

U. S. PUBLIC LAND SURVEY MONUMENT RECORD

INSTRUCTIONS:

This record shall show the location of the corner and shall include all of the following nine elements (a through i).


- (a) Identify the corner by reference to the U.S. public land survey system.  
○ = Corner monument restored.

Quarter Corner to Sections 26 and 35,  
T35N, R15E.

REGISTER'S OFFICE  
Forest County, Wis.

Received for record this 20<sup>th</sup> day  
of November A.D., 1990 at  
1:00 o'clock P.M. and recorded  
in Vol. Corner Restorations  
page V-19

*Paul Aschenbrenner*  
Register of Deeds

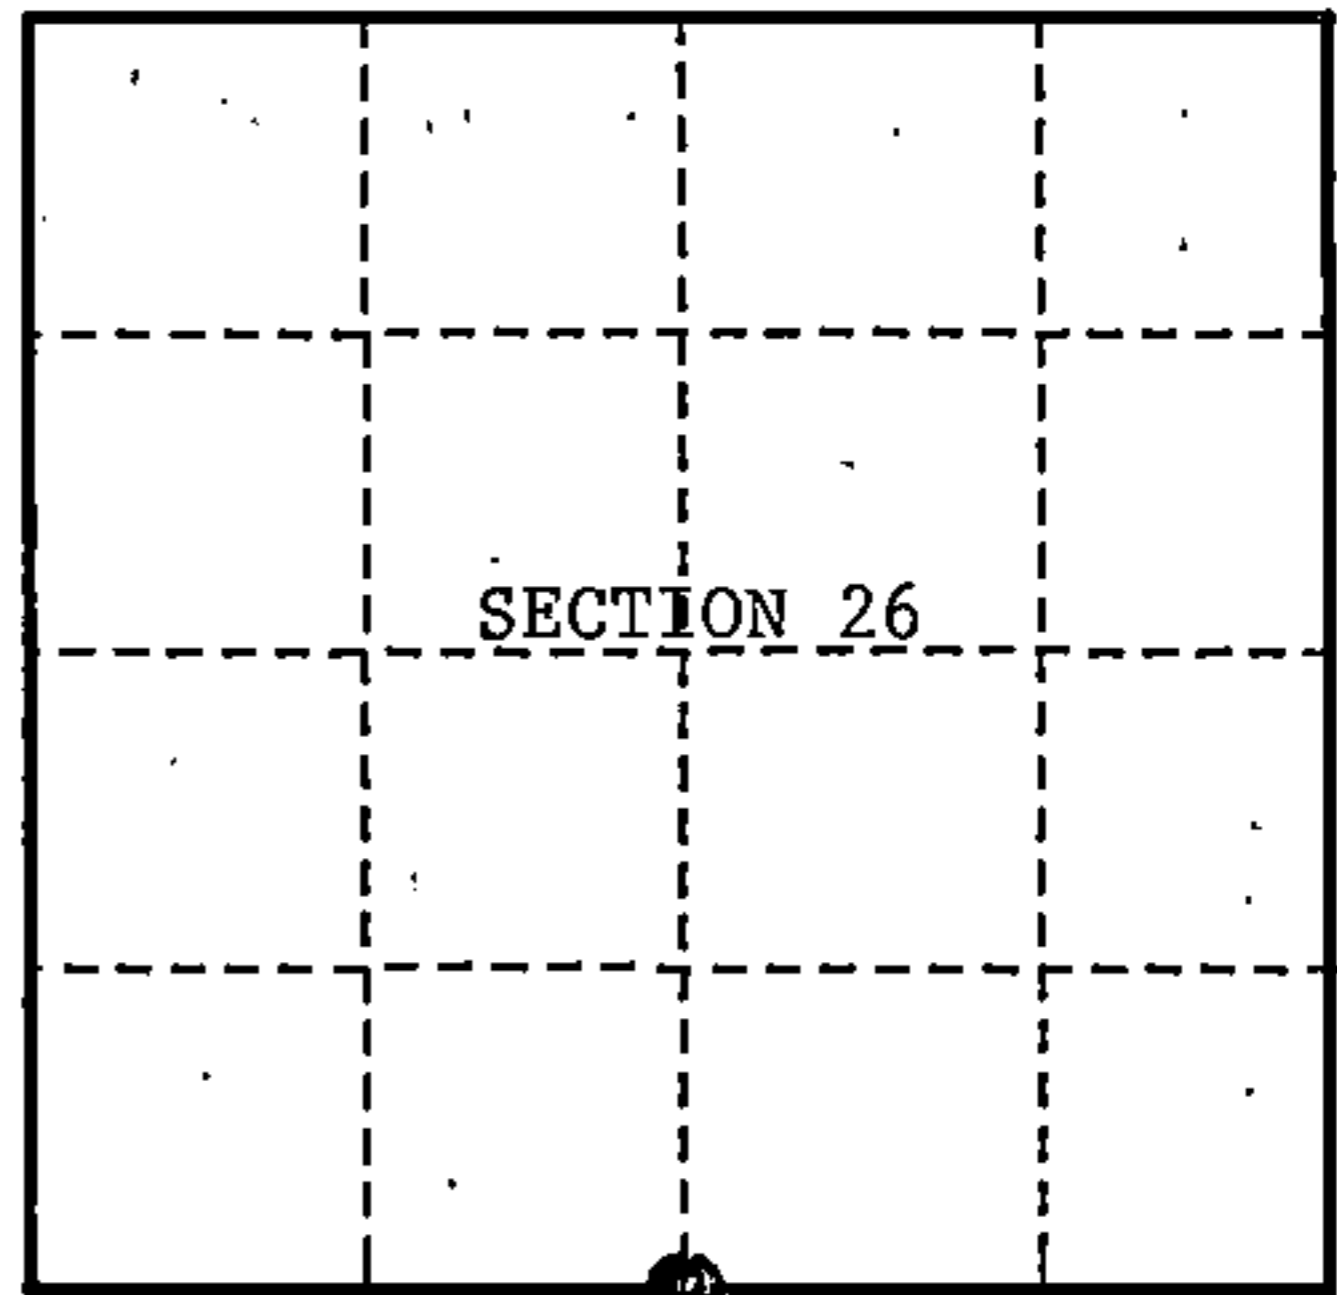

- (b) Describe any record evidence, monument evidence, occupational evidence, testimonial evidence or any other material evidence you considered, and whether the monument was found or placed.


In 1859 corner was established by James McBride. He set a wood post for the corner and made two BTs: Hemlock, 8", S.10°W., 12 Links and Hemlock, 6", N.23°W., 18 Links.  
1936 - Forest Service has an 874 stating corner was resurveyed by Rifleman. He placed a location poster on an Aspen stake.

On 5/14/1990 Milo E. Stefan found a mound of stone with post hole in center with the location poster lying in duff 3 feet Northeast of mound of stone. I accept this location as the restored corner location and monumented same to subdivide Section 26.

- (c) In the plan view drawing below, provide reference ties to at least 4 witness monuments, or, if the location is within a municipality, to at least 2 witness monuments. (witness monuments shall be made of concrete, natural stone, iron or other equally durable material.)

- (d) Show a plan view drawing depicting the relevant monuments and reference ties which is sufficient in detail to enable accurate relocation of the corner monument if the corner monument is disturbed. Indicate north.

- 1) 2" x 36" aluminum monument in mound of stone/tablet stamped to identify corner
- 2) Sugar, 10", N.23°E., 30.37'
- 3) Sugar, 10", S.34°E., 26.98'
- 4) Sugar, 10", South, 24.50'
- 5) Sugar, 6", N.58°W., 40.37'
- 6) Steel Sign Post, 6', East, 1.0'

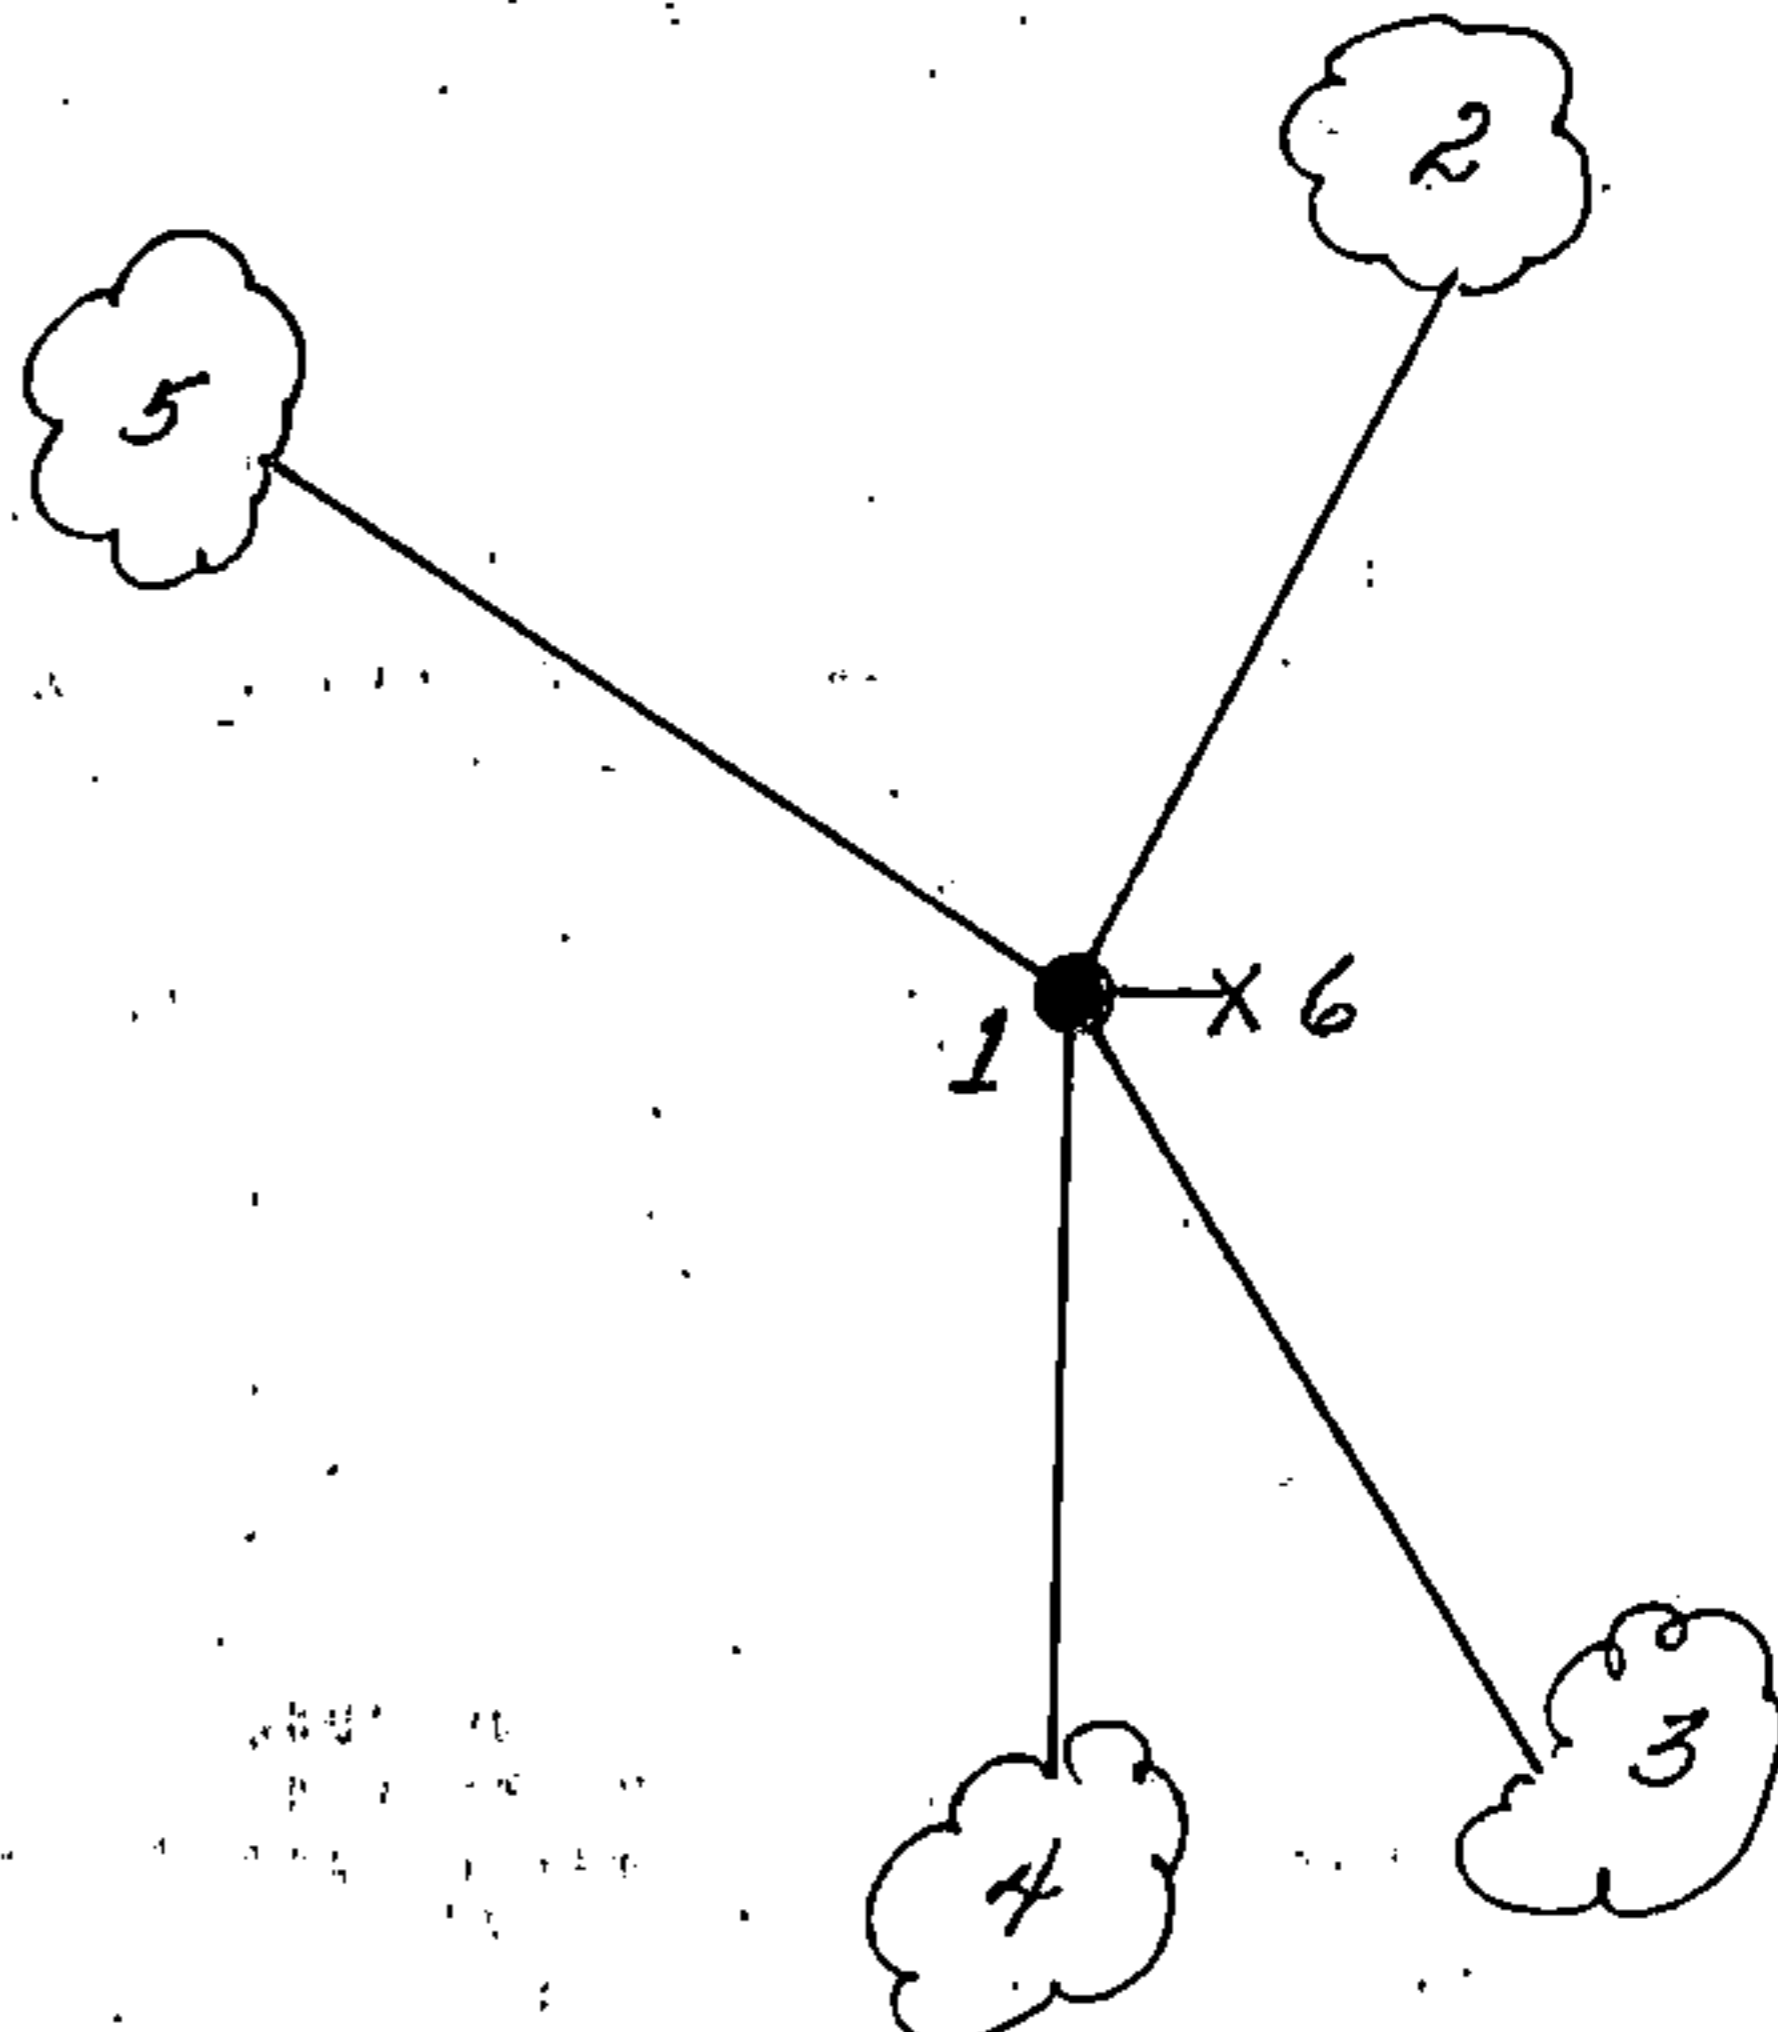

(a) Describe any material discrepancy between the location of the corner as restored or reestablished and the location of that corner as previously restored or reestablished by distance and direction. Show the discrepancy on the plan view drawing under (d) above. Show the distances between the corner as previously restored or reestablished and (1) the corner as restored or reestablished, and (2) to at least 2 of the witness monuments shown on the drawing in (d), above.

None

(f) Was the corner restored through acceptance of (1) an obliterated evidence location, or, (2) a found perpetuated location?

A found restored position.

(g & h) Was the corner reestablished through lost corner proportionate methods? If so, show the method, including the directions and distances to other public land survey corners used as evidence or used for proportioning in determining the corner location?



(1) I, Milo E. Stefan

(type or print name) certify that the corner location shown on this record was determined by me or under my direction and control and that this U.S. Public Land Survey Monument Record is correct and complete to the best of my knowledge and belief.

Milo E. Stefan  
Signature

July 16, 1990  
Date

CERTIFICATE READY FOR FILING:

Paul B. Staeger

District Ranger