

U. S. PUBLIC LAND SURVEY MONUMENT RECORD

INSTRUCTIONS:


This record shall show the location of the corner and shall include all of the following nine elements (a through i).

- (a) Identify the corner by reference to the U.S. public land survey system.  
 ○ = Corner monument restored.

Quarter Corner to Sections 27 & 34  
 T.35N.,R.15E., Forest County, WI.

State Plane Coordinates  
 Wisconsin North Zone  
 116709.82401-N  
 2326892.63065-E

Geographic Coordinates  
 45-28-41.10890-N  
 088-36-10.20708-W

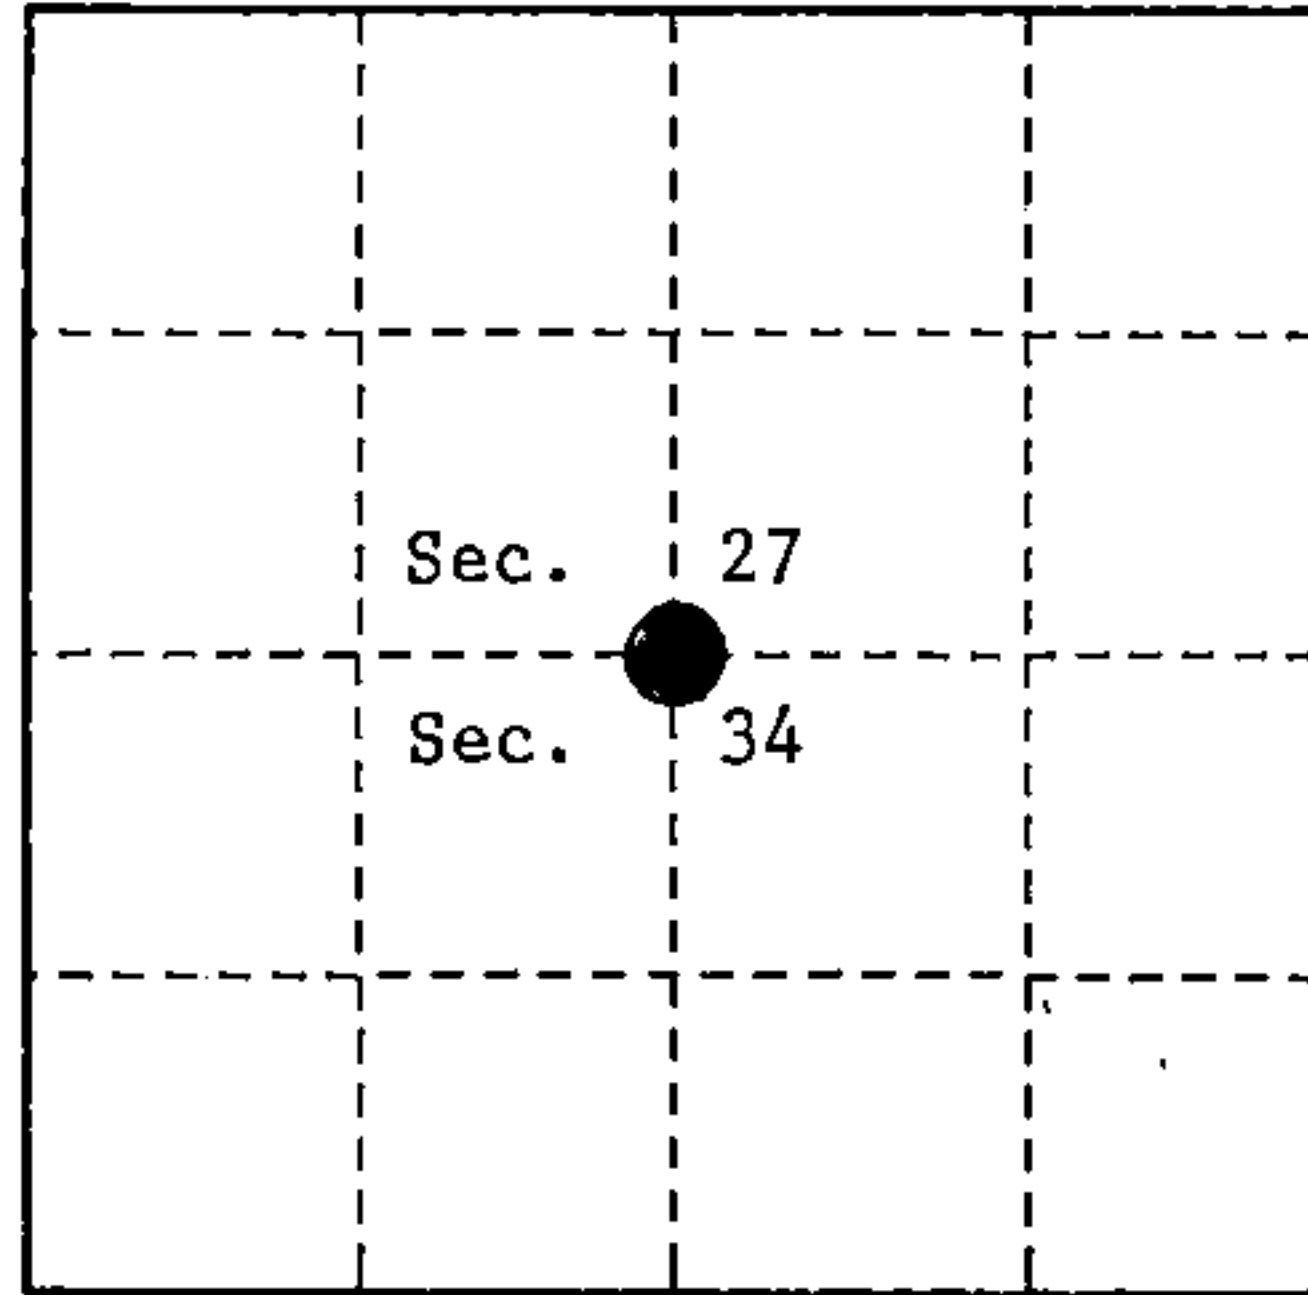

- (b) Describe any record evidence, monument evidence, occupational evidence, testimonial evidence or any other material evidence you considered, and whether the monument was found or placed.

Original survey in 1859 by James McBride. Set wood post and made the following bearing trees; Birch, 24", N.41°E., 28 links, Birch, 14", S.09°W., 19 links.


In 1989 J. Schulke, R.L.S. found no corner evidence. He re-established the corner position at mid-point and on line between opposing section corners. Set a 2 1/2" x 36" aluminum monument with an aluminum tablet stamped to identify corner. Blazed and scribed new bearing trees.

On 7/11/94, Alan Harrison, R.L.S., found monument and bearing trees as set by J. Schulke in 1989. Cut down all bearing trees for G.P.S. observations. After completion of G.P.S. observations on the section line between sections 27 and 34, found the monument as set by J. Schulke to be 1.18 feet out of position. Moved the monument as set by Schulke S.85°, 45'29"W., 1.18 feet. Made new bearing trees as noted below.

- (c) In the plan view drawing below, provide reference ties to at least 4 witness monuments, or, if the location is within a municipality, to at least 2 witness monuments. (witness monuments shall be made of concrete, natural stone, iron or other equally durable material.)

- (d) Show a plan view drawing depicting the relevant monuments and reference ties which is sufficient in detail to enable accurate relocation of the corner monument if the corner monument is disturbed. Indicate north.

1. 2 1/2" x 36" aluminum monument with tablet stamped to identify corner.
2. Sugar, 7", N.36°E., 33.37 feet.
3. Sugar, 11", S.85°W., 53.90 feet.
4. Sugar, 8", N.58°W., 57.60 feet.
5. Steel sign post, East, 1.30 feet.

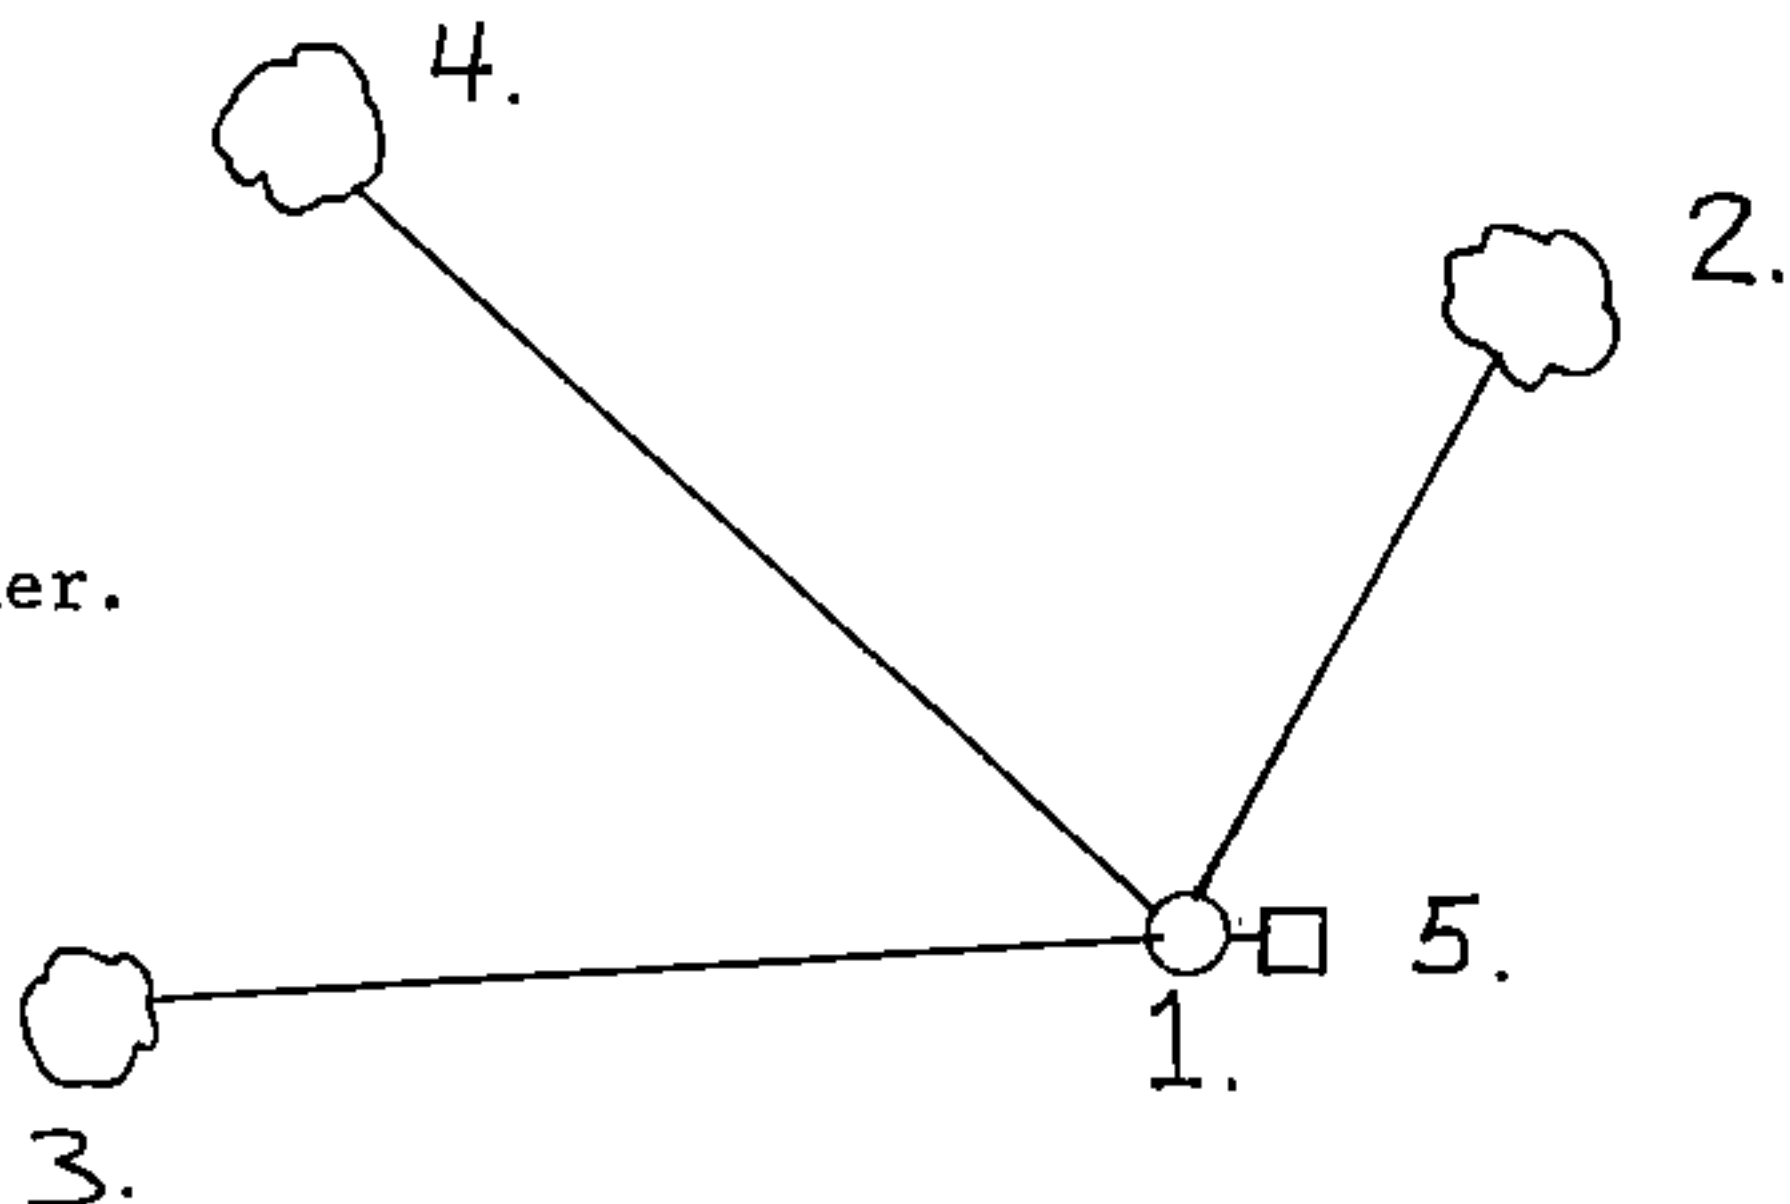

(e) Describe any material discrepancy between the location of the corner as restored or reestablished and the location of that corner as previously restored or reestablished by distance and direction. Show the discrepancy on the plan view drawing under (d), above. Show the distances between the corner as previously restored or reestablished and (1) the corner as restored or reestablished, and (2) to at least 2 of the witness monuments shown on the drawing in (d), above.

J.Schulke position of 1989 survey

A. Harrison position 1994 G.P.S. survey


(f) Was the corner restored through acceptance of (1) an obliterated evidence location, or, (2) a found perpetuated location ?

No

(g & h) Was the corner reestablished through lost corner proportionate methods? If so, show the method, including the directions and distances to other public land survey corners used as evidence or used for proportioning in determining the corner location?

Yes

REGISTER'S OFFICE  
Forest County, Wis.  
Received for record this 23rd day  
of December A.D., 1994 at  
9:00 o'clock A.M. and recorded  
in Vol. Cons. Restorations  
page 35/15; U-15  
*Seal Chitt, Deputy*  
Register of Deeds

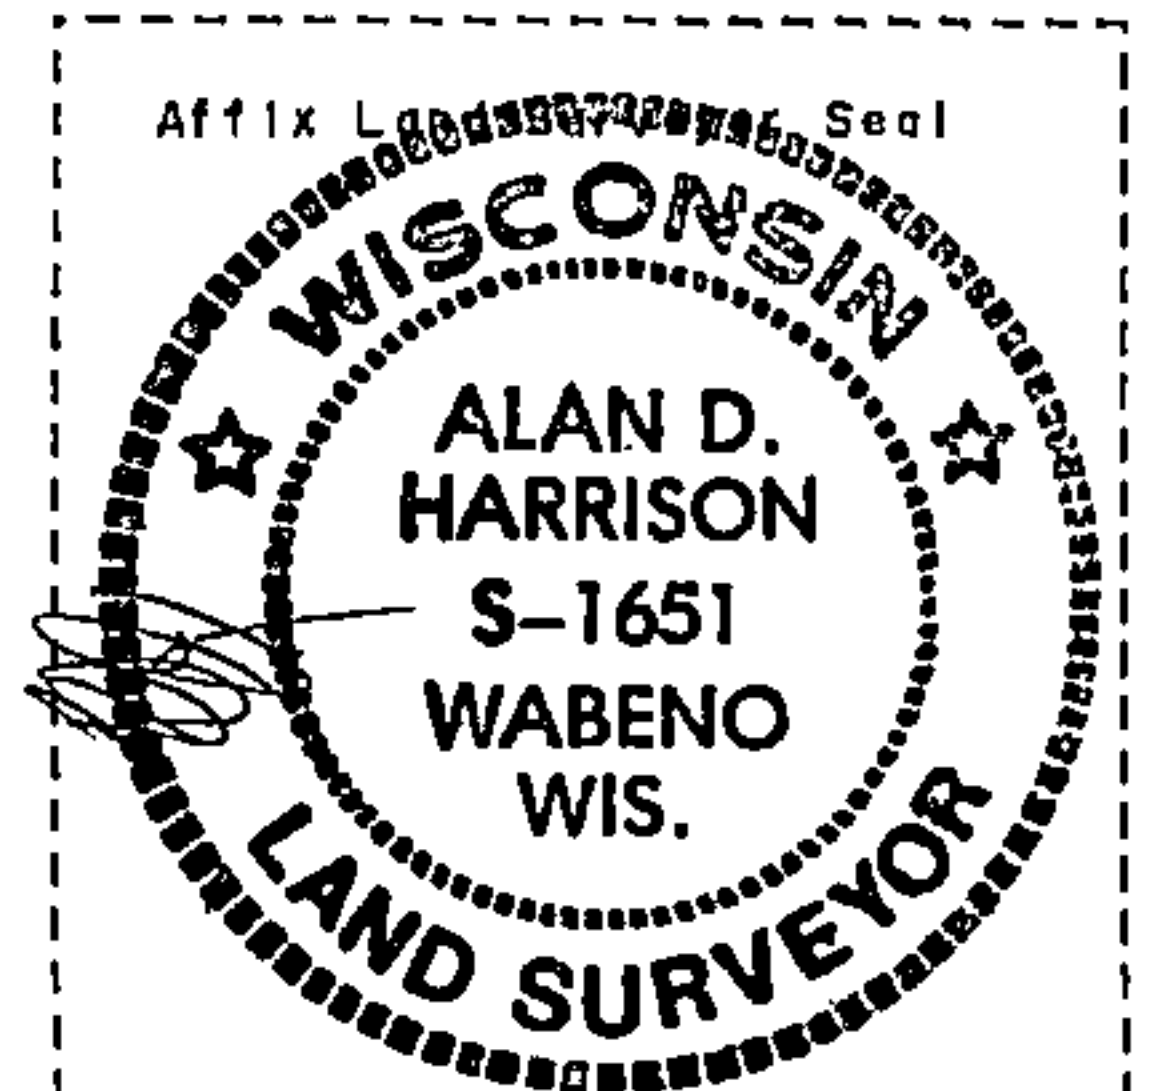

(1) I, Alan D. Harrison  
(type or print name) certify that the corner location shown  
on this record was determined by me or under my direction and  
control and that this U.S. Public Land Survey Monument Record is  
correct and complete to the best of my knowledge and belief.

Alan D. Harrison 10/27/94  
Signature Date


CERTIFICATE READY FOR FILING: Sue Vap  
District Ranger

## U. S. PUBLIC LAND SURVEY MONUMENT RECORD.

INSTRUCTIONS: This record shall show the location of the corner and shall include all of the following nine elements (a through i).

- (a) Identify the corner by reference to the U.S. public land survey system.  
 ○ = Corner monument restored.

Quarter Corner Between Sections 27 and 34  
 T35N, R15E, Forest County, Wisconsin

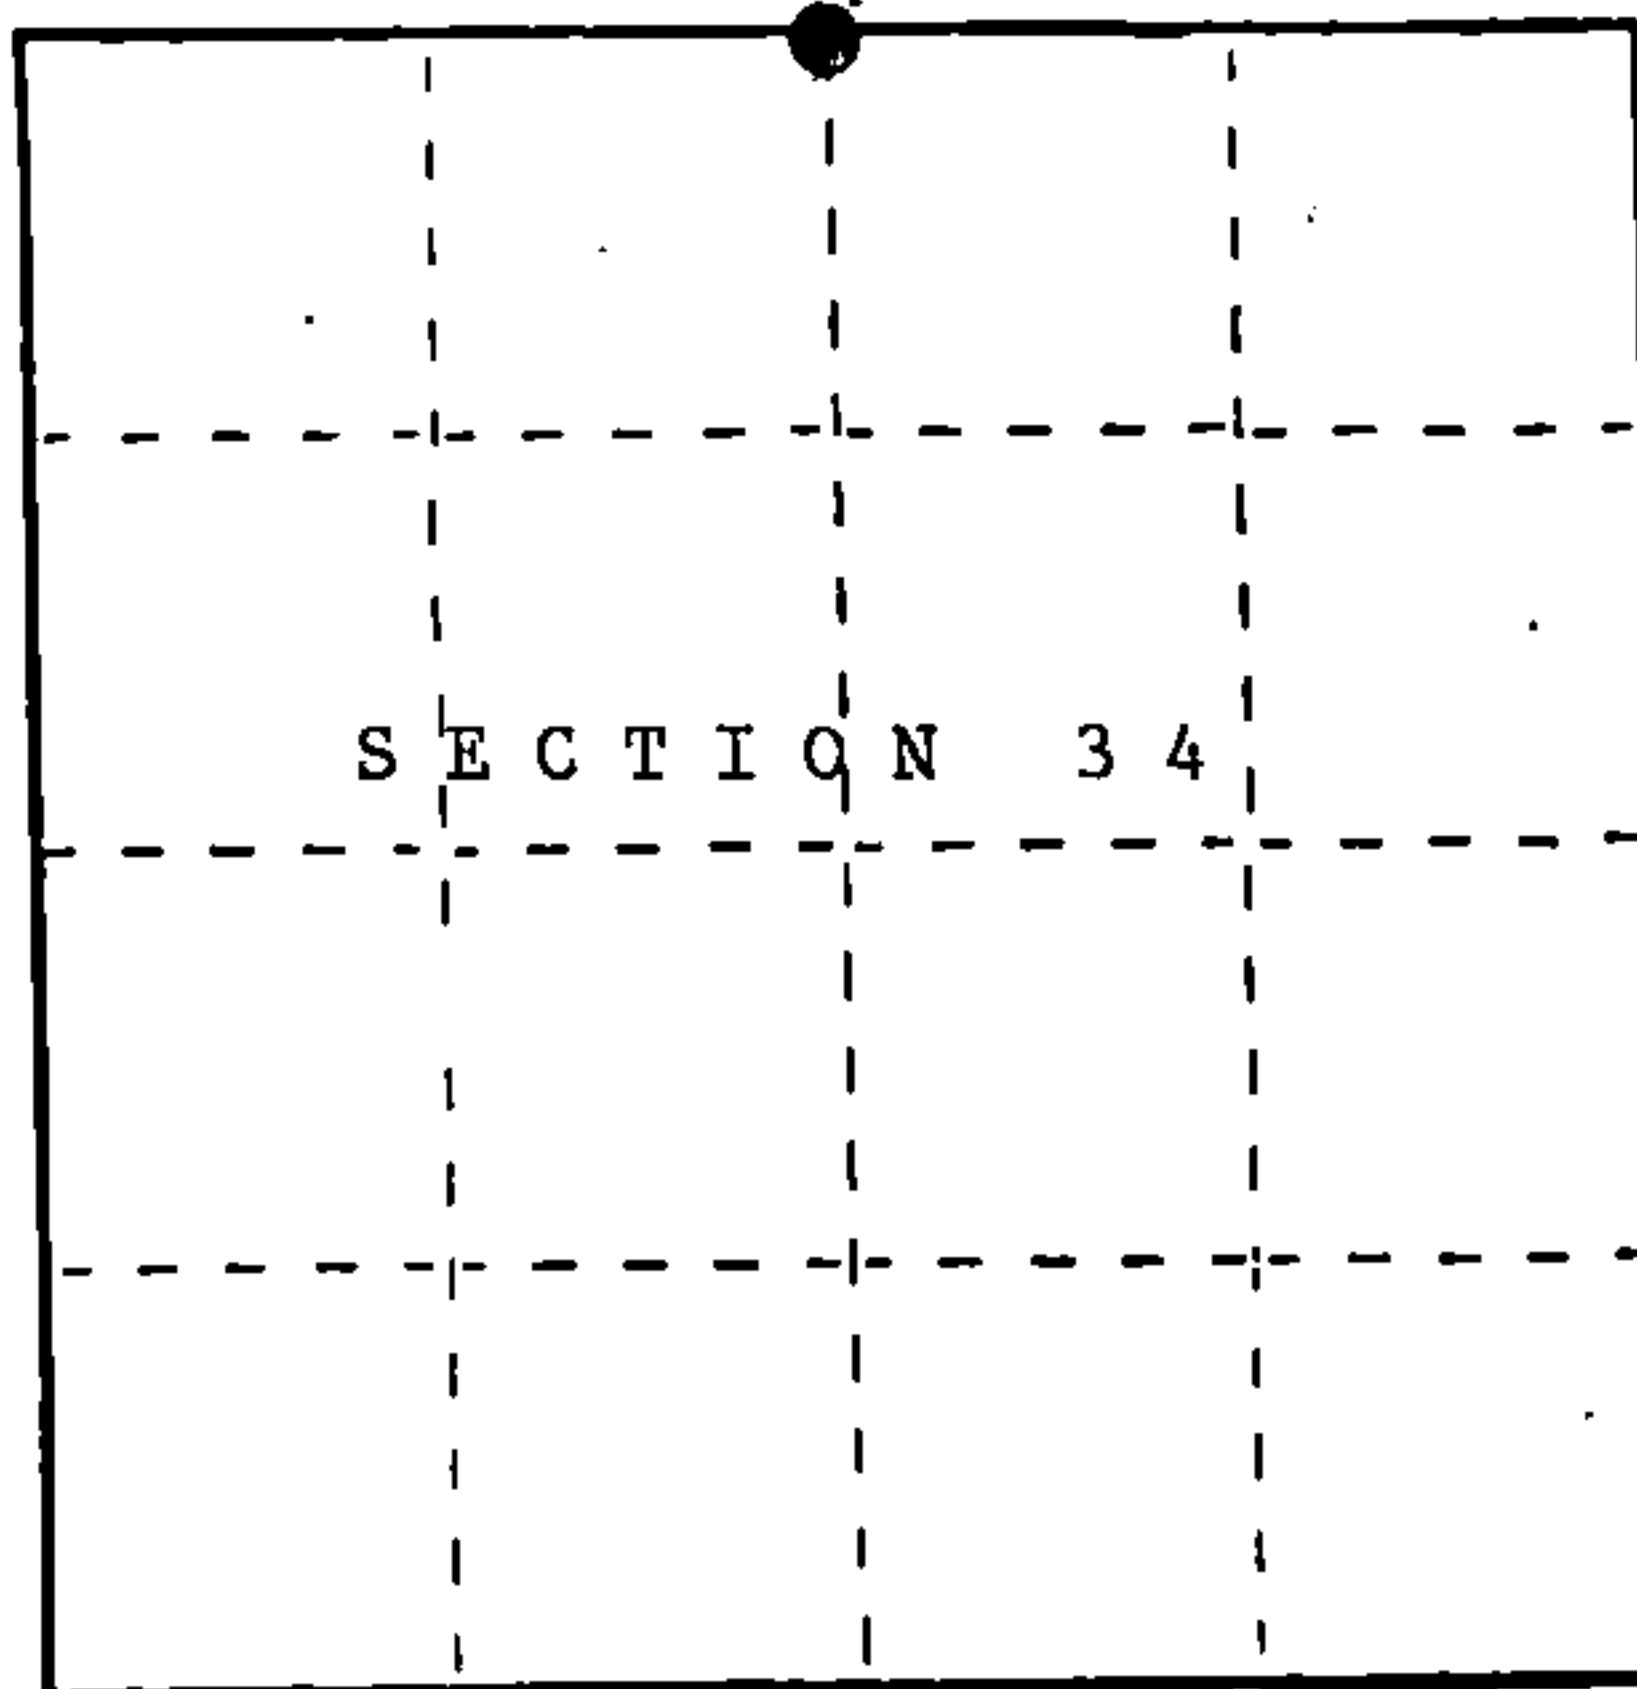

REGISTER'S OFFICE  
 Forest County, Wis.

Received for record this 6<sup>th</sup> day  
 of Sept. A.D., 1989 at

10:25 o'clock A.M. and recorded

In Vol. CORNER RESTORATIONS  
 page V-15

Paul Ackermann  
 Register of Deeds

- (b) Describe any record evidence, monument evidence, occupational evidence, testimonial evidence or any other material evidence you considered, and whether the monument was found or placed.


In 1859, James McBride set a wood post for the corner and the following corner references:  
 Birch 24" N41°E 28 lks. Birch 14" S09°W 19 lks.

In 1989, Schulke found no evidence.

- (c) In the plan view drawing below, provide reference ties to at least 4 witness monuments, or, if the location is within a municipality, to at least 2 witness monuments. (Witness monuments shall be made of concrete, natural stone, iron or other equally durable material.)  
 Describe witness monuments.

- (d) Show a plan view drawing depicting the relevant monuments and reference ties which is sufficient in detail to enable accurate relocation of the corner monument if the corner monument is disturbed. Indicate north.

1. 2 1/2" X 36" aluminum magnetic cap monument stamped to identify the corner.
2. Monument in a mound of stones.
3. Sugar Maple 10" N73°W 37.00 ft.
4. Sugar Maple 4" N21°W 9.38 ft.
5. Sugar Maple 5" S26°E 31.62 ft.
6. Sugar Maple 10" S70°W 21.25 ft.
7. Set a steel sign post 0.8 ft. WEST of the monument.

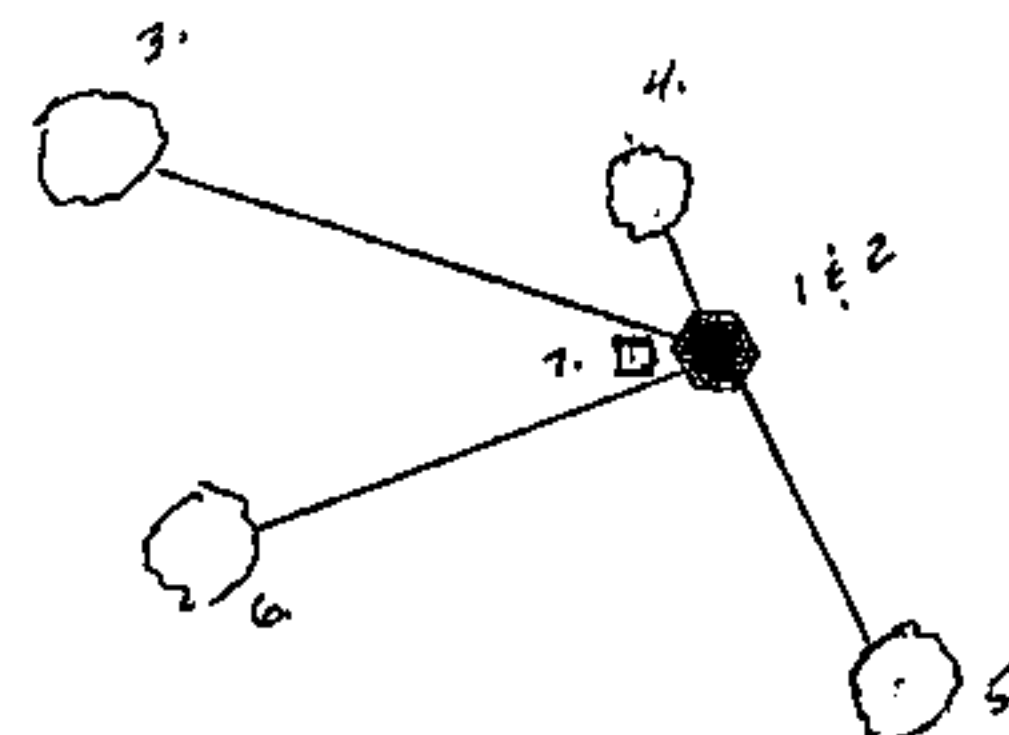

(e) Describe any material discrepancy between the location of the corner as restored or reestablished and the location of that corner as previously restored or reestablished by distance and direction. Show the discrepancy on the plan view drawing under (d), above. Show the distances between the corner as previously restored or reestablished and (1) the corner as restored or reestablished, and (2) to at least 2 of the witness monuments shown on the drawing in (d), above.


No discrepancy, first corner restoration.

(f) Was the corner restored through acceptance of (1) an obliterated evidence location, or, (2) a found perpetuated location?


No, see g and h.

(g&h) Was the corner reestablished through lost corner proportionate methods? If so, show the method, including the directions and distances to other public land survey corners used as evidence or used for proportioning in determining the corner location?

Corner restored by proportionate method.

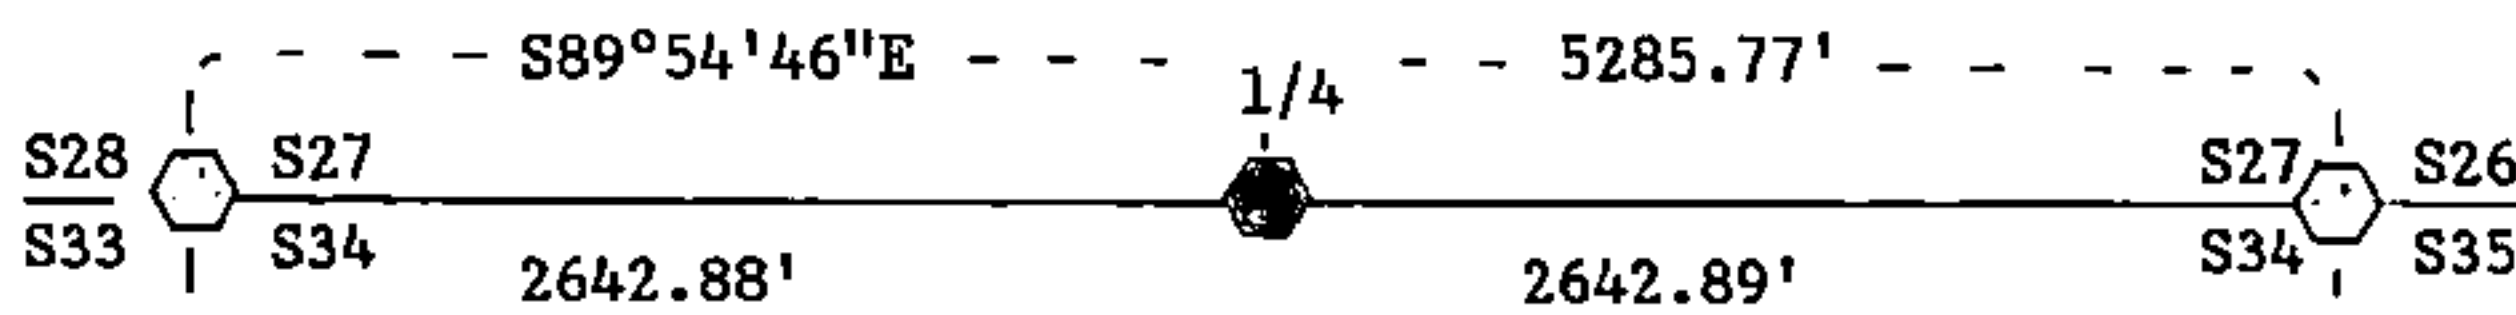

*Handwritten notes:*  
 2642.88' + 2642.89' = 5285.77'

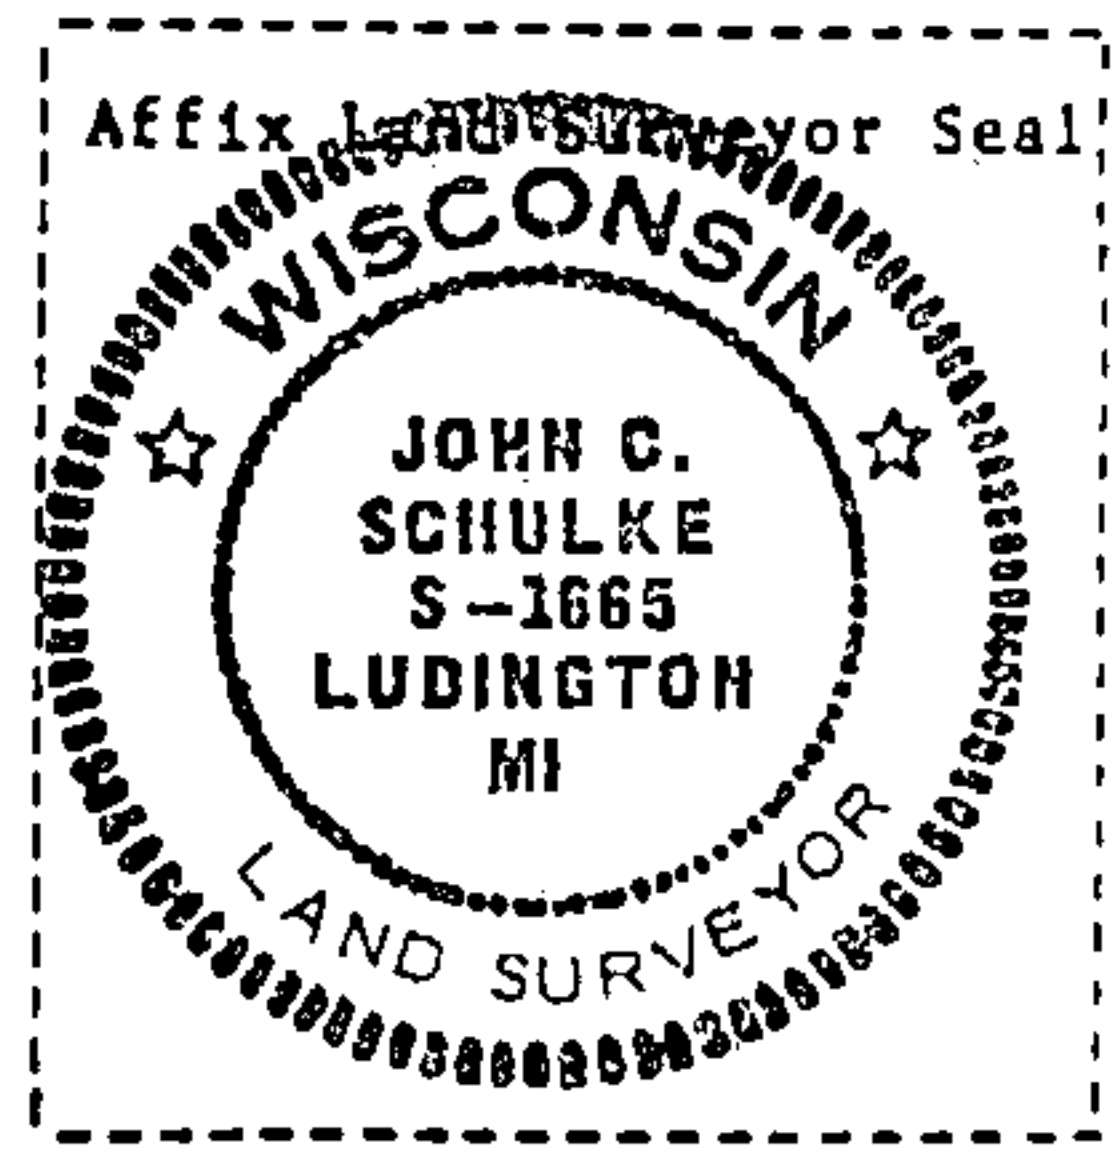

(1) I, John C. Schulke  
 (type or print name) certify that the corner location shown on this record was determined by me or under my direction and control and that this U.S. Public Land Survey Monument Record is correct and complete to the best of my knowledge and belief.

John C. Schulke Signature      June 7th, 1989 Date

Certificate ready for filing: Dale B. Staeger  
 District Ranger