

CERTIFIED LAND CORNER RESTORATION

State of Wisconsin }  
County of Forest } ss.

I Milo E. Stefan, do hereby certify that on the 25th day of April, 1983, I found evidence of the North Quarter corner of Section 33 Township 35 North, Range 15 East, Fourth Principal Meridian, as described hereon; and that from this evidence I established a new monument and accessories as described hereon to perpetuate the original location of this corner:

Description of original monument and accessories and subsequent restorations:

Surveyed in 1859 by James McBride  
40.00 chains, set wood post  
Cedar, 24", N.14°E., 27 links  
Birch, 18", S.64°E., 23 links


Description of corner evidence found:

Cedar (large-fallen), N.14°E., 27 links  
Local Evidence: Found location poster set on Yellow Birch, 18", N.25°E., approximately 27 links, as described on Form 874-9 from April 3, 1935; also, found fence corner, fence south and west.

Description of monument and accessories I established to perpetuate the location of this corner:

Placed a 2" x 36" aluminum monument in mound of stone with tablet stamped as follows:  
T35N, R15E, S28, 1/4, S33, 1983, RLS-1558  
From which the following bear:  
Black Ash, 5", N.90°E., 17.78 feet  
Sugar Maple, 8", S.35°E., 9.37 feet  
Yellow Birch, 5", S.58°W., 34.86 feet  
Steel Sign Post, North, 2.00 feet

DOCUMENT NO.  
124198

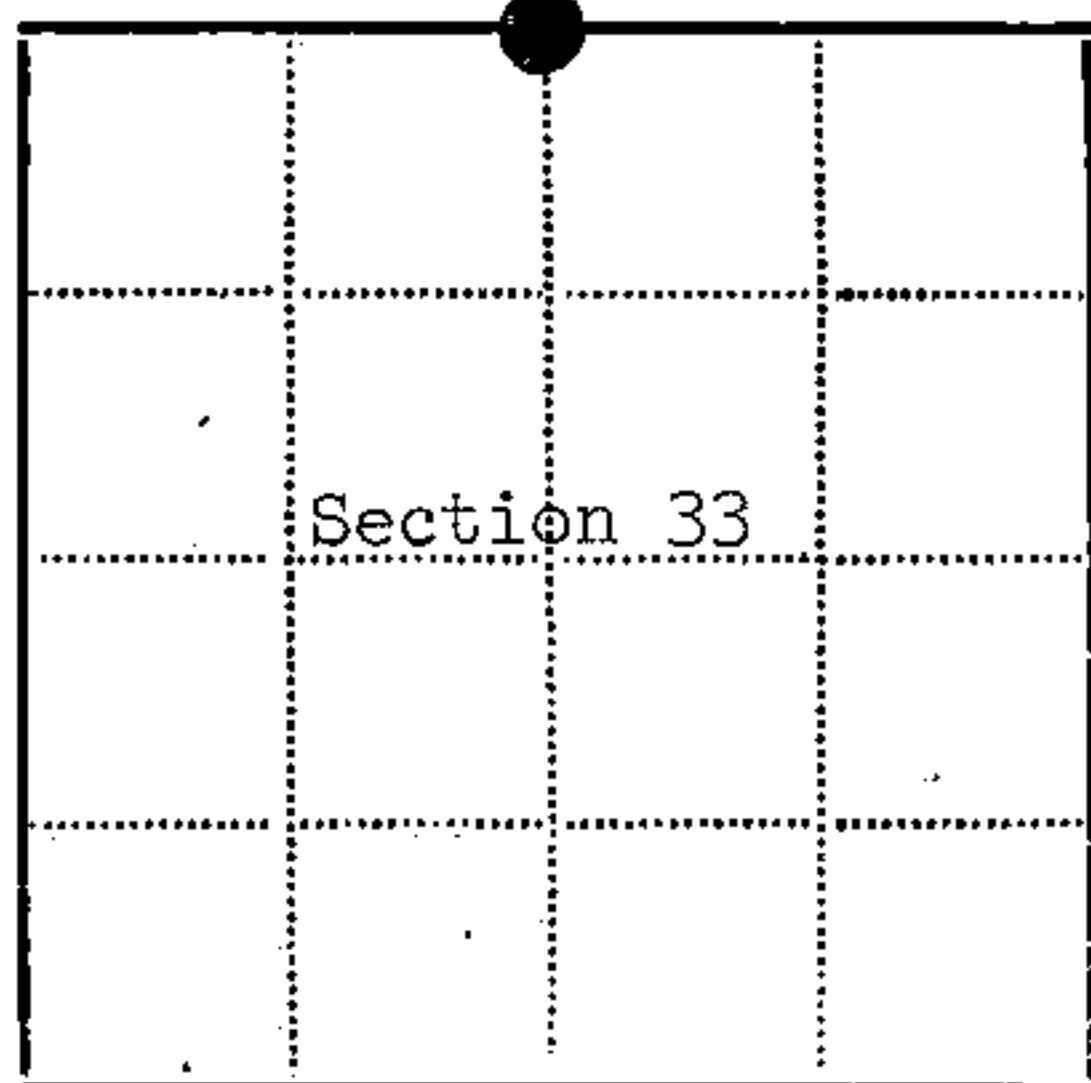

● - Corner monument restored  
□ -

Resident witnesses.....

Dated at Rhinelander, Wisconsin, this 25th day of April, 1983.

Signature Milo E. Stefan Title Land Surveyor  
(County Surveyor, Registered Land Surveyor, or other duly authorized official)

Surveyors Registration No. RLS-1558

Office of Register of Deeds County of Forest

I hereby certify that the within instrument was filed in this office for record on the 13th day of September, 1983, and was filed in Book No. .... Page No. .... of County Records.

Signature Eugene J. Staty Title Register of Deeds

Township 35 North, Range 15 East, Section 33, Index No. V-11, Page No. B-7, P-63