

CERTIFIED LAND CORNER RESTORATION

Index No. T-5


State of Wisconsin }
County of Forest } ss.

I Thomas R. Arnett, do hereby certify that on the 26 th day of September, 1977, I found evidence of the 1/4 corner of sections 29 & 30 Township 35, North, Range 15 E, Fourth Principal Meridian, as described hereon; and that from this evidence I established a new monument and accessories as described hereon to perpetuate the original location of this corner.

Resident witnesses:

Clifford Krauel

FORM 985 H. C. MILLER CO., MILWAUKEE

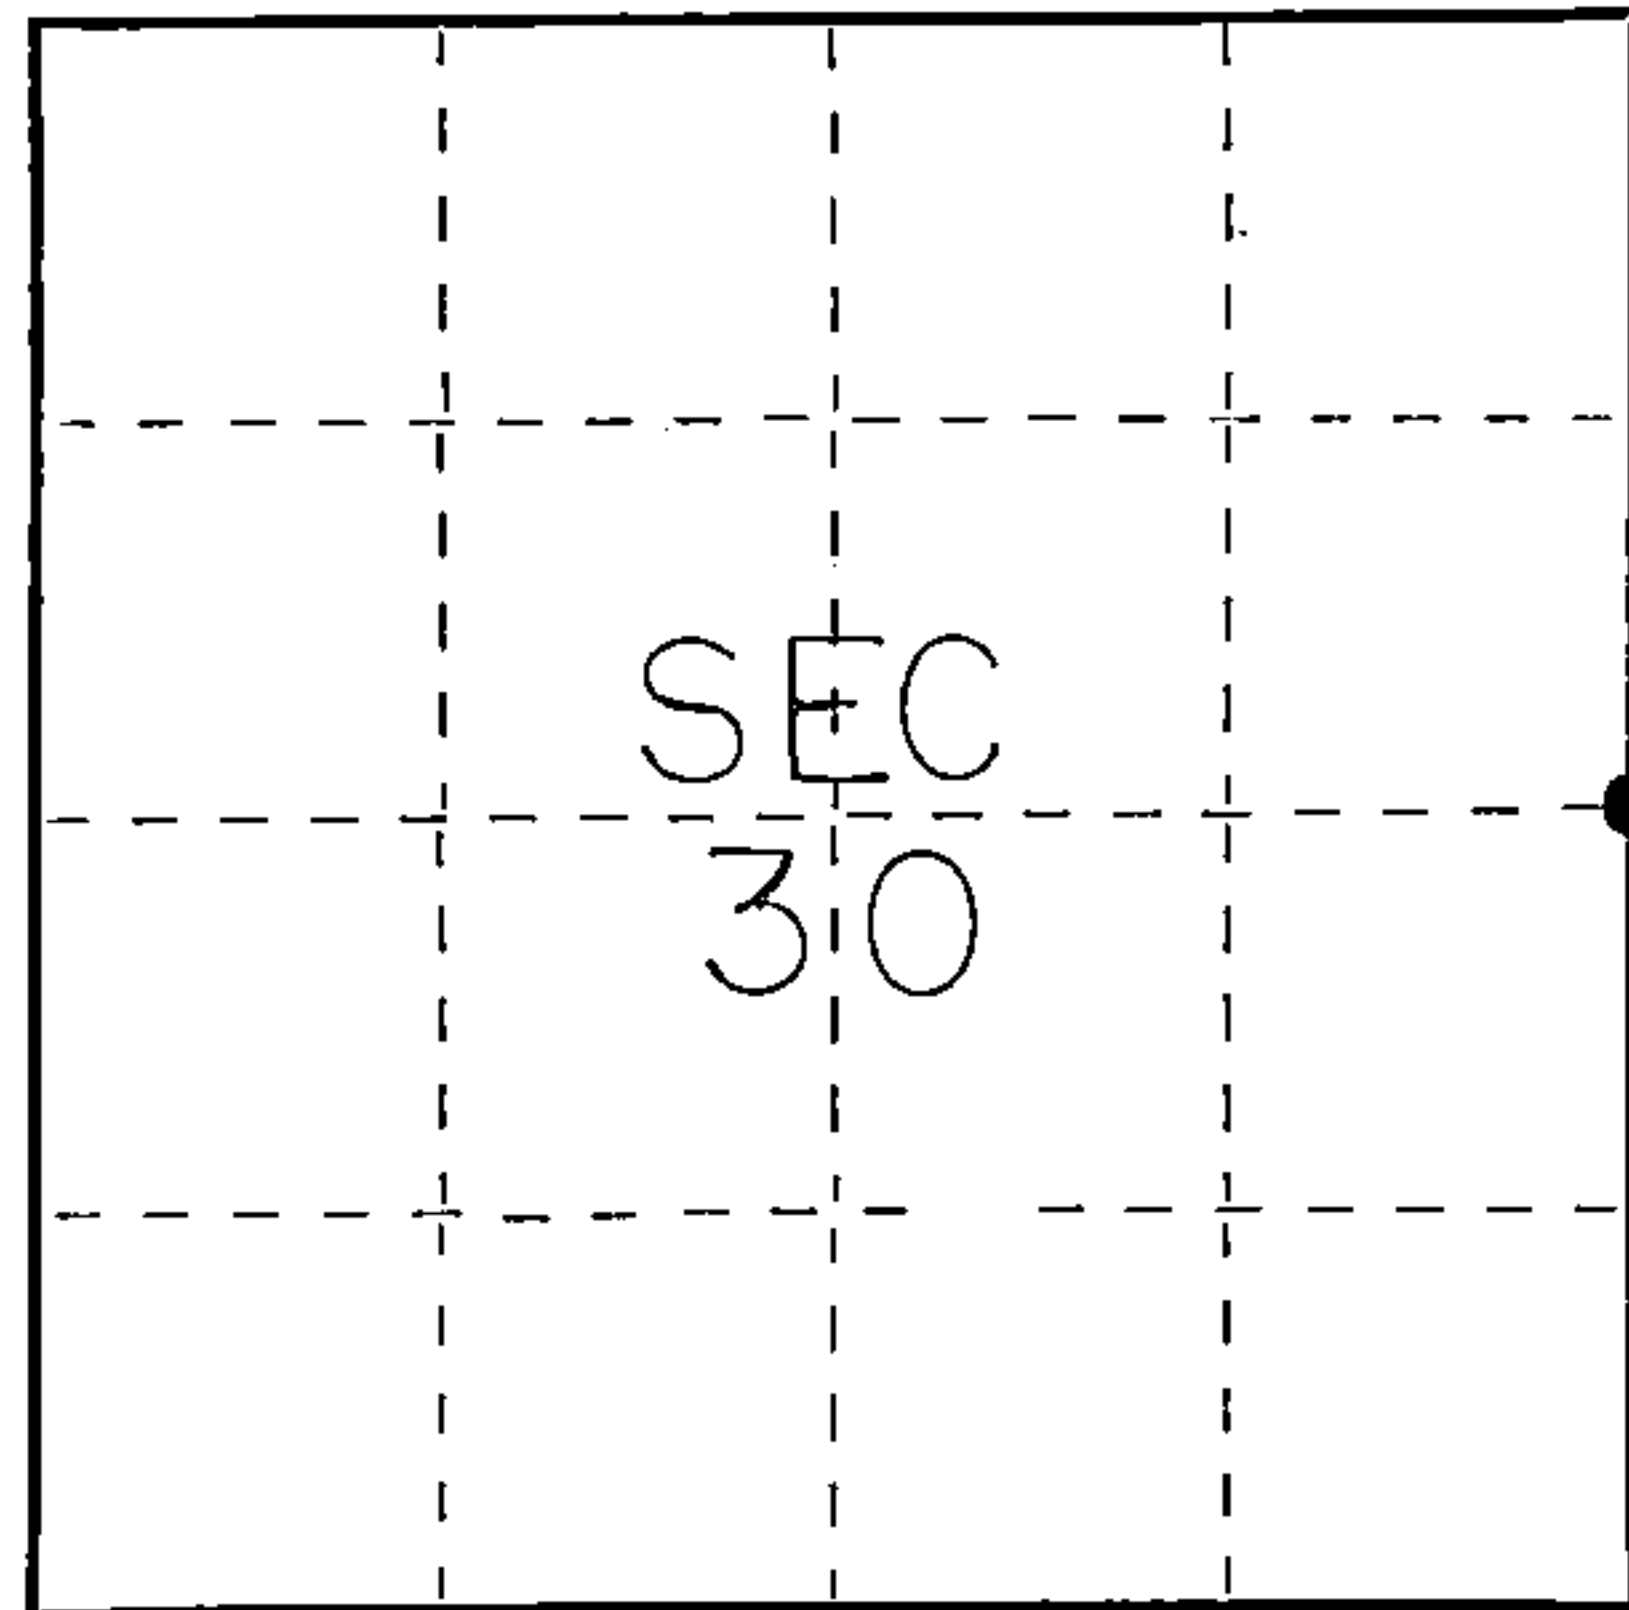

○ = Corner monument restored.

History of original corner establishment:

Original survey by James McBride 10 June - 15 June, 1859

Lind 14 N67E 19 lks.
Elm 16 S84W 57 lks.

Description of corner evidence found:

Found old wood post at fence corner

Description of monument and accessories I established to perpetuate the original location of this corner.

Set 5' long 2" steel pipe with brass cap.

Ties:

Maple 14 N22E 15.53 feet
Maple 12 S46E 30.97 feet



Dated at Crandon, Wis., this 3rd day of November, 1977.

Signature Thomas R. Arnett Title Surveyor Registration No. S-887
(County Surveyor, Registered Land Surveyor, or other duly authorized official)

Office of Register of Deeds, County of Forest, I hereby certify that the within instrument was filed in this office for record on the 3rd day of November, 1977 at 11 o'clock A. M.

Eugene Staszyn Doc. No. **112704**
(Register of Deeds)

By _____ Deputy

43515302000


U. S. PUBLIC LAND SURVEY MONUMENT RECORD

I N S T R U C T I O N S : This record shall show the location of the corner and shall include all of the following nine elements (a through i).

(a) Identify the corner by reference to the U.S. public land survey system.

○ = Corner monument restored.

Quarter corner to Sections 29 and 30, T.35N., R.15E.

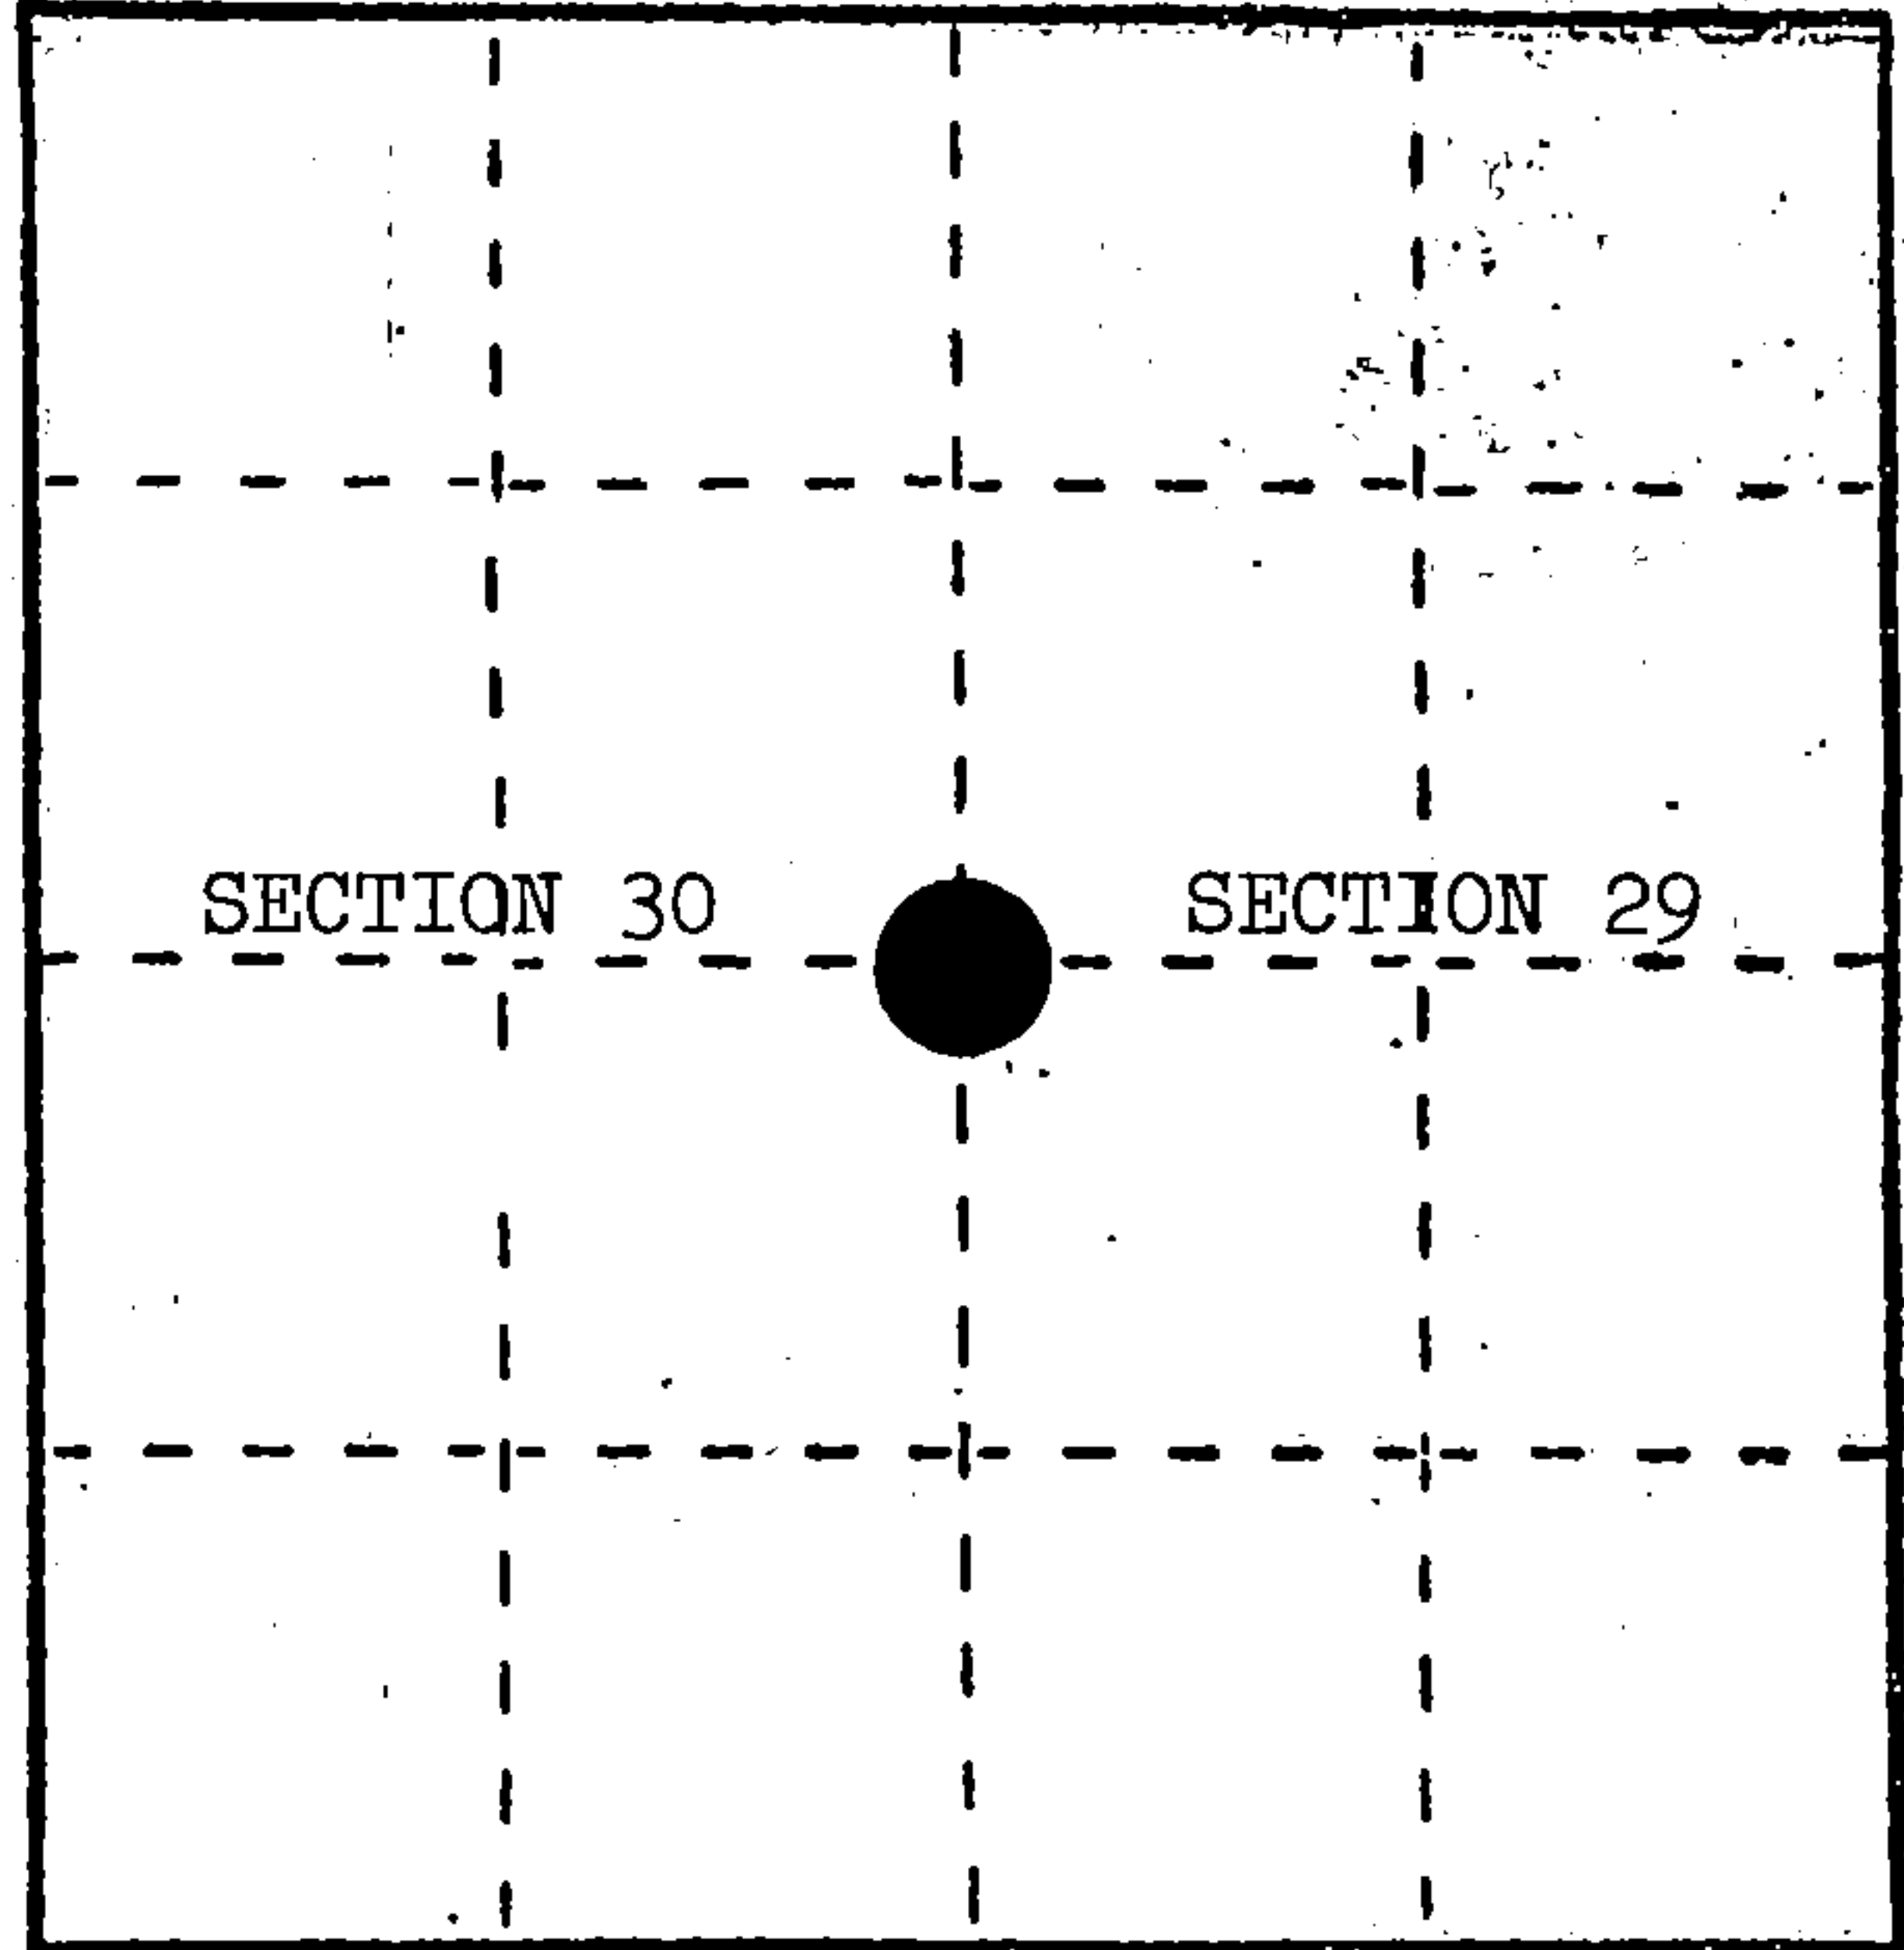

(b) Describe any record evidence, monument evidence, occupational evidence, testimonial evidence or any other material evidence you considered, and whether the monument was found or placed.

In 1859, James McBride set $\frac{1}{4}$ section post with the following BTs: Linn, 14", N.67°E., 19 links; Elm, 16", S.84°W., 57 links.


In 1909, Smith found original stumps with iron marks. Made the following new BTs: Sugar, 6", S.66 $\frac{1}{2}$ °E., 9 links; Hemlock, 10", N.57°E., 27 links.

August 31, 1984, USDA-FS, found a Forest County brass cap 2' above ground, set by S-887 (T. Arnott). Found Smith's BTs: Sugar (alive), 22", S.66°E., 5.94' and decayed Hemlock stump, N.57°E., 17.82'. Found stump holes at N.67°E., 12.54' and at S.84°W., 37.62' for original BTs. Old fence line north and west.

(c) In the plan view drawing below, provide reference ties to at least 4 witness monuments, or, if the location is within a municipality, to at least 2 witness monuments. (Witness monuments shall be made of concrete, natural stone, iron or other equally durable material.) Describe witness monuments.

(d) Show a plan view drawing depicting the relevant monuments and reference ties which is sufficient in detail to enable accurate relocation of the corner monument if the corner monument is disturbed. Indicate north.

1. Sugar, 14", N.15°E., 15.30'
2. Sugar, 10", S.46°E., 30.97'
3. Sugar, 18", S.7°W., 48.59'
4. Steel Sign Post, 7', North, 2.3'
5. Forest County cap stamped to identify the corner.

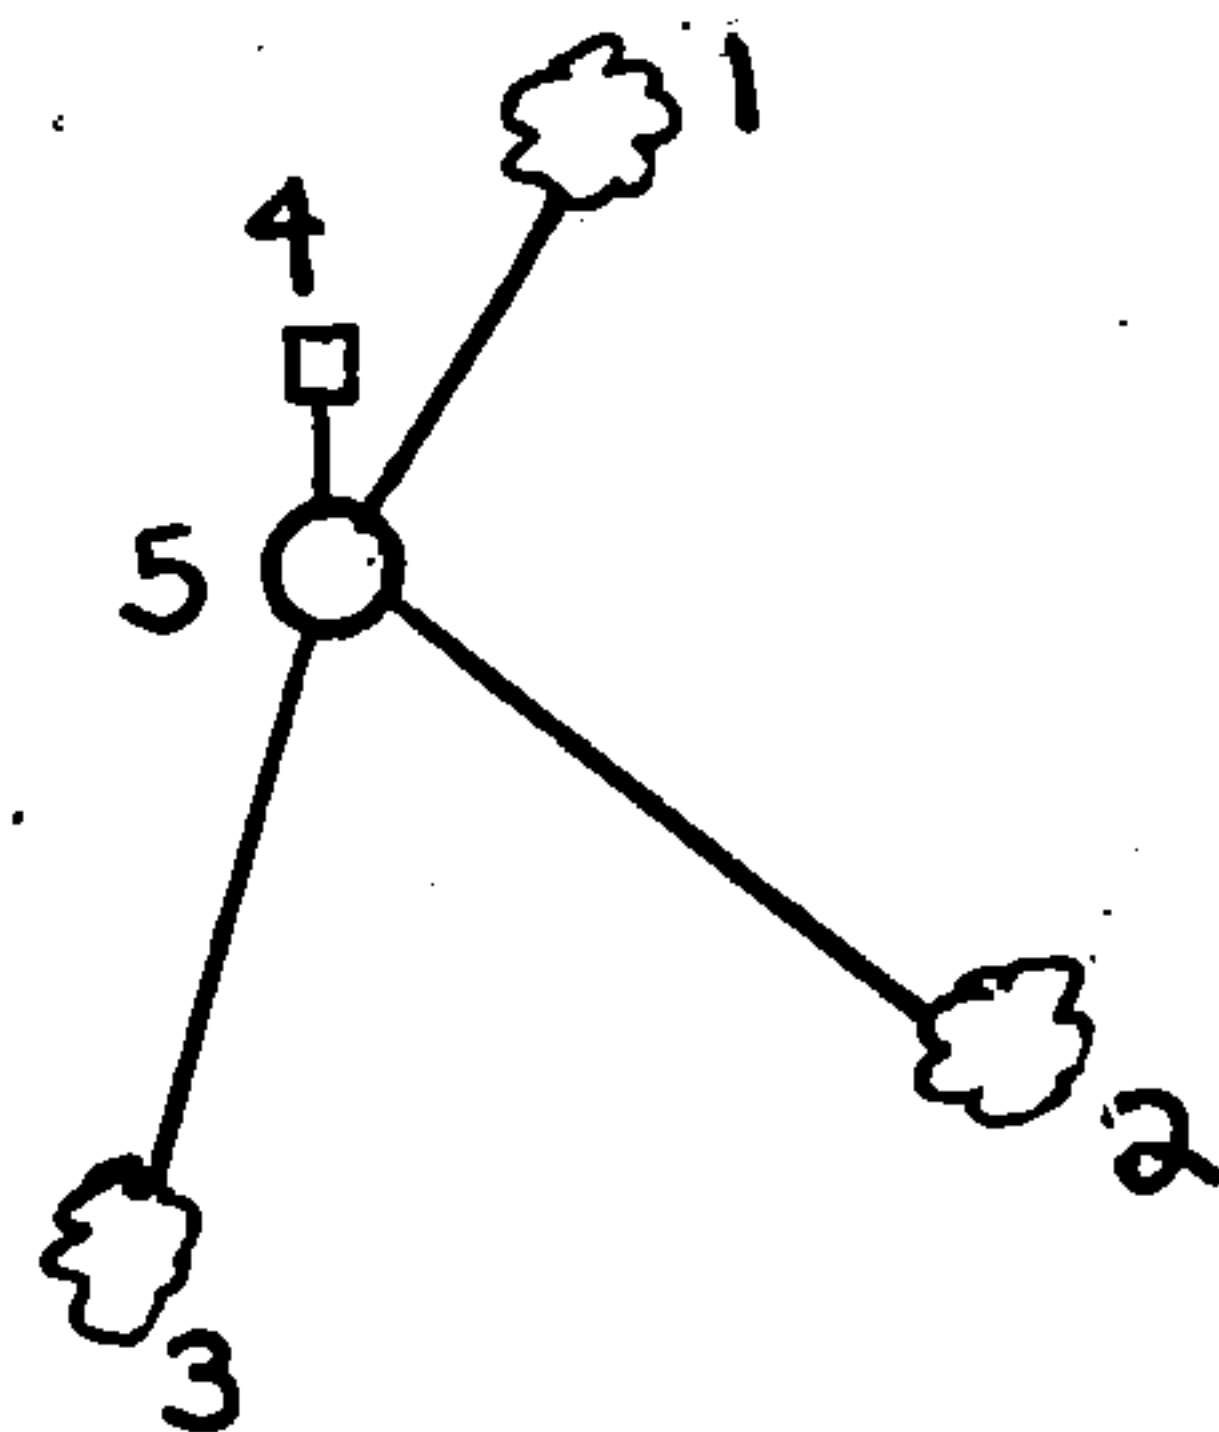

REGISTER'S OFFICE }
Forest County, Wis. }

Received for record this 21st day
of January A. D., 1985 at
11:00 o'clock A. M. and

recorded in Vol. CORNER RESTORATIONS
on page T-5

Paul Aschenbrenner
REGISTER

(e) Describe any material discrepancy between the location of the corner as restored or reestablished and the location of that corner as previously restored or reestablished by distance and direction. Show the discrepancy on the plan view drawing under (d), above. Show the distances between the corner as previously restored or reestablished and (1) the corner as restored or reestablished, and (2) to at least 2 of the witness monuments shown on the drawing in (d), above.

None.

(f) Was the corner restored through acceptance of (1) an obliterated evidence location, or, (2) a found perpetuated location?

(2) a found perpetuated location.

(g&h) Was the corner reestablished through lost corner proportionate methods? If so, show the method, including the directions and distances to other public land survey corners used as evidence or used for proportioning in determining the corner location?

No.

Affix Land Surveyor Seal



(i) I, Milo E. Stefan

(type or print name) certify that the corner location shown on this record was determined by me or under my direction and control and that this U.S. Public Land Survey Monument Record is correct and complete to the best of my knowledge and belief.

Milo E. Stefan
Signature

12/24/84
Date