

CERTIFIED LAND CORNER RESTORATION

State of Wisconsin }
County of Forest } ss.

I Milo E. Stefan, do hereby certify that on the 3rd day of August, 1983, I found evidence of the East Quarter corner of Section 33 Township 35 North, Range 15 East, Fourth Principal Meridian, as described hereon; and that from this evidence I established a new monument and accessories as described hereon to perpetuate the original location of this corner:

Description of original monument and accessories and subsequent restorations:

Surveyed in 1857 by James McBride
40.00 chains, set wood post
White Pine, 10", N.51°E., 19 links, 12.54 feet
Black Ash, 18", N.43°W., 29 links, 19.14 feet


Description of corner evidence found:

No original evidence found
Local Evidence: 3 1/2" x 3 1/2" x 4' pointed concrete post

Description of monument and accessories I established to perpetuate the location of this corner:

Placed a 2" x 36" aluminum monument in mound of stone with tablet stamped as follows:
T35N, R15E, 1/4, S33, S34, 1983, RLS-1558
From which the following bear:
Red Maple, 7", S.10°E., 29.28 feet
Black Ash, 8", S.50°W., 68.03 feet
Red Maple, 10", N.66°W., 37.14 feet
Steel Sign Post, West, 2.10 feet

DOCUMENT NO.
124199

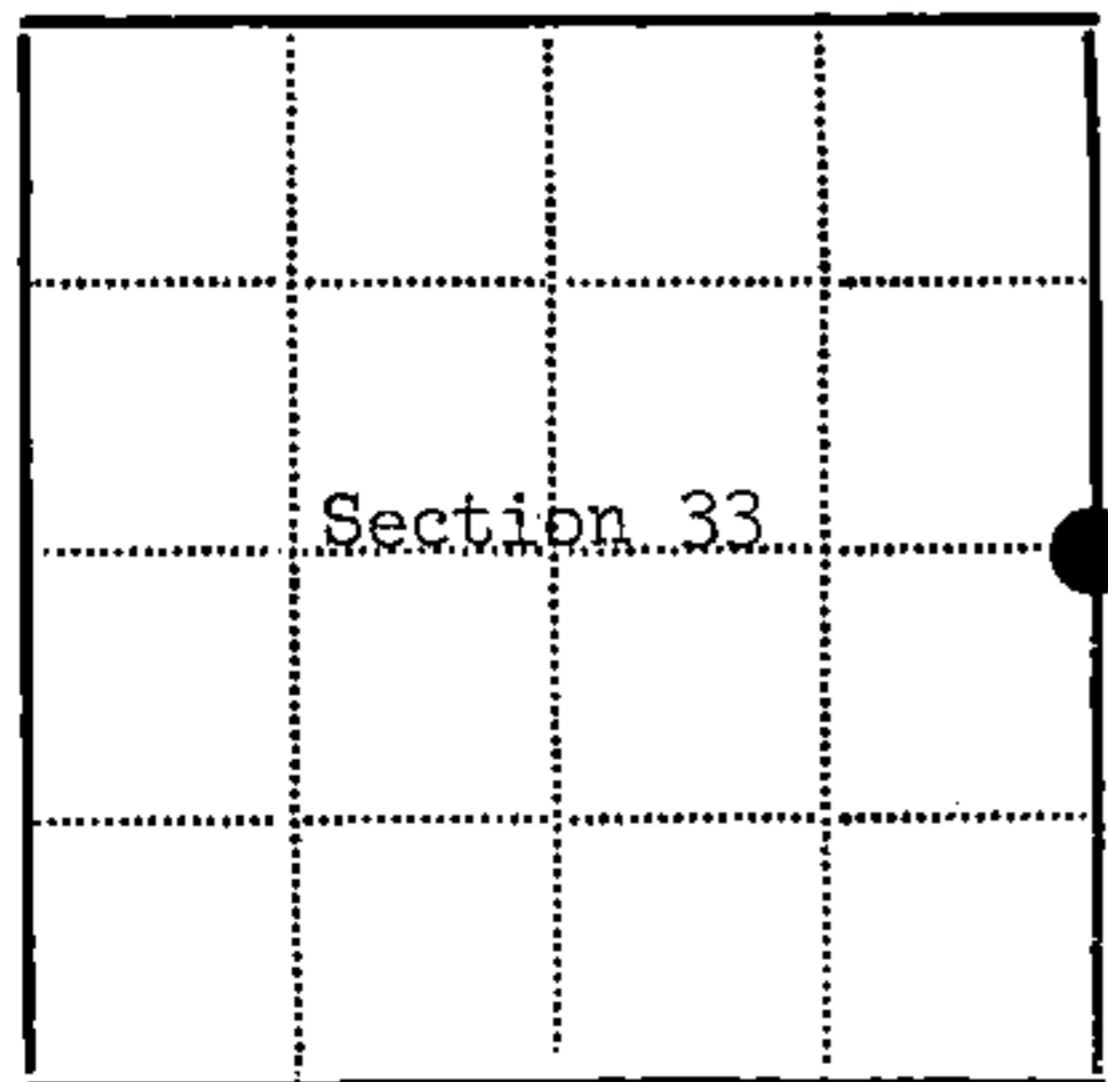

● - Corner monument restored
□ -

Resident witnesses.....

Dated at Rhinelander Wisconsin, this 13th day of 1983.

Signature Milo E. Stefan Title Land Surveyor
(County Surveyor, Registered Land Surveyor, or other duly authorized official)

Surveyors Registration No. RLS-1558

Office of Register of Deeds County of Forest

I hereby certify that the within instrument was filed in this office for record on the 13th day of September 1983, and was filed in Book No. Page No. of County Records.

Signature Eugene Skatym Title Register of Deeds

Township 35 North, Range 15 East, Section 33, Index No. X-13, Page No. B-7, P-66

43515332000

X13