


U. S. PUBLIC LAND SURVEY MONUMENT RECORD

INSTRUCTIONS: This record shall show the location of the corner and shall include all of the following nine elements (a through i).

(a) Identify the corner by reference to the U.S. public land survey system.

○ = Corner monument restored.

Quarter Corner to Sections 2 and 11, T.35N., R.16E.

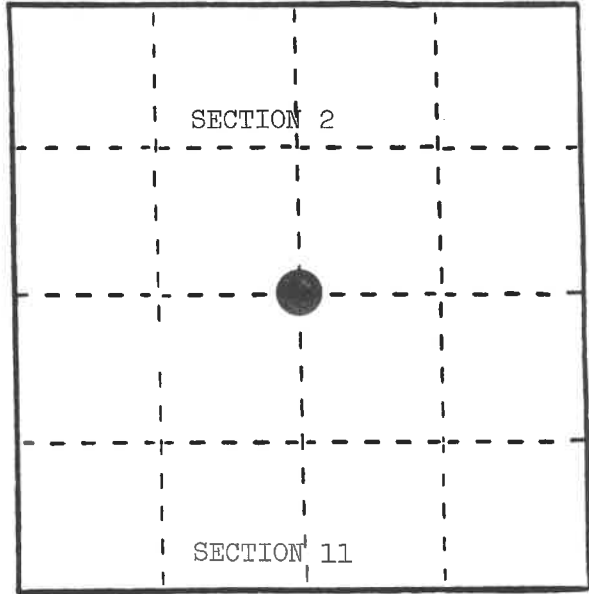

REGISTER'S OFFICE  
 Forest County, Wis.  
 Received for record this 17<sup>th</sup> day  
 of February A.D., 1988 at  
10:00 o'clock AM and recorded  
 in Vol. CORNER RESTORATIONS  
 page 5-19  
*Paul A. Schenk*  
 Register of Deeds

(b) Describe any record evidence, monument evidence, occupational evidence, testimonial evidence or any other material evidence you considered, and whether the monument was found or placed.

In 1858, James McBride set post with the following BTs: Linn, 16", N.59°E., 14 links; Sugar, 14", S.27°W., 24 links.

In 1928, Goodman Co. found old 4" Maple post partly rotted (set by Wells Co.). Set 4" Hemlock post and 2'-8" flue pipe 1' high. Found 16" Linden at N.59°E., 14 links, to be a stub.

In 1936, J. Hammes found iron pipe and placed a location tag on 4" Hemlock post alongside iron pipe.


In 1974, Resvick and Tallier found a 1" iron pipe with top of old post with Forest Service location tag stuck in top of pipe. Also found a 2" iron pipe alongside 1" iron pipe and post remains found in hole after removing pipe. Found no evidence of BTs.

In 1987, Alan Harrison found the corner as per Resvick and Tallier and noted that original Basswood BT is now a stump hole. Monumented post hole as best remaining evidence of corner location.

(c) In the plan view drawing below, provide reference ties to at least 4 witness monuments, or, if the location is within a municipality, to at least 2 witness monuments. (Witness monuments shall be made of concrete, natural stone, iron or other equally durable material.) Describe witness monuments.

(d) Show a plan view drawing depicting the relevant monuments and reference ties which is sufficient in detail to enable accurate relocation of the corner monument if the corner monument is disturbed. Indicate north.

1. 2½" x 36" aluminum monument with tablet stamped to identify the corner.
2. Sugar, 10", N.09°W., 29.30 feet
3. Basswood, 12", S.75°E., 19.54 feet
4. Sugar, 14", N.48°W., 58.42 feet
5. Steel Sign Post, 6', Southeast, 0.73 feet

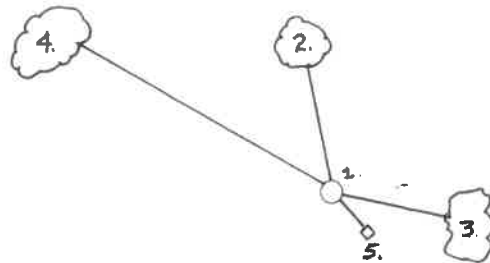

43516020027

(e) Describe any material discrepancy between the location of the corner as restored or reestablished and the location of that corner as previously restored or reestablished by distance and direction. Show the discrepancy on the plan view drawing under (d), above. Show the distances between the corner as previously restored or reestablished and (1) the corner as restored or reestablished, and (2) to at least 2 of the witness monuments shown on the drawing in (d), above.

None.

(f) Was the corner restored through acceptance of (1) an obliterated evidence location, or, (2) a found perpetuated location?

(2) a found perpetuated location.

(g&h) Was the corner reestablished through lost corner proportionate methods? If so, show the method, including the directions and distances to other public land survey corners used as evidence or used for proportioning in determining the corner location?

No.

(i) I, Alan D. Harrison  
(Type or print name) certify that the corner location shown on this record was determined by me or under my direction and control and that this U.S. Public Land Survey Monument Record is correct and complete to the best of my knowledge and belief.

Alan D. Harrison  
Signature

2/11/88  
Date

