

## CERTIFIED LAND CORNER RESTORATION

State of Wisconsin

County of Forest

ss.

I Jean F. Resvick, do hereby certify that on the 11th day of Sept., 1972, I found evidence of the Northeast Section corner of Section 10 Township 35 North, Range 16 East, Fourth Principal Meridian, as described hereon; and that from this evidence I established a new monument and accessories as described hereon to perpetuate the original location of this corner:

## Description of original monument and accessories and subsequent restorations:

Surveyed in 1858 by James McBride  
80.00 chains North between section 10 and 11, set post.  
Linn 16, bears N83W, 35 lks.  
Sugar 16, bears N50E, 31 links  
Sugar 8, bears S64E, 37 links  
Ironwood 10, bears S36W, 37 links


## Description of corner evidence found:

2 inch steel pipe, 20 inches above ground  
Old post point along side of pipe  
Basswood snag, 28 inch diam. with rotted out blaze and open face, bears N81W, 35 links  
Stump hole bears N50E, 31 links  
Stump hole bears S64E, 37 links

## Description of monument and accessories I established to perpetuate the original location of this corner:

Replaced 2 inch pipe found with 2 inch inside diam. galvanized iron pipe, 5 ft. long, filled with concrete, flanged on bottom with brass cap stamped.

From which the following blazed and scribed new bearing trees bear:

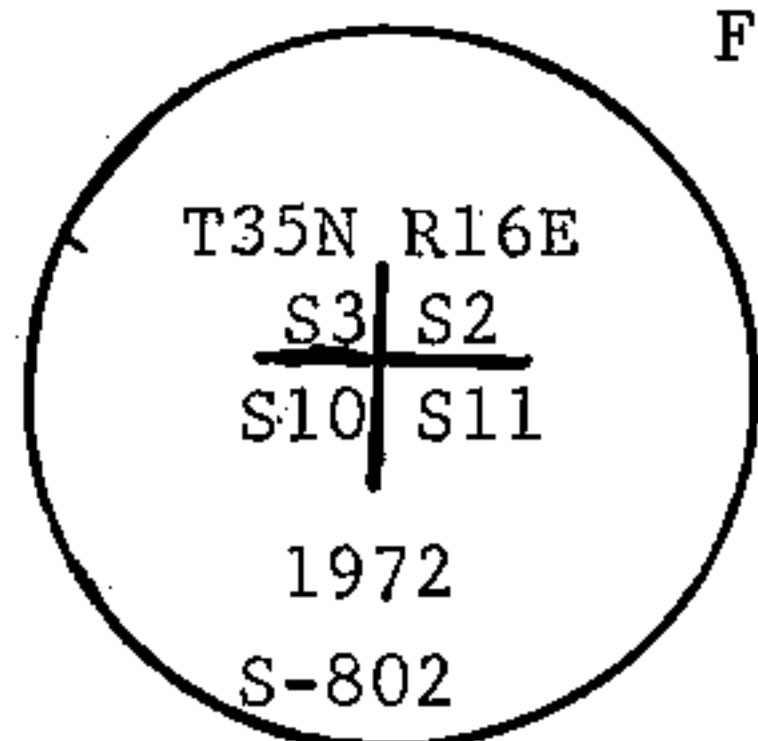

Maple 5, N24W, 13.50 ft.  
Yellow Birch 8, S14E, 17.88 ft.  
Basswood 9, S60W, 9.27 ft.  
Maple 7, N18W, 37.62 ft.

435160300007

Resident witnesses

Dated at Rhinelander Wisconsin, this 6th day of April, 1973.

Signature *Jean F. Resvick* Title Land Surveyor  
(County Surveyor, Registered Land Surveyor, or other duly authorized official)

Surveyors Registration No. S-802 DOCUMENT NUMBER 103127

Office of Register of Deeds County of Forest  
I hereby certify that the within instrument was filed in this office for record on the 10th day of April, 1973, and was filed in Book No. Page No. E-17 of County Records.

Signature *Eugene Stutzman* Title Register of Deeds

Township 35 North, Range 16 East, Section 10, Index No. E-17, Page No.

⊙ = Corner monument restored

□ =

E

17