

CERTIFIED LAND CORNER RESTORATION

State of Wisconsin

County of Forest

ss.

I Jean F. Resvick, do hereby certify that on the 18th day of September, 1974, I found evidence of the east quarter corner of Section 10 Township 35 North, Range 16 East, Fourth Principal Meridian, as described hereon; and that from this evidence I established a new monument and accessories as described hereon to perpetuate the original location of this corner:

Description of original monument and accessories and subsequent restorations:



Surveyed by James McBride August 1858
North between Sections 10 and 11, 40.00 chains set post for corner of sections 10 and 11
Elm, 10", S59°E, 28 lks
Elm, 10", N44°W, 5 lks

Description of corner evidence found:

2" steel pipe, 20" above ground
Remains of large elm N44°W, 5 lks with overgrowth of bearing tree blaze

Description of monument and accessories I established to perpetuate the location of this corner:

Replaced iron pipe with a 2 inch inside diameter, galvanized pipe 3 feet long, filled with concrete with a brass cap stamped T35N, R16E, 1/4, S10, S11, 1975, S-802
From which the following bear
Basswood, 20", S61°E, 74.44 feet
Basswood, 8", S66°W, 20.82 feet
Set steel sign post 0.5 ft NW of monument

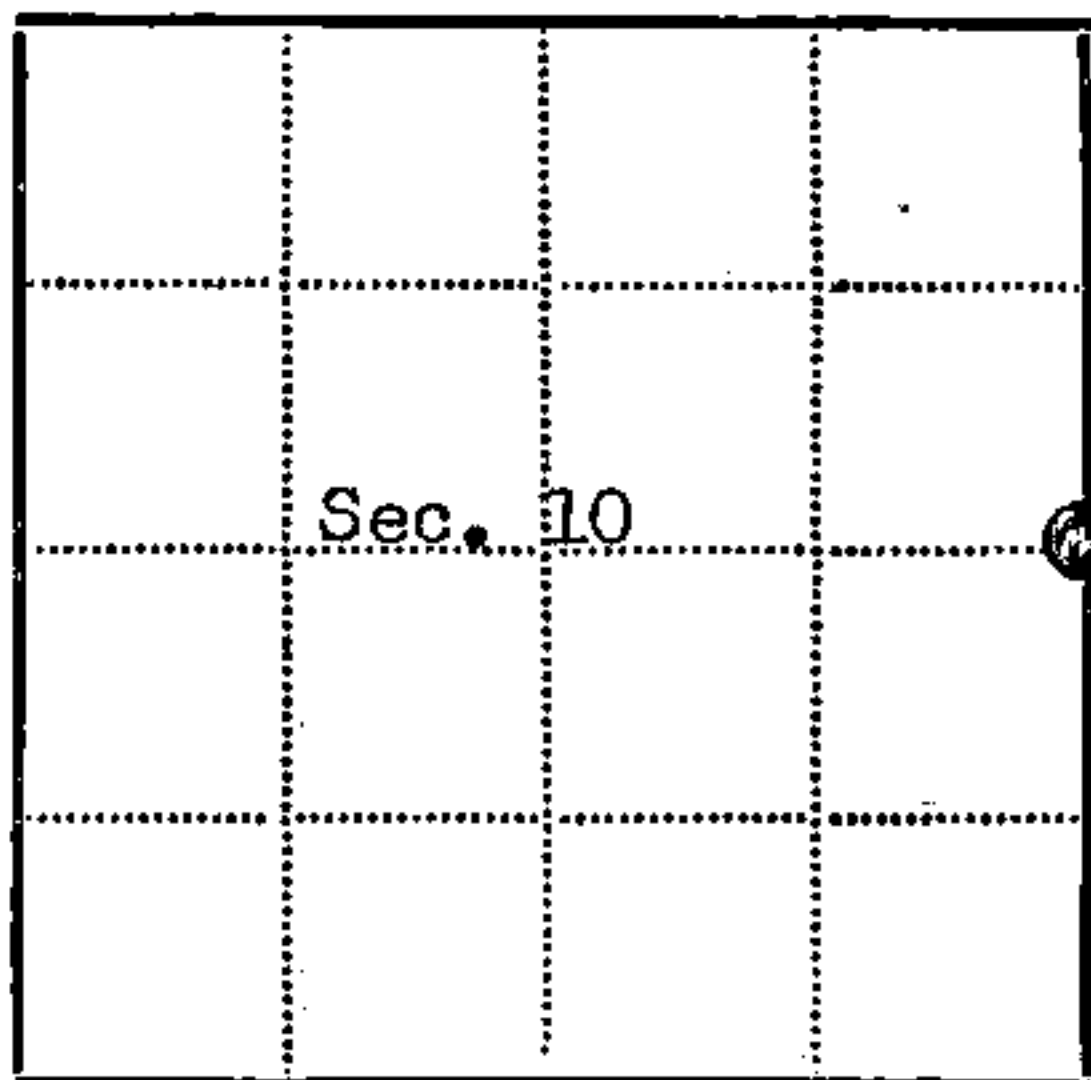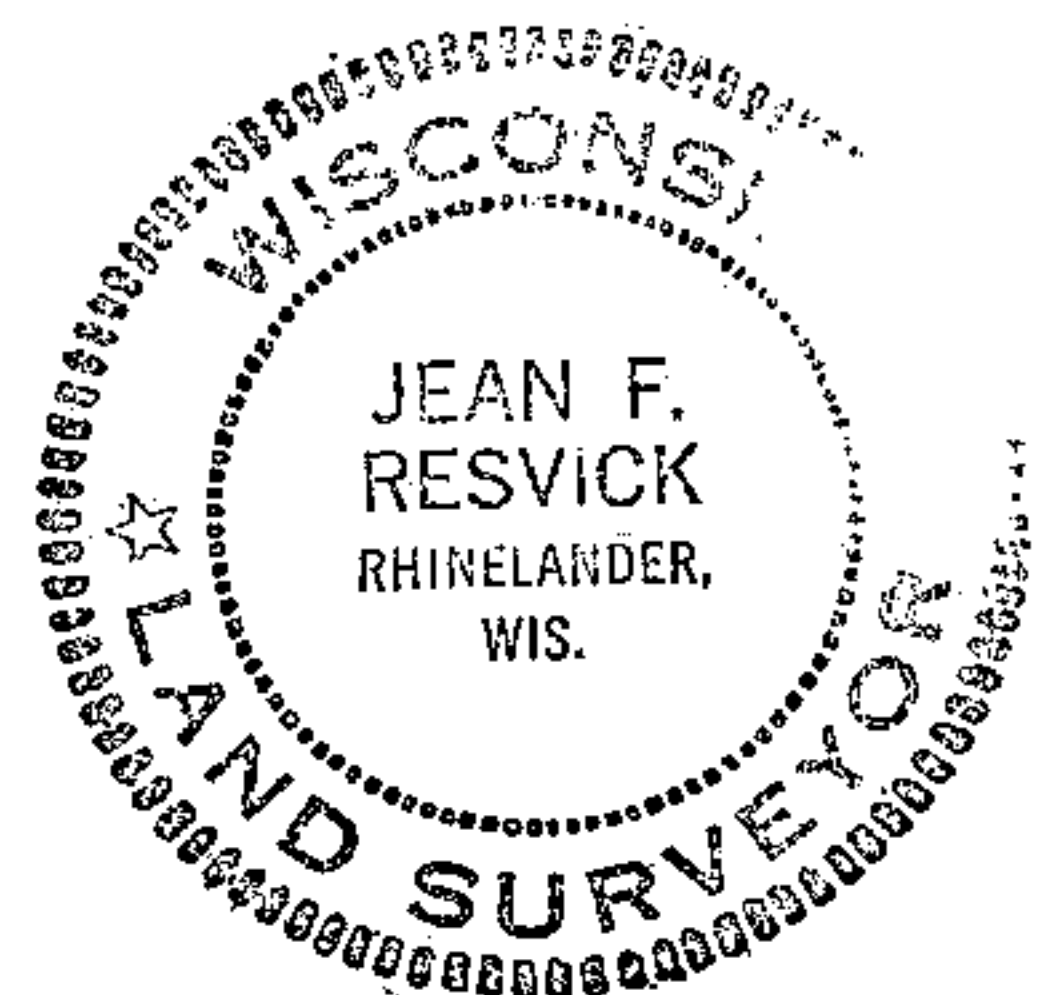

☉ - Corner monument restored
□ -

Resident witnesses

Dated at Rhinelander Wisconsin, this 20 day of March 1975.

Signature Jean F. Resvick Title Land Surveyor
(County Surveyor, Registered Land Surveyor, or other duly authorized official)

Surveyors Registration No. S-802 Document Number 106869

Office of Register of Deeds County of Forest

I hereby certify that the within instrument was filed in this office for record on the 31st day of March 1975, and was filed in Book No. Corner Page No. G-17 of County Records.

Signature Eugene Stetson Title Register of Deeds

Township 35 North, Range 16 East, Section 10, Index No. G-17, Page No.

43516 102000

G 17