

CERTIFIED LAND CORNER RESTORATION

State of Wisconsin }
 County of Forest } ss.

I Milo E. Stefan, do hereby certify that on the 17 day of December, 1979, I found evidence of the Southeast Section corner of Section 16 Township 35 North, Range 16 East, Fourth Principal Meridian, as described hereon; and that from this evidence I established a new monument and accessories as described hereon to perpetuate the original location of this corner:

Description of original monument and accessories and subsequent restorations:

Surveyed in 1858 by James McBride.
 North between sections 21 and 22, at 80.00 chains set post corner to sections 15, 16, 21 and 22.
 Tamarack 12", N42°W, 39 links
 W. Pine 12", N25°E, 10 links
 W. Pine 24", S83°E, 18 links
 W. Pine 14", S59°W, 10 links.

Description of corner evidence found:

2" X 24" iron pipe with post point along side from which remains of original bearing trees; Rotten Tamarack stump, N42°W, 39 links; Rotten W. Pine stump N25°E, 10 links; Rotten W. Pine stump, S83°E, 18 links; Rotten W. Pine stump S59°W, 10 links.

Description of monument and accessories I established to perpetuate the location of this corner:


Replaced the iron pipe and post point with a 2 inch inside diameter galvanized iron pipe, 30 inches long, concrete filled, with brass tablet stamped as follows: T35N, R16E, S15, S16, S21, S22, 1979, S-1558.

Blazed and scribed the following new bearing trees:

Balsam Fir, 11", N43°E, 23.06 feet
 White Pine, 13", S82°W, 70.81 feet
 White Pine, 11", N31°W, 72.60 feet
 Tamarack, 6", N1°E, 62.60 feet
 Steel sign post, southeast, 1.0 feet

DOCUMENT NO.

119853

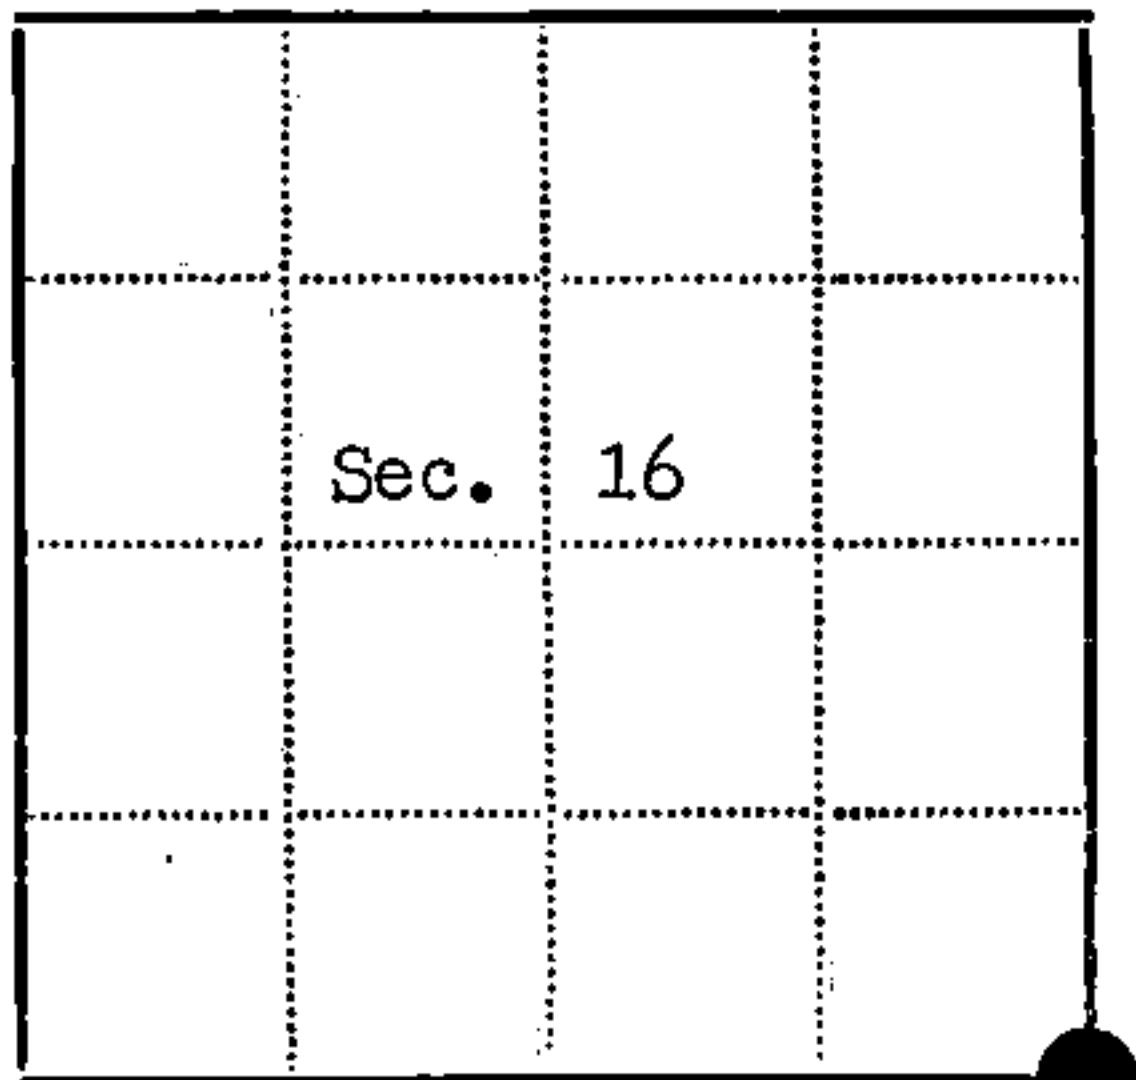

● - Corner monument restored
 □ -

Resident witnesses.....

Dated at Laona Wisconsin, this 18 day of December 1979.

Signature *Milo E. Stefan* Title Land Surveyor
 (County Surveyor, Registered Land Surveyor, or other duly authorized official)

Surveyors Registration No. S-1558

Office of Register of Deeds County of Forest

I hereby certify that the within instrument was filed in this office for record on the 2nd day of June 1981, and was filed in Book No. Page No. of County Records.

Signature *Eugene Stategoy* Title Register of Deeds

Township 35 North, Range 16 East, Section 16, Index No. N-13, Page No.

43516160000

N13