

CERTIFIED LAND CORNER RESTORATION

State of Wisconsin }
County of Forest } ss.

I Milo E. Stefan, do hereby certify that on the 17 day of December, 1979, I found evidence of the East Quarter corner of Section 21 Township 35 North, Range 16 East, Fourth Principal Meridian, as described hereon; and that from this evidence I established a new monument and accessories as described hereon to perpetuate the original location of this corner:

Description of original monument and accessories and subsequent restorations:

Surveyed in 1858 by James McBride.
40.00 chains north between sections 21 and 22.
Set 1/4 section post.
Cedar 8", S88°E, 20 links
Cedar 12", S84°W, 4 links.

Description of corner evidence found:

4" X 4" Squared wood post with axle shaft
New Bt's 15-20 years ago, origin unknown
Tamarack 6", N.4°E, 10.63 feet
Tamarack 11", S.48°W, 5.96 feet
Call to creek north, fits well.
Cedar stump 383°E., 13.2 feet

Description of monument and accessories I established to perpetuate the location of this corner:

Replaced wood post with a 2 inch inside diameter galvanized iron pipe, concrete filled, with brass tablet stamped:
T35N, R16E, 1/4, S21, S22, 1979, S-1558.


Blazed and scribed the following new bearing trees:

Tamarack, 6", N4°E, 10.63 feet
Tamarack, 6", S29°E, 10.72 feet
Tamarack, 11", S48°W, 5.96 feet
Steel sign post, S45°W, 1.5 feet



DOCUMENT NO. 124233

43516212000

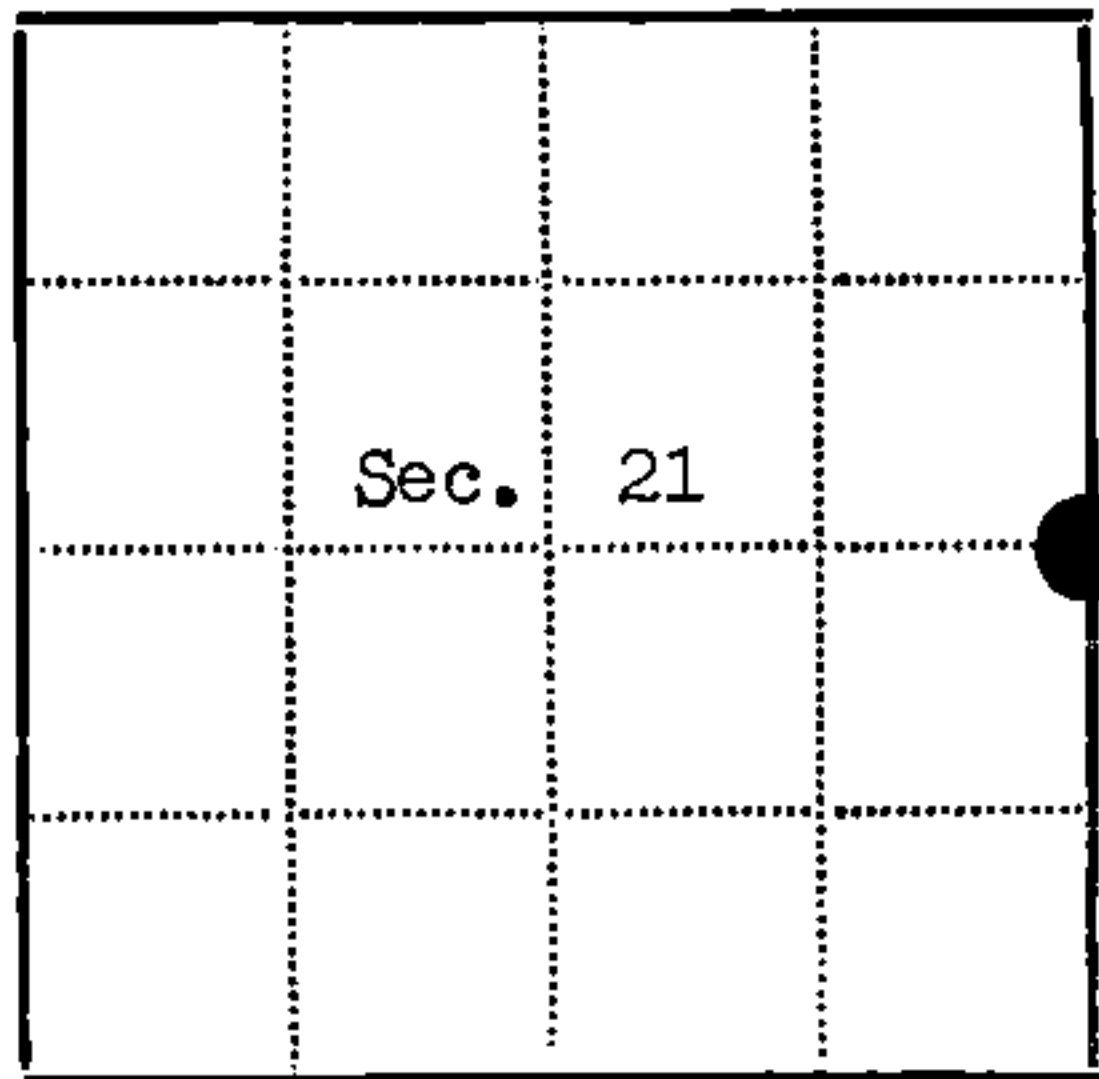

● - Corner monument restored
□ -

Resident witnesses.....

Dated at Laona Wisconsin, this 18 day of December 1979.

Signature Milo E. Stefan Title Land Surveyor
(County Surveyor, Registered Land Surveyor, or other duly authorized official)

Surveyors Registration No. S-1558

Office of Register of Deeds County of Forest

I hereby certify that the within instrument was filed in this office for record on the 15th day of September 1983, and was filed in Book No. Page No. of County Records.

Signature Eugene Stearns Title Register of Deeds

Township 35N, Range 16E, Section 21, Index No. P-13, Page No.

P17