


U. S. PUBLIC LAND SURVEY MONUMENT RECORD

INSTRUCTIONS:

This record shall show the location of the corner and shall include all of the following nine elements (a through i).

- (a) Identify the corner by reference to the U.S. public land survey system.
- = Corner monument restored.

Quarter corner to sections 26-35, T.35N., R.16E., Forest County, Wisconsin.

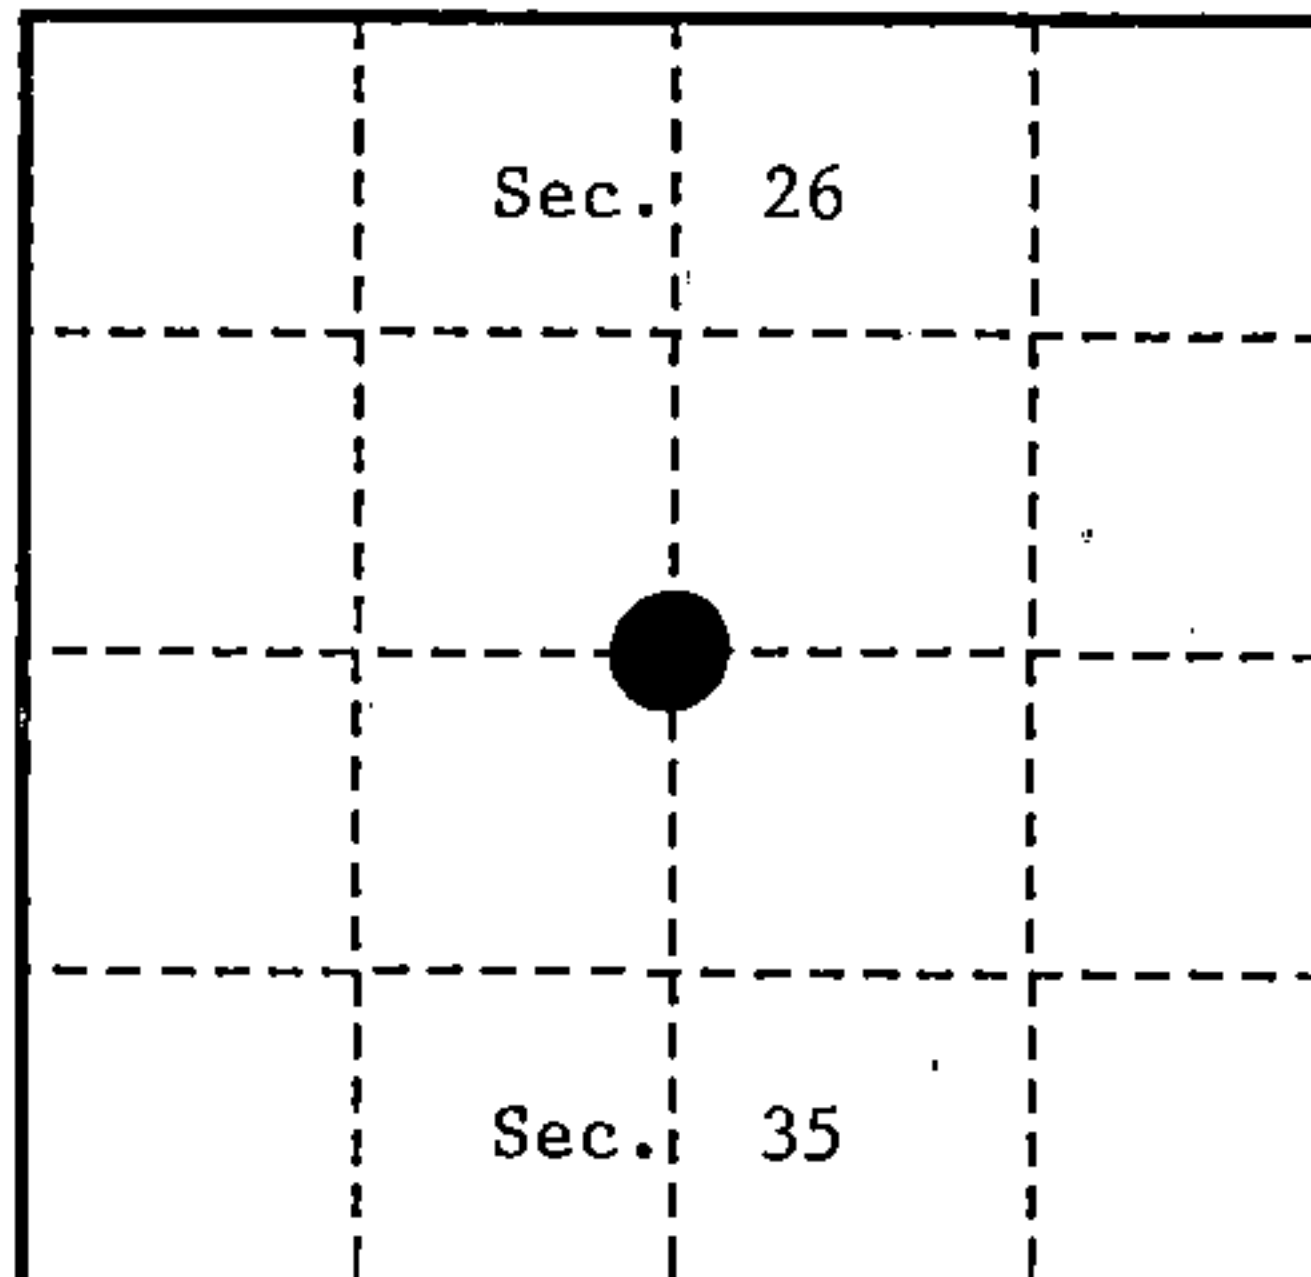

- (b) Describe any record evidence, monument evidence, occupational evidence, testimonial evidence or any other material evidence you considered, and whether the monument was found or placed.

In 1858, James McBride set a wood post with the following B.T.'s: Hemlock, 24", S.51°W., 24 links (15.84 feet); Elm, 14", N.54°E., 18 links (11.88 feet).


In 1935, Dangremond (C.C.C.) found square wood post 24" high, set location tag on a 5" maple, N.53W., 30 links (19.80 feet).

In 1990, Alan D. Harrison (R.L.S.) searched and found no evidence of corner or B.T.'s. Corner restored by single proportionate measure.

- (c) In the plan view drawing below, provide reference ties to at least 4 witness monuments, or, if the location is within a municipality, to at least 2 witness monuments. (witness monuments shall be made of concrete, natural stone, iron or other equally durable material.)

- (d) Show a plan view drawing depicting the relevant monuments and reference ties which is sufficient in detail to enable accurate relocation of the corner monument if the corner monument is disturbed. Indicate north.

- 2 1/2" x 36" aluminum monument with tablet stamped to identify the corner.
- Black Cherry, 8", N.32°E., 64.68 feet.
- Sugar, 16", S.18°W., 51.67 feet.
- Black Cherry, 7", N.47°W., 25.20 feet.
- Steel Sign Post, 6', West, 0.68 feet.

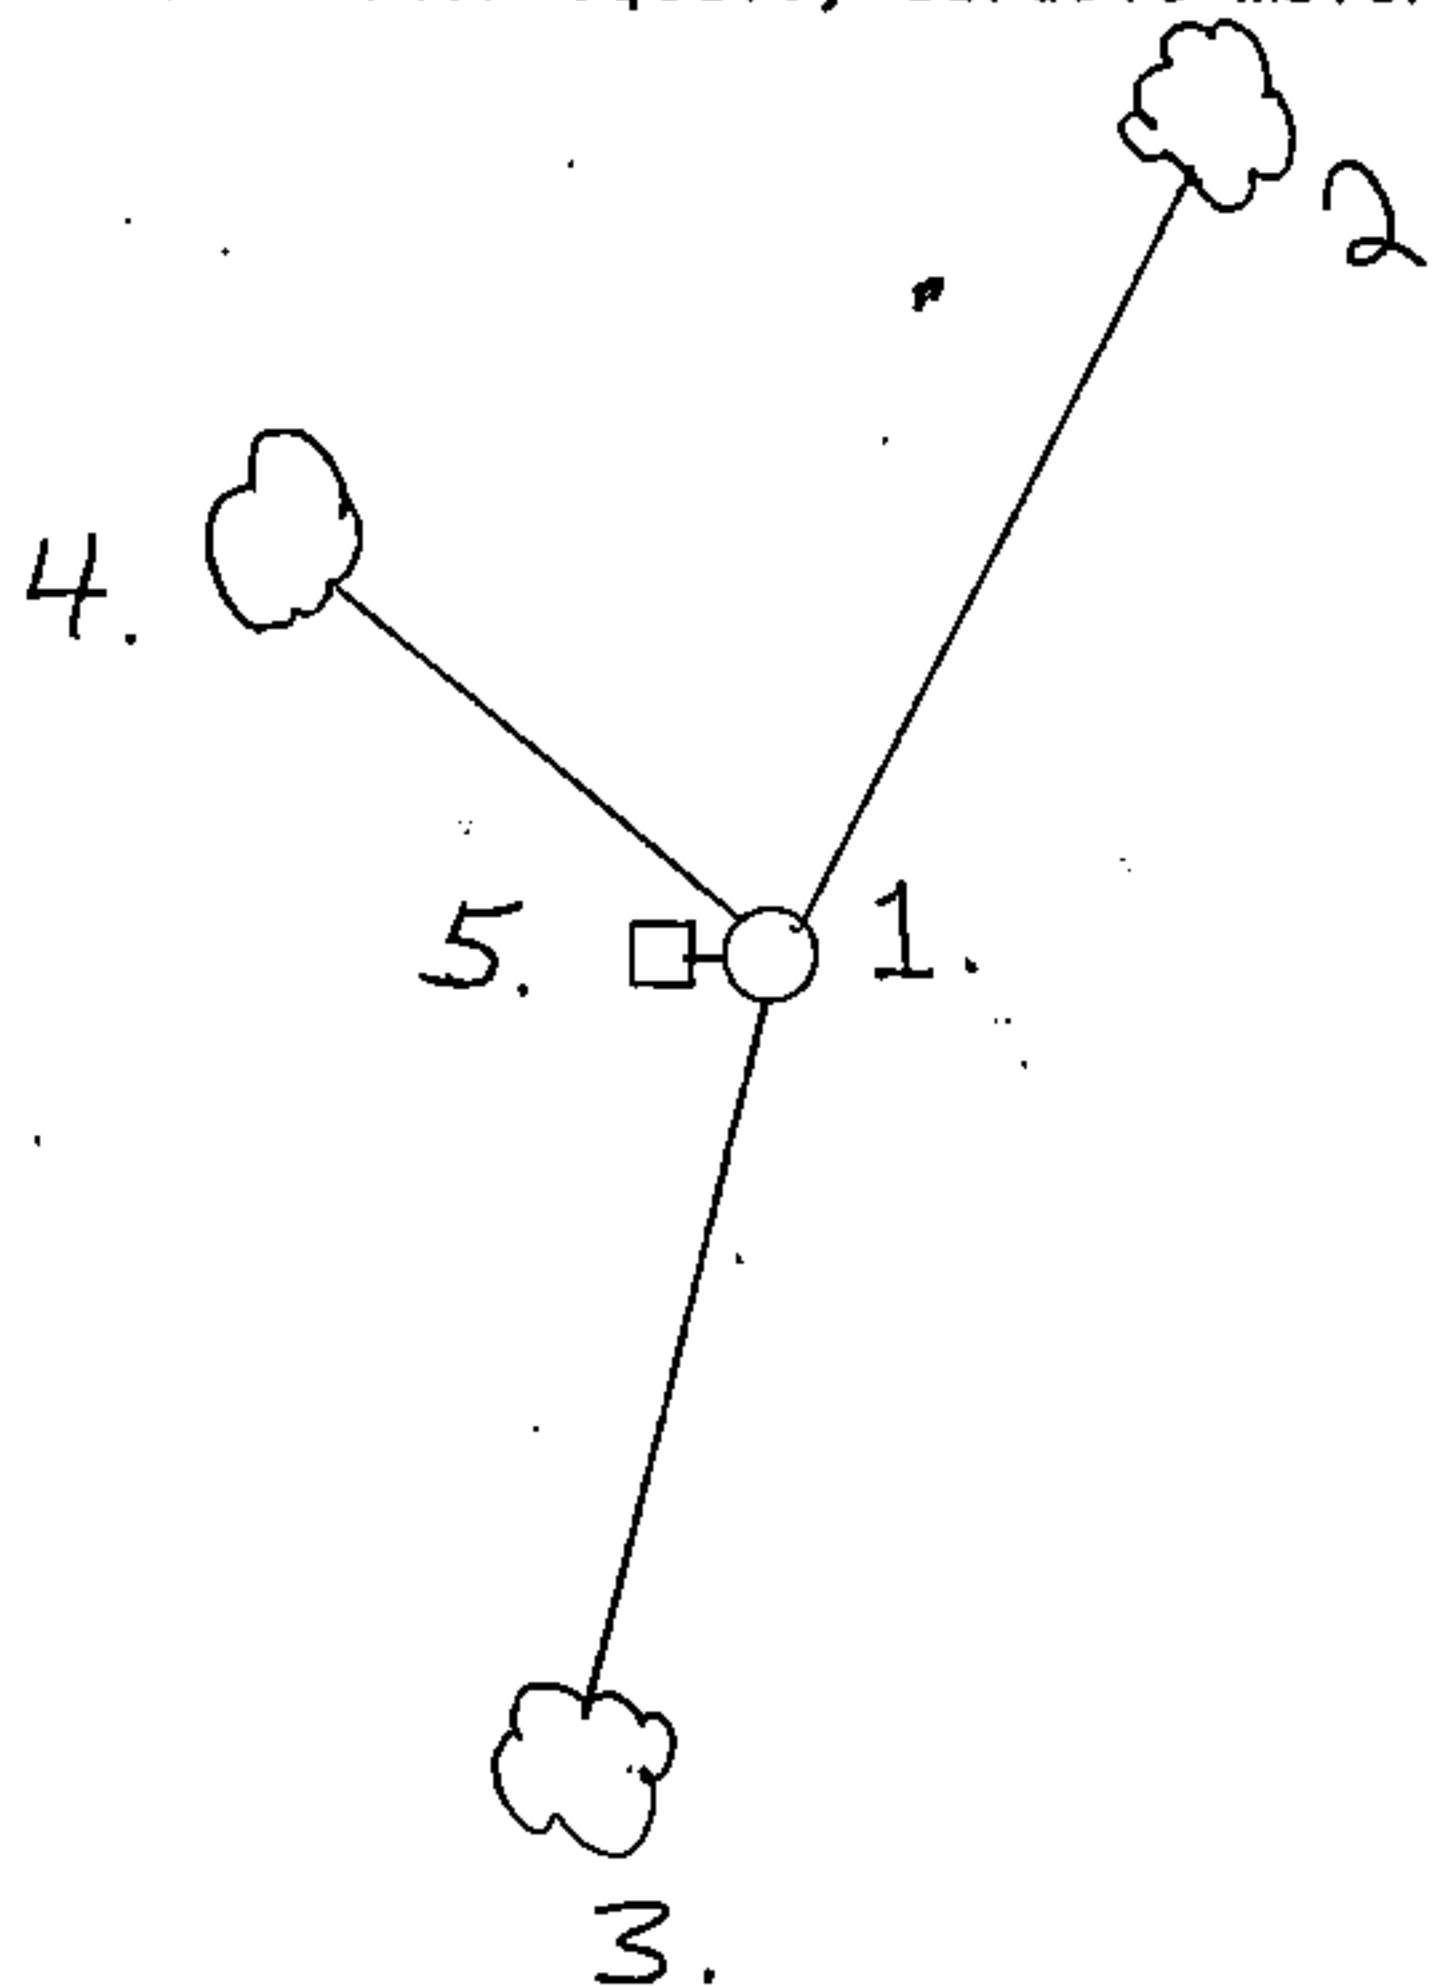

REGISTER'S OFFICE  
 Forest County, Wis.  
 Received for record this 8th day  
 of April A.D., 1991 at  
1:15 o'clock P.M. and recorded  
 in Vol. CORNER RESTORATIONS  
 page V-19

*Paul Aschmussen*  
 Register of Deeds

4351626 0020

61-1

