

CERTIFIED LAND CORNER RESTORATION

State of Wisconsin }
County of Forest } ss.

I Milo E. Stefan, do hereby certify that on the 17 day of December, 19 79, I found evidence of the East Quarter corner of Section 29 Township 35 North, Range 16 East, Fourth Principal Meridian, as described hereon; and that from this evidence I established a new monument and accessories as described hereon to perpetuate the original location of this corner:

Description of original monument and accessories and subsequent restorations:

Surveyed in 1858 by James McBride
40.00 set $\frac{1}{4}$ section post.
Sugar 8", N50°E, 20 links
Sugar 10", N20°W, 20 links.

Description of corner evidence found:

Wood post with location post, very rotten and fallen from which evidence of original bearing trees remains N20°E, 20 links.


Description of monument and accessories I established to perpetuate the location of this corner:

Replaced wood post with a 2 inch inside diameter, galvanized iron pipe, 3 feet long in mound of stone with tablet stamped:
T35N, R16E, $\frac{1}{4}$, S28, S29, 1979, S-1558.

Blazed and scribed the following new bearing trees:

Rock Elm 6", N4°W, 25.82 feet
White Spruce 10", N63°E, 11.30 feet
Rock Elm 6", S51°W, 25.79 feet
Steel sign post, southeast, .50 feet

DOCUMENT NO.
119857

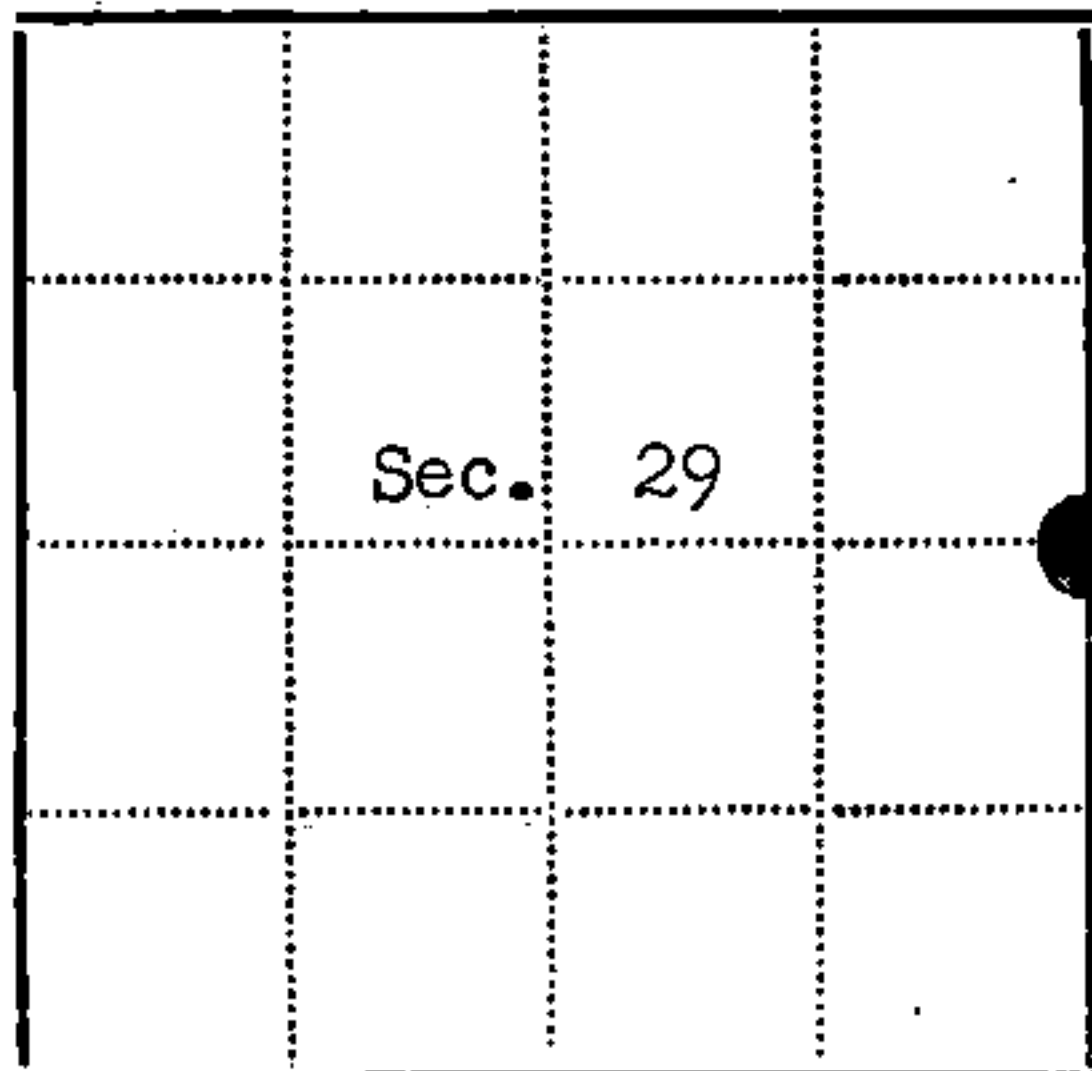

● - Corner monument restored
□ -

Resident witnesses.....

Dated at Laona Wisconsin, this 18 day of December 19 79.

Signature Milo E. Stefan Title Land Surveyor
(County Surveyor, Registered Land Surveyor, or other duly authorized official)

Surveyors Registration No. S-1558

Office of Register of Deeds County of Forest

I hereby certify that the within instrument was filed in this office for record on the 2nd day of June 19 81, and was filed in Book No. Page No. of County Records.

Signature Eugene Stutzman Title Register of Deeds

Township 35N, Range 16E, Section 29, Index No. T-9, Page No.

43516 29 2000

1
6