

U. S. PUBLIC LAND SURVEY MONUMENT RECORD


INSTRUCTIONS:

This record shall show the location of the corner and shall include all of the following nine elements (a through I).

- (a) Identify the corner by reference to the U.S. public land survey system.
 O = Corner monument restored.
 Quarter Corner between Sections 29 and 30,
 T.35N. R.16E., Forest County, Wisconsin

 State Plane Coordinates, Wisconsin North Zone
 N- 119516.58431
 E- 2345990.46199

 Geographic Coordinates
 N- 45-29-05.40961
 W- 88-31-41.51216

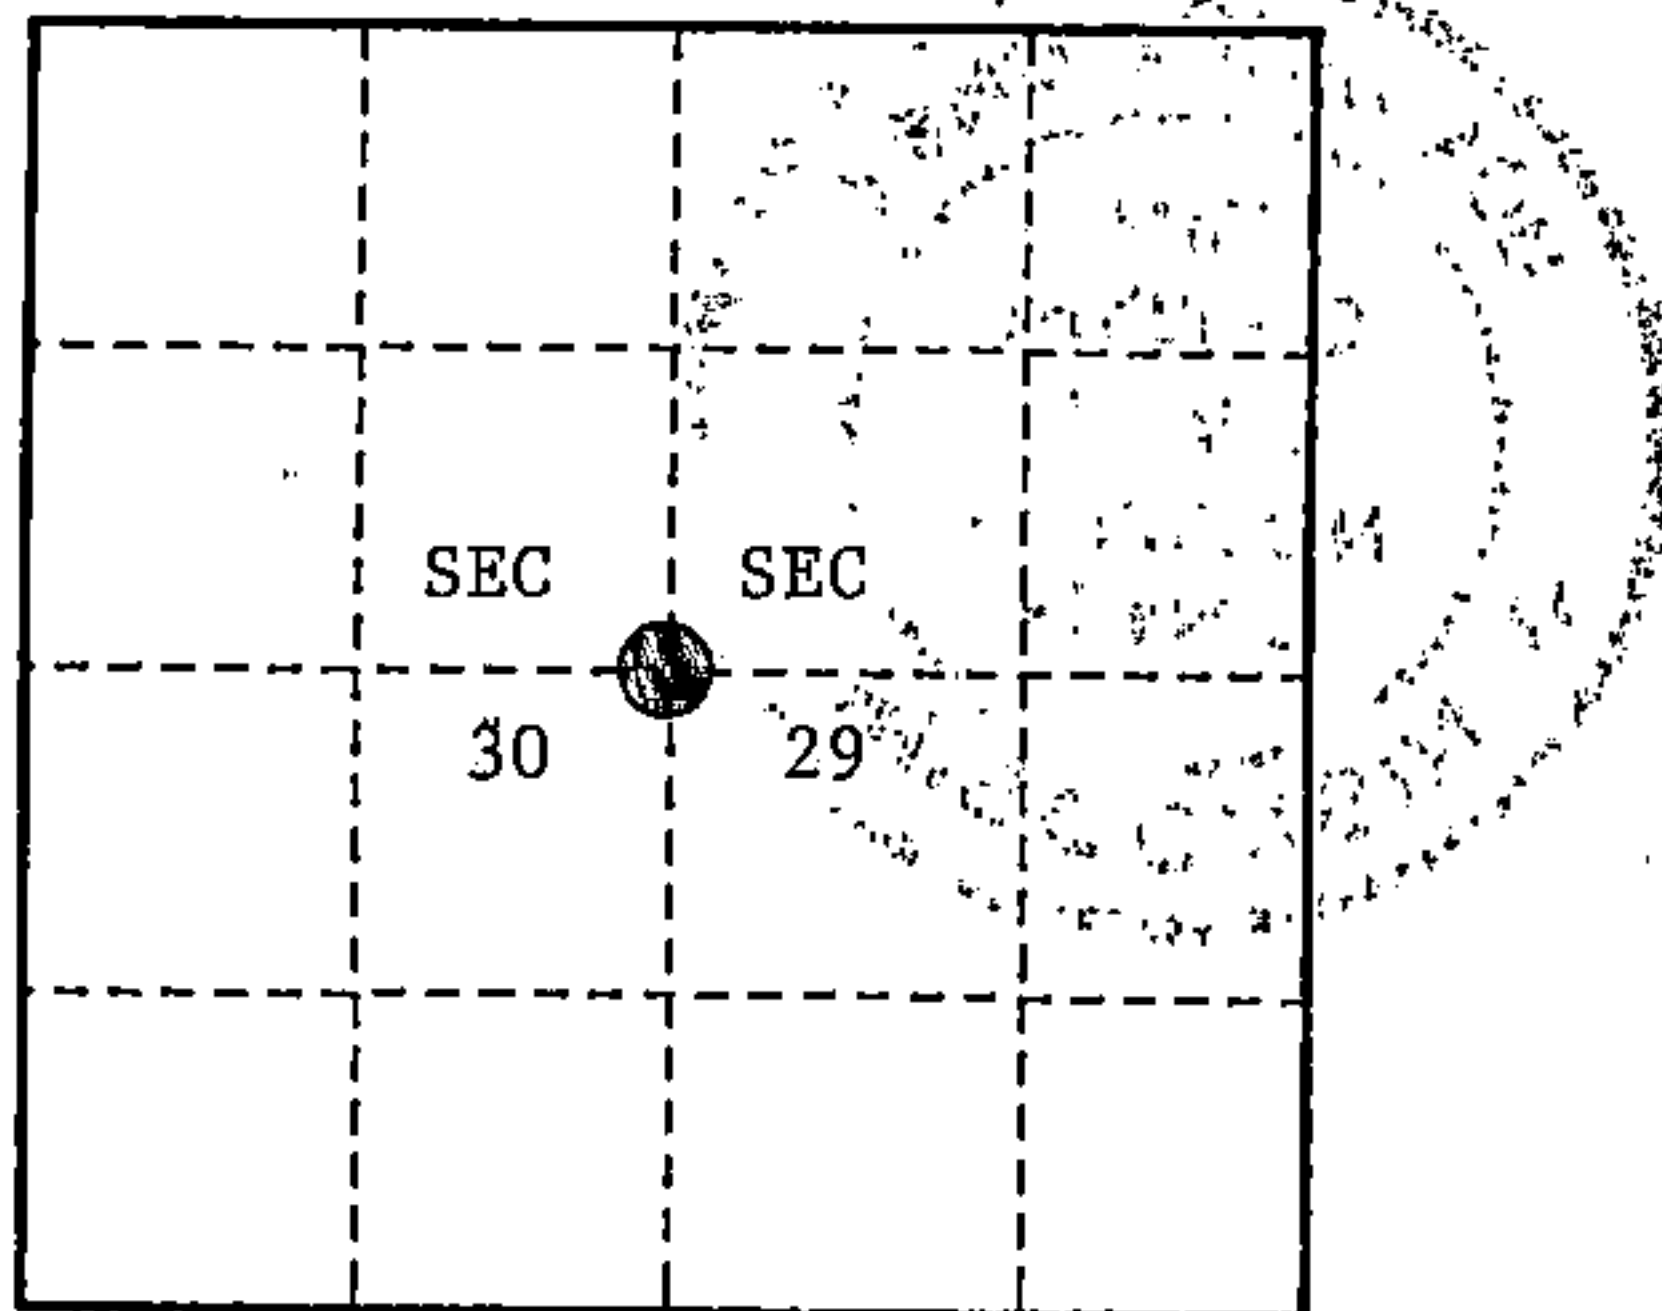


- (b) Describe any record evidence, monument evidence, occupational evidence, testimonial evidence or any other material evidence you considered, and whether the monument was found or placed.
 Original Survey in 1858 by James McBride. Set wood post from which the following bear: Black Ash, 7", S.35°W., 14 lks., Cedar, 8", N.69°E., 6 lks. South, 22.00 chains stream 15 lks. wide runs Northeast.

In 1995, Alan Harrison, RLS with the Forest Service, established Global Positioning Satellite control on the Northeast Section Corner of Section 30 and the Southeast Section Corner of Section 30: Using this control and original calls, could not recover any corner evidence. Reestablished the corner position at mid-point and on line between the Northeast and Southeast Section Corners of Section 30. At the corner position, set a 2½"x36" aluminum pipe monument with an aluminum cap stamped to identify the corner. Blazed and scribed new bearing trees as listed below.

- (c) In the plan view drawing below, provide reference ties to at least 4 witness monuments, or, if the location is within a municipality, to at least 2 witness monuments. (witness monuments shall be made of concrete, natural stone, iron or other equally durable material.)

- (d) Show a plan view drawing depicting the relevant monuments and reference ties which is sufficient in detail to enable accurate relocation of the corner monument if the corner monument is disturbed. Indicate north.

1. 2½"x36" aluminum monument with cap stamped to identify corner
2. Aspen, 12", N.67°E., 3.64 feet
3. Black Ash, 5", S.16°E, 18.12 feet
4. Black Ash, 5", S.12°W, 8.73 feet
5. Steel Sign Post, 0.90 feet Southeast of monument

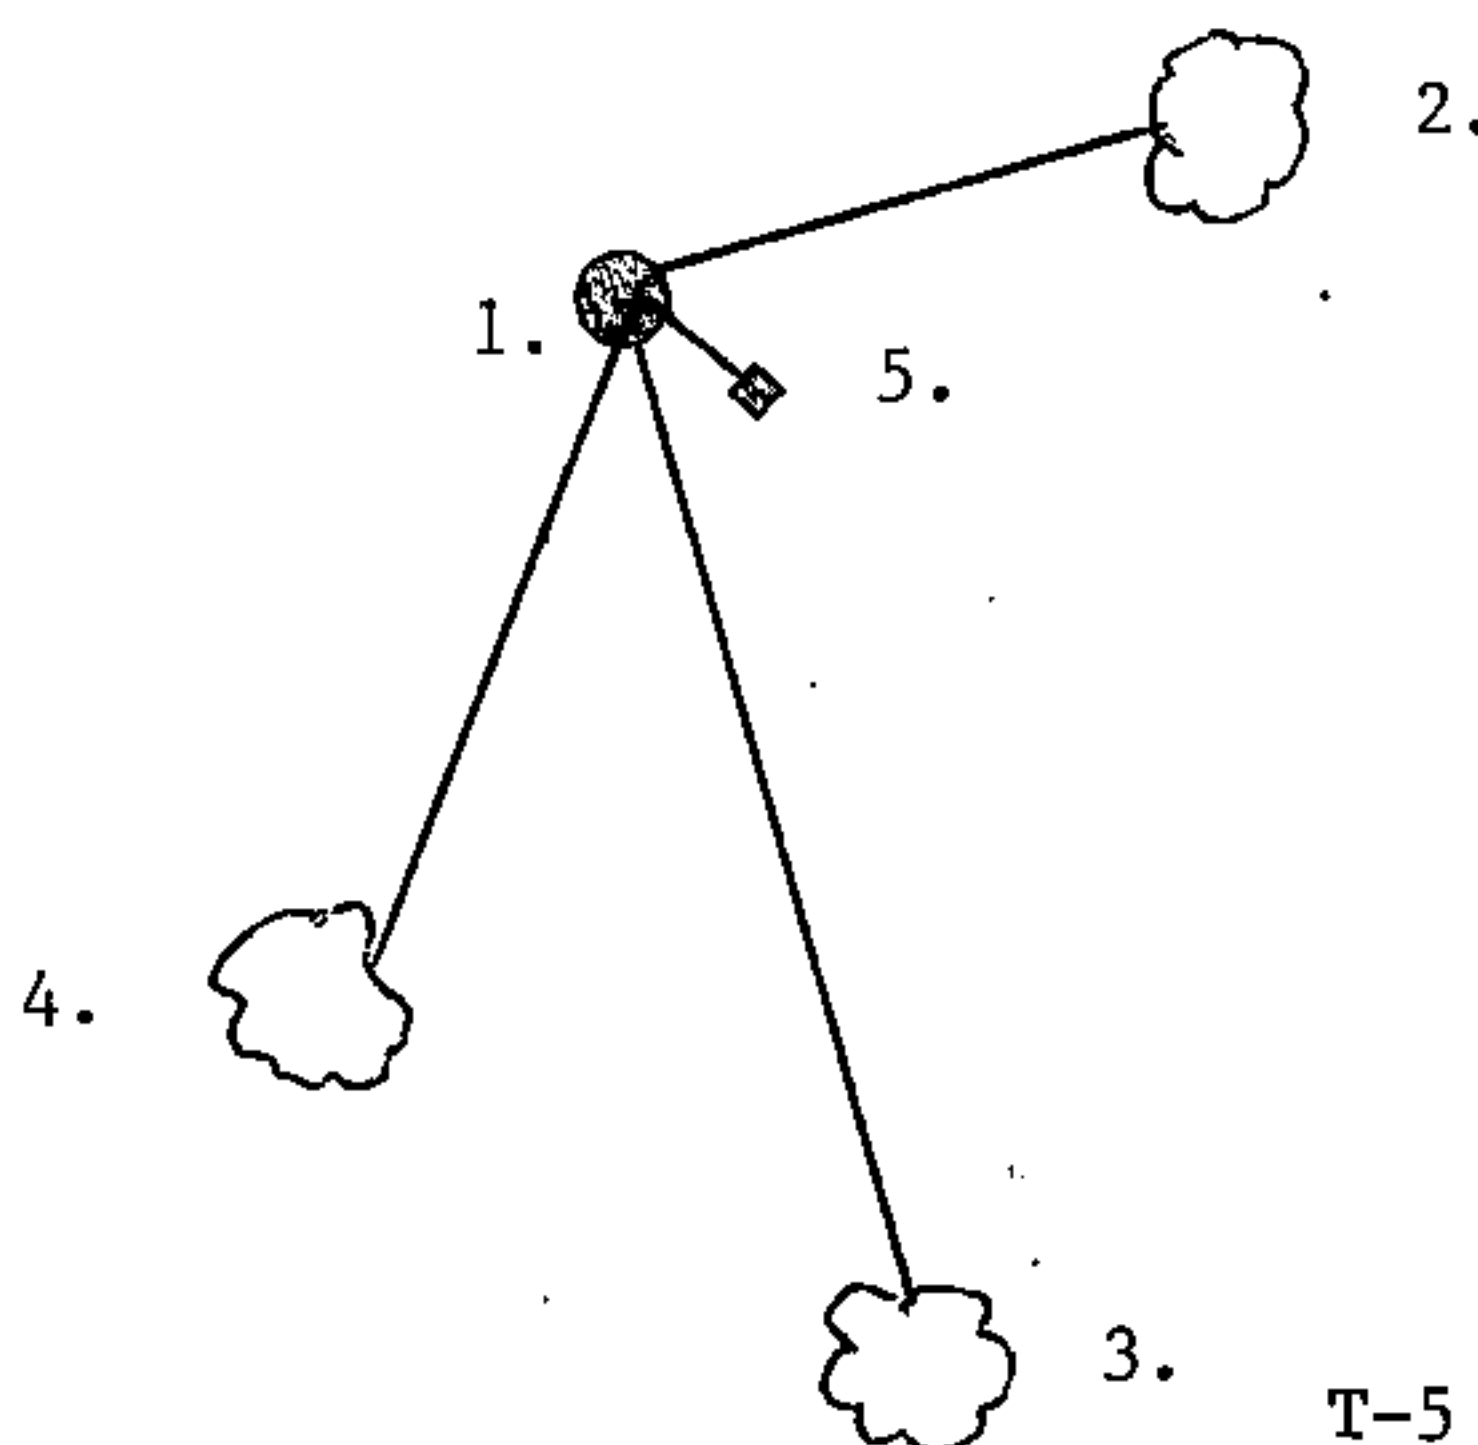

(e) Describe any material discrepancy between the location of the corner as restored or reestablished and the location of that corner as previously restored or reestablished by distance and direction. Show the discrepancy on the plan view drawing under (d), above. Show the distances between the corner as previously restored or reestablished and (1) the corner as restored or reestablished, and (2) to at least 2 of the witness monuments shown on the drawing in (d), above.


None

(f) Was the corner restored through acceptance of (1) an obliterated evidence location, or, (2) a found perpetuated location?


No

(g & h) Was the corner reestablished through lost corner proportionate methods? If so, show the method, including the directions and distances to other public land survey corners used as evidence or used for proportioning in determining the corner location?

Yes

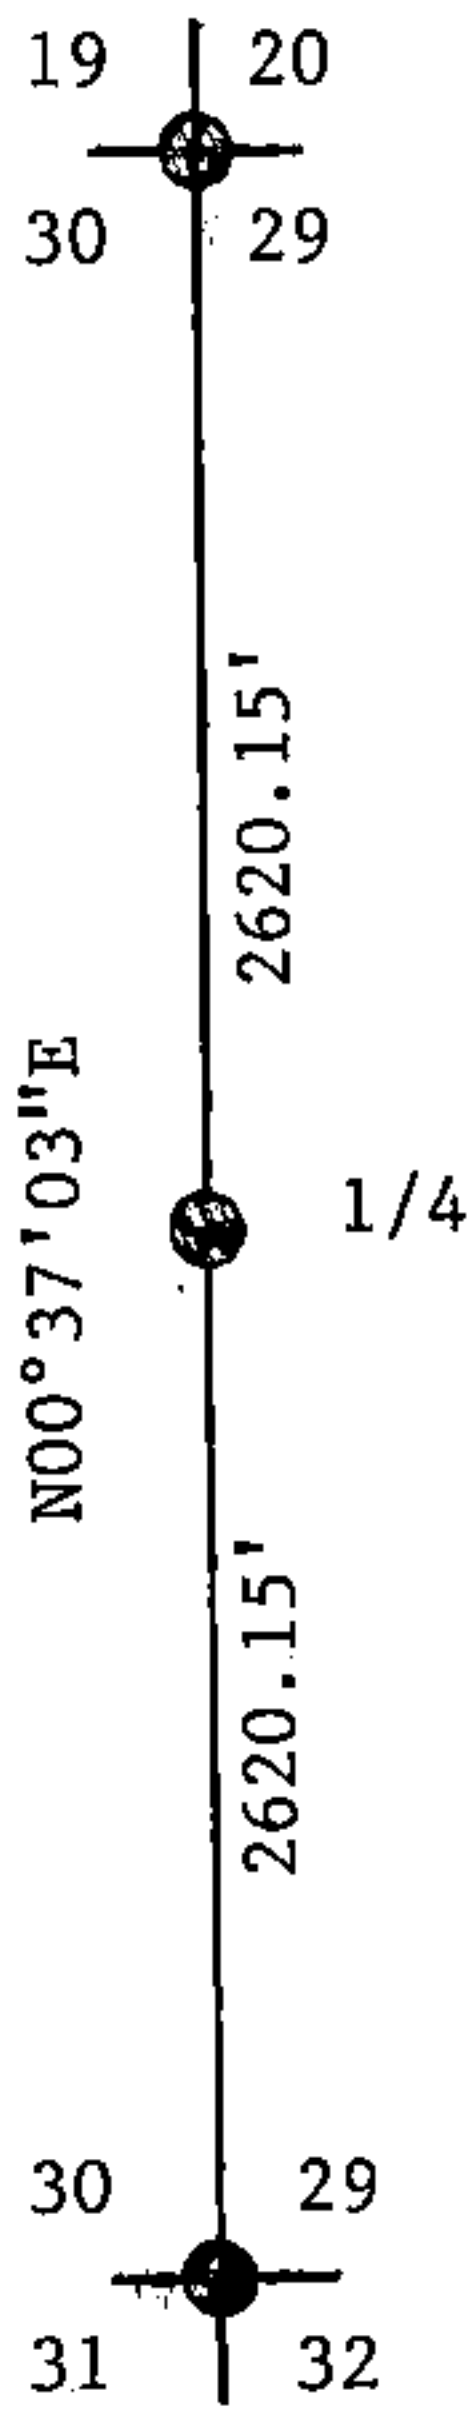

REGISTER'S OFFICE
 Forest County, Wis.
 Received for record this 30th day
 of November, A.D., 1995 at
1:30 o'clock P.M. and recorded
 in Vol Corner Restorations
 page 35-16-1-5
[Signature]
 Register of Deeds

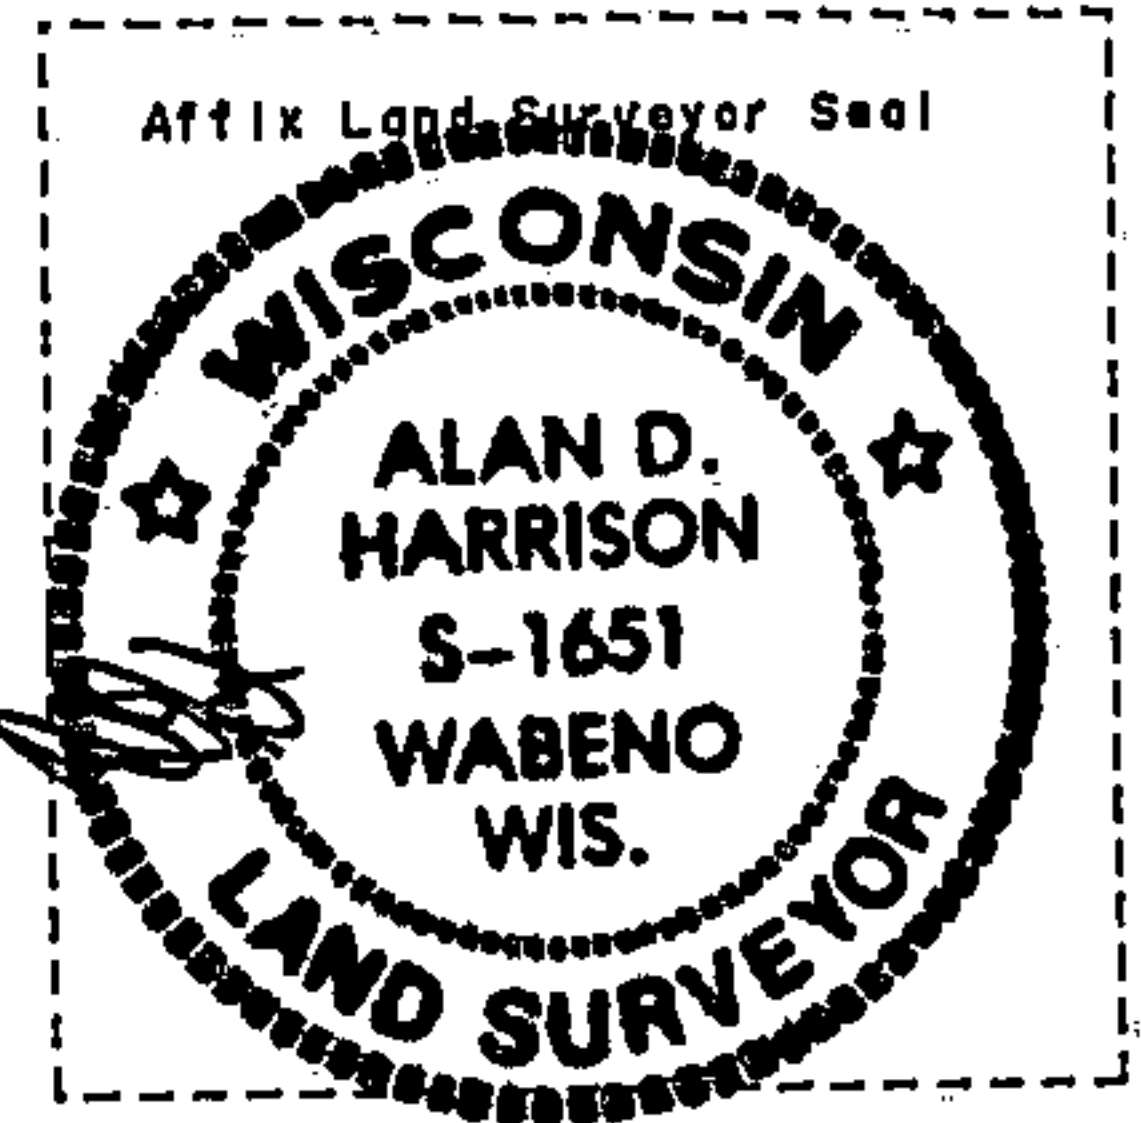

(1) I, Alan D. Harrison
 (type or print name) certify that the corner location shown
 on this record was determined by me or under my direction and
 control and that this U.S. Public Land Survey Monument Record is
 correct and complete to the best of my knowledge and belief.

[Signature] _____ 11/28/95
 Signature Date

CERTIFICATE READY FOR FILING:

[Signature] _____
 District Ranger