


CERTIFIED LAND CORNER RESTORATION

Index No. **B 1**

State of Wisconsin } ss.  
County of Forest

I Philip T. Hansen, do hereby certify that on the 11th day of December, 1974, I found evidence of the N-1/16 corner of Sections 1 & 6 Township 36, North, Range 11 & 12 East, Fourth Principal Meridian, as described hereon; and that from this evidence I established a new monument and accessories as described hereon to perpetuate the original location of this corner.

Resident witnesses:

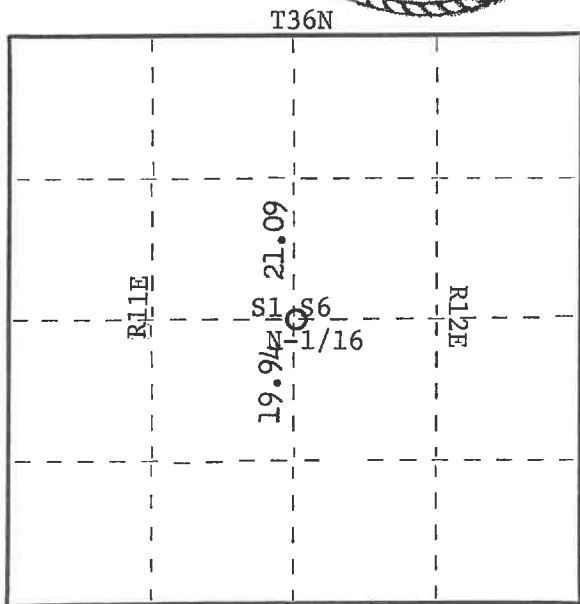

○ = Corner monument restored.

History of original corner establishment:

Original survey established by Wm. E. Dougherty in 1859, Section Corners and 1/4 corner. Retracement survey made by H.C. Lawrence in 1957. His notes indicate he ran a line from corner of Sec. 1-6-31 & 36 South 1°30' East to 1/4 corner, where he recovered a 4" squared and scribed stake and a bearing tree which checked the original notes. Measurement on this line fell 10 links short of the original. Set new 1/16 corner 21.09 chains south of Twp. corner and 19.94 chains north of 1/4 corner. B.T. blazed and scribed Y. birch 20" S48E 37 links; sugar 12 S2W 7 links.


Description of corner evidence found:

Recovered 4" cedar post, squared and scribed S1 N-1/16; S6 N-1/16 - in good condition.  
1" iron pipe set next to this post.  
Recovered B.T.'s Yellow birch 22" S52E 38 links Scribed N-1/16 B.T.  
Sugar maple 15" South 7½ links

Description of monument and accessories I established to perpetuate the original location of this corner.

Set 1" x 5' iron pipe with brass cap stamped -

New B.T.'s Sugar maple 9" N22W 17 links S498  
Scribed 1/16 B.T. T36N

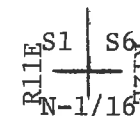

CPI-1974

Dated at Grandon, Wis., this 11th day of December, 1974.

Signature Philip T. Hansen Title Registered Land Surveyor Registration No. S-498  
(County Surveyor, Registered Land Surveyor, or other duly authorized official)

Office of Register of Deeds, County of Forest, I hereby certify that the within instrument was filed in this office for record on the 17th day of March, 1975 at 3:35 o'clock P. M. Document No. 106808

Eugene Stutzman  
(Register of Deeds)  
By..... Deputy

FORM 985 R. C. MILLER CO., MILWAUKEE

4361103000