



CERTIFIED LAND CORNER RESTORATION

Index No. **J 1**

State of Wisconsin }
 County of Forest } ss.

I Philip T. Hansen, do hereby certify that on the 5th day of December, 1974, I found evidence of the Southwest corner of Section 7 Township 3-6, North, Range 12 East, Fourth Principal Meridian, as described hereon; and that from this evidence I established a new monument and accessories as described hereon to perpetuate the original location of this corner.

Resident witnesses:

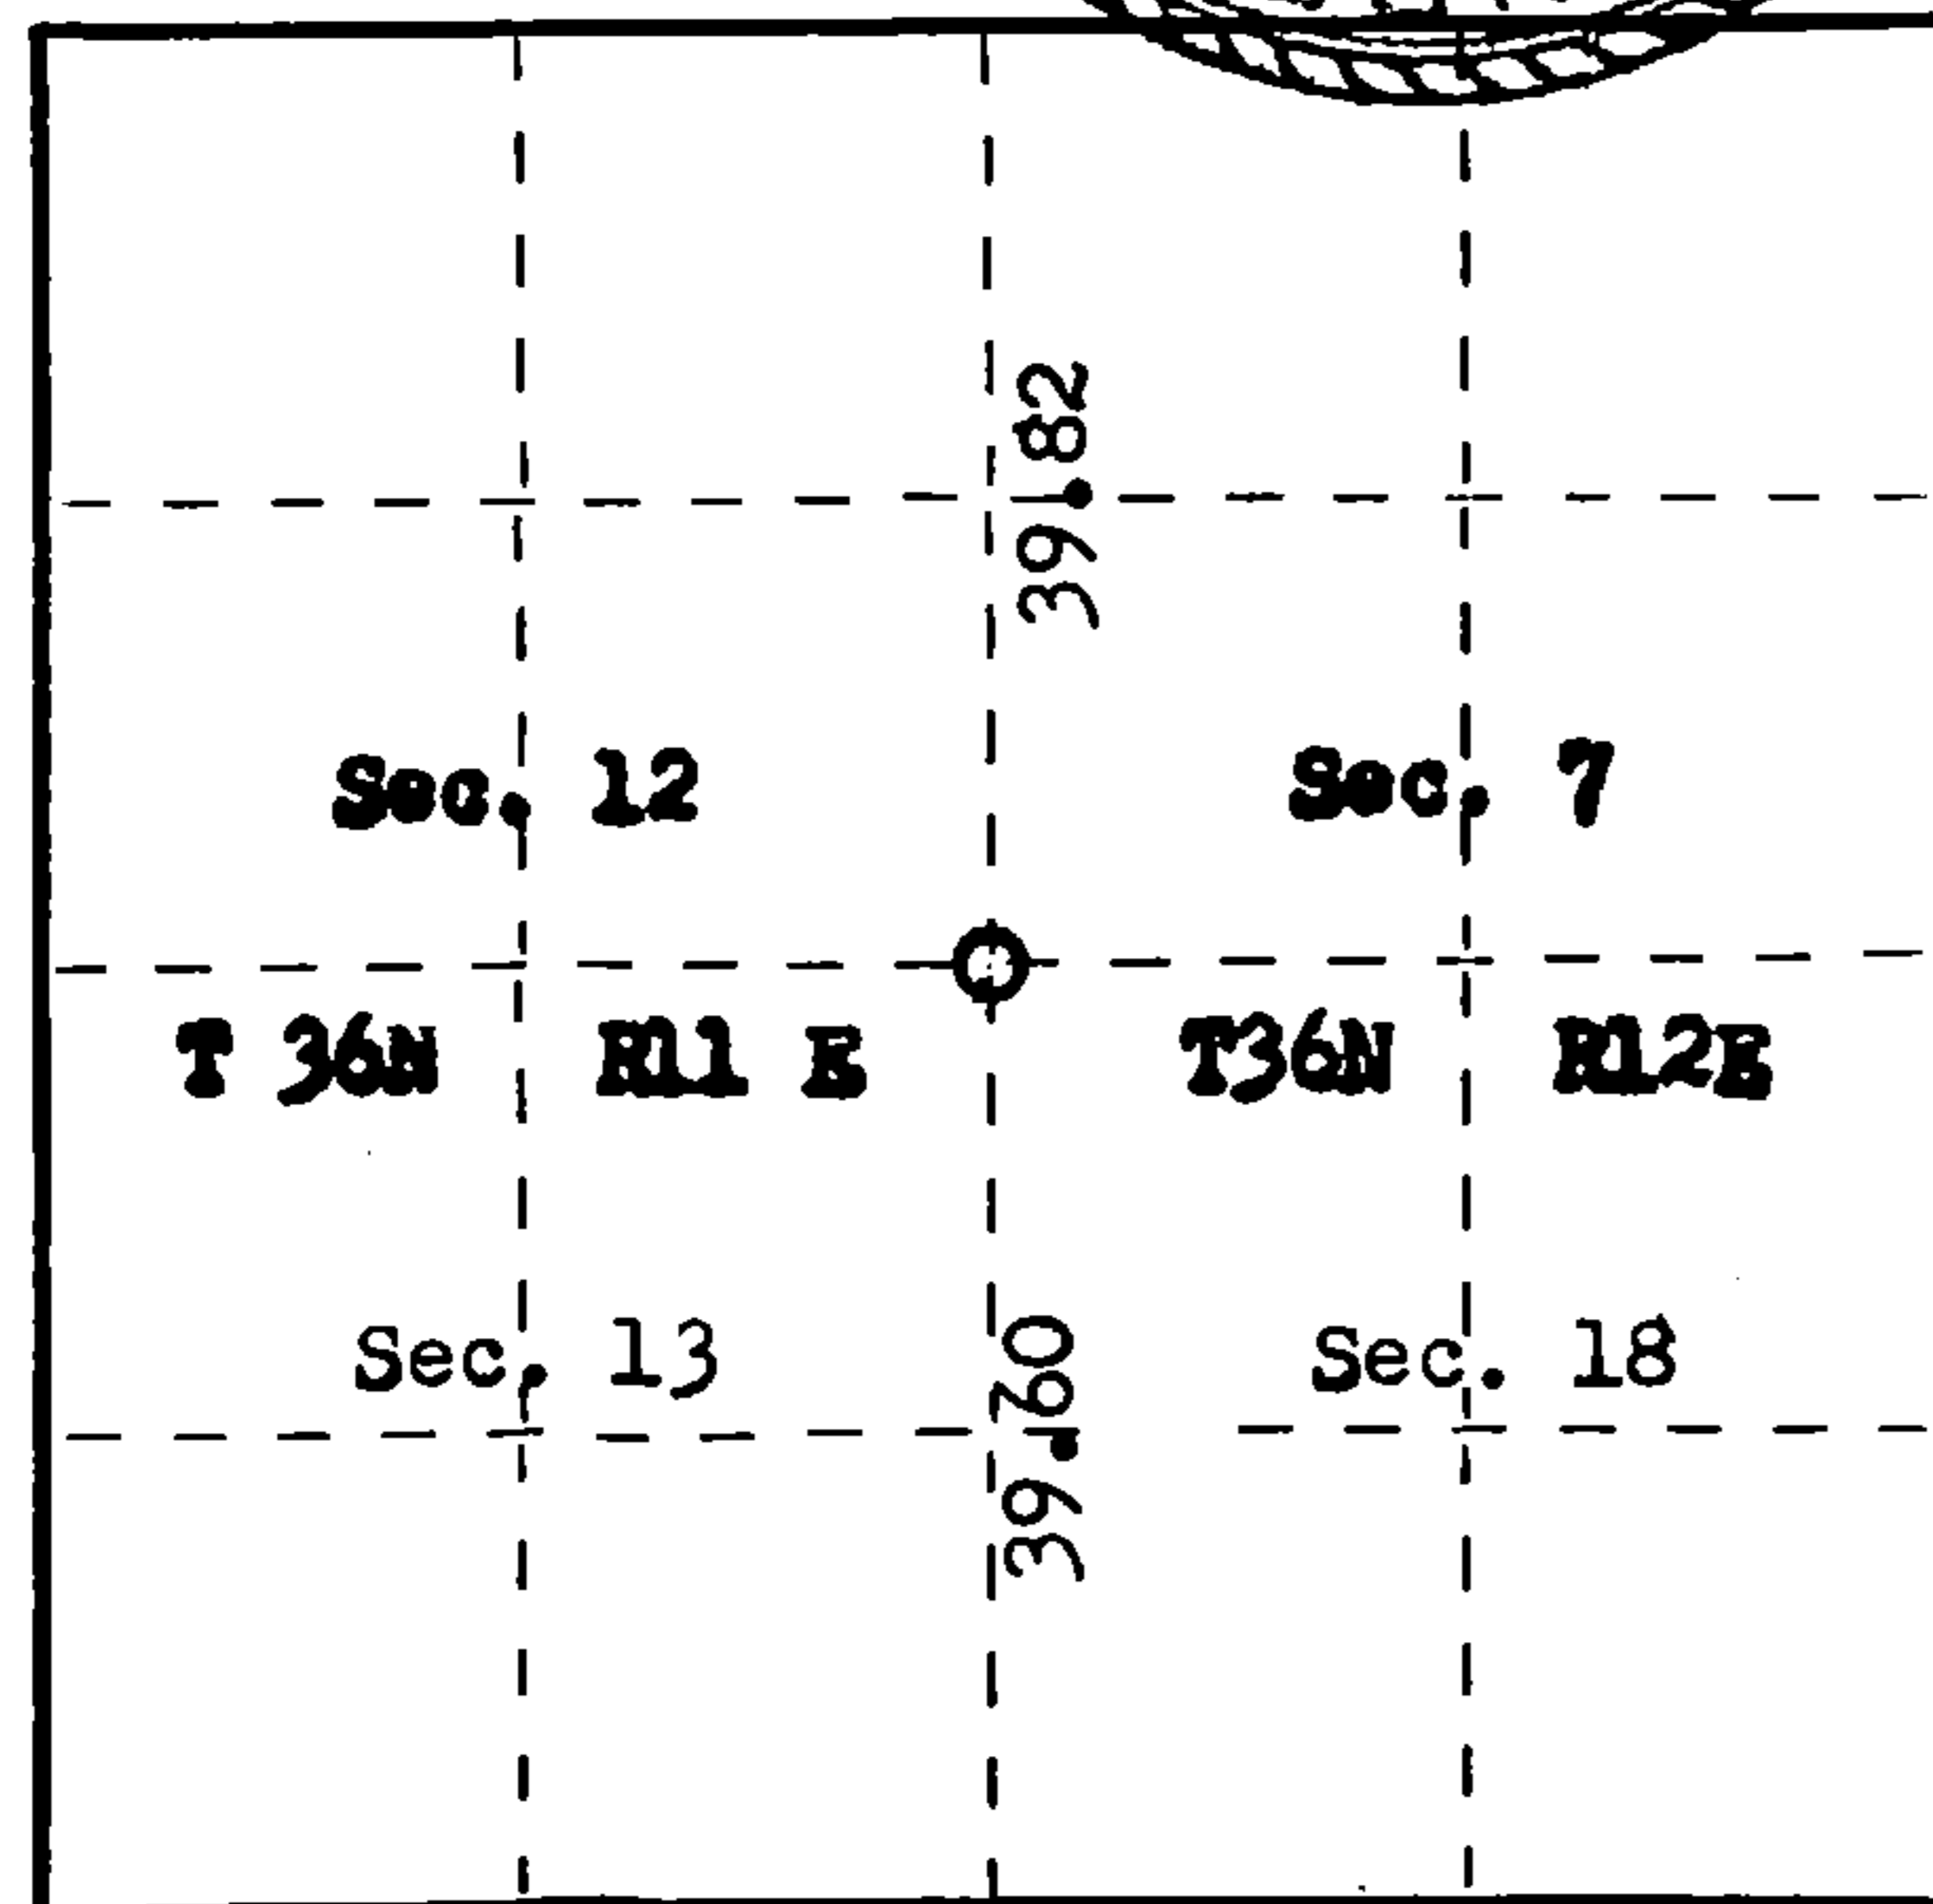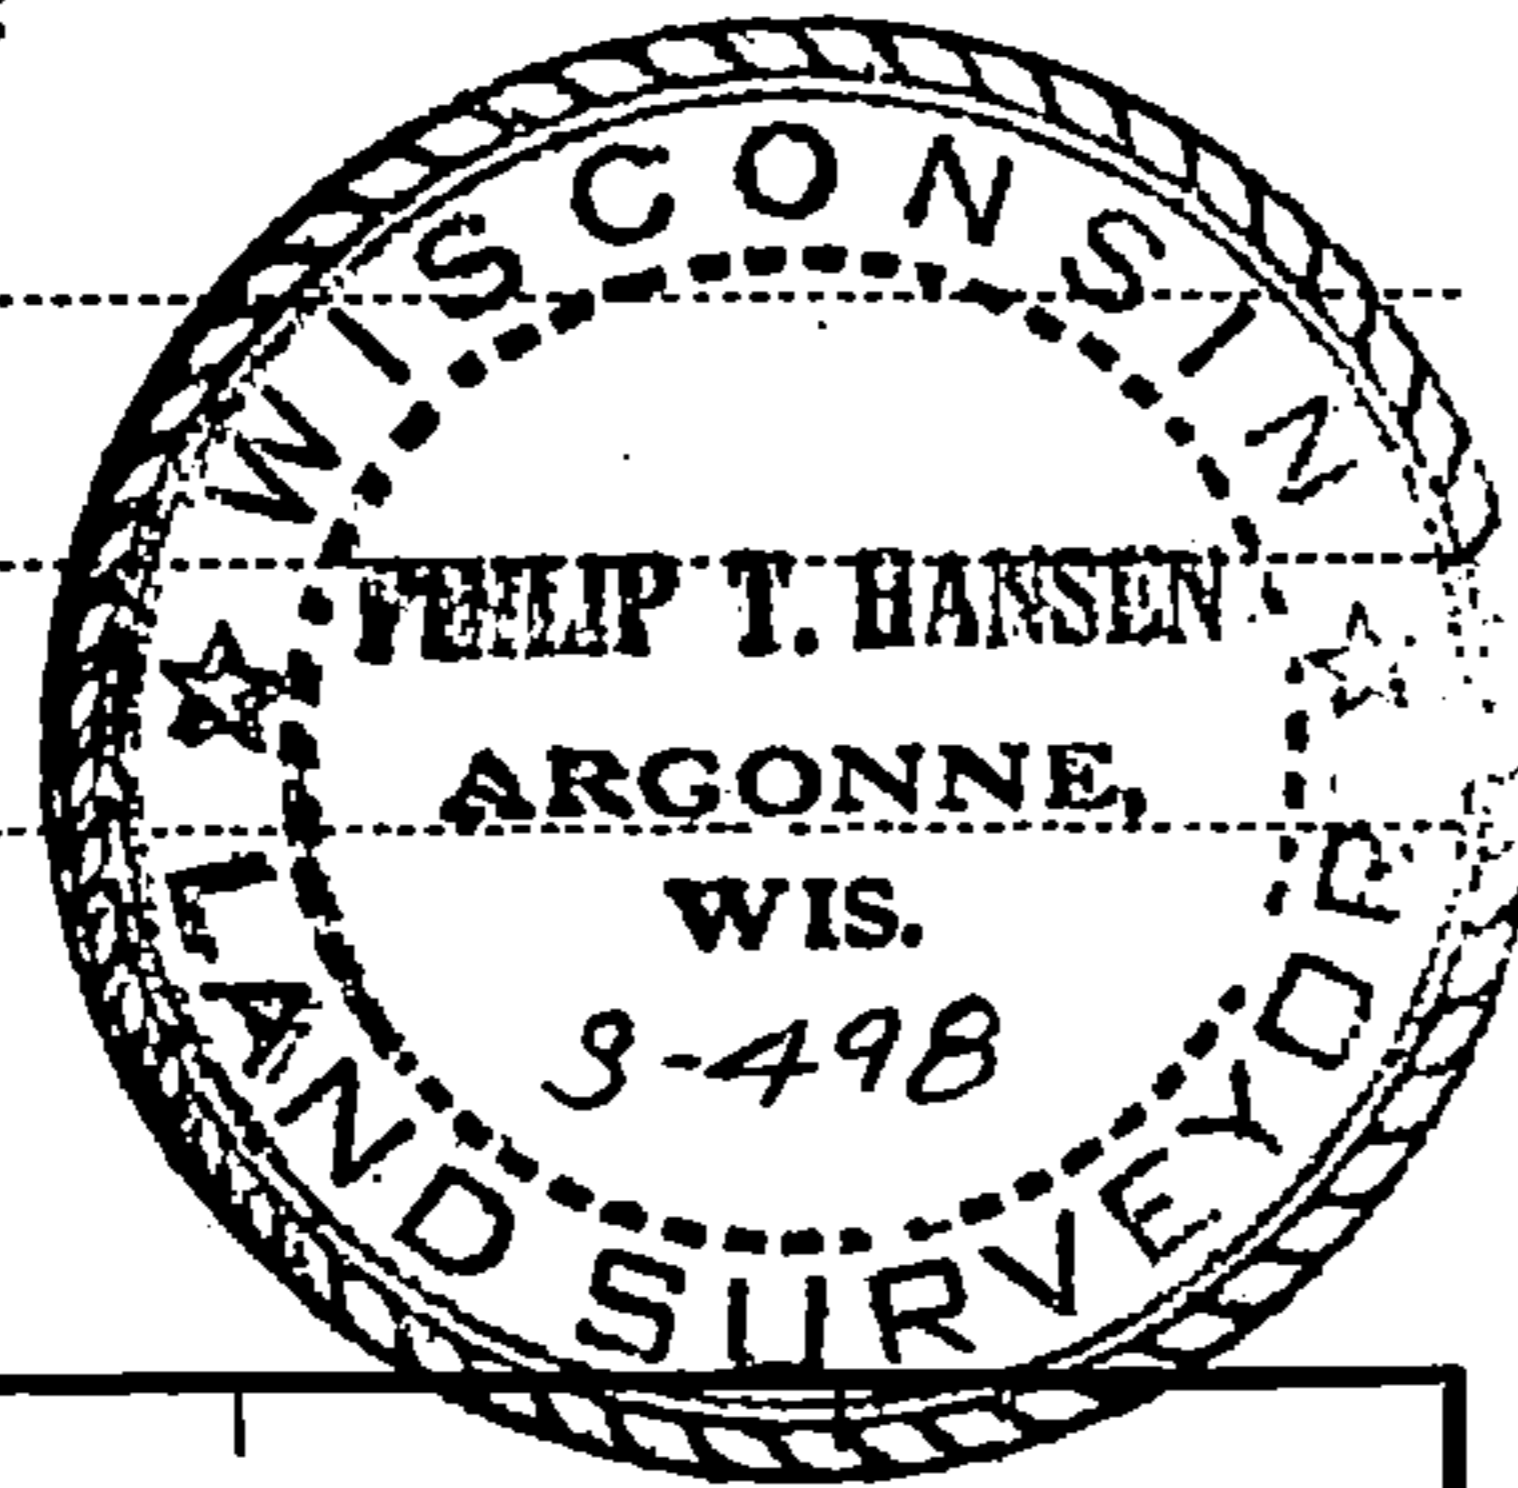

○ = Corner monument restored.

History of original corner establishment:

Original corner established in 1859 by William E. Dougherty, Governemet Deputy Surveyor

Y. Pine 20" N 20 E 55 lks.
 Cedar 12" N 80 W 7 lks
 Tamarac 15" S 5 W 50 lks
 Cedar 10" S 65 E 42 lks

Description of corner evidence found: Recovered 4"x 4" cedar post, squared, very old.
 Recovered old yellow pine stump, scribe obliterated (orig. B.T.) Sound.
 Recovered H.C.Lawrence 5" scribed post established in 1956, fair condition.
 Recovered 4" post, scribed B.T. Origin unknown.

Description of monument and accessories I established to perpetuate the original location of this corner.

Set 2 1/2" x 5' Galvanized iron pipe with brass cap stamped as follows:

S- 498
 T36N
 R11E | S 12 | S 7 | R12E
 S 13 | S 18
 CPI 1974
 New BTs Cedar 11" N78E 44 1/2 lks
 Cedar 11" S16E 38 lks
 Cedar Post BT 4" S64E 41 1/2 lks

Dated at Argonne, Wis., this 17th day of December, 1974.

Signature Philip T. Hansen Title Registered Land Surveyor Registration No. S 498
 (County Surveyor, Registered Land Surveyor, or other duly authorized official)

Office of Register of Deeds, County of Forest, I hereby certify that the within instrument was filed in this office for record on the 17th day of March, 1975 at 9:35 o'clock A.M. Document No. **106813**

Eugene Staszynski
 (Register of Deeds)
 Deputy

FORM 985 H. C. MILLER CO., MILWAUKEE

4361120000