

CERTIFIED LAND CORNER RESTORATION

Index No. **M 1**


State of Wisconsin }
County of Forest } ss.

I Philip T. Hansen, do hereby
certify that on the 7th day
of October, 1975, I found
evidence of the S-1/16
corner of Sections 13 and 18
Township 36, North, Range
11 and 12 East, Fourth Principal Meridian,
as described hereon; and that from this evidence
I established a new monument and accessories
as described hereon to perpetuate the original
location of this corner.


Resident witnesses

Glen Barker

Jim Claflin

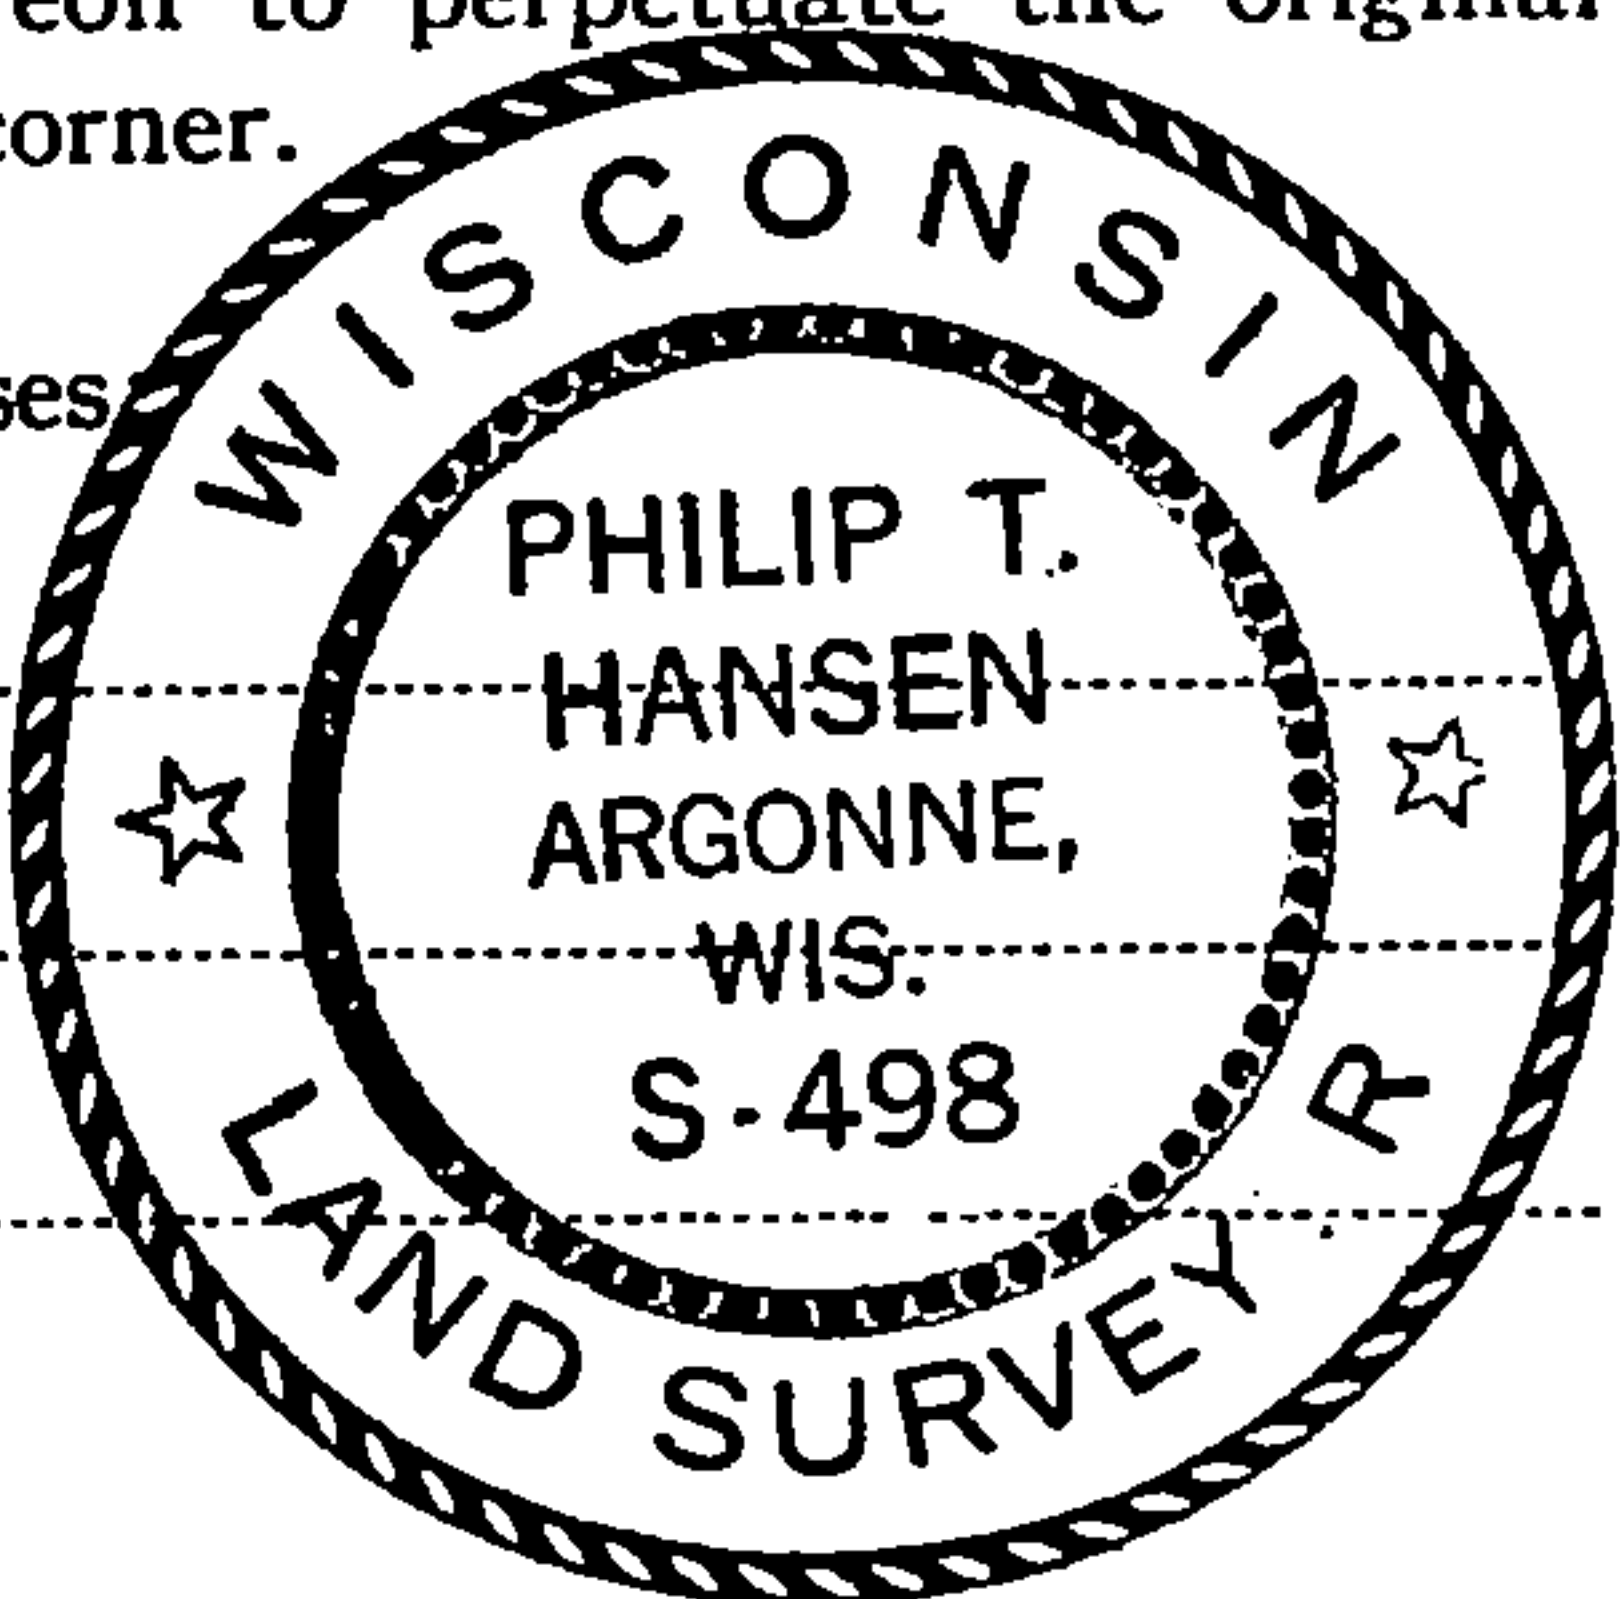

T36N R12E

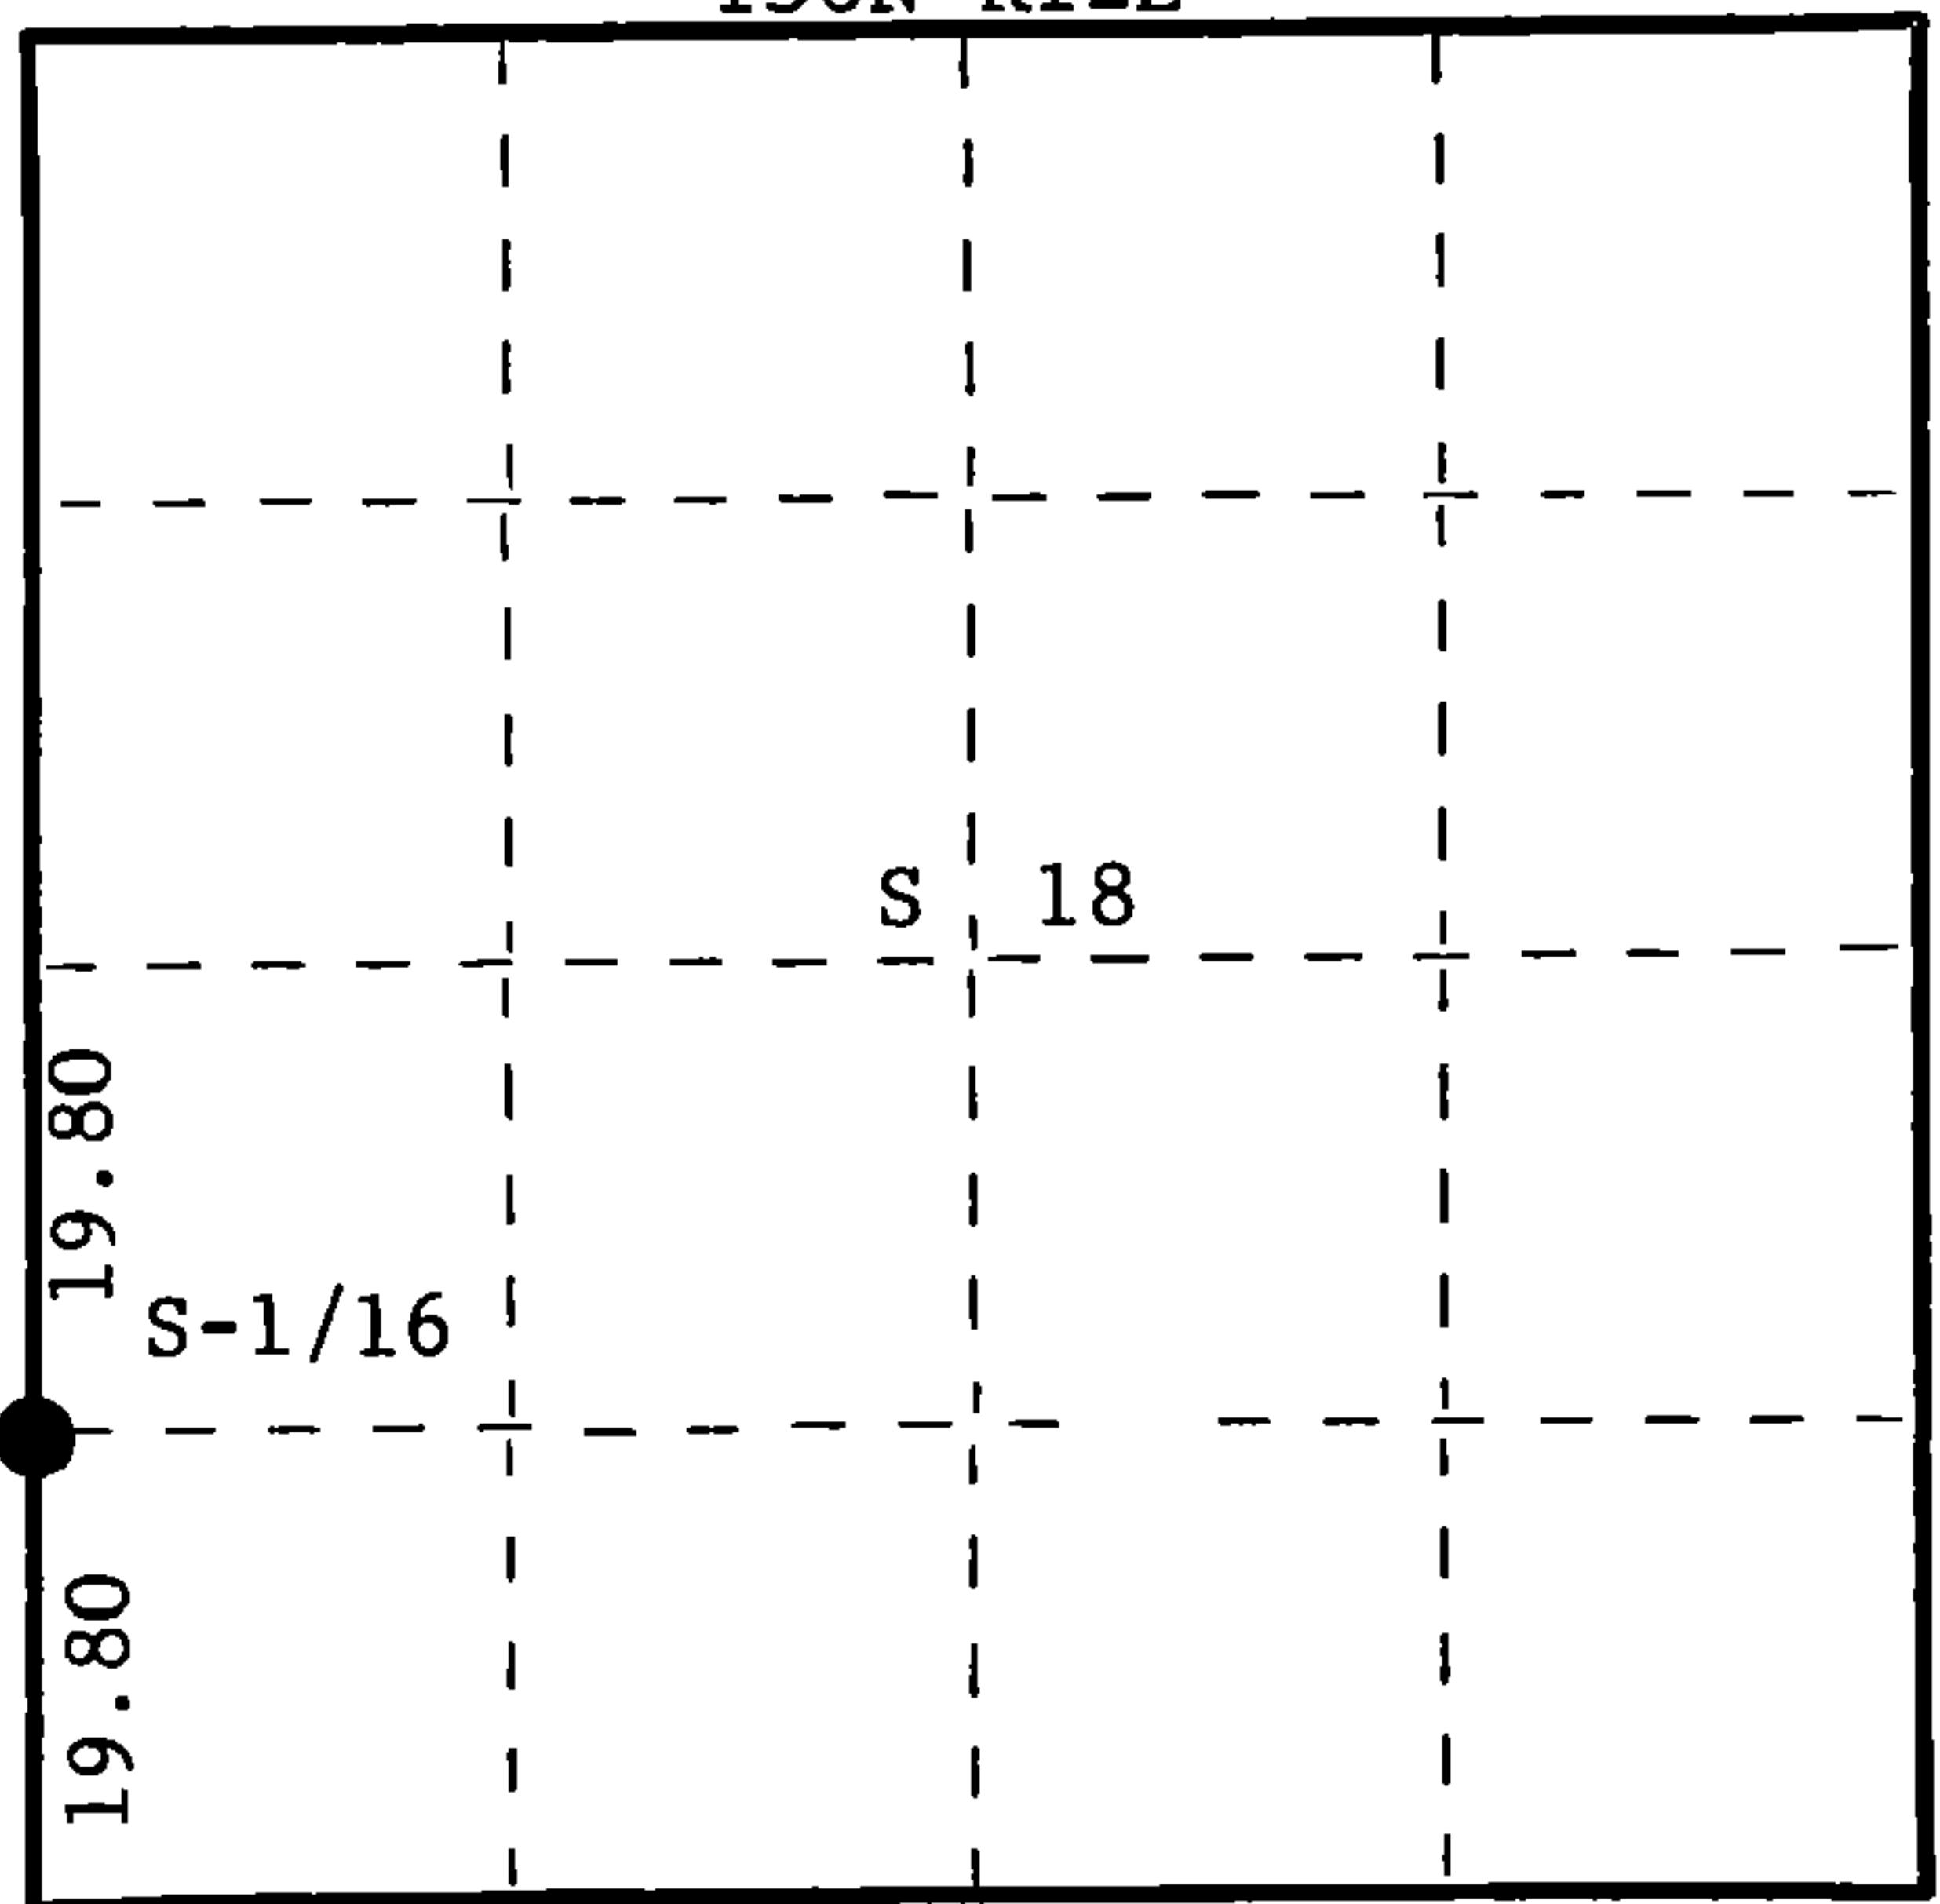

○ = Corner monument restored.

History of original corner establishment:

Corner established by H.C. Lawrence, Registered Land Surveyor, in 1950. He ran a random line S3°00'W from Section Corner 12, 7, 18, and 13, a distance of 79.20 chains, at which point the Section Corner was 7.00 chains east. Corrected bearing S2°05'E. He was unable to recover 1/4 corner on this line, so set it equidistant at 39.60 chains and 3.50 chains east of random line. Set S-1/16 at 19.80, equidistant between 1/4 corner and S-E corner and 5.25 chains east of random line. Set new tamarack post in stand of small tamarack.

Description of corner evidence found:

Recovered 5" tamarack post, squared and scribed S-1/16 S6, S-1/16 S5 in fair condition. No BT's were recovered.

Description of monument and accessories I established to perpetuate the original location of this corner.

Replaced 5" tamarack post with 1-1/2" OD iron pipe with 2" brass cap stamped - S498
As this area is all backwater from Beaver Dam and no trees were T36N
available for BT's, two 1-1/2" OD iron pipes w/brass caps were
set for witness corners - #1 - scribed W/C

S20 links
#2 - scribed W/C
E30 links

R
11 S-1/16 S13 | S18 R
E 12
1975 E

Dated at Argonne, Wis., this 13th day of October, 1975.

Signature *Philip T. Hansen* Title Registered Land Surveyor Registration No. S-498.
(County Surveyor, Registered Land Surveyor, or other duly authorized official)

Office of Register of Deeds, County of Forest, I hereby certify that the within
instrument was filed in this office for record on the 16th day of October, 1975.
at 2:30 o'clock P. M.

Eugene Staszynski
(Register of Deeds)

By Deputy

DOCUMENT NUMBER - 107988