

CERTIFIED LAND CORNER RESTORATION


Index No. R-1

State of Wisconsin }
County of Forest } ss.


I Philip T. Hansen, do hereby certify that on the 19th day of March, 1976, I found evidence of the Section corner of S 19, 30, 25, 24 Township 36, North, Range 11 & 12 East, Fourth Principal Meridian, as described hereon; and that from this evidence I established a new monument and accessories as described hereon to perpetuate the original location of this corner.

Resident witnesses:

Glen Barker
Jim Claflin
Herb Wagoner

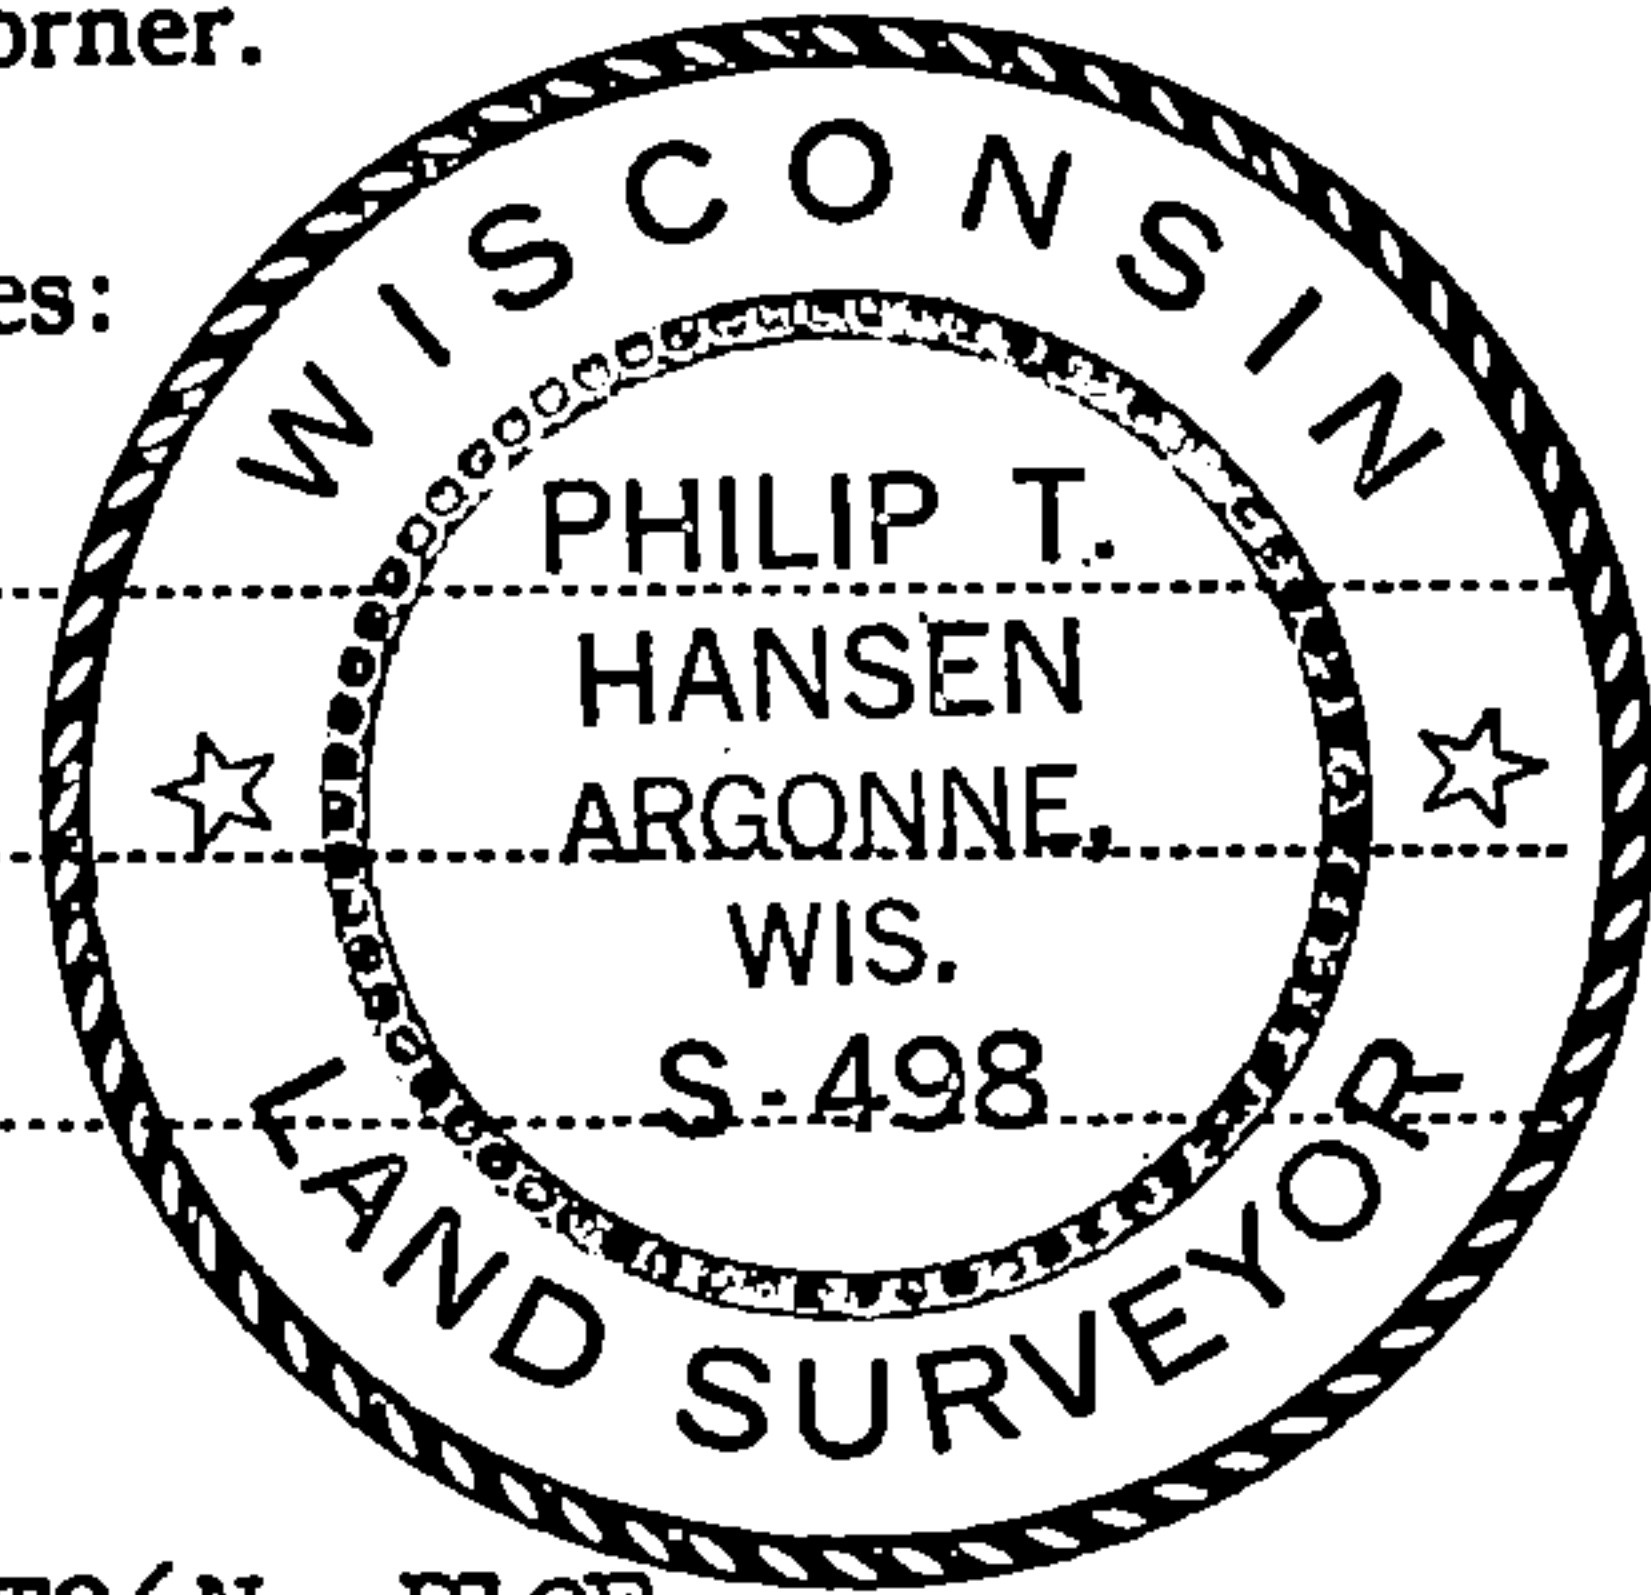

FORM 985 W. C. MILLER CO., MILWAUKEE

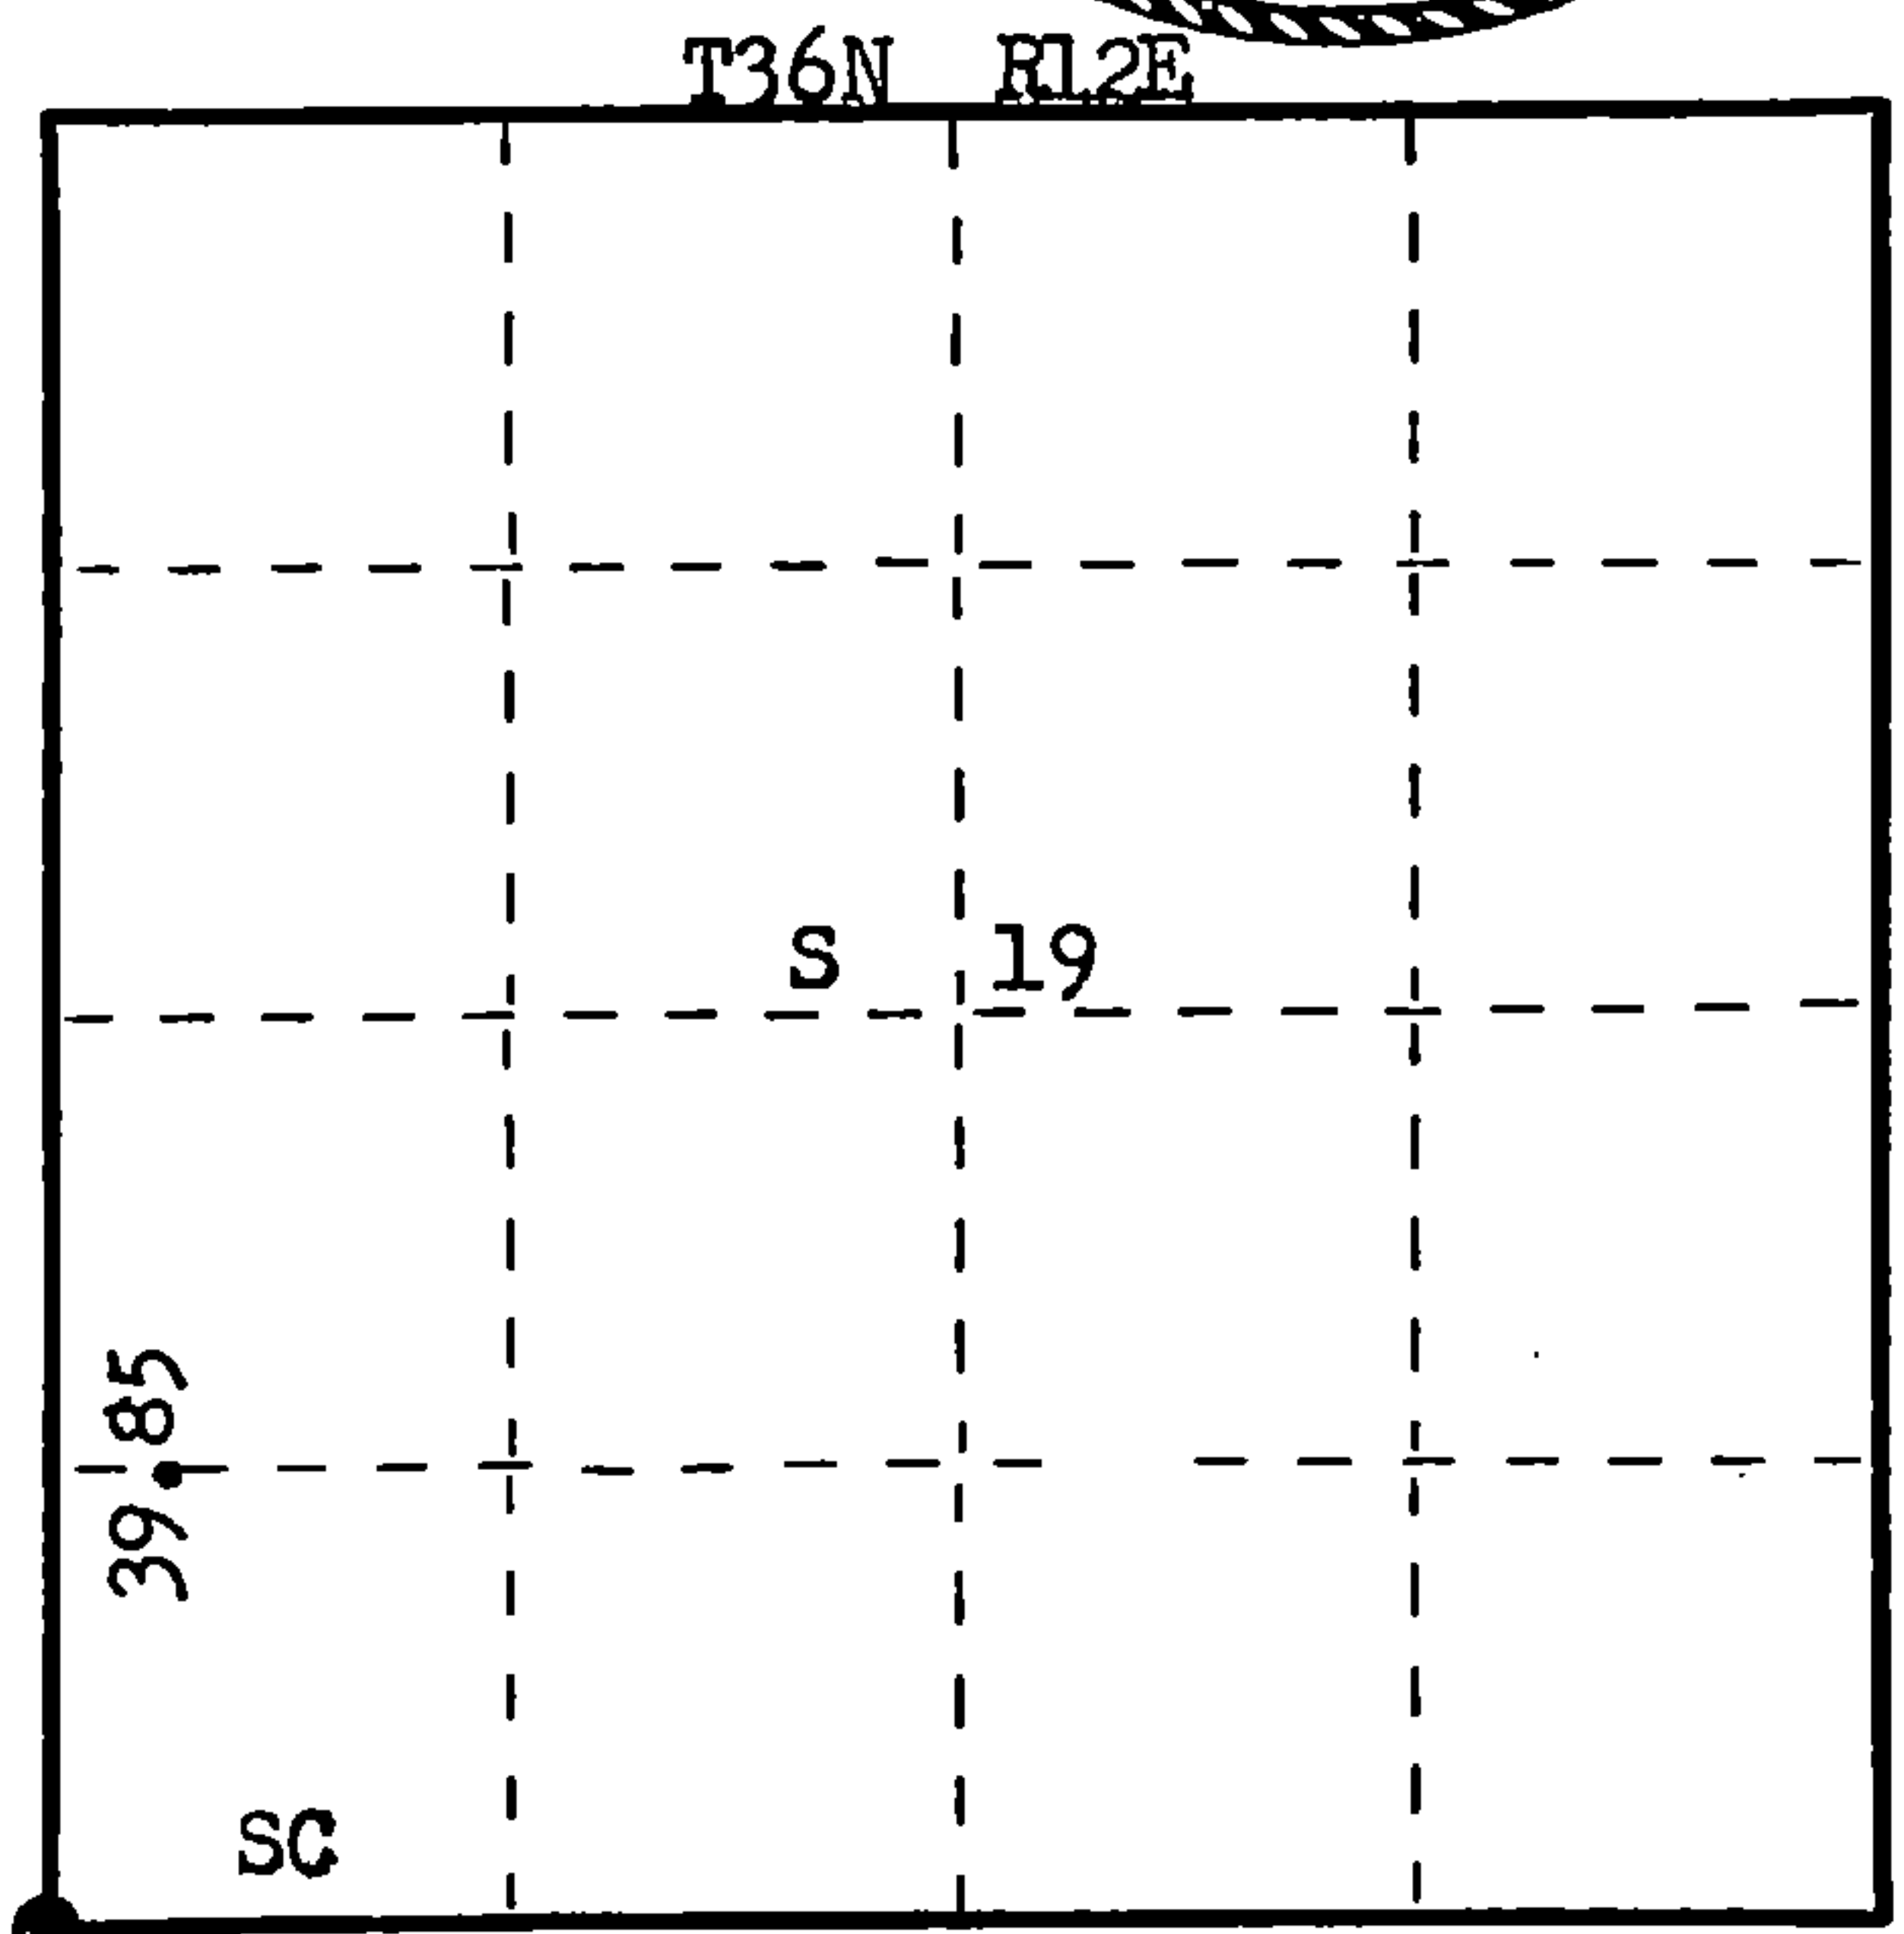

○ = Corner monument restored.

History of original corner establishment:

Original corner established by Alfred Millard, Deputy Surveyor, in 1858, from which tamarack 10" bears N 20° E 40 lks, tamarack 11" bears N 85° W 32 lks, tamarack 11" bears S 80° W, 16 lks and tamarack 10" bears S 60° E 40 lks.

Corner recovered by H. C. Lawrence, Registered Land Surveyor, in 1947. Recovered all tamarack BTs and point of original post. Set new post in place of old point and marked NBTs. Tamarack 8" N 20° W 21½ lks, and tamarack 7" N 80° E 31 lks.

Description of corner evidence found:

Recovered 4" tamarack post, squared and scribed S 19, S 24, S 25, S 30, in fair condition. Also recovered the point of original stake in the muck beside cedar post.

Recovered - original tamarack BT 11" S 80° W 16 lks, now a decayed stump.
original tamarack 10" S 60° E 40 lks, now a decayed stump.
tamarack 8" (10") N 20° W 21.5 lks, scribed S 24 BT.
tamarack 7" (8") N 80° E (N 83° E) 31 lks, scribed S 19 BT.

Description of monument and accessories I established to perpetuate the original location of this corner.

Replaced 4" tamarack post with 2½" Berntsen A-1 Federal Monument, aluminum with magnet installed in cap and base. Pipe projects 18" above ground. Cap stamped. Drove old point in beside new pipe. Set old post beside it.
NBTs - tamarack 10" N 29° E 46.1 lks, scribed SC BT.
tamarack 6" S 46° W 23.1 lks, scribed SC BT.
Pipe and BTs painted blue.

S498
T36N
R 24 | 19 R
11 25 | 30 12
E 1976 E

Dated at Rhineland, Wis., this 23rd day of March, 1976

Signature Philip T. Hansen Title Registered Land Surveyor Registration No. S-498
(County Surveyor, Registered Land Surveyor, or other duly authorized official)

Office of Register of Deeds, County of Forest, I hereby certify that the within instrument was filed in this office for record on the 31st day of March, 1976 at 3:30 o'clock P. M.

Eugene Stutzman
(Register of Deeds)
By _____ Deputy

DOCUMENT NUMBER **108951**

436124 0000