

# CERTIFIED LAND CORNER RESTORATION

Index No. **E-5**

State of Wisconsin }  
County of Forest } ss.


I Philip T. Hansen, do hereby  
certify that on the 23rd day  
of January, 19 78, I found  
evidence of the Section  
corner of Sec. 5, 6, 7 & 8  
Township 36, North, Range  
12 East, Fourth Principal Meridian,  
as described hereon; and that from this evidence  
I established a new monument and accessories  
as described hereon to perpetuate the original  
location of this corner.

Resident witnesses:


Glen Barker

Jim Claflin

Herb Wagoner

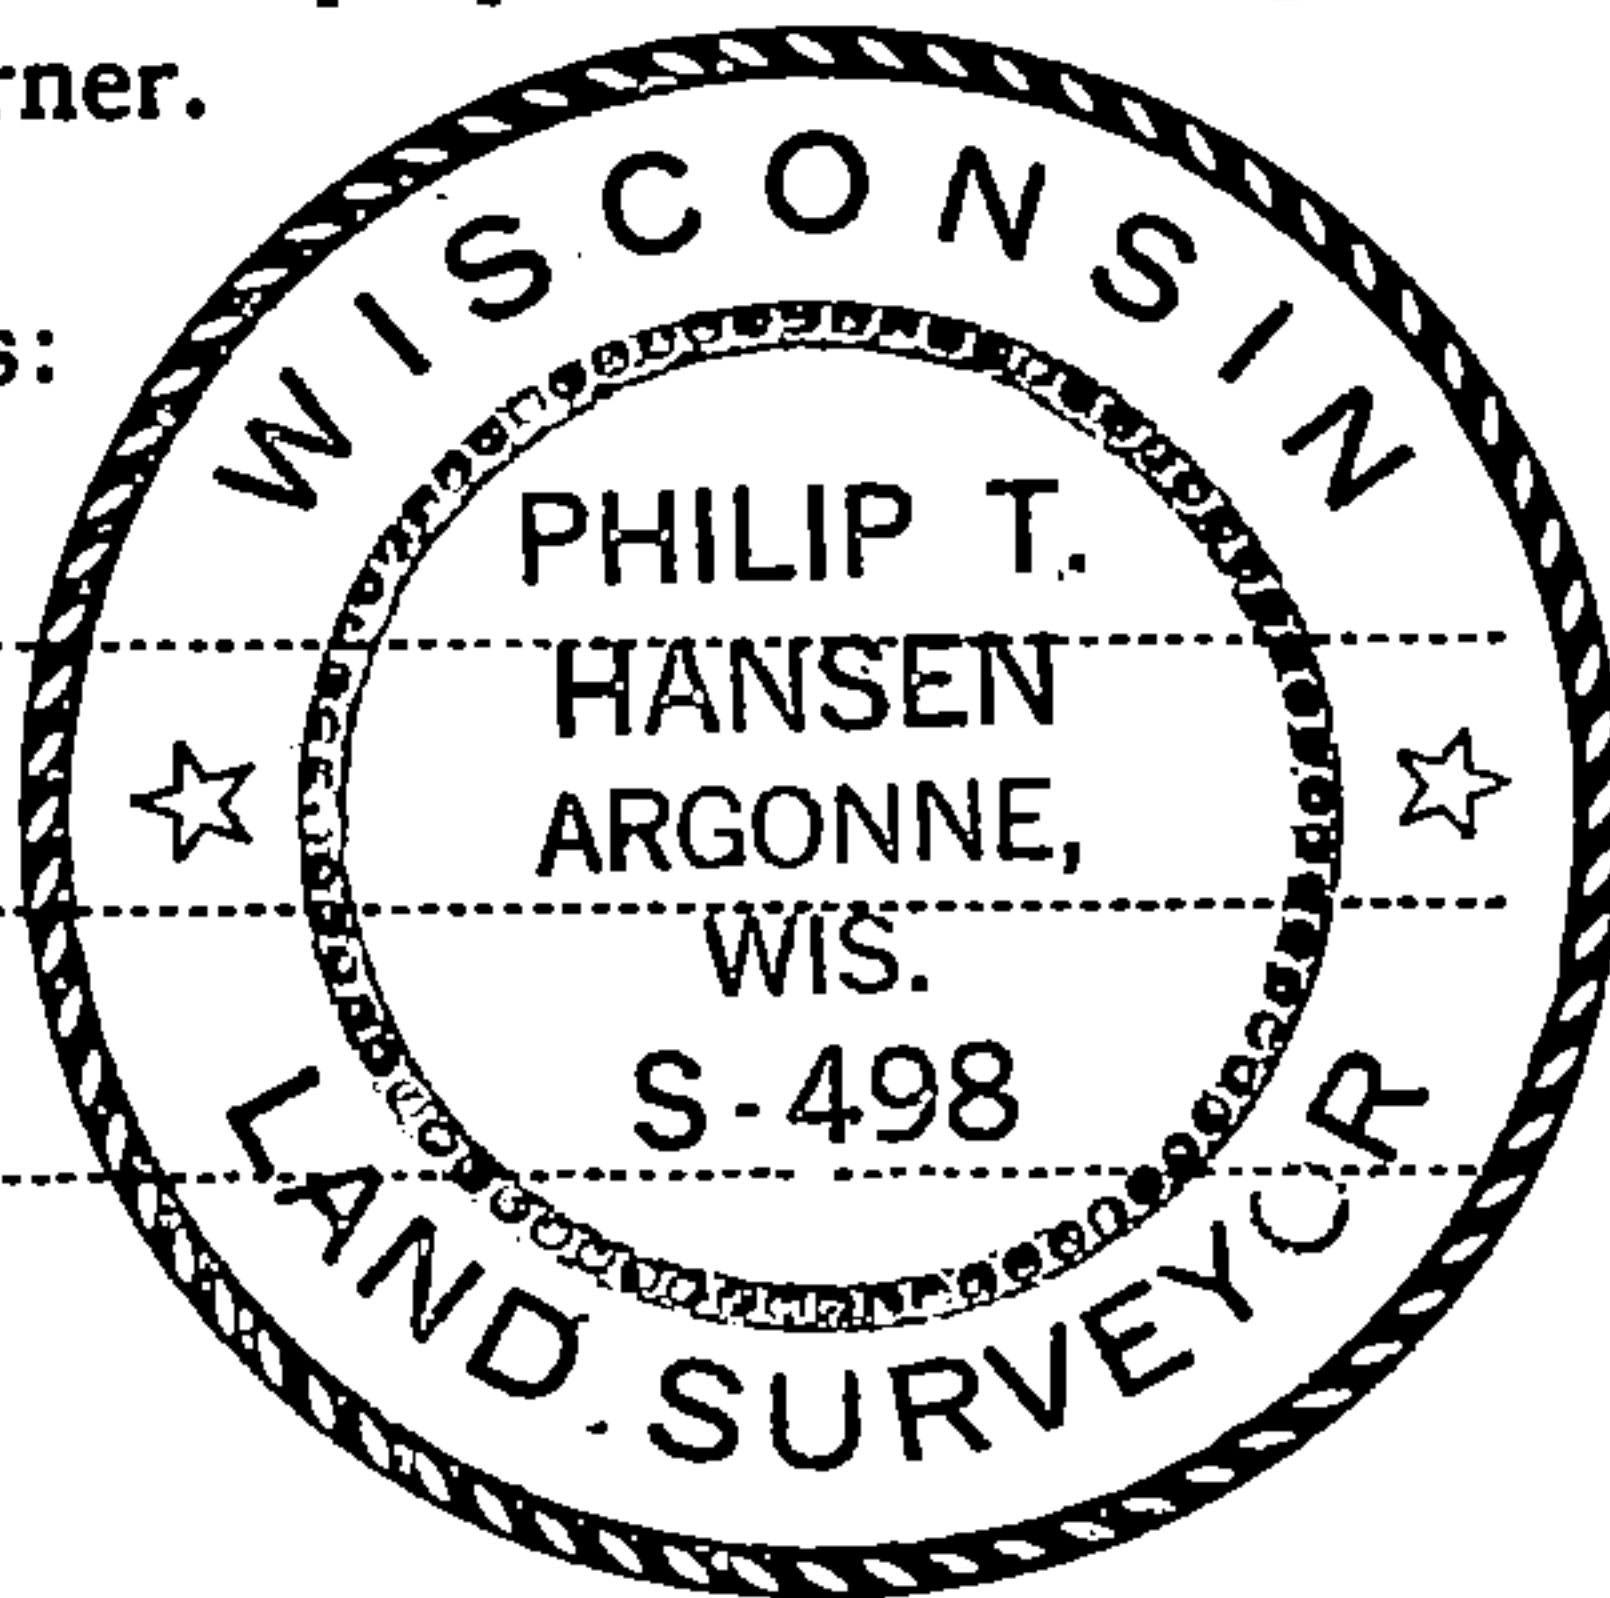

T36N R12E

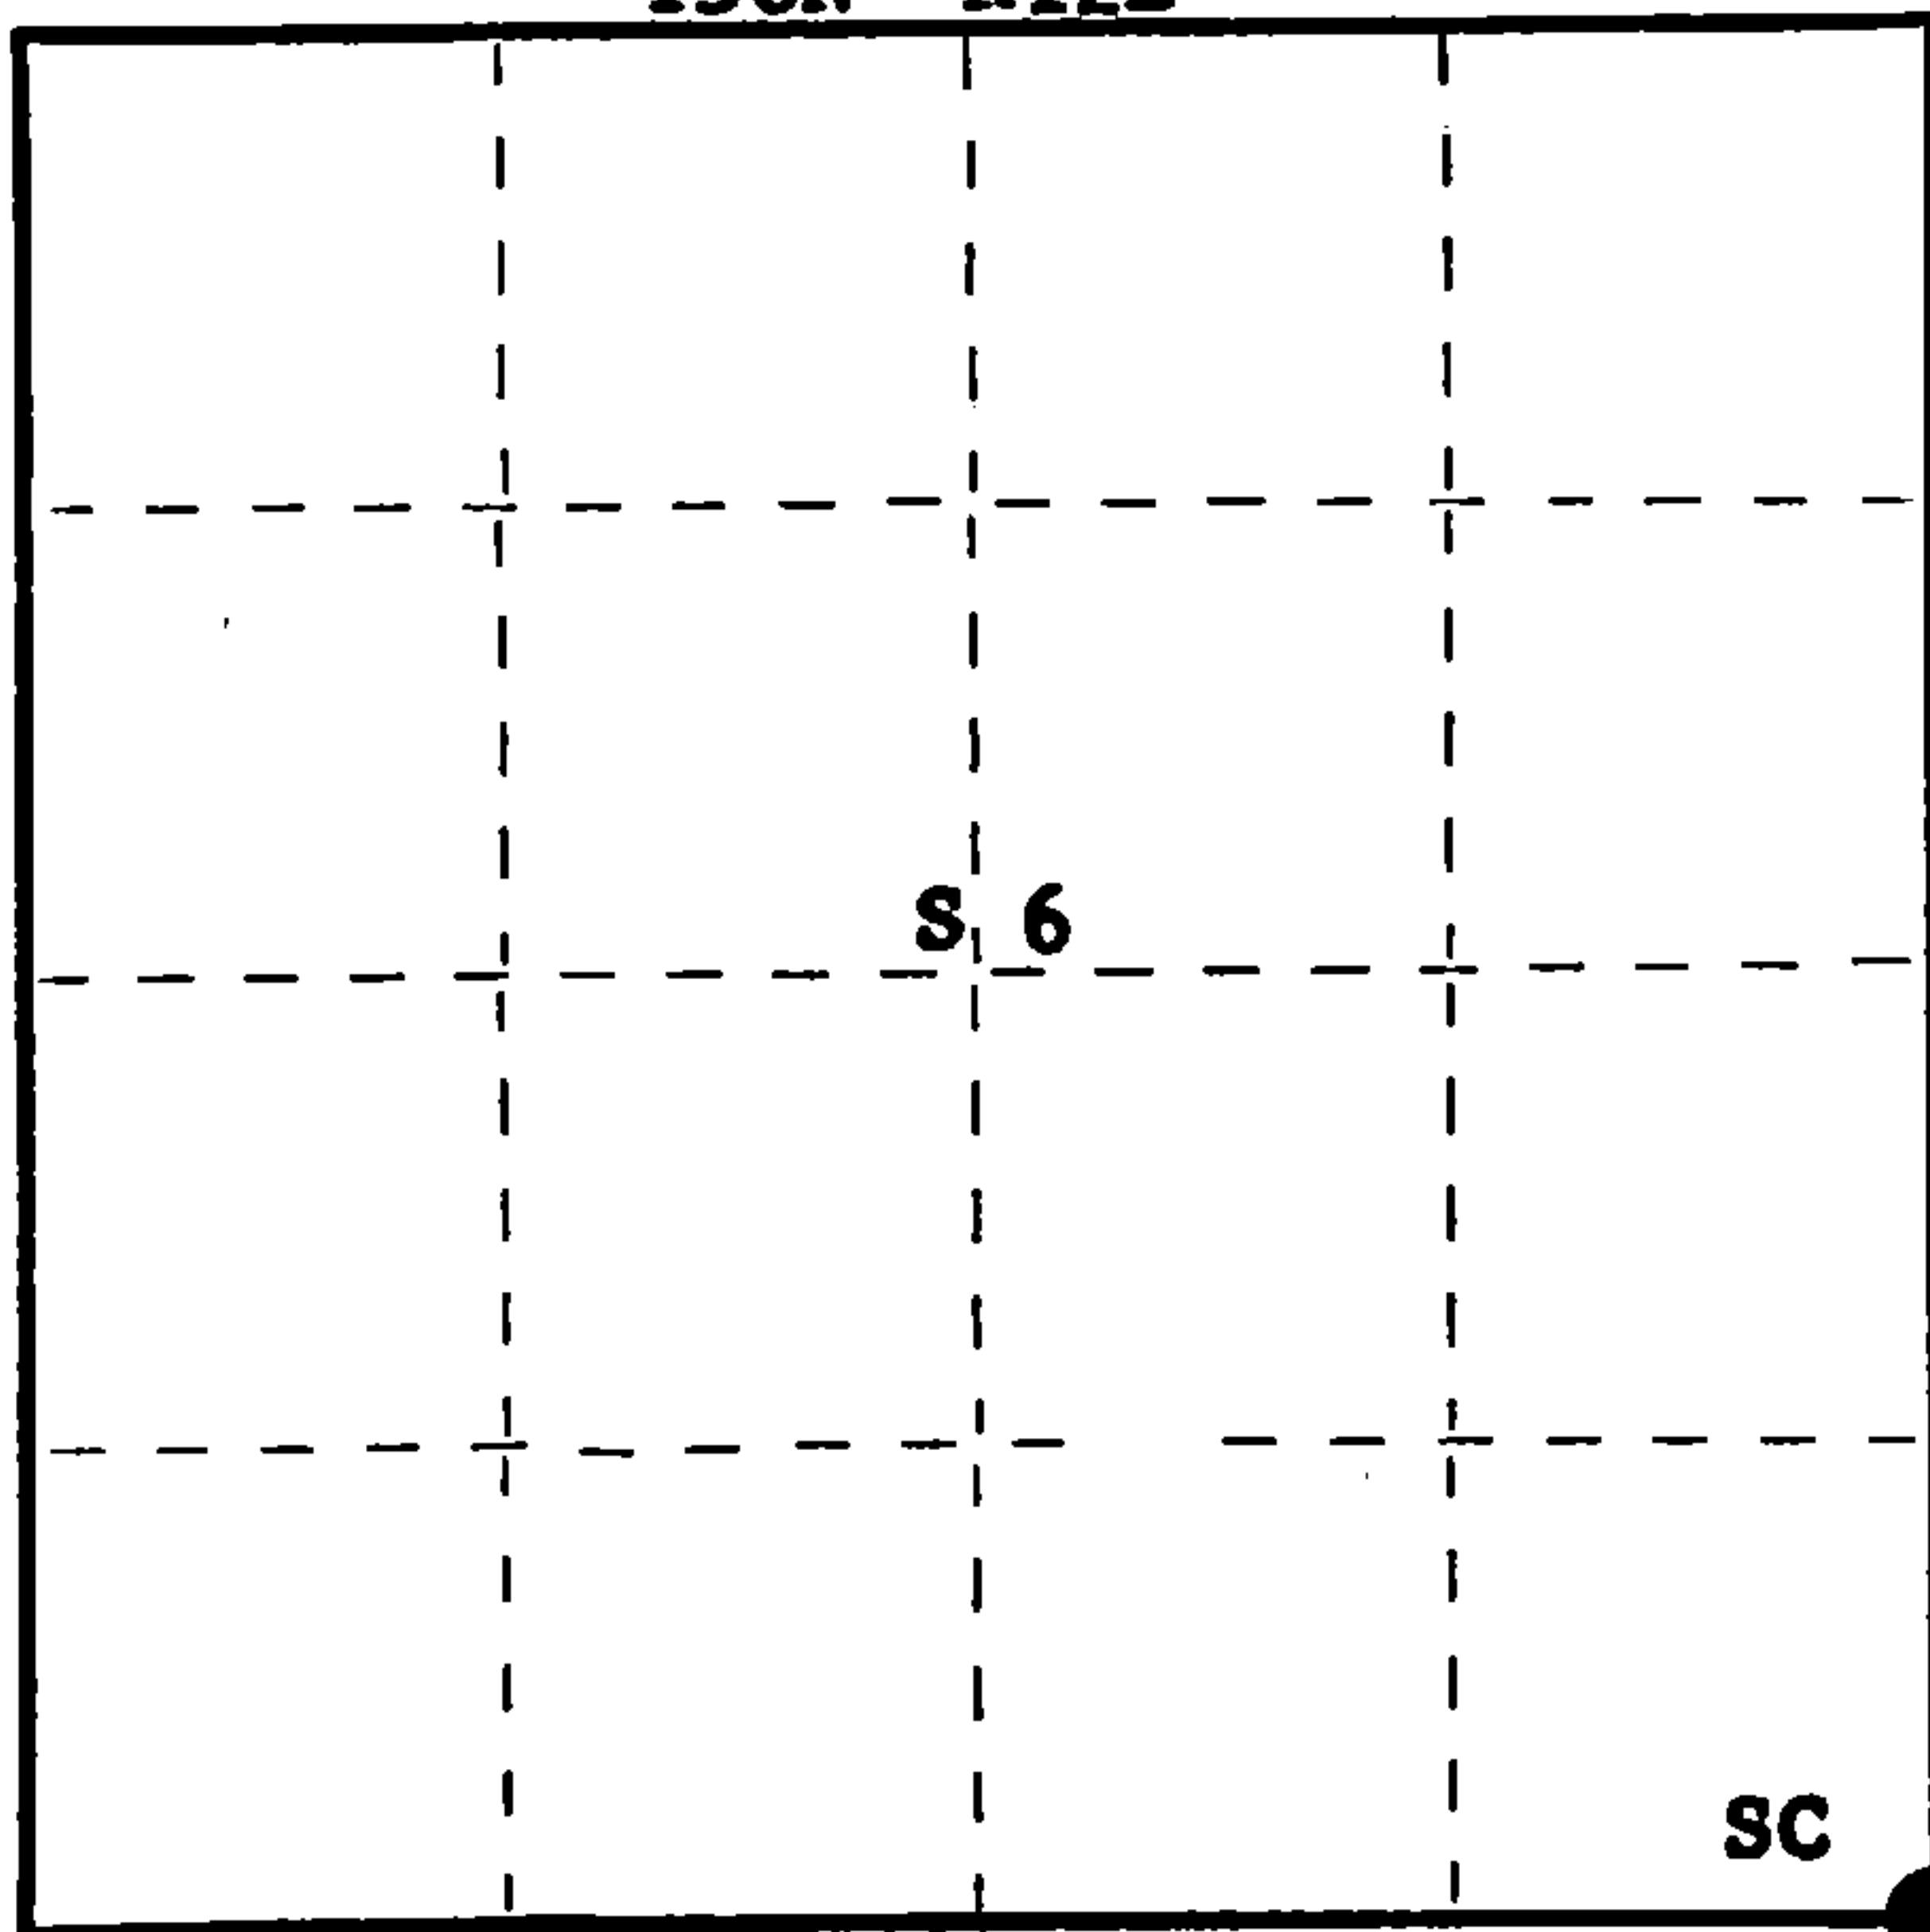

○ = Corner monument restored.

History of original corner establishment:

Corner established by Alfred Millard, Deputy Surveyor, in 1958.

No records of any subsequent survey.

H.C. Lawrence, Registered Land Surveyor, recovered a very old stake in 1958. Set 4" cedar post. No records of any BT's established.

Description of corner evidence found:

Recovered 4" cedar post, squared and scribed S6, S7, S5, S8, in very poor condition. While setting a new monument, recovered the points of three old points all within a radius of 1 link.

Recovered OBT's - White Pine 18" S43°E, 80.4 links, scribed S8 BT.  
Tamarack 7" N68°E, 26.6 links, scribed S5 NBT.

Description of monument and accessories I established to perpetuate the original location of this corner.

Replaced wood post with 2½" Berntsen A-1 Federal Monument, aluminum with magnet in cap and base. Monument projects 18" above ground. Cap stamped:  
Drove the old points around base of monument.

Marked NBT's - Tamarack 8" S45°W, 48.2 links, scribed SC BT.  
Tamarack 7" N32°E, 18.7 links, scribed SC BT.

All distances to new and old BT's are to new monument.

Monument sets in a wet tamarack and alder swamp.

T36N  
Sec.  $\frac{6}{7+8}$   
R12E  
S498-1978

Dated at Rhineland, Wis., this 24th day of January, 1978.

Signature Philip T. Hansen Title Registered Land Surveyor Registration No. S-498  
(County Surveyor, Registered Land Surveyor, or other duly authorized official)

Office of Register of Deeds, County of Forest, I hereby certify that the within  
instrument was filed in this office for record on the 27th day of January, 1978  
at 4:00 o'clock P. M.

Eugene Stutzman  
(Register of Deeds)

DOCUMENT NUMBER - **113207**

By \_\_\_\_\_ Deputy