

CERTIFIED LAND CORNER RESTORATION

Index No. E-3

State of Wisconsin }
County of Forest } ss.



I, Philip T. Hansen, do hereby certify that on the 23rd day of October, 19 78, I ~~found~~ **established** ~~the~~ Quarter corner of Sections 6 and 7 Township 36, North, Range 12 East, Fourth Principal Meridian, as described hereon; and that from this evidence I established a new monument and accessories as described hereon to perpetuate the original location of this corner.

Resident witnesses:

Glen Barker

Jim Claflin

Herb Wagoner

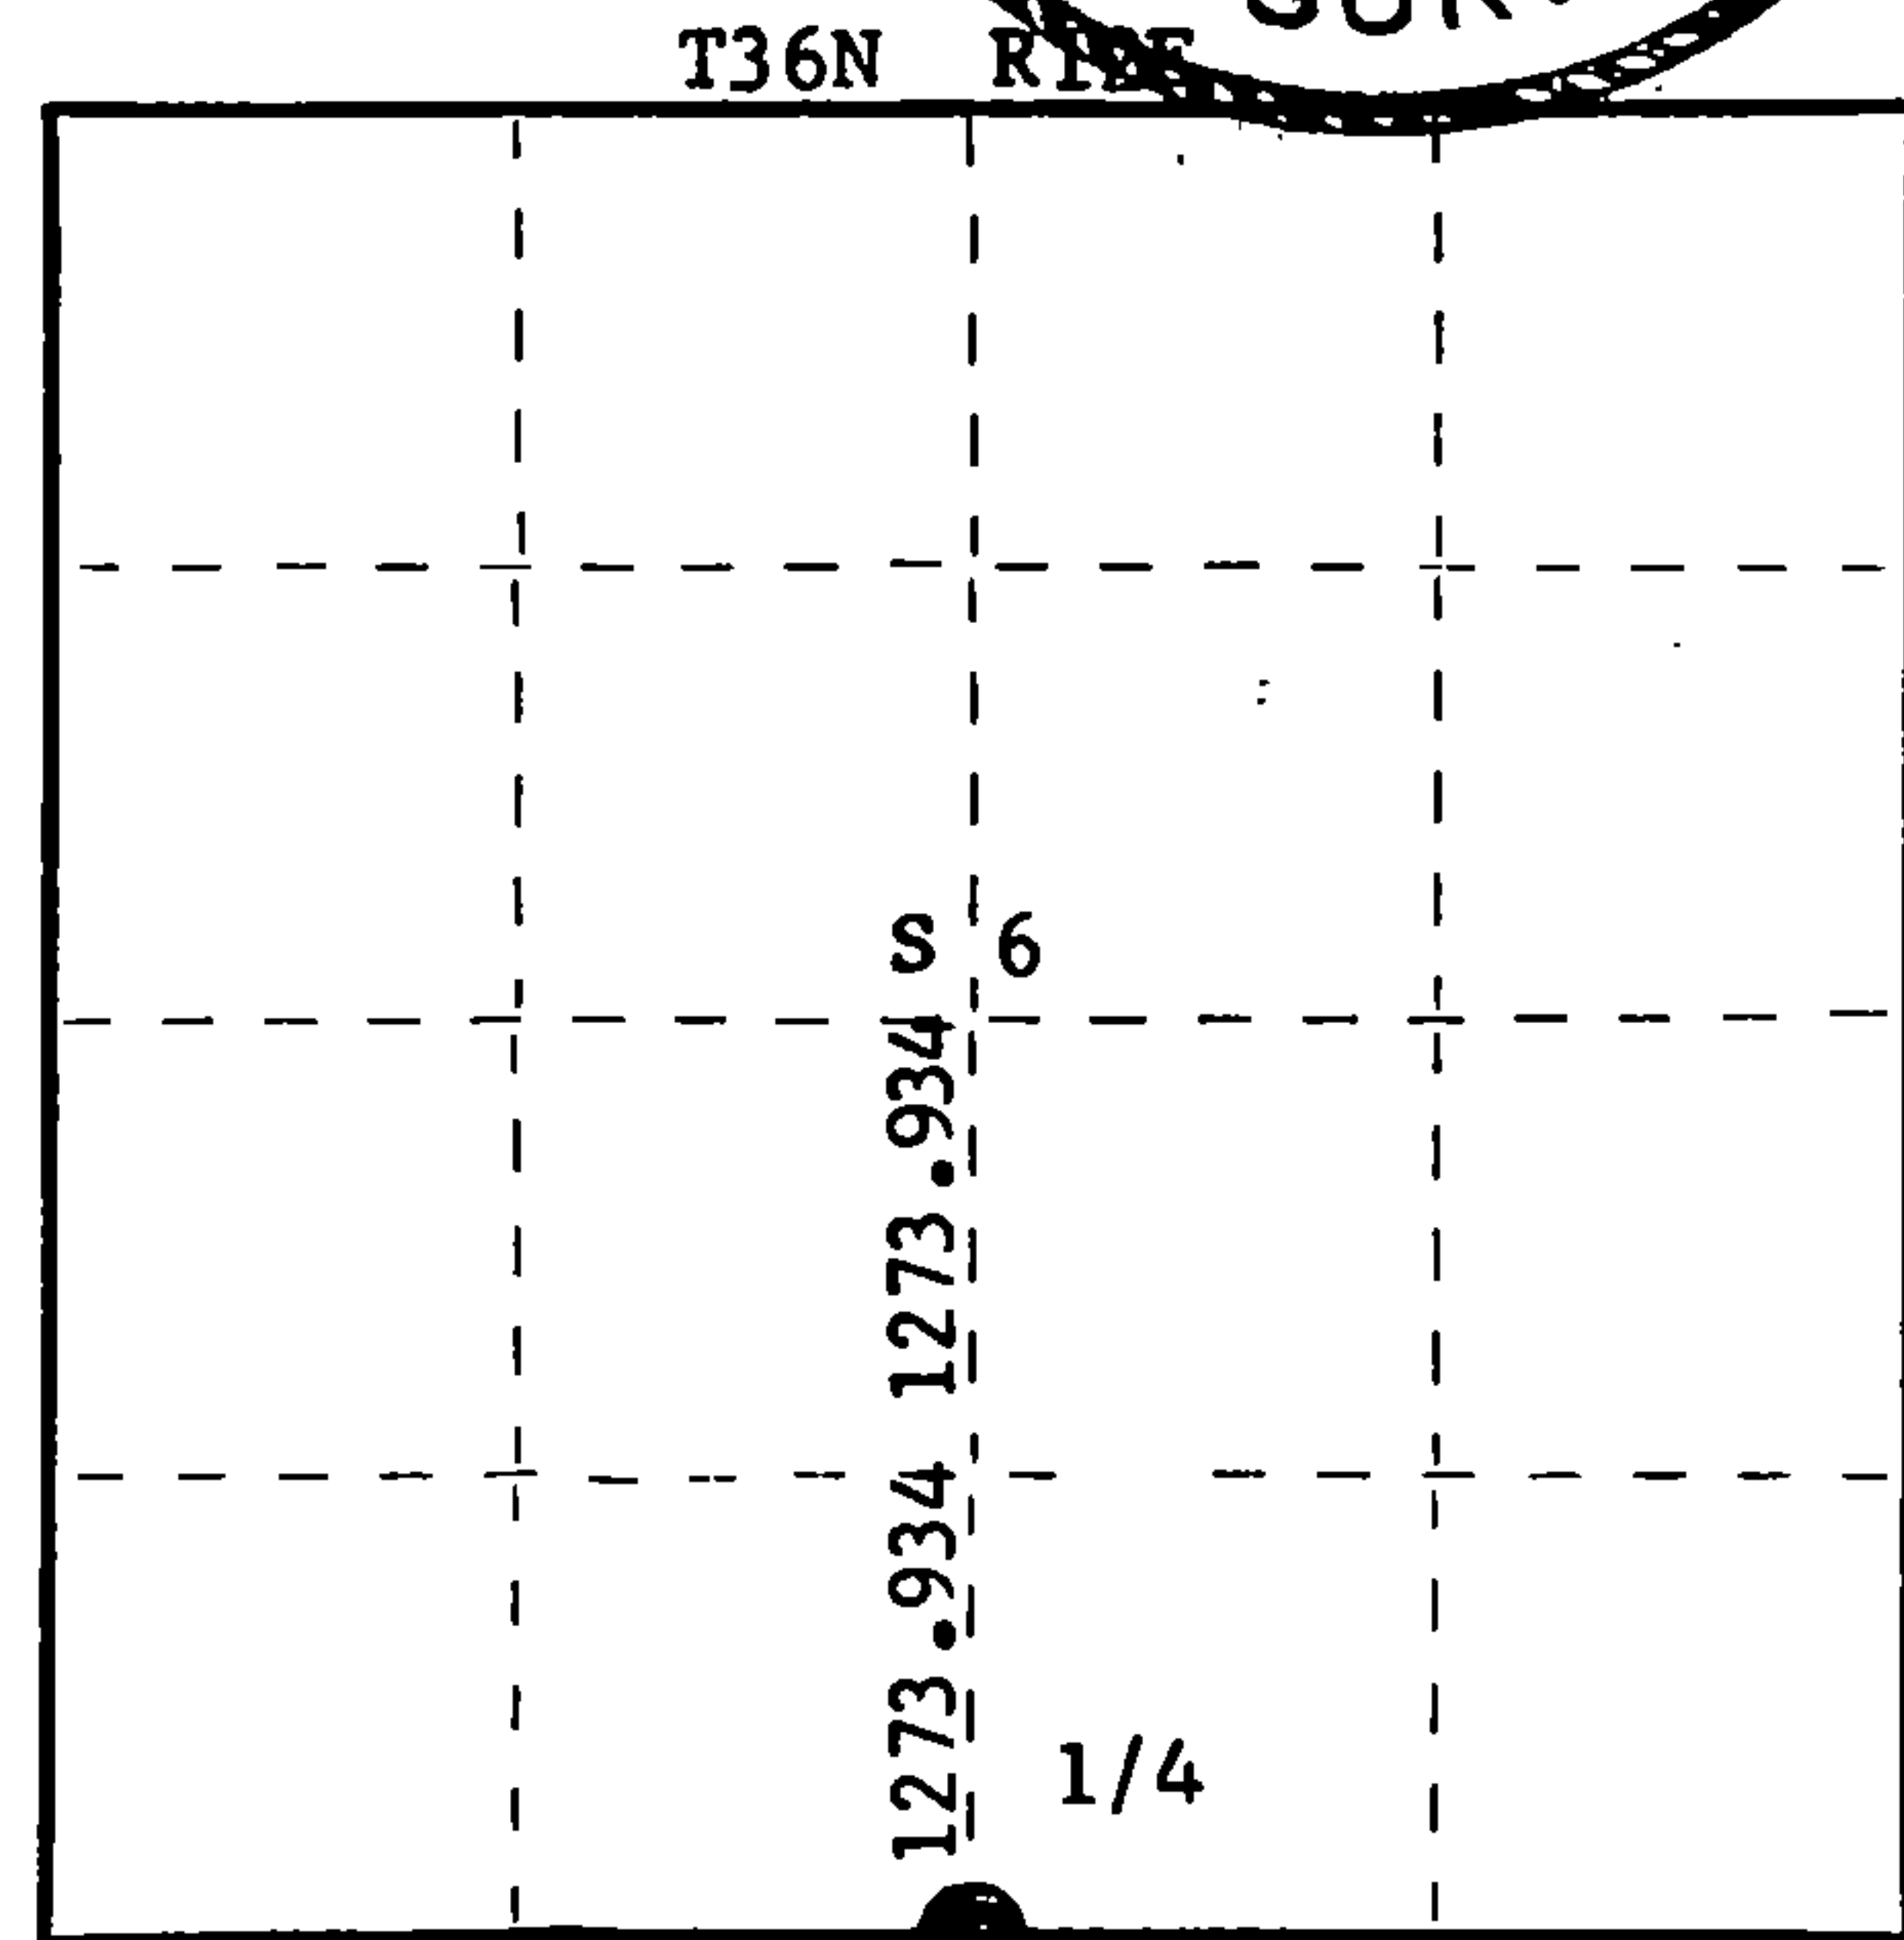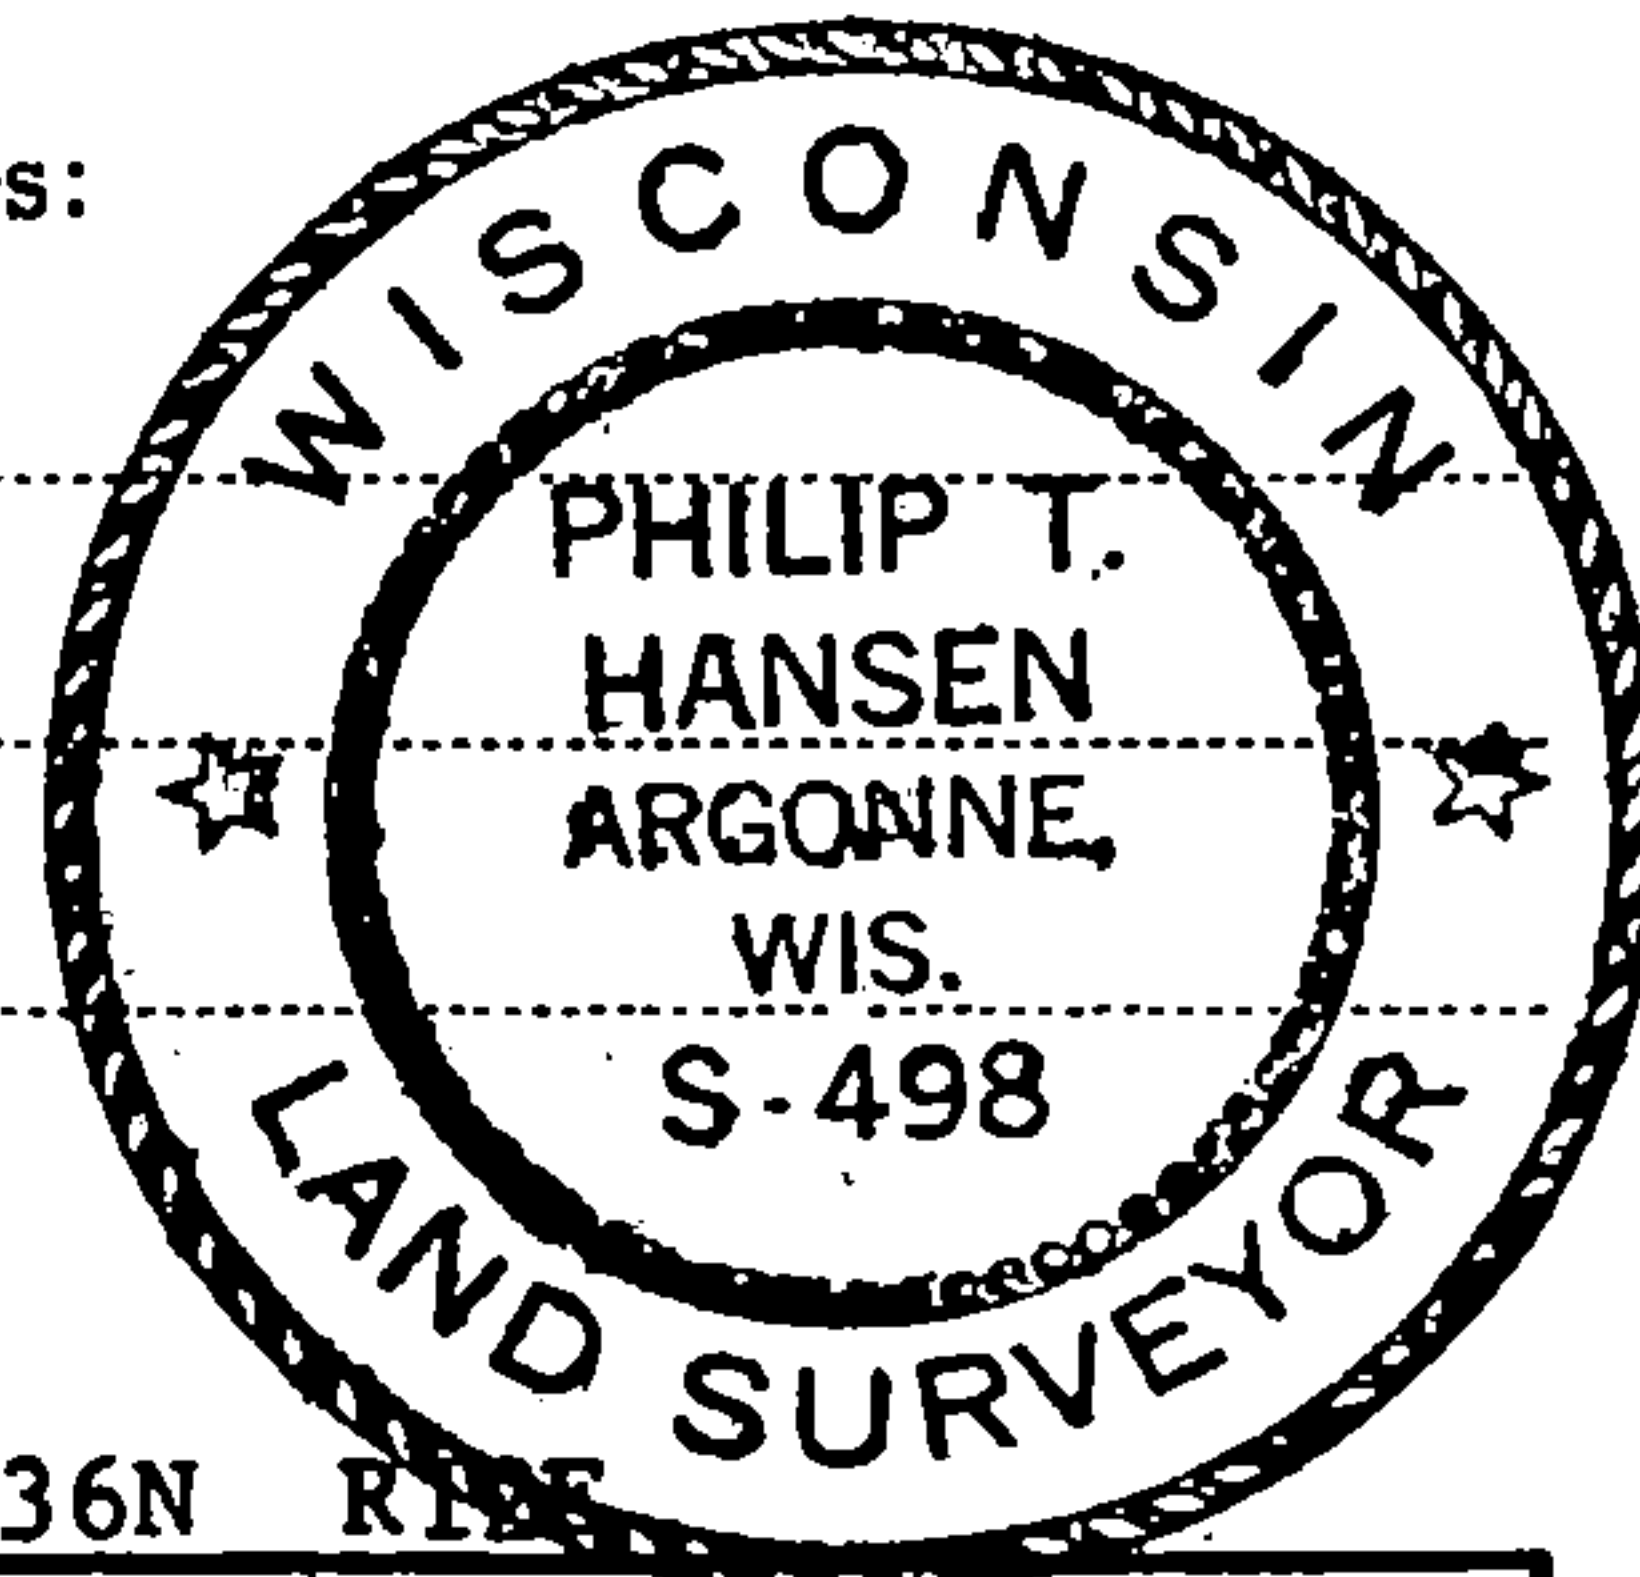

○ = Corner monument restored.

History of original corner establishment:

Corner established by Alfred Millard, Deputy Surveyor, in 1858. No records of any subsequent survey.

Description of corner evidence found:

No evidence of any corner or accessories recovered.
Corner established by traverse and computation.
Ran traverse from established C 1/4 corner to SC 1/16 section 6.
Computed distance is 1273.934 feet at bearing S 4° 22' 44" E.
Doubled this distance and set S 1/4 corner at 2547.868 feet from C 1/4.

Description of monument and accessories I established to perpetuate the original location of this corner.

Set a 2-1/2" Berntsen A-1 Federal Monument projecting 18" - stamped:

Marked NBT's -
Cedar 8" S61°E 30.0'
Cedar 9" N49°E 27.2'
Cedar 12" N21°E 33.0'
Cedar 8" N29°W 54.43'
all BT's scribed 1/4 BT

T36N R12E
1/4 S+6
S+7
S498 - 1978

Dated at Rhineland, Wis., this 16th day of May, 19 80

Signature Philip T. Hansen Title Registered Land Surveyor Registration No. S-498
(County Surveyor, Registered Land Surveyor, or other duly authorized official)

Office of Register of Deeds, County of Forest, I hereby certify that the within instrument was filed in this office for record on the 2nd day of June, 19 80 at 8:30 o'clock A. M.

Eugene Stegemyer
(Register of Deeds)
By _____ Deputy

DOCUMENT NO. **117998**

FORM 985 M. C. MILLER CO., MILWAUKEE

43612060020