

CERTIFIED LAND CORNER RESTORATION

Index No. **C-3**

State of Wisconsin }  
County of Forest } ss.


I Philip T. Hansen, do hereby certify that on the 29th day of July, 1976, I found evidence of the C 1/4 corner of Section 6 Township 36, North, Range 12 East, Fourth Principal Meridian, as described hereon; and that from this evidence I established a new monument and accessories as described hereon to perpetuate the original location of this corner.

Resident witnesses:


Glen Barker

Jim Claflin

Herb Wagoner

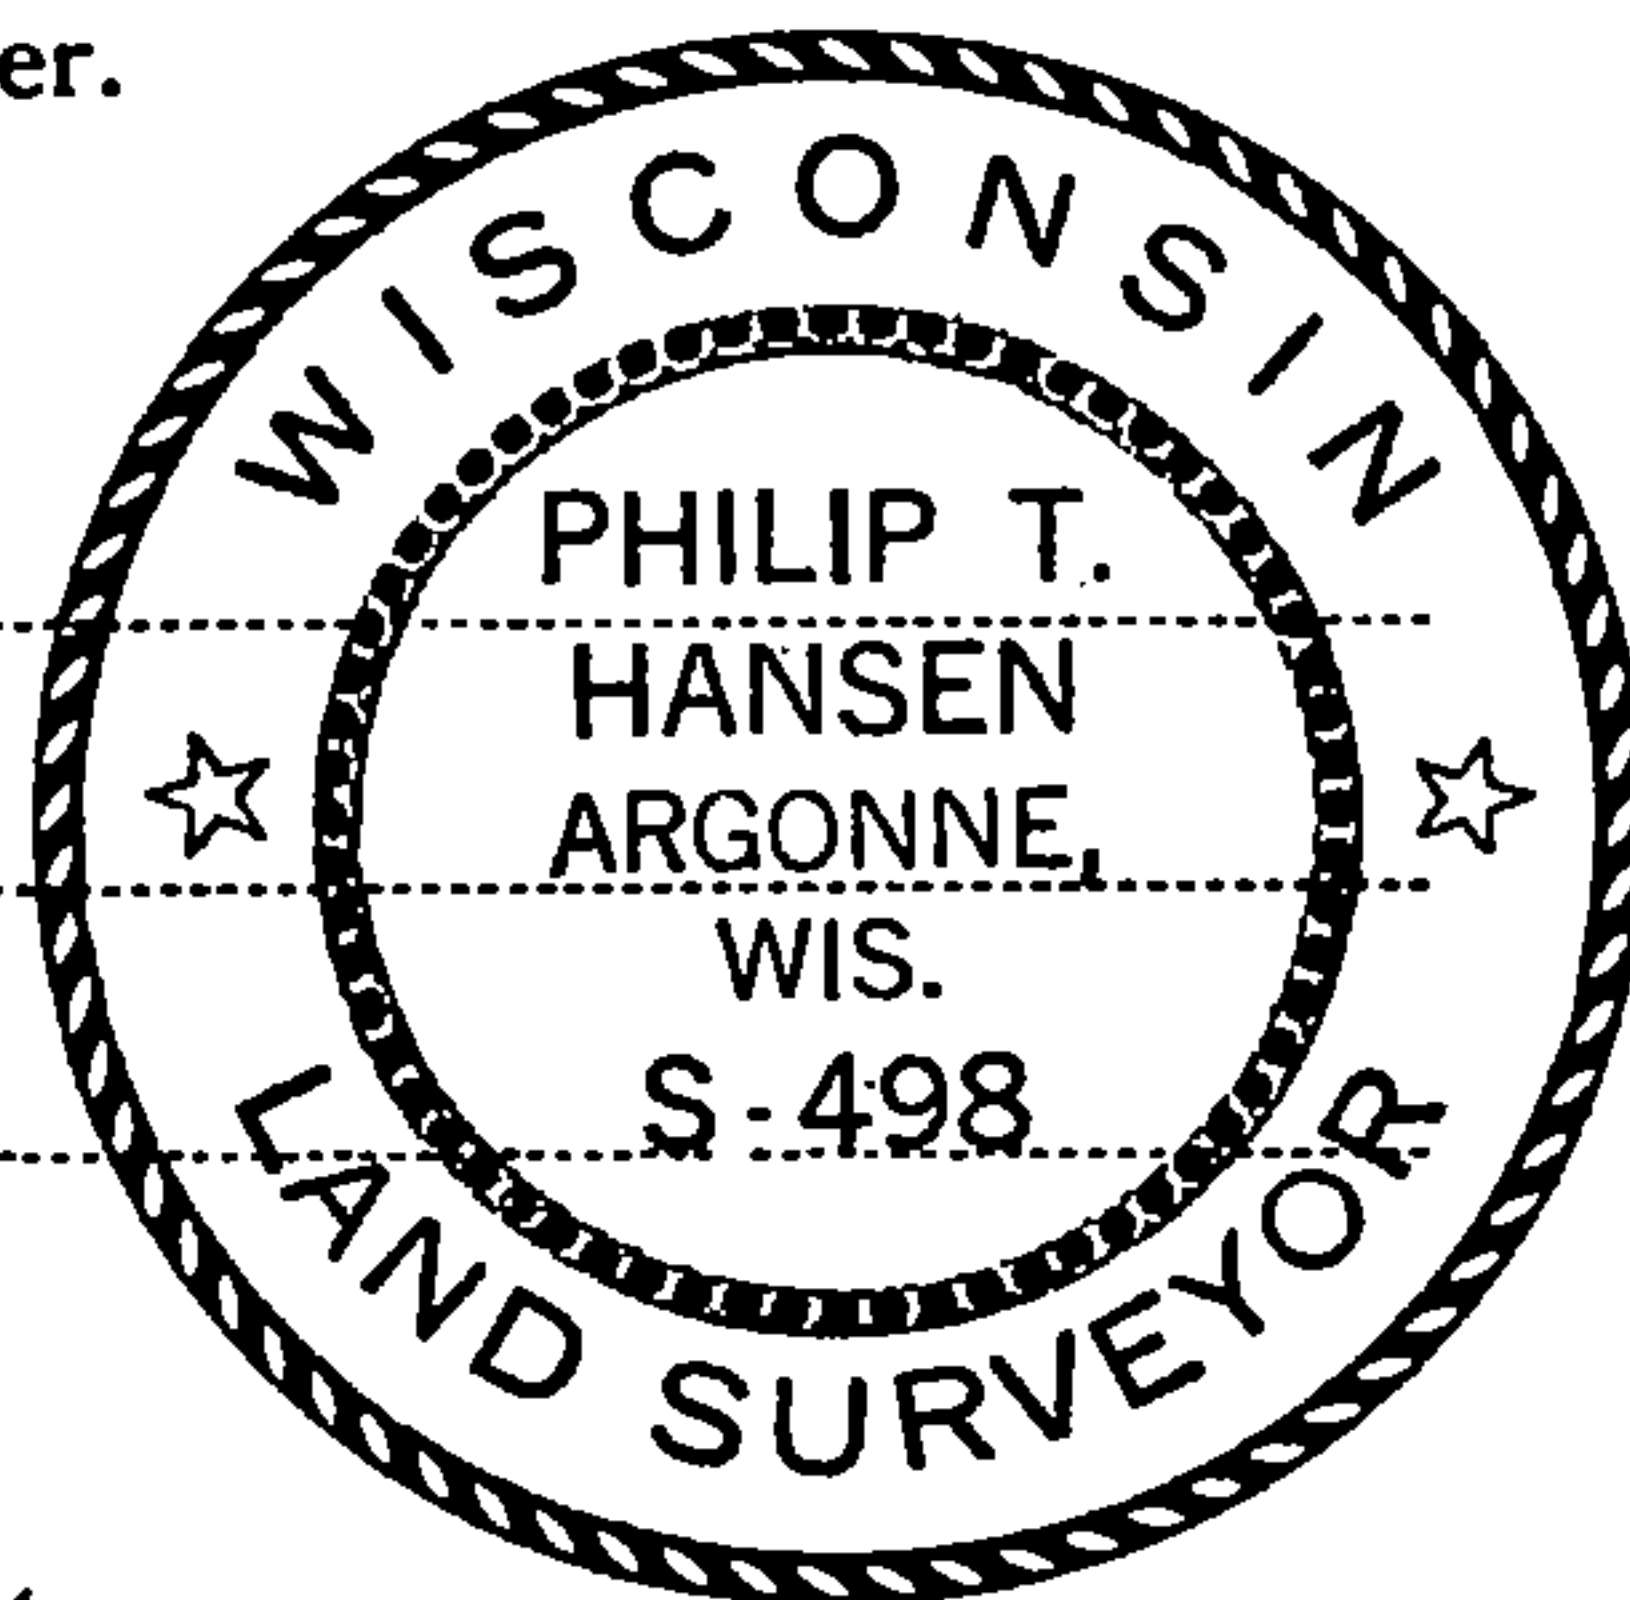

FORM 985 W. G. MILLER CO., MILWAUKEE

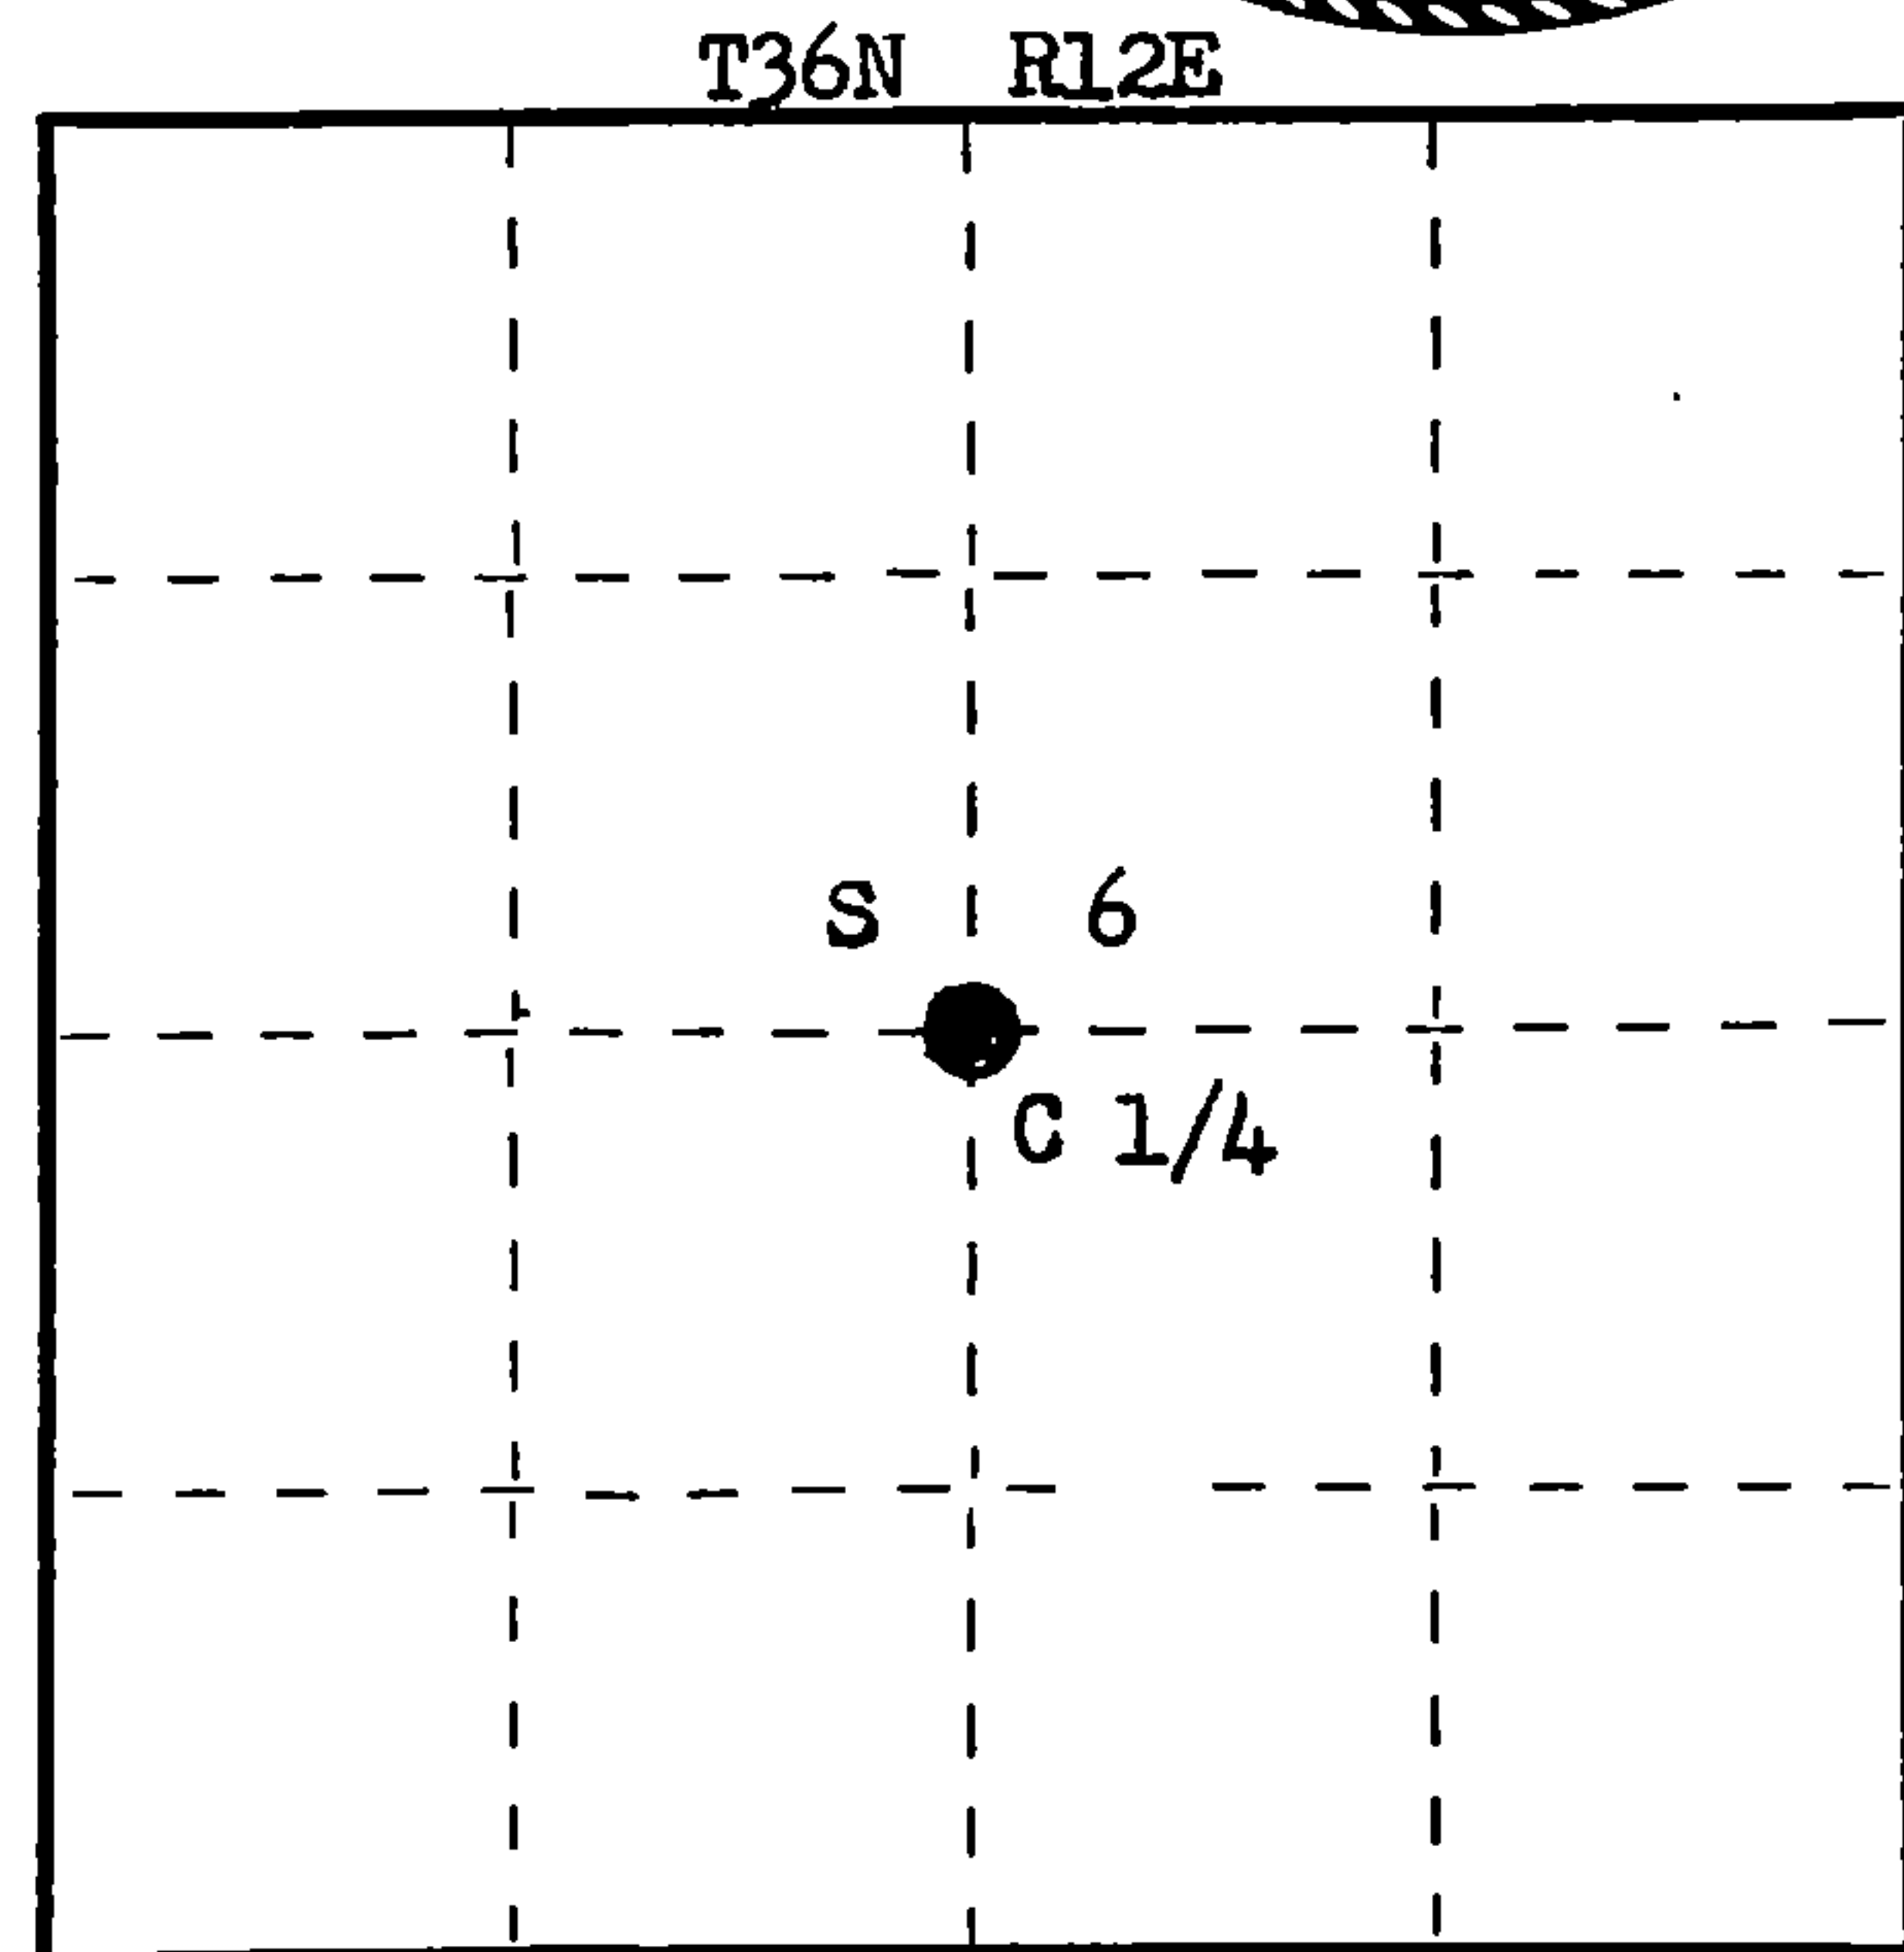

○ = Corner monument restored.

History of original corner establishment: Corner established by H.C. Lawrence, Registered Land Surveyor, in 1957. Ran E-W and N-S 1/4 lines from established 1/4 Corners and set C 1/4 corner at 2.00 chs north and 1.13 east of the intersection of 1/4 lines. Set 4" cedar post.

Description of corner evidence found:

Recovered 4" cedar post laying down, scribed C1/4S S6, C1/4 S6. Recovered the hole in which it set.  
No record or evidence of BTs established.

Description of monument and accessories I established to perpetuate the original location of this corner.

Replaced wood post with 2 1/2" Berntsen A-1 Federal Monument, stamped.  
Monument projects 18" above ground.

NBTs - Cedar 8" S 7° W 14 lks, scribed C1/4 BT.  
Cedar 8" S 22° E 33.7 lks, scribed C1/4 BT.  
Cedar 7" N 43° E 51.7 lks, scribed C1/4 BT.

Corner sets 4 chains west of a N-S logging road.  
Monument and BTs painted blue.

T36N R12E  
C 1/4 S 6  
S498-1976

Dated at Rhineland, Wis., this 10th day of August, 1976.

Signature Philip T. Hansen Title Registered Land Surveyor Registration No. S-498  
(County Surveyor, Registered Land Surveyor, or other duly authorized official)

Office of Register of Deeds, County of Forest, I hereby certify that the within instrument was filed in this office for record on the 8th day of September, 1976 at 10 o'clock A M.

Eugene Staszny  
(Register of Deeds)  
By \_\_\_\_\_ Deputy

DOCUMENT NUMBER  
**110106**

43612062020