

CERTIFIED LAND CORNER RESTORATION

C-2 Index No. C 2


State of Wisconsin }
County of Forest } ss.

I, Philip T. Hansen, do hereby certify that on the 8th day of October, 1975, I found evidence of the WC-1/16 corner of Section 6 Township 36 North, Range 12 East, Fourth Principal Meridian, as described hereon; and that from this evidence I established a new monument and accessories as described hereon to perpetuate the original location of this corner.


Resident witnesses:

Glen Barker

Jim Claflin

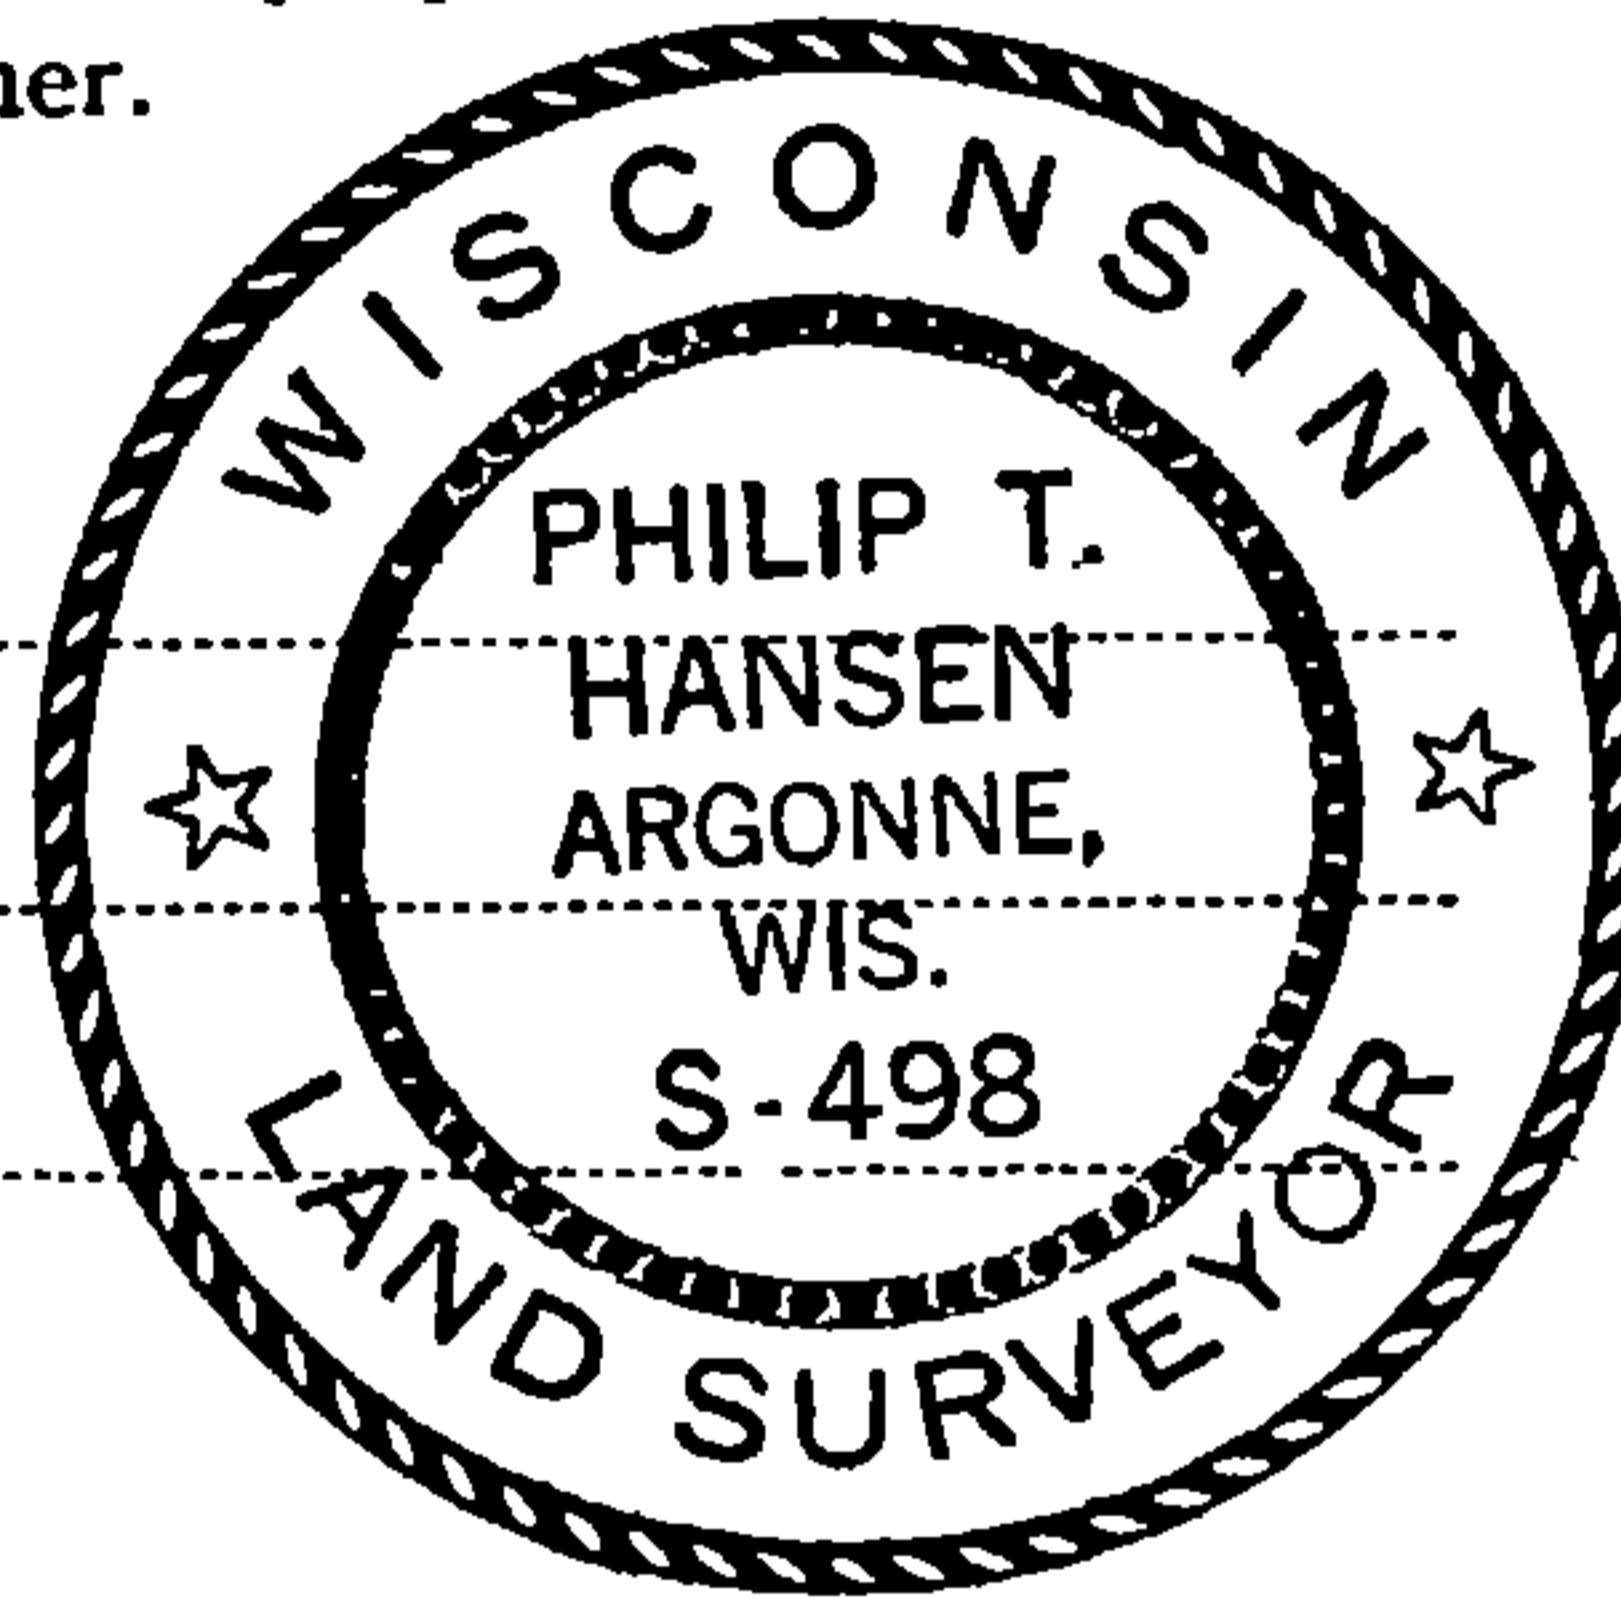

T36N R12E

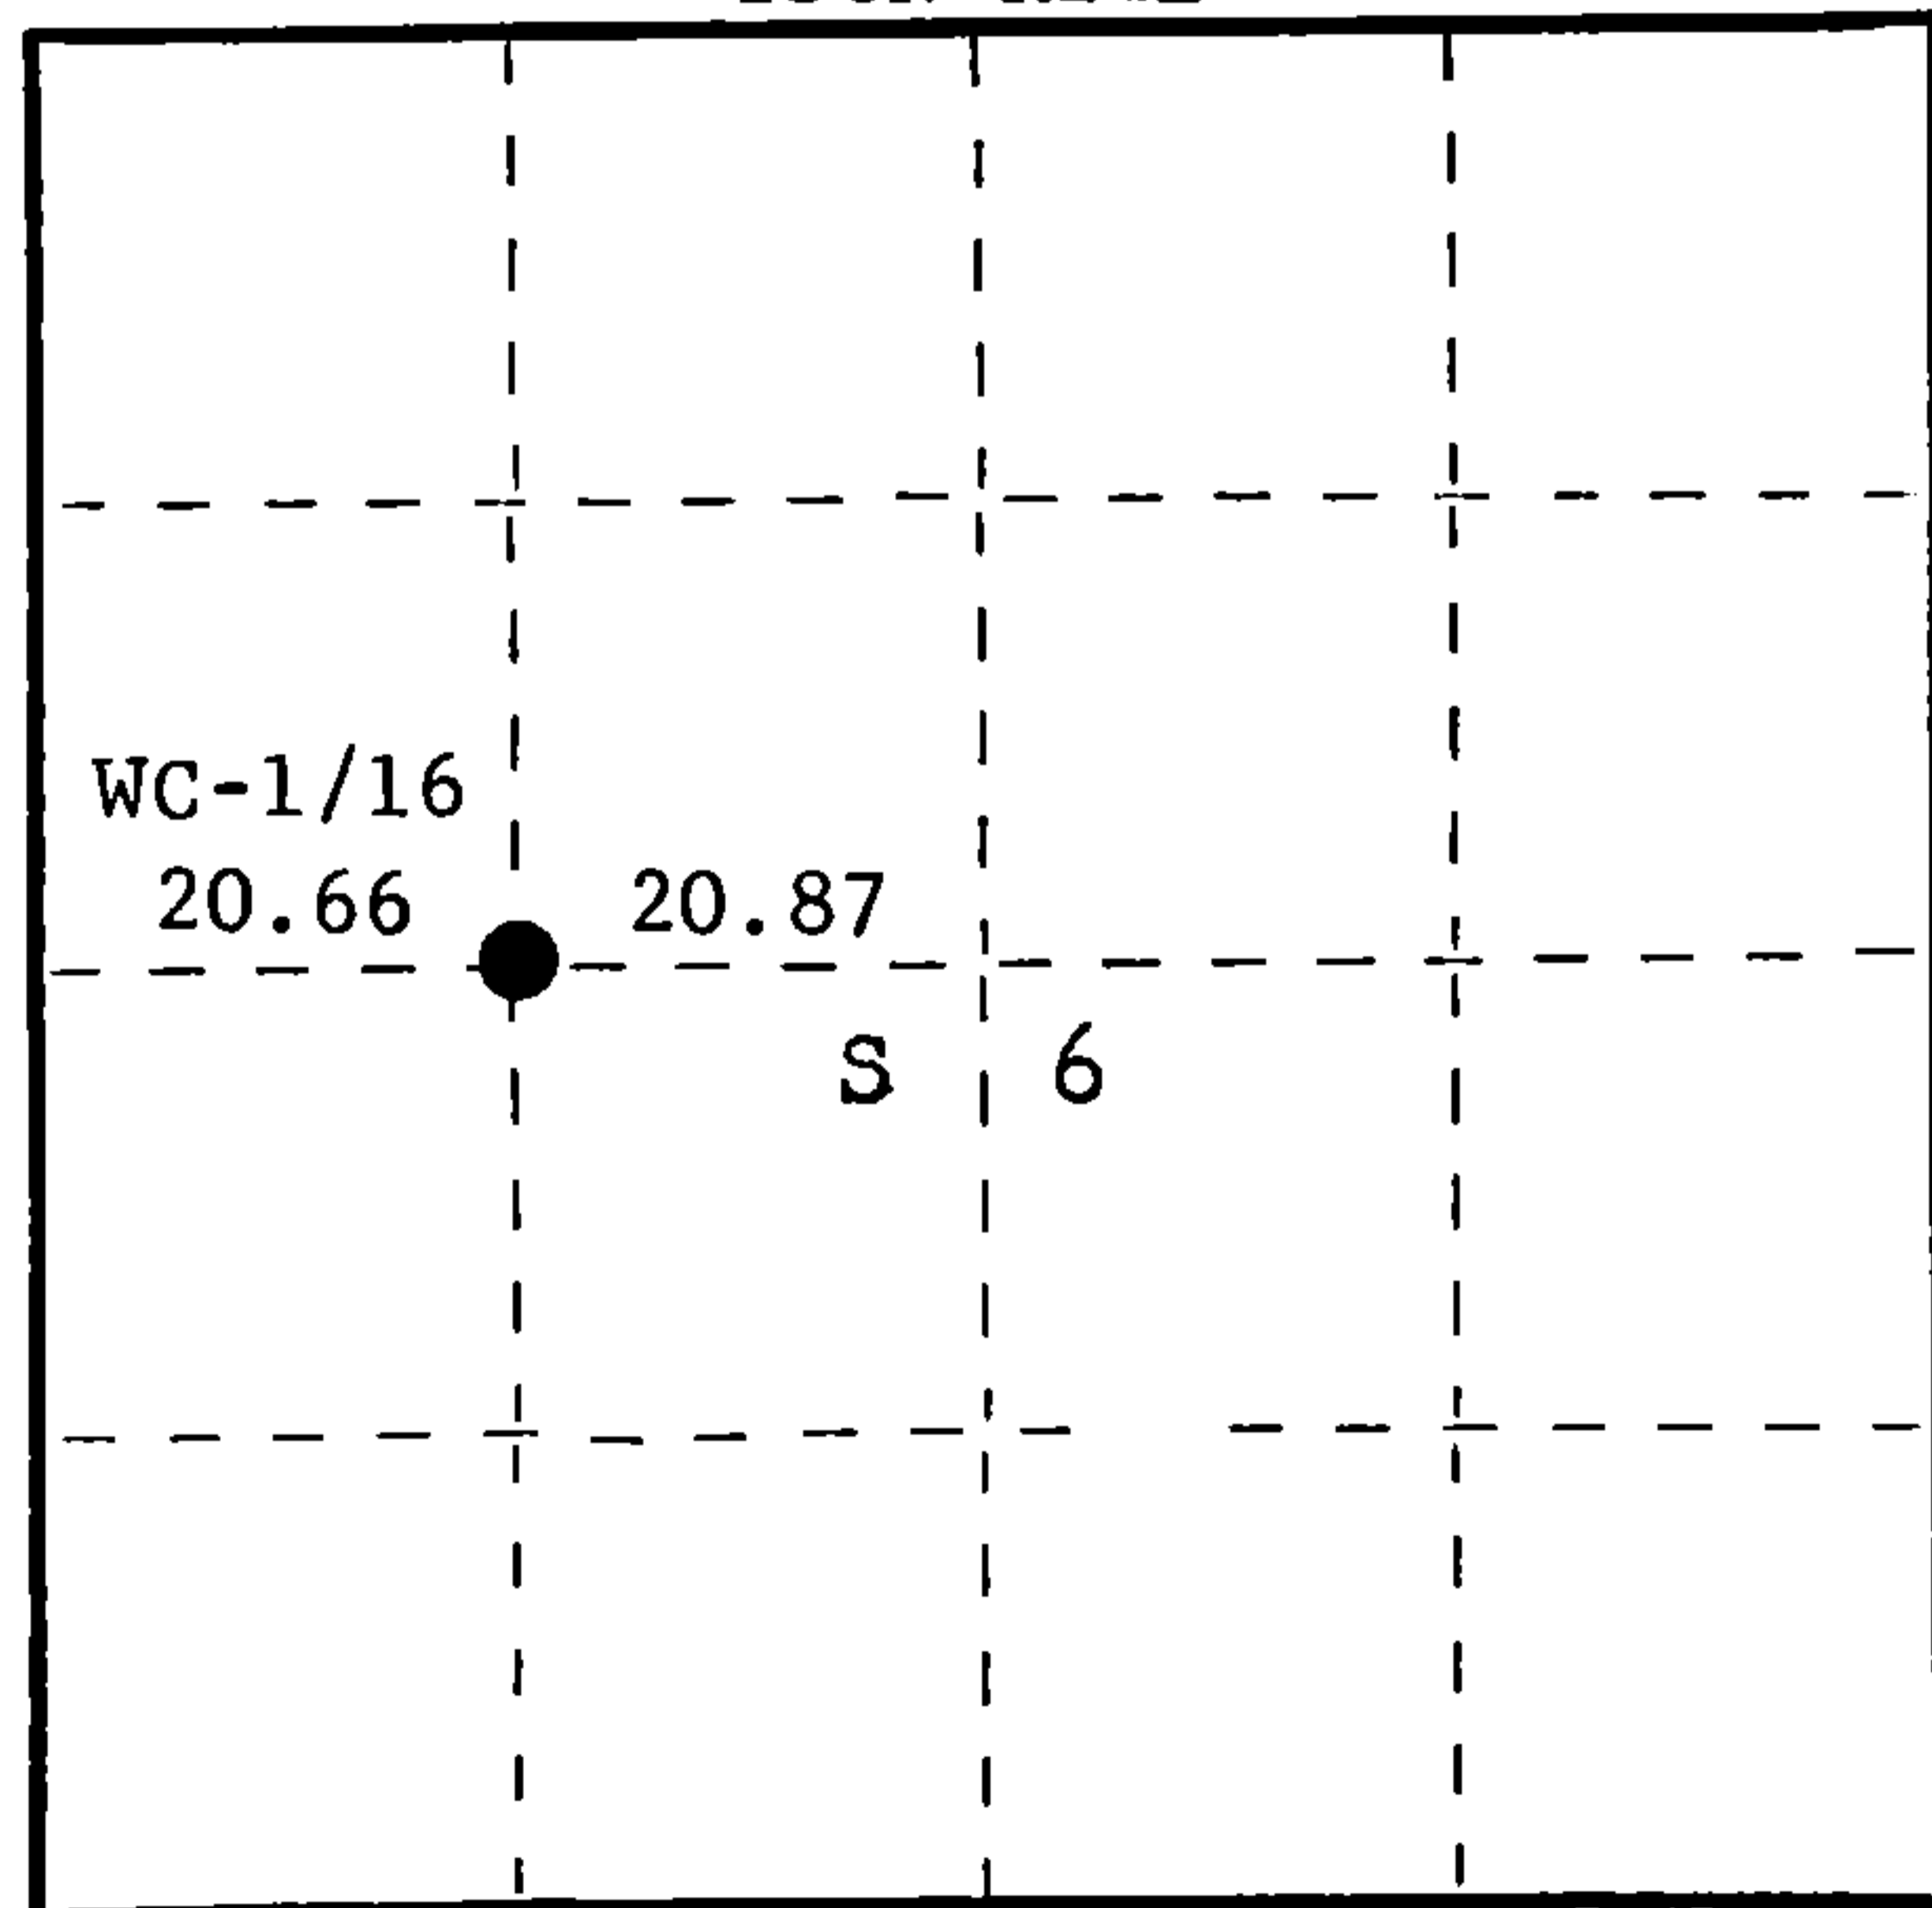

○ = Corner monument restored.

History of original corner establishment:

Corner established by H.C. Lawrence, Registered Land Surveyor, in 1956. From established C-1/4 corner, he set WC-1/16 corner, 20.87 chains west and 20.66 east from W-1/4 corner. Set 4" cedar post and marked NBT's: Sugar 6" N20°E 4 links and Sugar 12" S19°W 26-1/2 links.

Description of corner evidence found:

Recovered 4" cedar post, squared and scribed WC-1/16 S6, WC-1/16 in fair condition.
Recovered OBT's: Sugar 6" (7") N20°E 4 links - scribing grown over.
Sugar 12" (14") S19°W (S22°W) 26.5 links - scribing grown over.

Description of monument and accessories I established to perpetuate the original location of this corner.

Replaced 4" cedar post with 1-1/2" OD iron pipe with 2" brass cap stamped - S498
Iron post projects 18" above ground. T36N R12E
No additional accessories established.
Pipe and BT's painted blue.

WC-1/16
S 6
CPI-1975

Dated at Argonne, Wis., this 13th day of October, 1975.

Signature: *Philip T. Hansen* Title Registered Land Surveyor Registration No. S-498
(County Surveyor, Registered Land Surveyor, or other duly authorized official)

Office of Register of Deeds, County of Forest, I hereby certify that the within instrument was filed in this office for record on the 16th day of October, 1975 at 2:30 o'clock P.M.

Eugene Stutzman
(Register of Deeds)

By Deputy

DOCUMENT NUMBER 107987

FORM 985 H. C. MILLER CO., MILWAUKEE

436120102030