

CERTIFIED LAND CORNER RESTORATION

B-5 Index No. B 5


State of Wisconsin }
County of Forest } ss.

I, Philip T. Hansen, do hereby certify that on the 6th day of October, 1975, I found evidence of the N-1/16 corner of Sections 5 and 6 Township 36 North, Range 12 East, Fourth Principal Meridian, as described hereon; and that from this evidence I established a new monument and accessories as described hereon to perpetuate the original location of this corner.


Resident witnesses:

Glen Barker

Jim Claflin

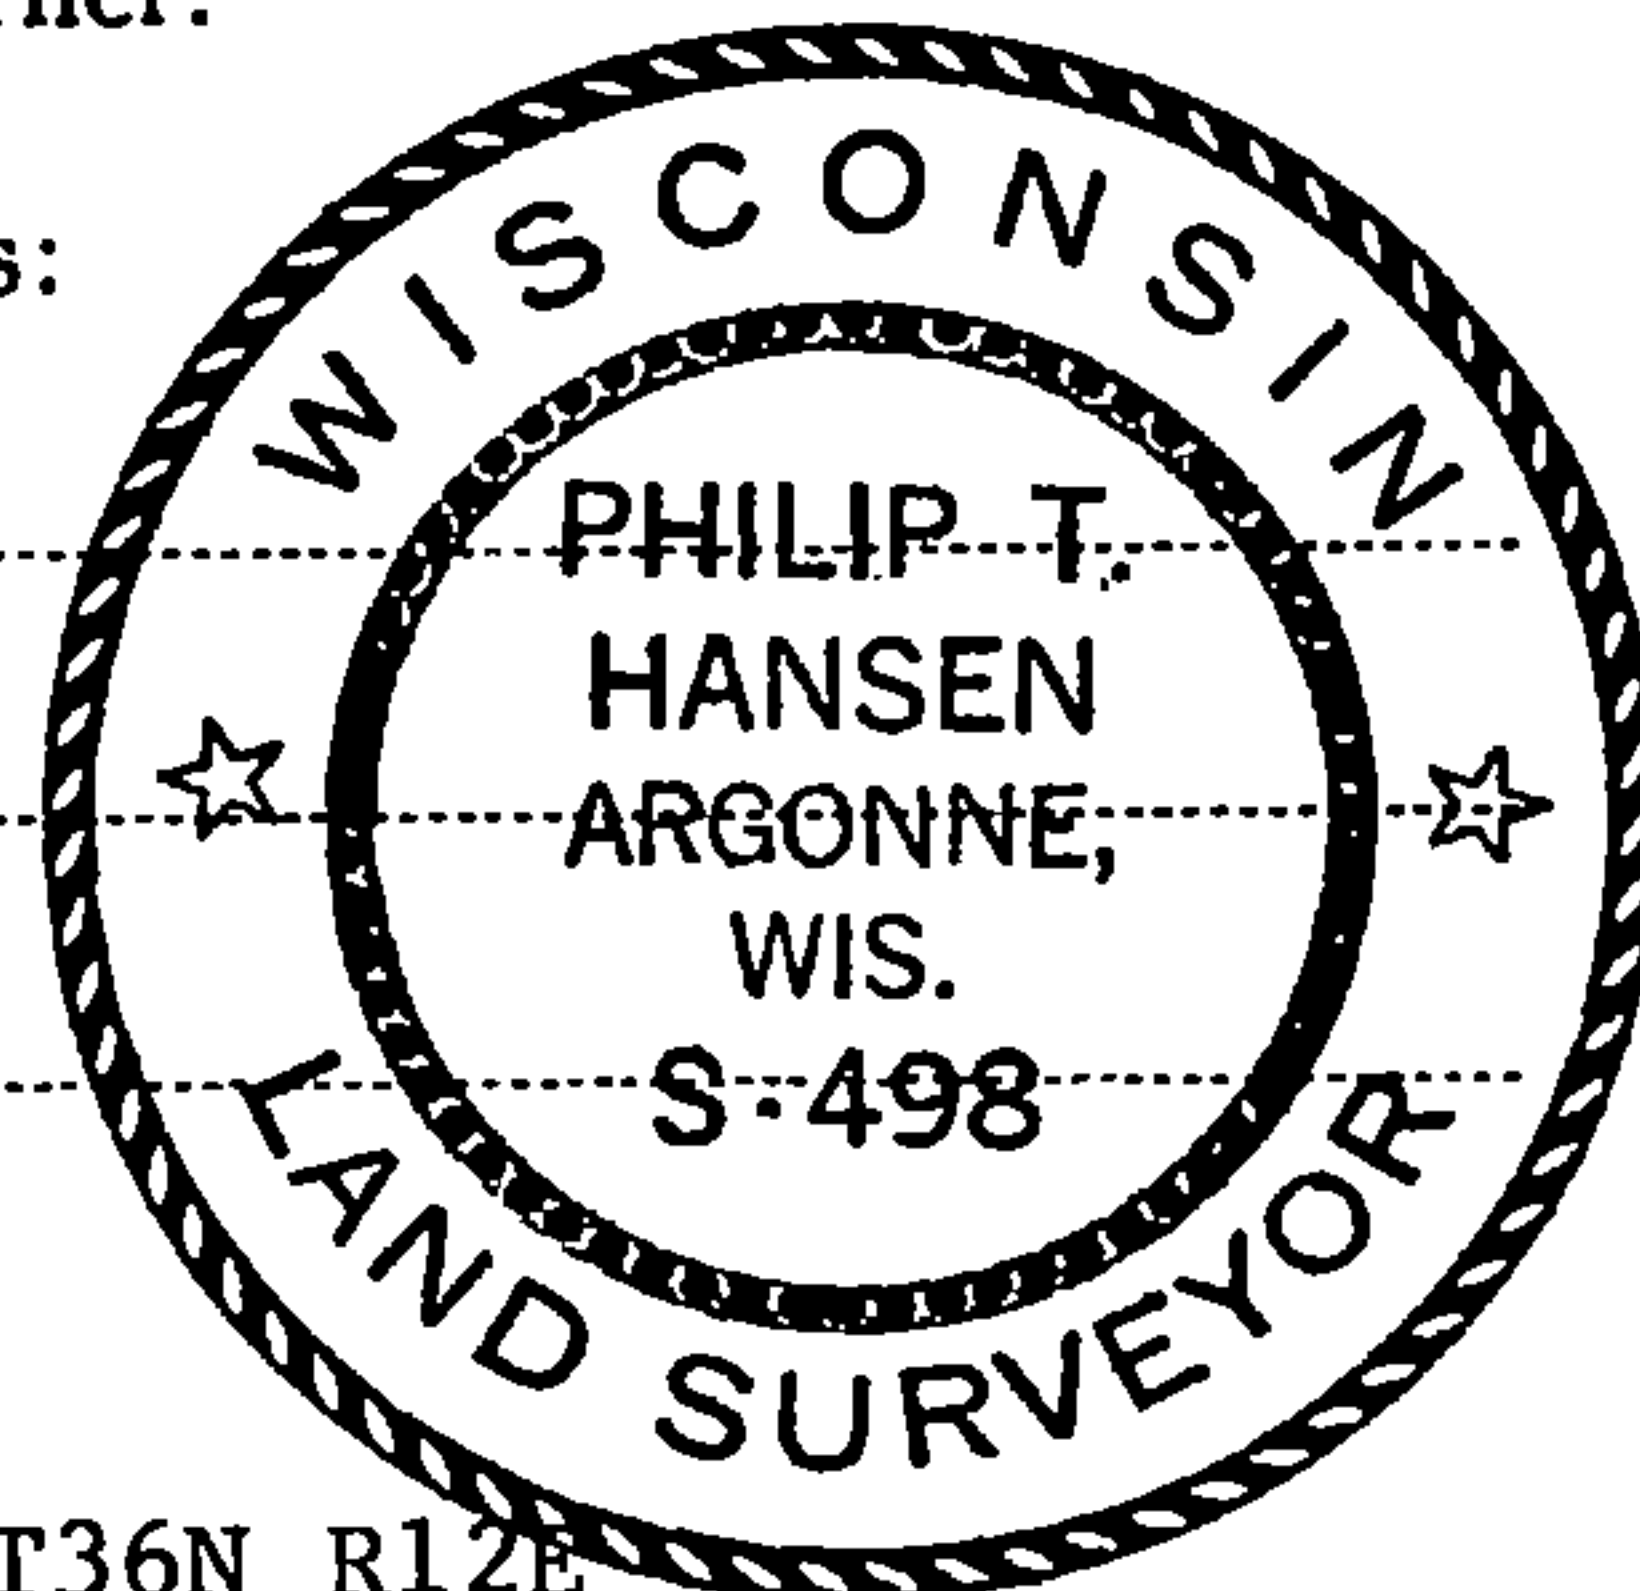

T36N R12E

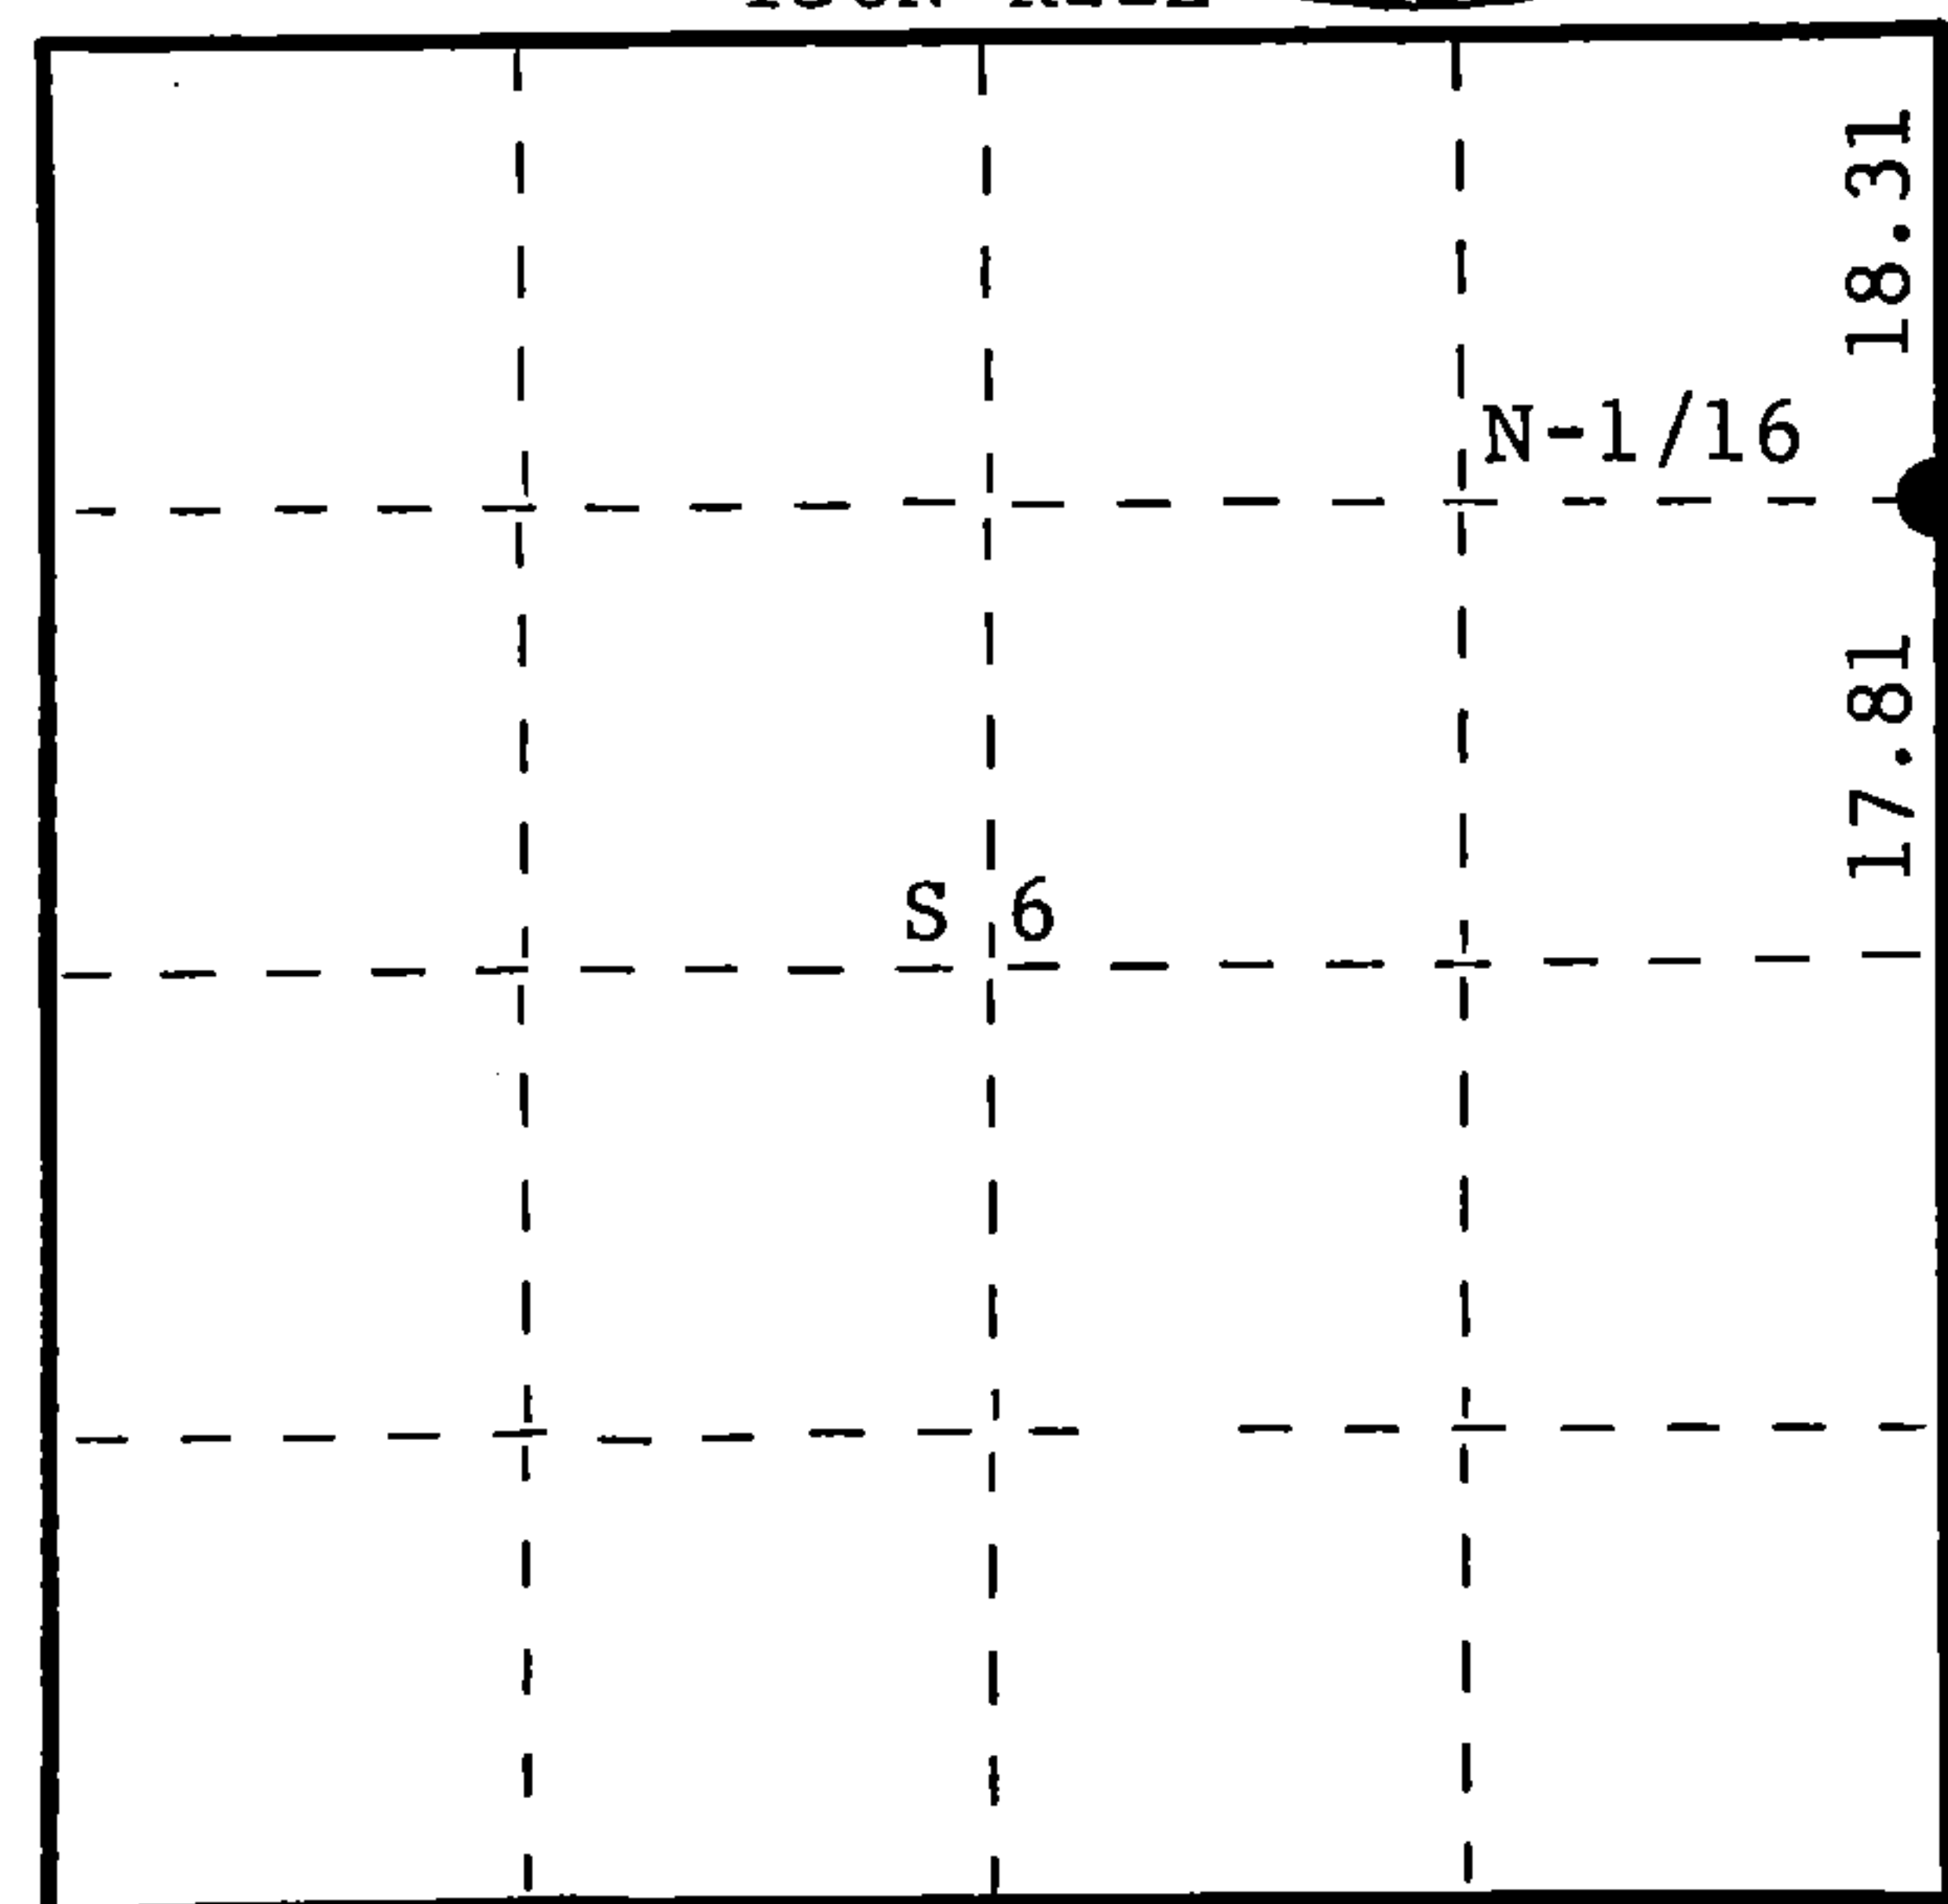

○ = Corner monument restored.

History of original corner establishment:

Original corner established by H.C. Lawrence, Registered Land Surveyor, in 1958. Ran random line south from Section Corner 31, 32, 5, and 6, and at 71.74 chains he was 8.50 chains west of Section Corner 5, 6, 7, and 8. Corrected bearing of line south 6°45'E, original government survey distance, S-1/2, 40.00 chains N-1/2, 40.57 chains. He reran line south on corrected bearing and found old blazes agreeing with his line. At 40.19 he intersected his E-W 1/4 line, 81.76 chains east of W-1/4 corner. Set 1/4 corner at 36.12 chains south of Section Corner and the N-1/16 corner at 18.31 chains south of Section Corner, and 17.81 chains north of 1/4 corner, marked cedar 16", N35°W, 12 links for BT.

Description of corner evidence found:

Recovered 3" cedar post, squared and scribed N-1/16 S5, S6 in poor condition but still standing.

Recovered OBT: Cedar 16" (17") N35°W 12 links - scribed N-1/16 S6 BT.

Description of monument and accessories I established to perpetuate the original location of this corner.

Replaced 3" cedar post with 1-1/2" OD iron pipe w/2" brass cap stamped -

S498
T36N R12E

NBT: Cedar 12" N89°W 39.3 links - scribed 1/16 BT.
Post and NBT painted blue.

N-1/16 S6/S5
CPI-1975

Dated at Forest, Wis., this 13th day of October, 1975.

Signature *Philip T. Hansen* Title Registered Land Surveyor Registration No. S-498
(County Surveyor, Registered Land Surveyor, or other duly authorized official)

Office of Register of Deeds, County of Forest, I hereby certify that the within instrument was filed in this office for record on the 16th day of October, 1975, at 2:30 o'clock P. M.

DOCUMENT NUMBER -- 107986

Eugene Staszny
(Register of Deeds)

By Deputy

FORM 985 H. C. MILLER CO., MILWAUKEE

43612003000