

CERTIFIED LAND CORNER RESTORATION

B-3 Index No. **B 3**



State of Wisconsin }  
County of Forest } ss.

I Philip T. Hansen, do hereby  
certify that on the 8th day  
of October, 1975, I found  
evidence of the NC-1/16  
corner of Section 6  
Township 36, North, Range  
12 East, Fourth Principal Meridian,  
as described hereon; and that from this evidence  
I established a new monument and accessories  
as described hereon to perpetuate the original  
location of this corner.

Resident witnesses:

Glen Barker

Jim Claflin

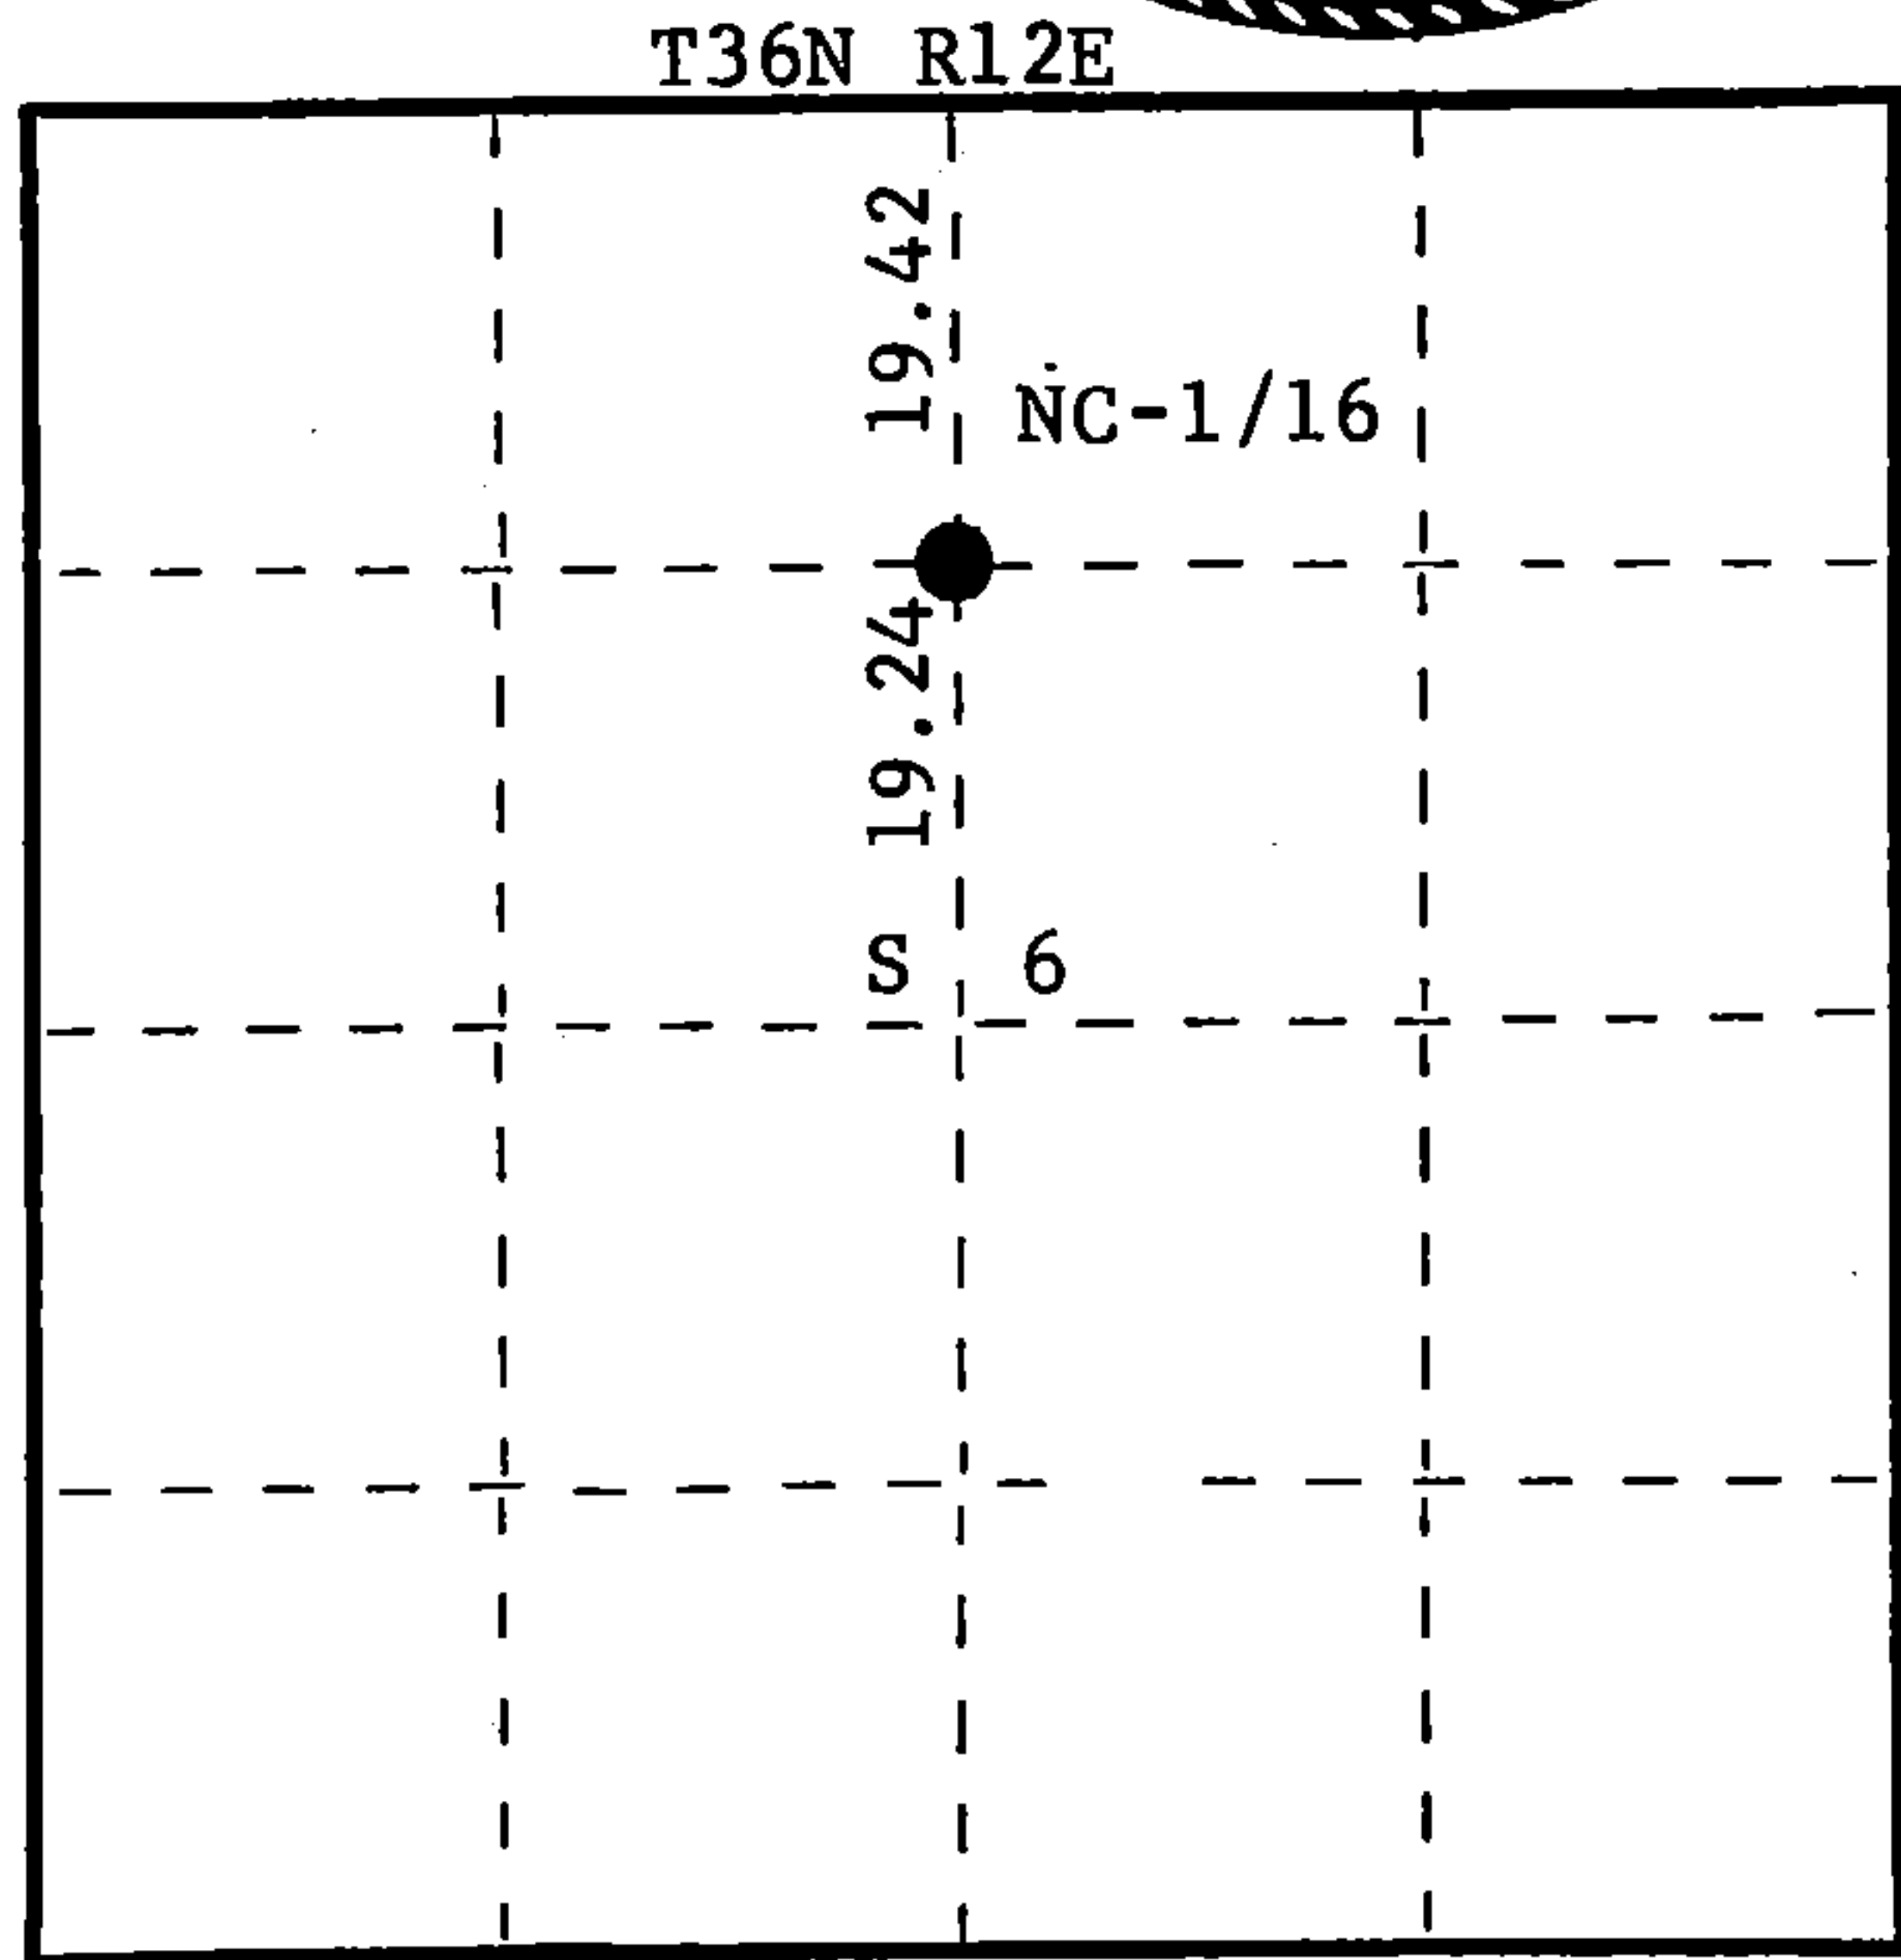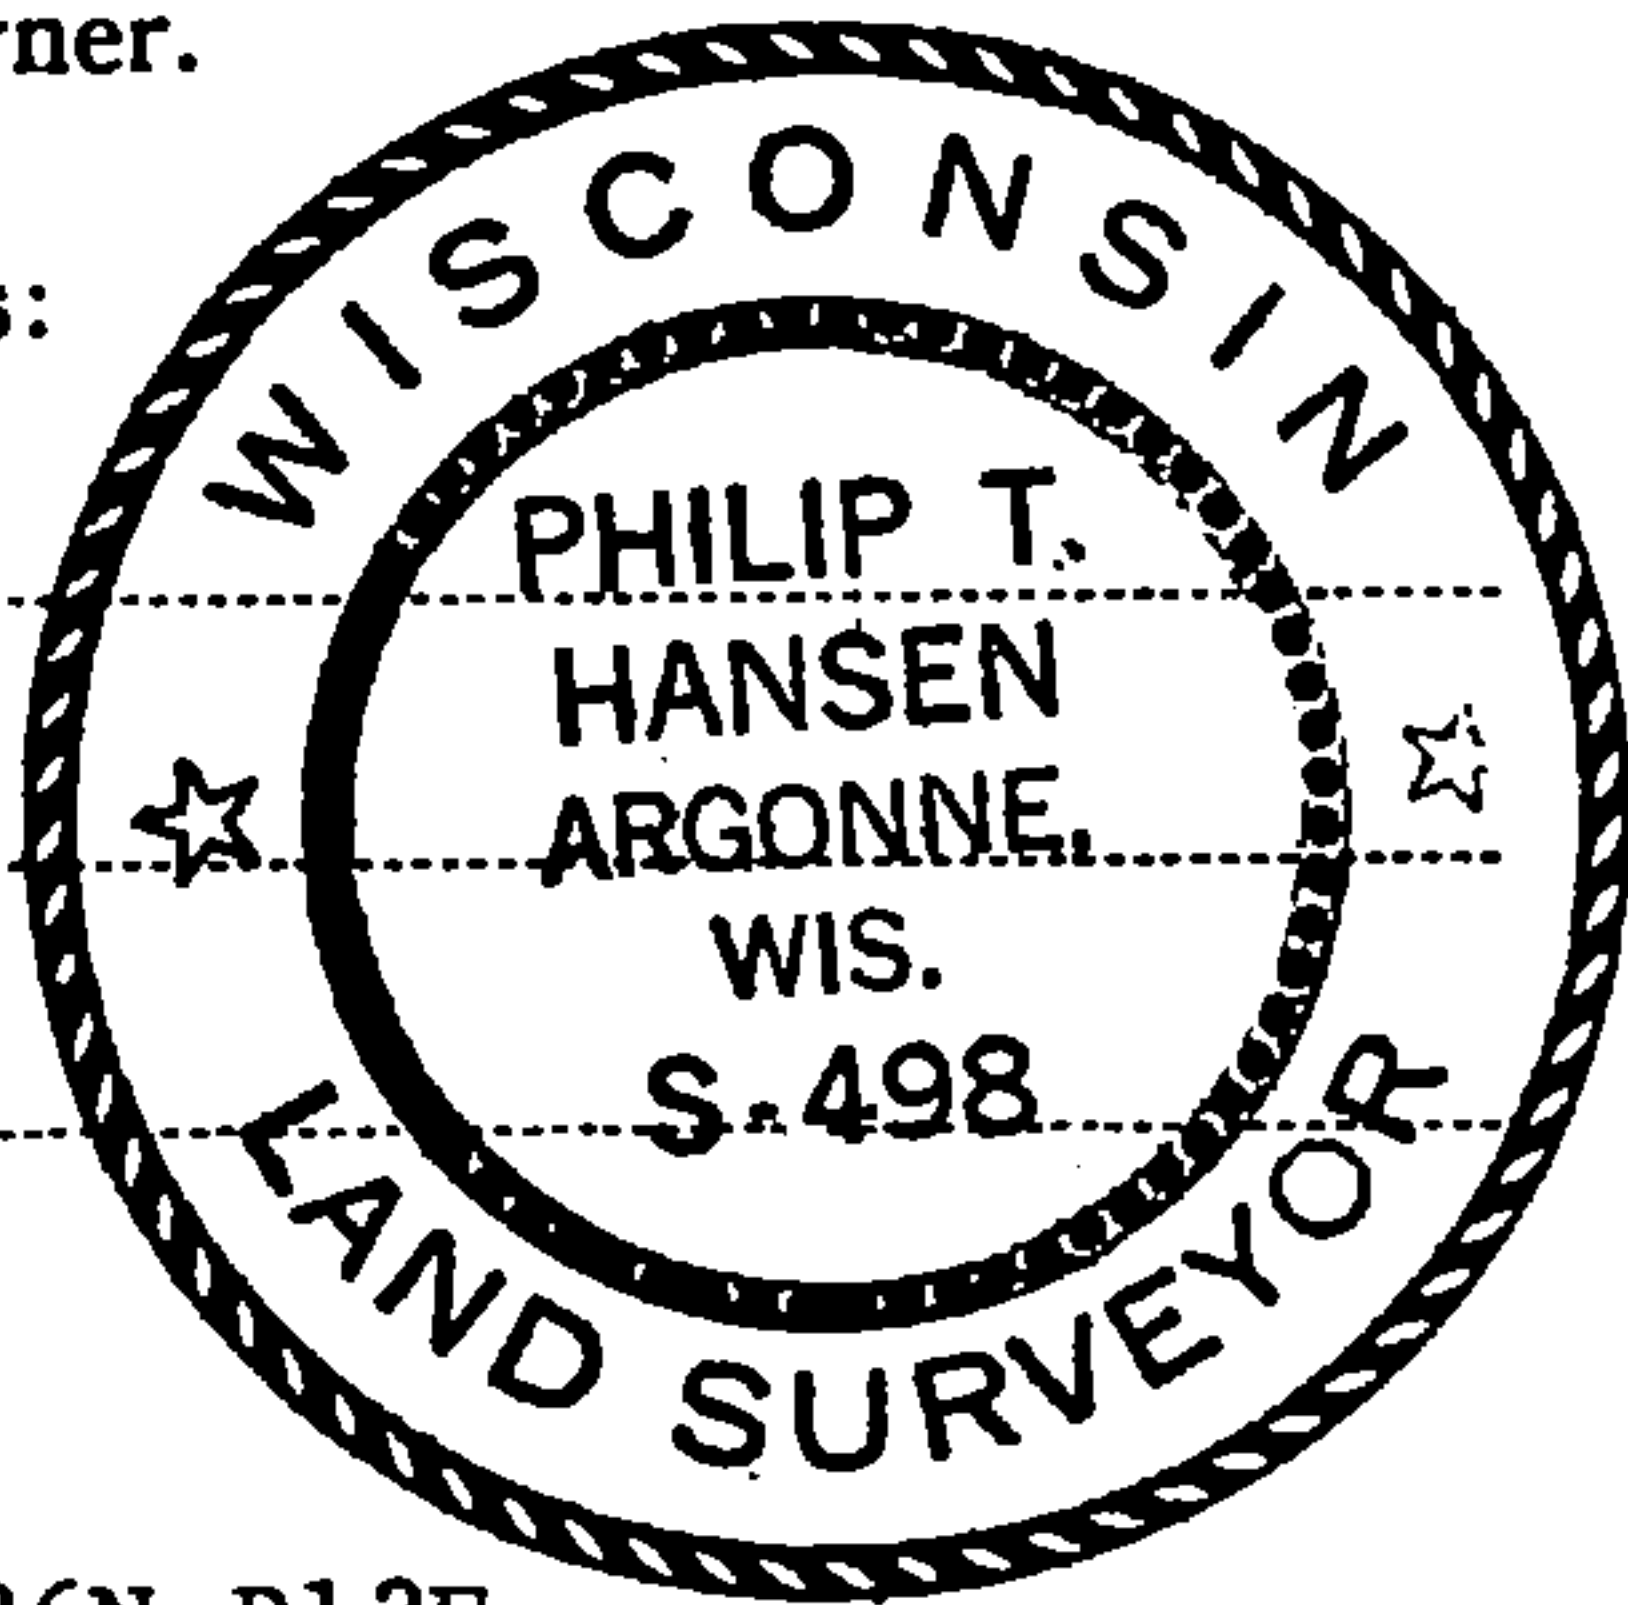

○ = Corner monument restored.

History of original corner establishment:

Corner established by H.C. Lawrence in 1956. He ran the N-S 1/4 line and the E-W 1/4 line. Established C-1/4 corner, 38.66 chains south of N-1/4 corner, 38.48 chains north of S-1/4 corner, 40.73 chains west of E-1/4 corner and 41.03 east of W-1/4. Set NC-1/16 corner, 4" cedar post, 19.24 chains north of C-1/4 corner and 19.42 chains south of N-1/4. Marked NBT's: Basswood 9" N6°W 14 links and Elm 11" S39°E 31 links.

Description of corner evidence found:

Recovered 4" cedar post, squared and scribed NC-1/16 S6, NC-1/16 S6 in fair condition. Recovered OBT's: Basswood 9" (10") N6°W (N3°W) 14 links (18.3 links) - scribed N-1/16 BT. Elm 11" (12") S39°E 31 links - scribing grown over.

Description of monument and accessories I established to perpetuate the original location of this corner. Replaced 4" cedar post with 1-1/2" OD iron pipe with 2" brass cap stamped - No additional accessories established. Post and BT's painted blue.

S498  
T36N R12E

NC-1/16  
S 6  
1975

Dated at Argonne, Wis., this 13th day of October, 1975.

Signature *Philip T. Hansen* Title Registered Land Surveyor Registration No. S-498  
(County Surveyor, Registered Land Surveyor, or other duly authorized official)

Office of Register of Deeds, County of Forest, I hereby certify that the within instrument was filed in this office for record on the 16th day of October, 1975, at 2:30 o'clock P.M.

*Eugene Staszny*  
(Register of Deeds)  
By Deputy

DOCUMENT NUMBER 107985