

# U.S. PUBLIC LAND SURVEY MONUMENT RECORD

Note: This form is intended and designed to fulfill all requirements of Wisconsin Administrative Code, Chapter A-E 7.08 U.S. Public Land Survey Monument Record (3) (a) (b) (c) (d) (e) (f) (g) (h) (i). An additional sheet may be added if necessary to conform with said requirements.

(a) Corner location: Township 36 North

Range 12 East/West

Town/City/Village Crandon


County Forest

Document Number

**169631**

REGISTER'S OFFICE  
Forest County, Wis.

Received for record this 2nd day  
of October A.D., 2000 at  
1:00 o'clock P.M. and recorded  
in Vol Corner Restoration  
page 69

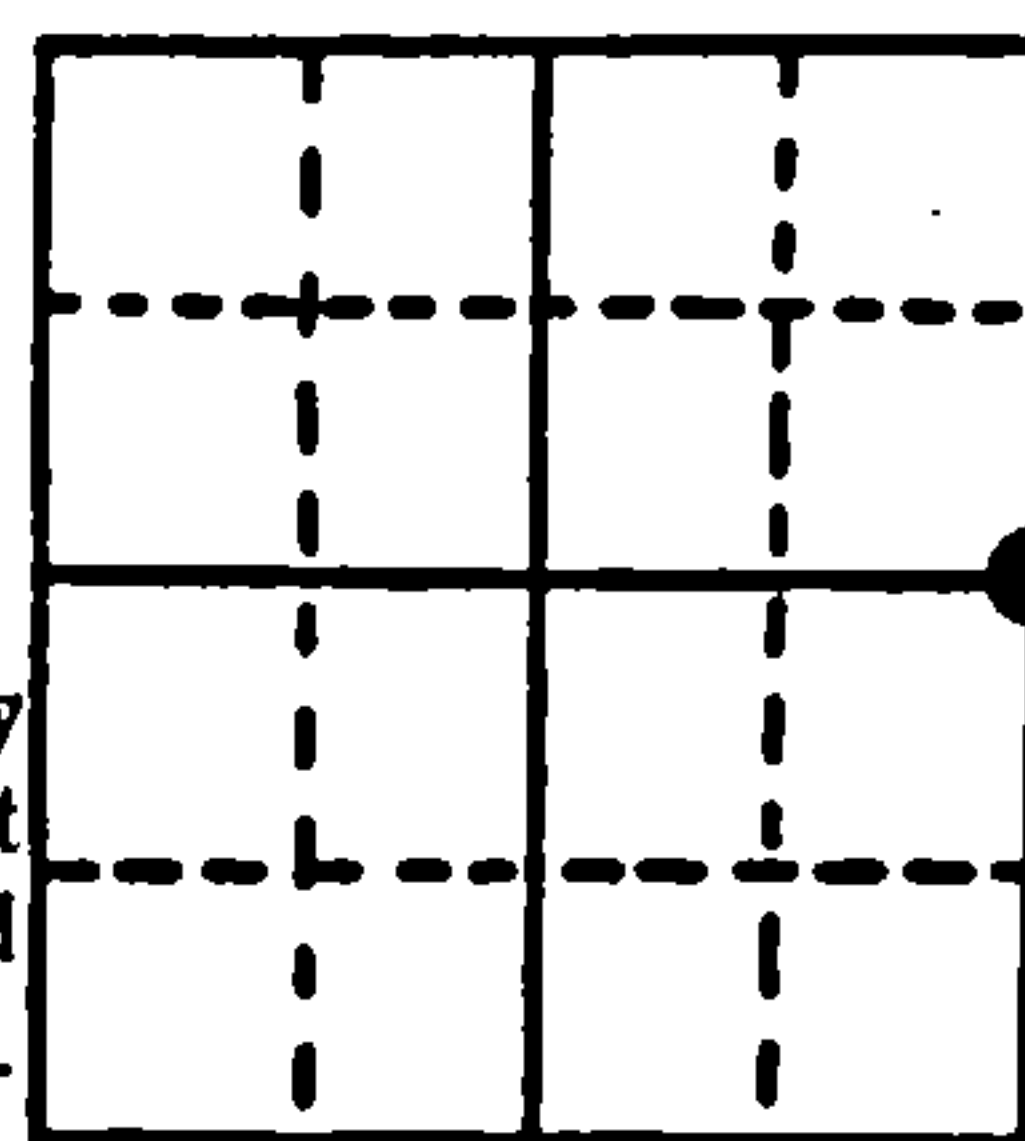

Kay Swanson, Deputy  
Register of Deeds

Section 8


(b) (f) (g) (h) Description of monument found at this corner and if it was accepted, state all evidence (material, testimonial, occupational, plats, records, other monuments) used as a basis for accepting. If not accepted or if nothing was found, state evidence used as basis for establishing location. If reestablished through lost corner proportionate methods, indicate all monuments, distances and directions used to establish. Indicate type of monument found or set and sign post.

1859 - Wm. Daugherty 40 ch. set wood post.

Original B.T.'s Tamarack 8" N 62° E 30 lks.  
Tamarack 7" S 31° W 40 lks.

2000 - Found wood post with old ribbon in an area of swampland where we also found evidence of prior searches for corner. This area also matches closely the calls in original Gov't. notes from Daugherty. Replaced post with a Forest County aluminum capped monument stamped to identify corner. Made new B.T.'s and set plastic sign post 1.0' West of corner.

(c) (d) (e) Plan view of corner with ties to at least 4 witness monuments. If in disagreement with previously established corner, show the distances between the two corners and also indicate the ties to the disputed corner.

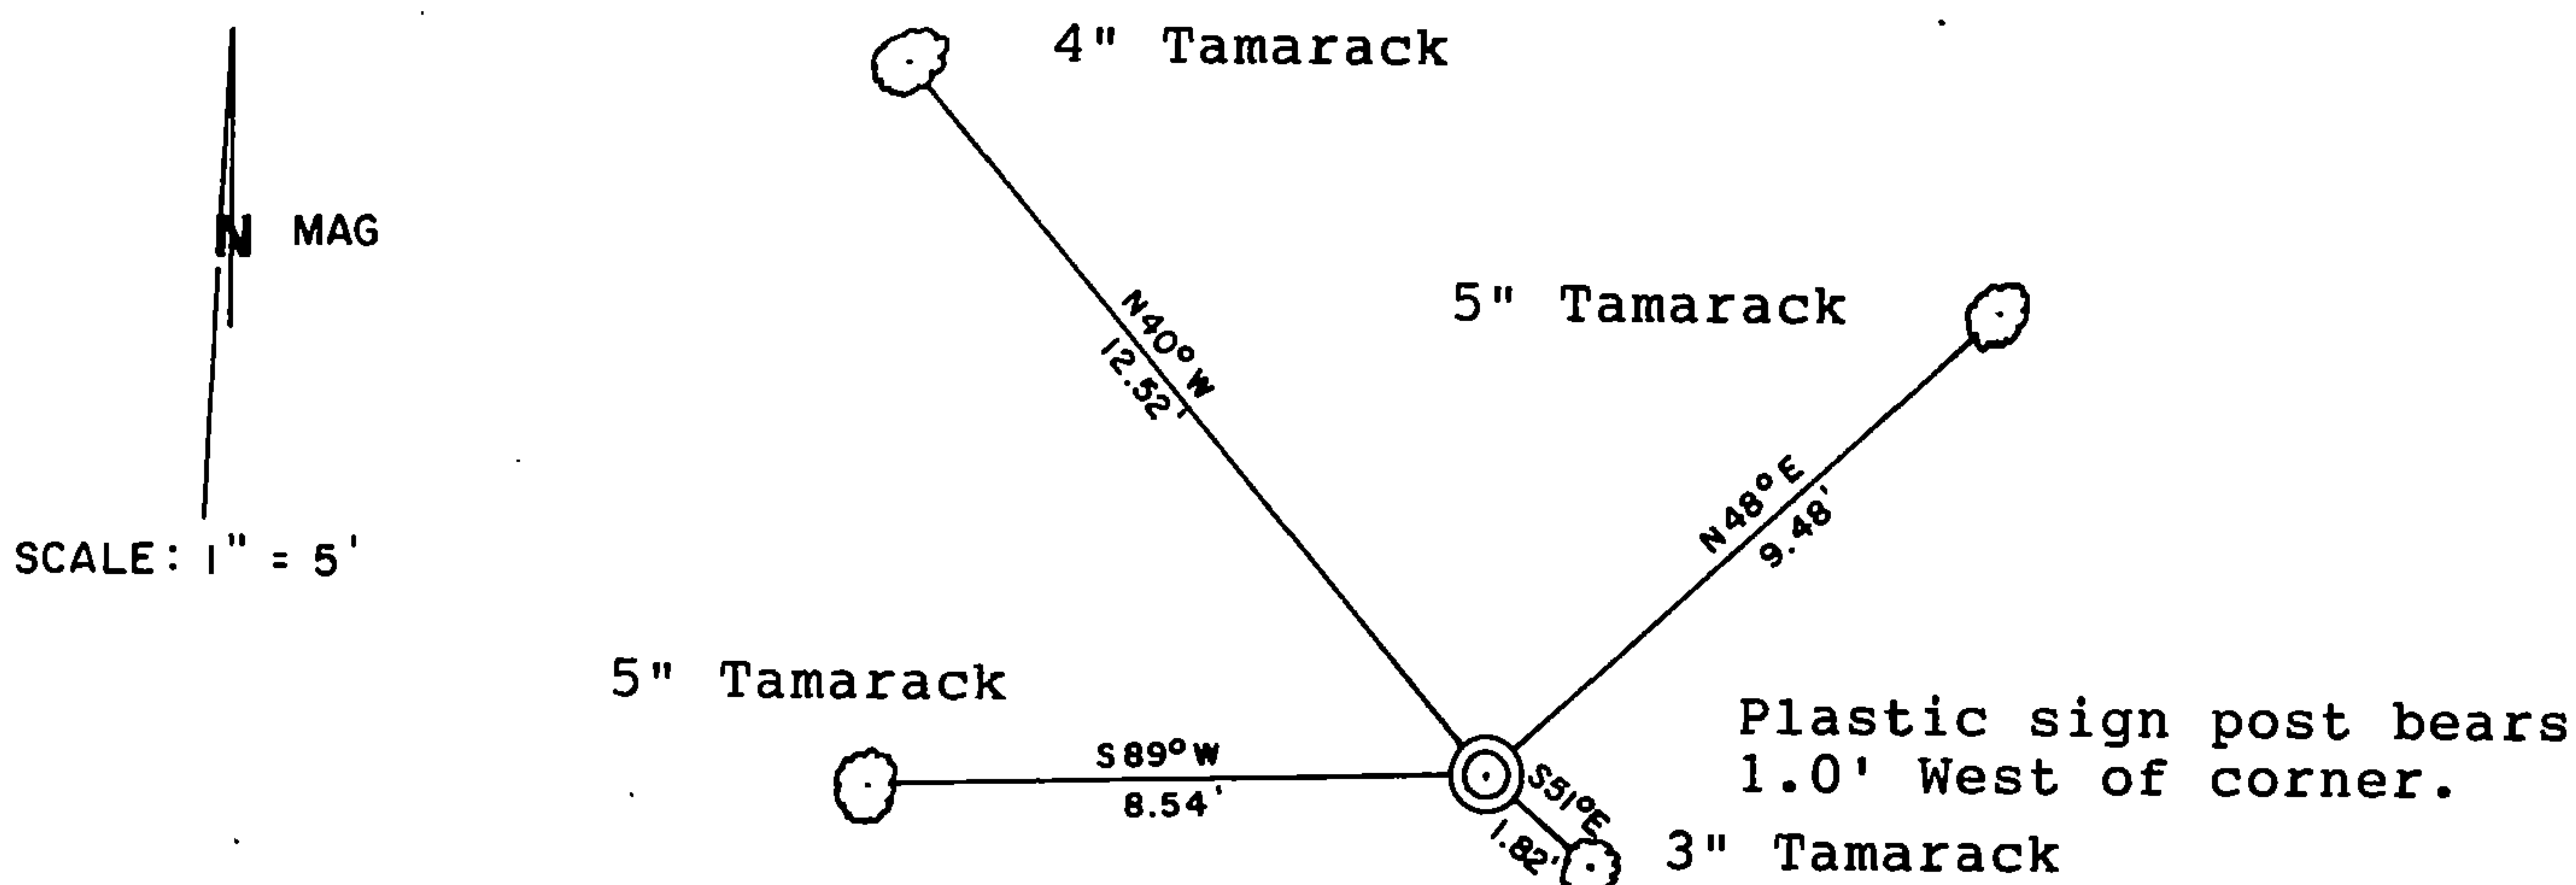

⊙ FOREST CO. ALUMINUM CAPPED MONUMENT.

Note: All measurements taken to nail in side of tree.

(i) I, Kip W. Soder R.L.S. #1731

(type or print name) certify that the corner location on this record was determined by me or under my direction and control and that this U.S. Public Land Survey Monument Record is correct and complete to the best of my knowledge and belief.

Signature

Date



Stamp

Index No. 6-9

43612 08 2000