

CERTIFIED LAND CORNER RESTORATION

Index No. R-9

State of Wisconsin }
County of Forest } ss.

I Milo E. Stefan, do hereby
certify that on the 14th day
of December, 1993, I found
evidence of the Section
corner ~~88~~ to Sections 21, 20, 28 & 29
Township 36, North, Range
12 East, Fourth Principal Meridian,
as described hereon; and that from this evidence
I established a new monument and accessories
as described hereon to perpetuate the original
location of this corner.

Resident witnesses:

Myron Smith

Charles Blomdahl

Ted Golden (Local Resident)

History of original corner establishment: By James L. Nowlan, 8/8/1859, at 80.00 Chains, set post
for Section Corner and two BTs:
24" Hemlock, N40°E, 18 Lks
6" Sugar, S18°W, 10 Lks

Description of corner evidence found:

May 2, 1921 - I.R. Ritter's "Record of Survey" as filed with the Forest County Register
of Deeds indicates he found evidence of this corner and made two new BTs:
12" Sugar, N80°W, 25 Lks 12" Hemlock, S75°E, 28 Lks

12/14/1993 - Milo E. Stefan and crew found scribed Cedar Post and three iron pipes in
mound of stone - also pointed out to us by local resident that this was the Section
Corner.

Description of monument and accessories I established to perpetuate the original location of this corner.

We replaced iron pipes with a 2" x 48" aluminum monument in mound of stone and made four
new BTs as follows:

- 8" Sugar Maple, N80°E, 17.06 Feet
- 4" Sugar Maple, S15°E, 70.51 Feet
- 6" Sugar Maple, S72°W, 52.79 Feet
- 6" Sugar Maple, N33°E, 45.65 Feet



Dated at Rhinelander, Wis., this 30th day of December, 1993.

Signature Milo E. Stefan Title Registered Land Surveyor Registration No. 1558
(County Surveyor, Registered Land Surveyor, or other duly authorized official)


Office of Register of Deeds, County of FOREST, I hereby certify that the within
instrument was filed in this office for record on the 7th day of FEBRUARY, 1994
at 1:30 o'clock P. M.

Paul Achenbrenner
(Register of Deeds)

By Deputy

FORM 985 H. C. MILLER CO., MILWAUKEE

DOCUMENT NUMBER
A49578

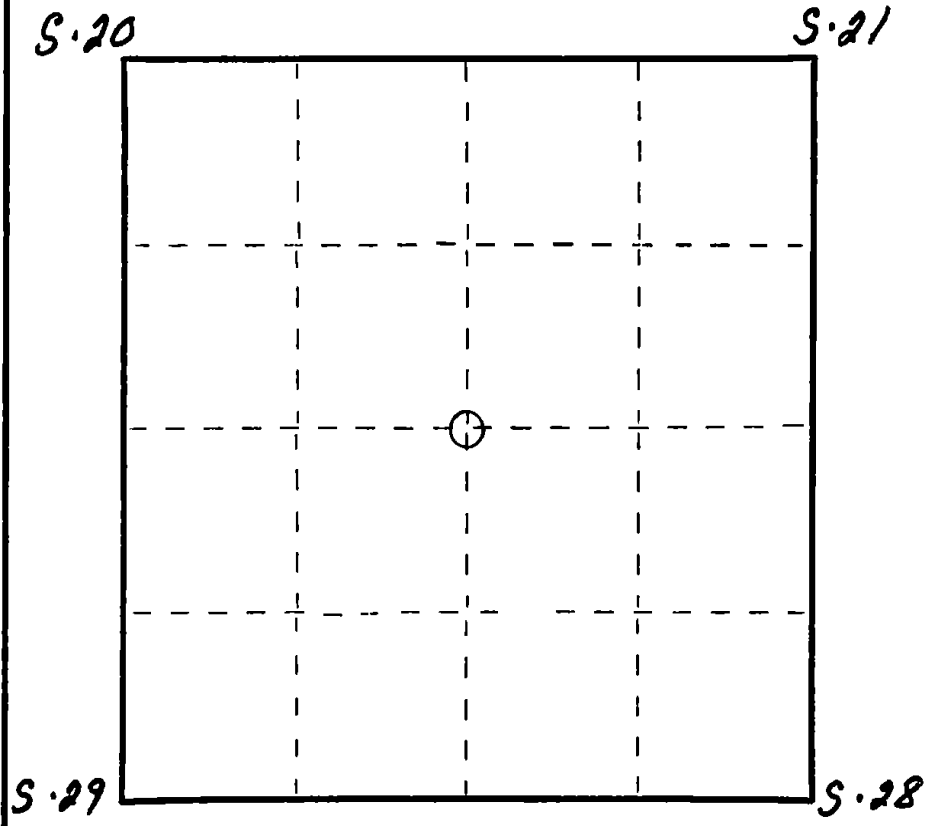

○ = Corner monument restored.

43612 20 0000

c) Describe any material discrepancy between the location of the corner as restored or reestablished and the location of that corner as previously restored or reestablished by distance and direction. Show the discrepancy on the plan view drawing under (d), above. Show the distances between the corner as previously restored or reestablished and (1) the corner as restored or reestablished, and (2) to at least 2 of the witness monuments shown on the drawing in (d), above.

N/A

(f) Was the corner restored through acceptance of (1) an obliterated evidence location, or, (2) a found perpetuated location?

(2) a found perpetuated location

(g&h) Was the corner reestablished through lost corner proportionate methods? If so, show the method, including the directions and distances to other public land survey corners used as evidence or used for proportioning in determining the corner location?

N/A

(i) I, Milo E. Stefan
(type or print name) certify that the corner location shown on this record was determined by me or under my direction and control and that this U.S. Public Land Survey Monument Record is correct and complete to the best of my knowledge and belief.



Milo E. Stefan
Signature

12/30/93
Date