

CERTIFIED LAND CORNER RESTORATION

Index No. P-9

State of Wisconsin }  
County of Forest } ss.

History of original corner establishment: By James L. Nowlan, 8/8/1859 at 40.00 chains set  
1/4 Section Post/two BTs:  
8" Cedar, N41°W, 11 Lks  
8" Cedar, S71°E, 10 Lks

I Milo E. Stefan, do hereby certify that on the 14th day of December, 1993, I found evidence of the 1/4 corner of Sections 20 & 21 Township 36, North, Range 12 East, Fourth Principal Meridian, as described hereon; and that from this evidence I established a new monument and accessories as described hereon to perpetuate the original location of this corner.

Resident witnesses:

Myron Smith

Charles Blomdahl

Description of corner evidence found:


May 2, 1921 - I.R. Ritter's "Record of Survey" as filed with the Forest County Register of Deeds indicates he found evidence of this corner and restored it. As this corner fell in the road a reference post was set North and South, 38 Links from the corner.

12/14/1993 - We found corner position marked with a railroad spike in surface of road and a 1" iron pipe North, 29.9'.

Description of monument and accessories I established to perpetuate the original location of this corner.

We placed a 1" x 24" aluminum monument as a Reference Monument North, 33.00' of railroad spike with four new BTs as follows:

- 5" Sugar Maple, N14°E, 40.90 Feet
- 8" Sugar Maple, S23°E, 80.60 Feet
- 8" Sugar Maple, S34°W, 71.62 Feet
- 6" Red Oak, N22°W, 45.55 Feet

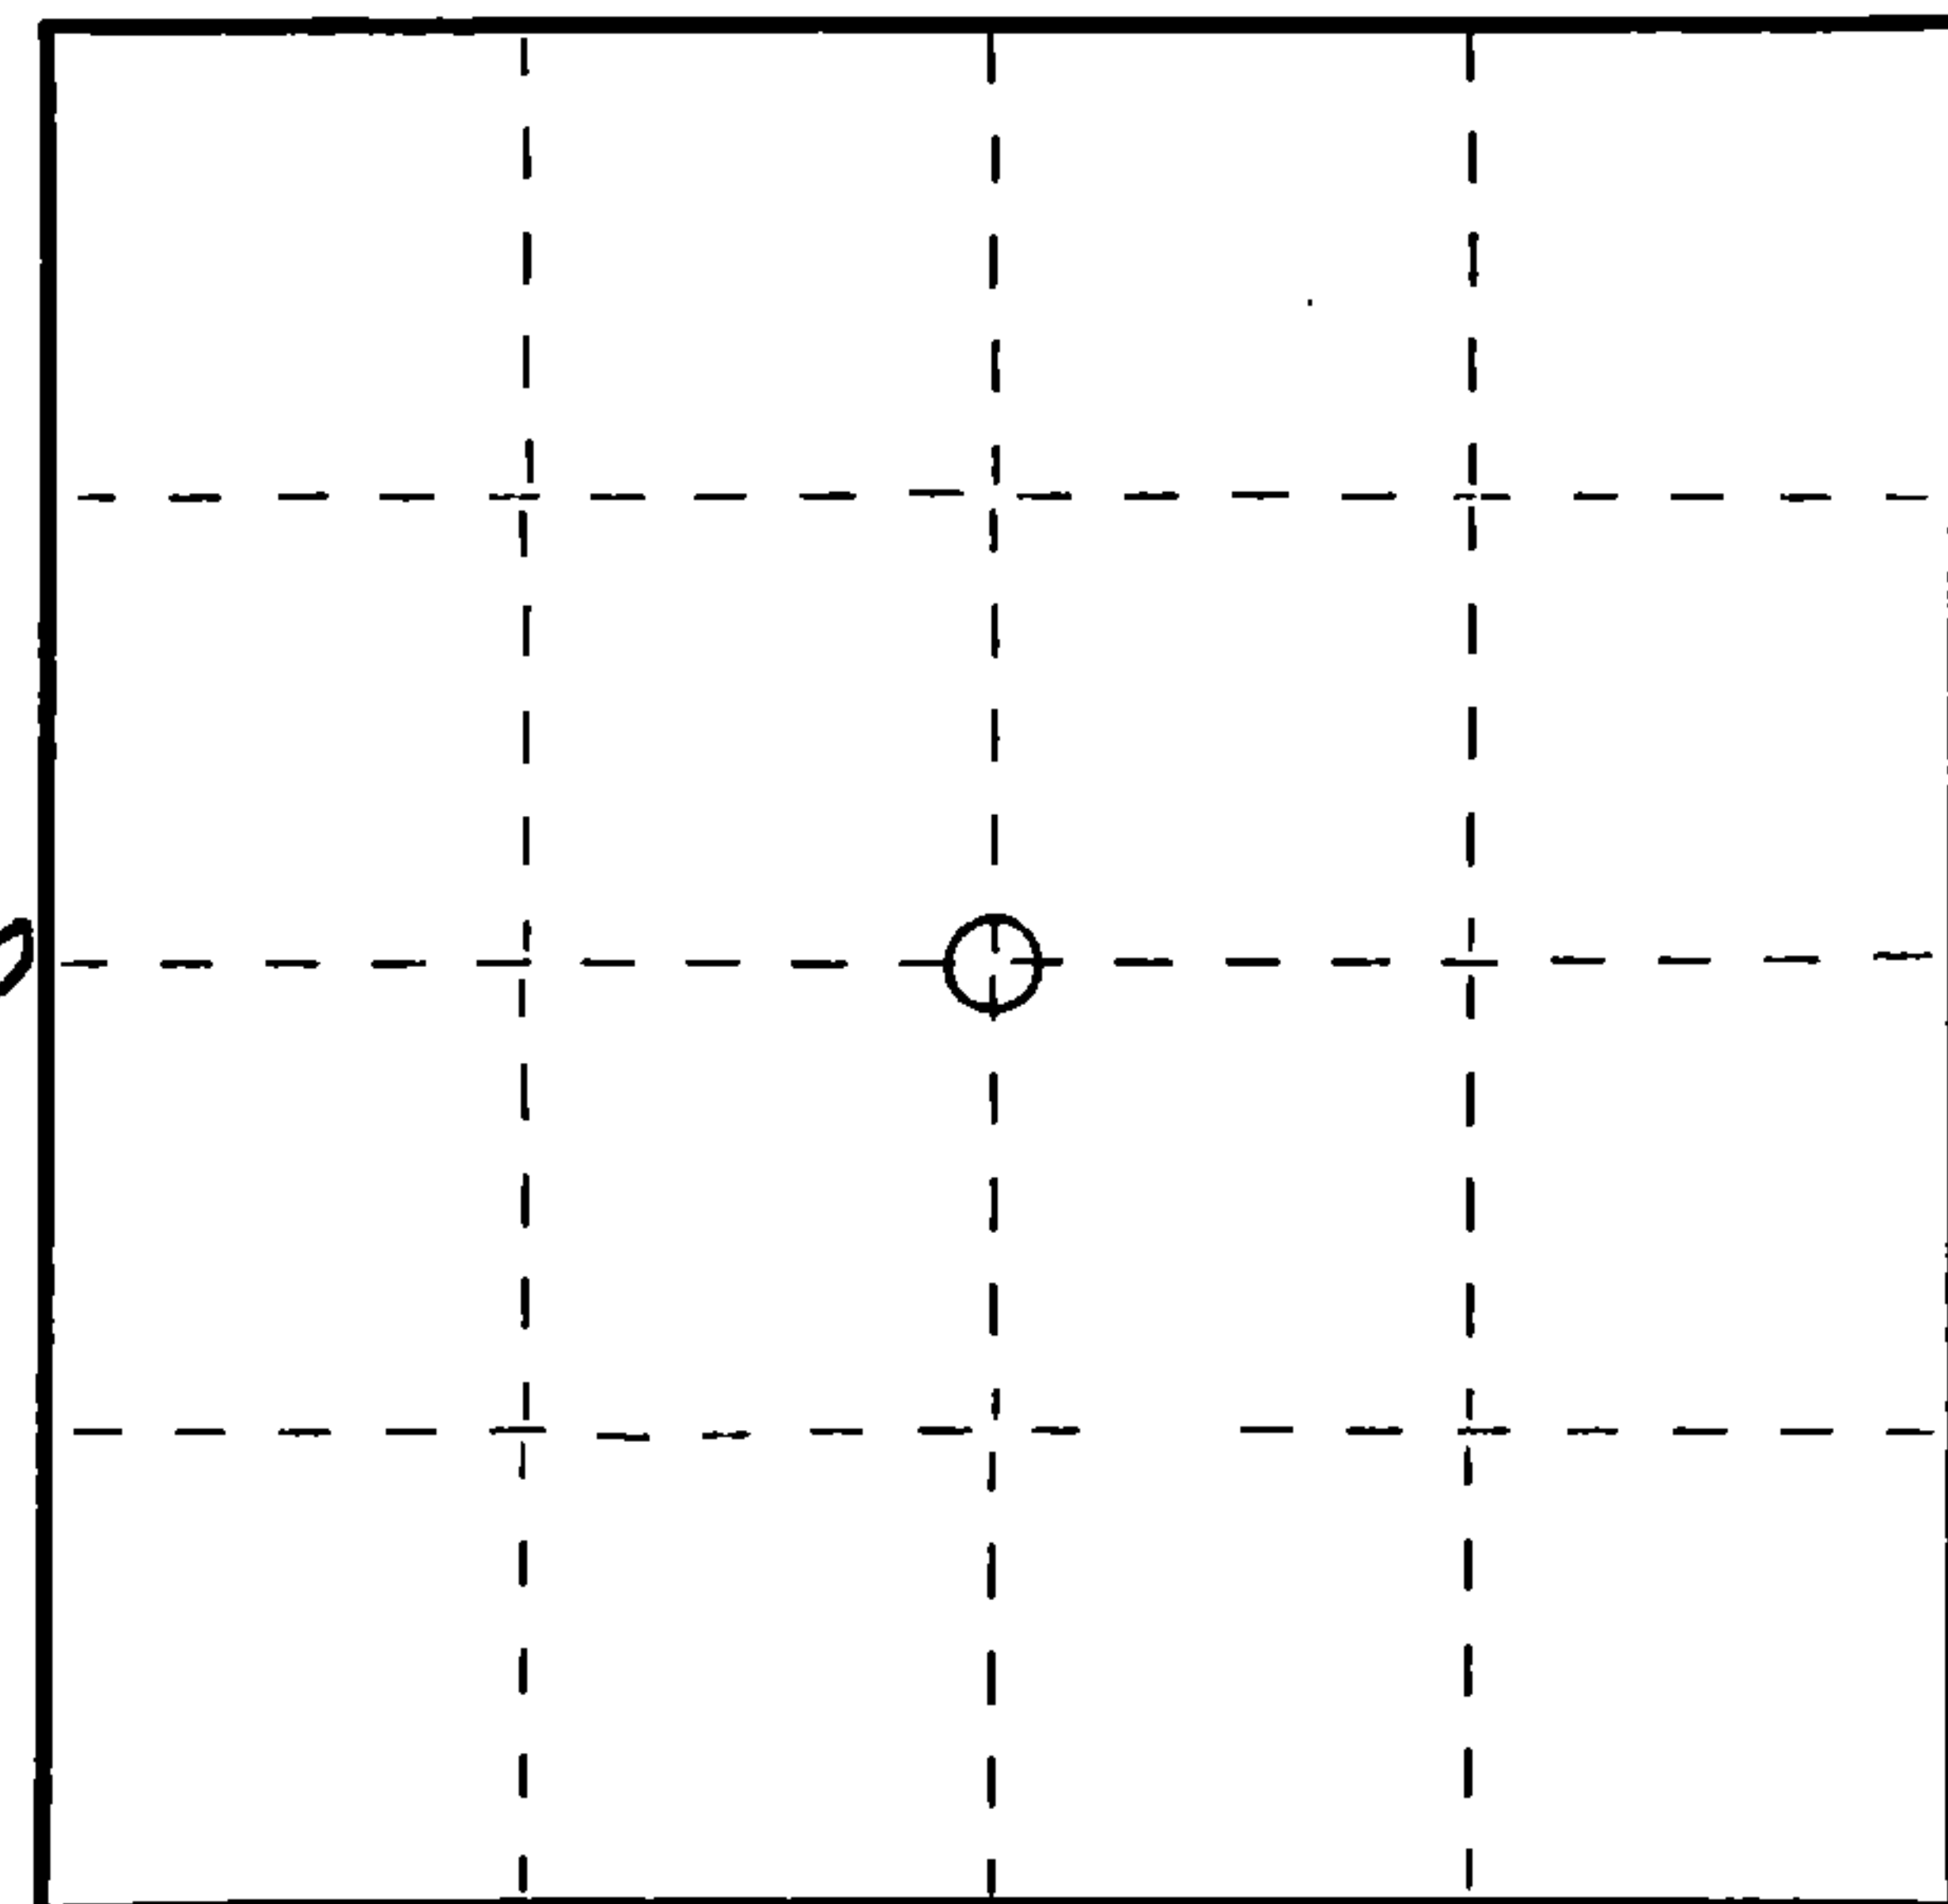

○ = Corner monument restored.

Dated at Rhinelander, Wis., this 30th day of December, 1993

Signature: *Milo E. Stefan* Title: Registered Land Surveyor Registration No. 1558  
(County Surveyor, Registered Land Surveyor, or other duly authorized official)

Office of Register of Deeds, County of FOREST, I hereby certify that the within instrument was filed in this office for record on the 7th day of FEBRUARY, 1994 at 1:30 o'clock P. M.

*Paul Hochstetler*  
(Register of Deeds)

By \_\_\_\_\_ Deputy

DOCUMENT NUMBER 149575

FORM 985 N. C. MILLER CO., MILWAUKEE

43612202000

e) Describe any material discrepancy between the location of the corner as restored or reestablished and the location of that corner as previously restored or reestablished by distance and direction. Show the discrepancy on the plan view drawing under (d), above. Show the distances between the corner as previously restored or reestablished and (1) the corner as restored or reestablished, and (2) to at least 2 of the witness monuments shown on the drawing in (d), above.

N/A

(f) Was the corner restored through acceptance of (1) an obliterated evidence location, or, (2) a found perpetuated location?

(2) a found perpetuated location

(g&h) Was the corner reestablished through lost corner proportionate methods? If so, show the method, including the directions and distances to other public land survey corners used as evidence or used for proportioning in determining the corner location?

N/A

Affix Land Surveyor Seal



(i) I, Milo E. Stefan  
(type or print name) certify that the corner location shown on this record was determined by me or under my direction and control and that this U.S. Public Land Survey Monument Record is correct and complete to the best of my knowledge and belief.

Milo E. Stefan  
Signature

12/30/93  
Date