


CERTIFIED LAND CORNER RESTORATION

Index No. **R21**

State of Wisconsin }  
County of Forest } ss.

I Thomas R. Arnott, do hereby certify that on the 20th day of June, 1978, I found evidence of the section corner of sec. 23, 24, 25, 26 Township 36, North, Range 12 E, Fourth Principal Meridian, as described hereon; and that from this evidence I established a new monument and accessories as described hereon to perpetuate the original location of this corner.

Resident witnesses:

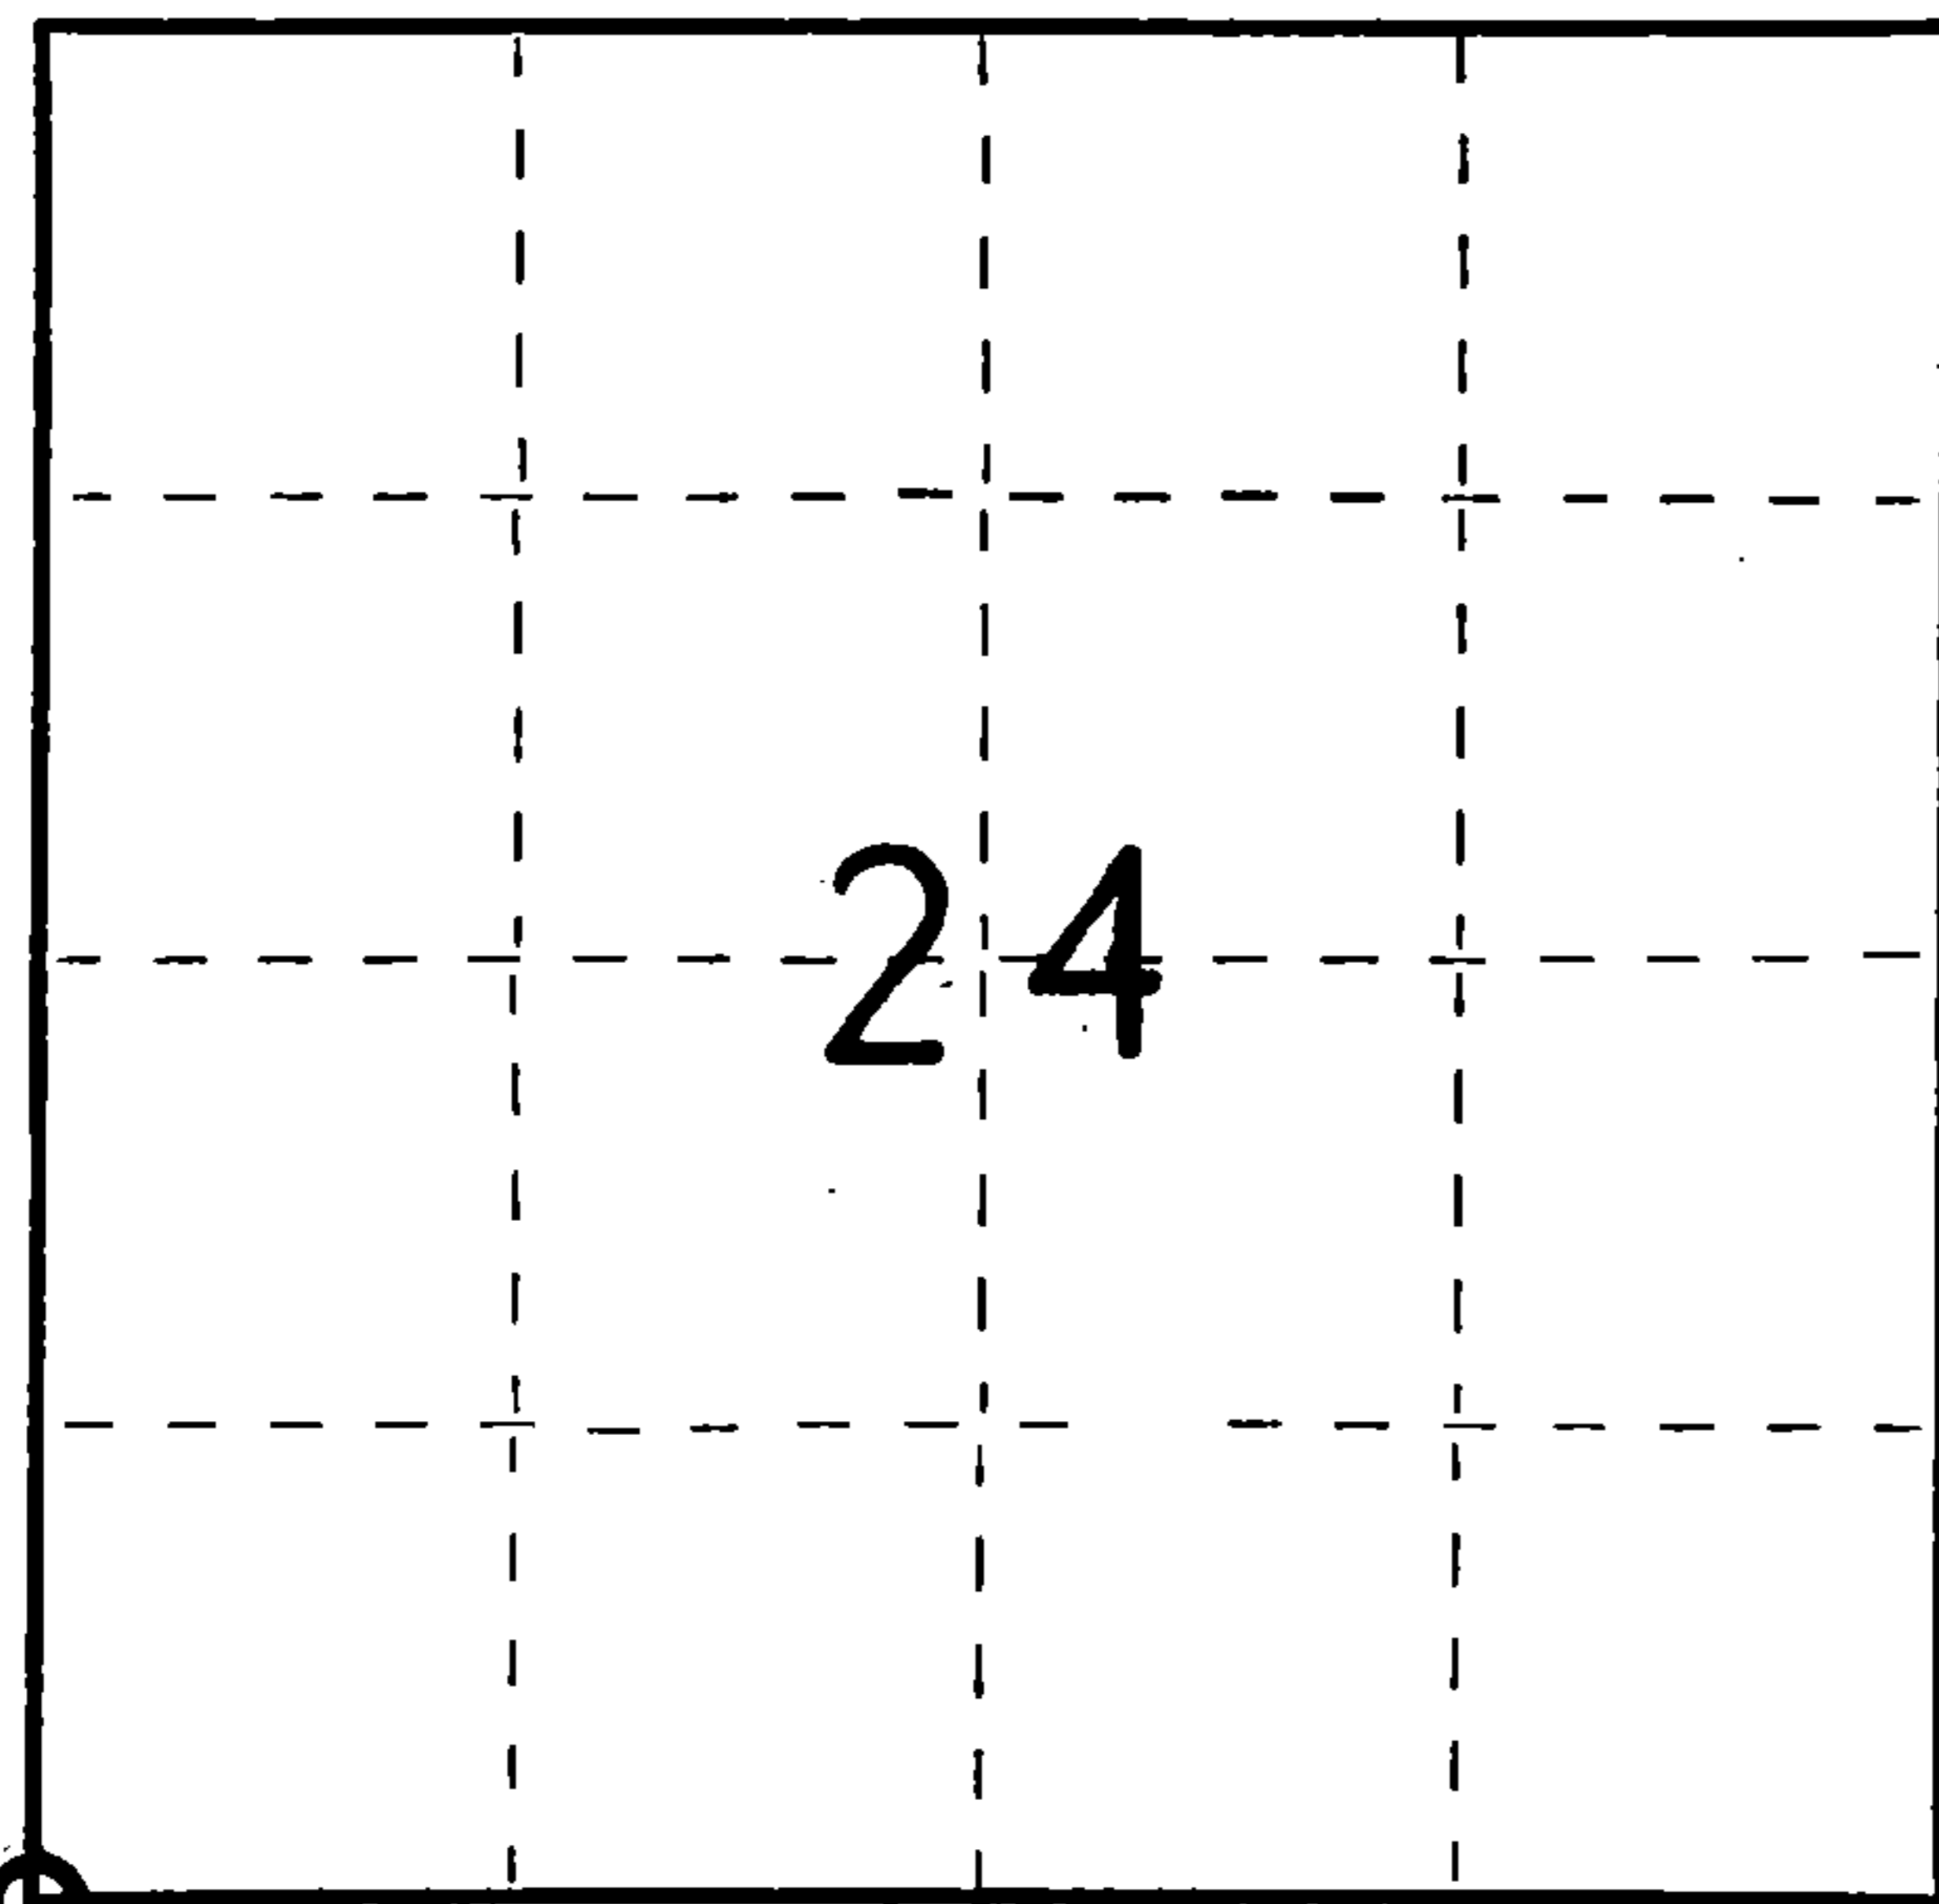

○ = Corner monument restored.

History of original corner establishment:

Original subdivision by William Daugherty 4 Aug. - 9 Aug. 1859

Fir 6 N58W 21 Lks.  
Hemlock 8 S16E 15 Lks.

Description of corner evidence found:

Remonumented by Ritter 21 June - 28 June, 1921


Birch 24 S35E 158 Lks (found)  
Hemlock 8 S70W 139 Lks

Description of monument and accessories I established to perpetuate the original location of this corner.

Set 1 1/4 " iron pipe from birch stump found

Ties:

Forest County Aluminum Monument S4E 19.42 feet  
Maple 8 N50E 39.27 feet

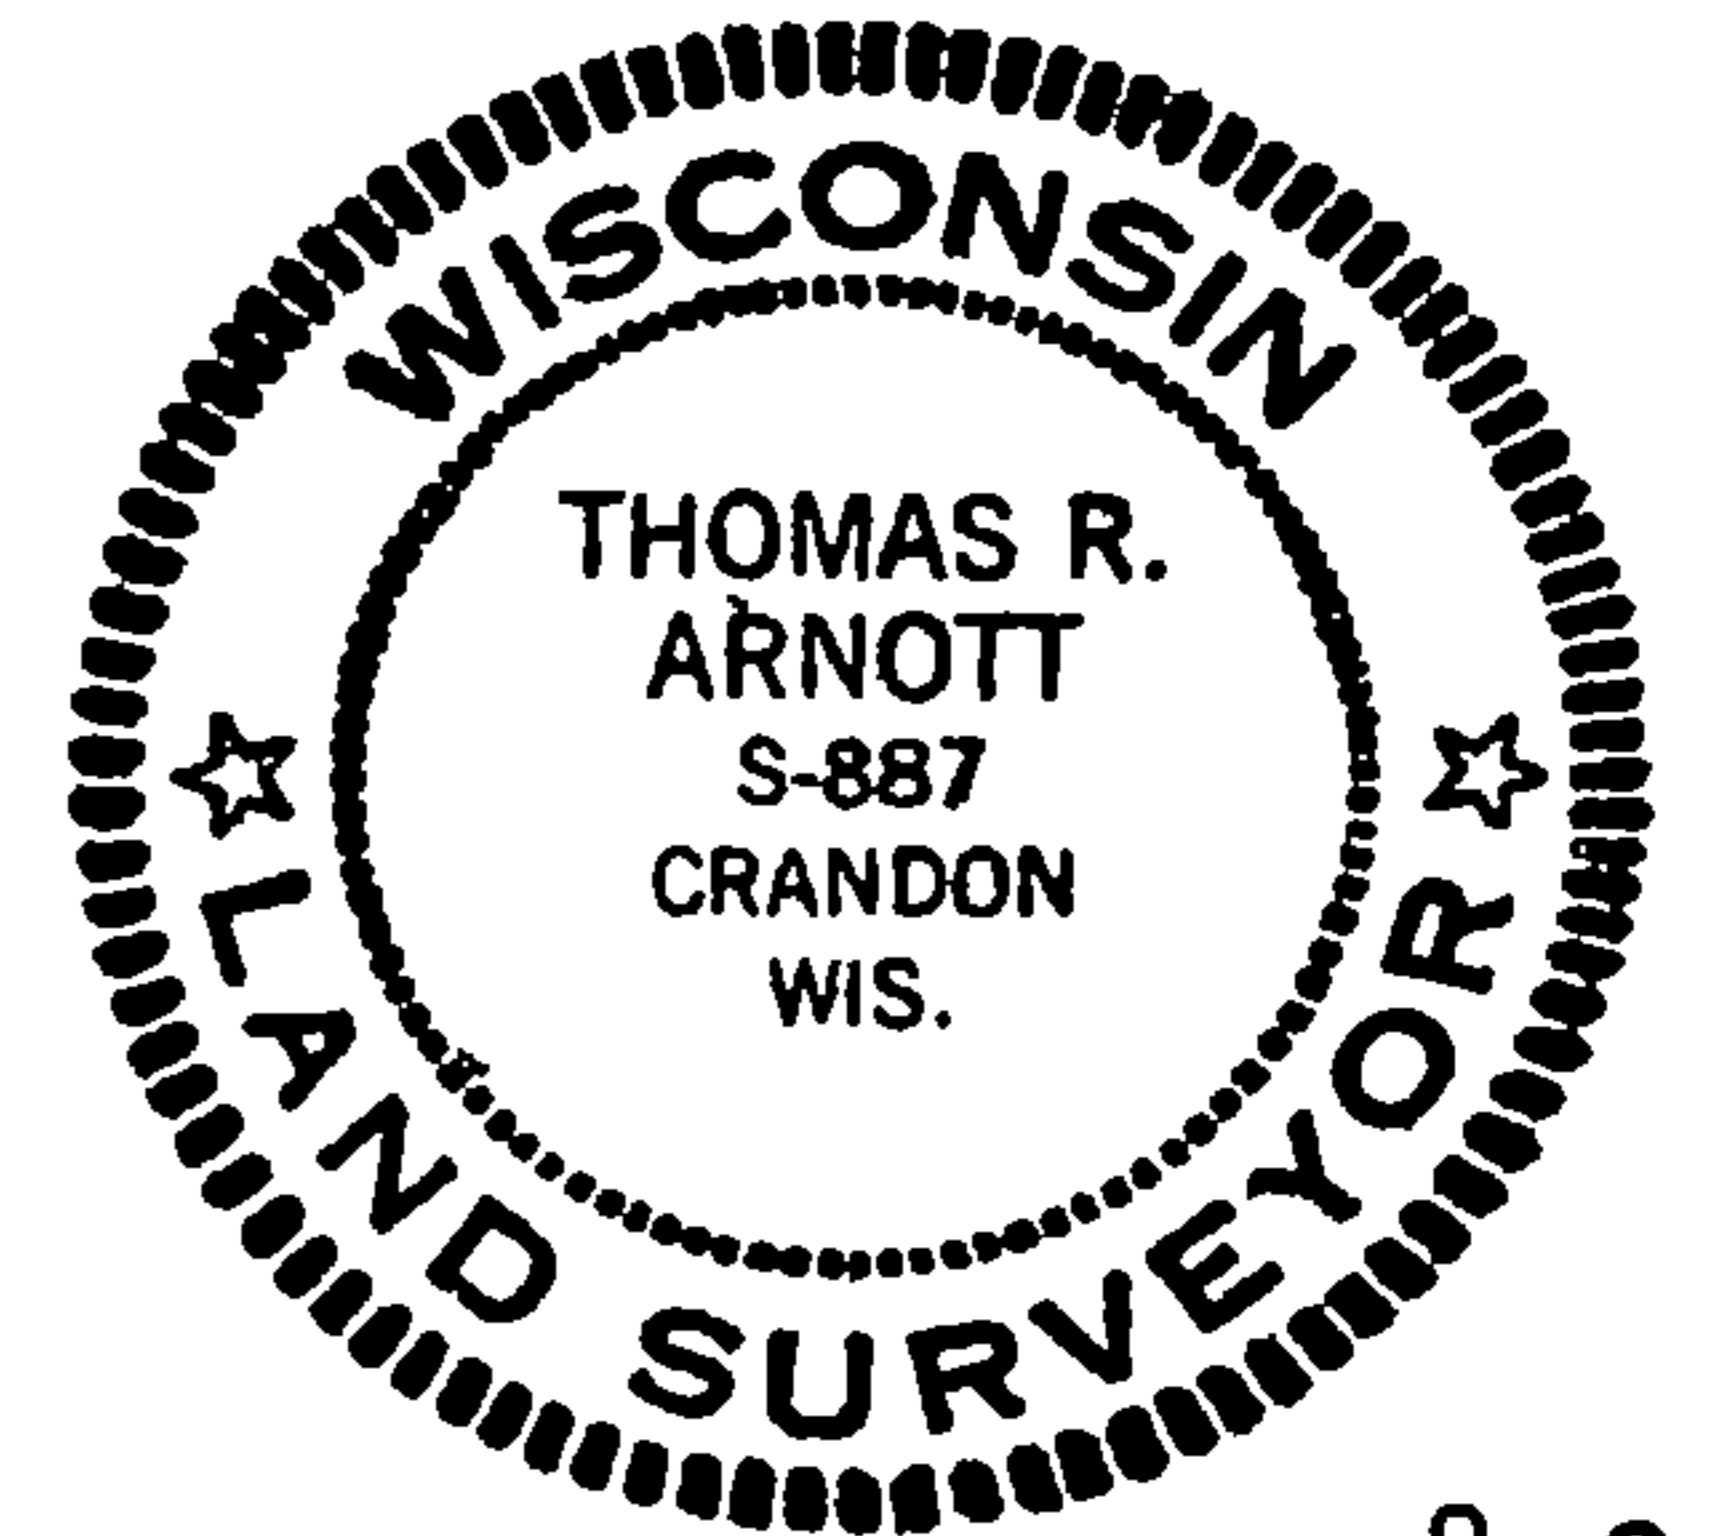

Dated at Crandon, Wis., this 28th day of January, 1980

Signature Thomas R. Arnott Title Surveyor Registration No. S-887  
(County Surveyor, Registered Land Surveyor, or other duly authorized official)

Office of Register of Deeds, County of Forest, I hereby certify that the within instrument was filed in this office for record on the 29th day of January, 1980 at 10:30 o'clock A. M.

Eugene Stutzny Document Number **117462**  
(Register of Deeds)

By..... Deputy

FORM 985 M. C. MILLER CO., MILWAUKEE

43612230000