

CERTIFIED LAND CORNER RESTORATION

Index No. V-16

State of Wisconsin }
County of Forest } ss.


I Philip T. Hansen, do hereby certify that on the 3rd day of August, 1977, I found evidence of the E 1/16 corner of Section 27 & 34 Township 36, North, Range 12 East, Fourth Principal Meridian, as described hereon; and that from this evidence I established a new monument and accessories as described hereon to perpetuate the original location of this corner.

Resident witnesses:


Glen Barker

Jim Claflin

Herb Wagoner

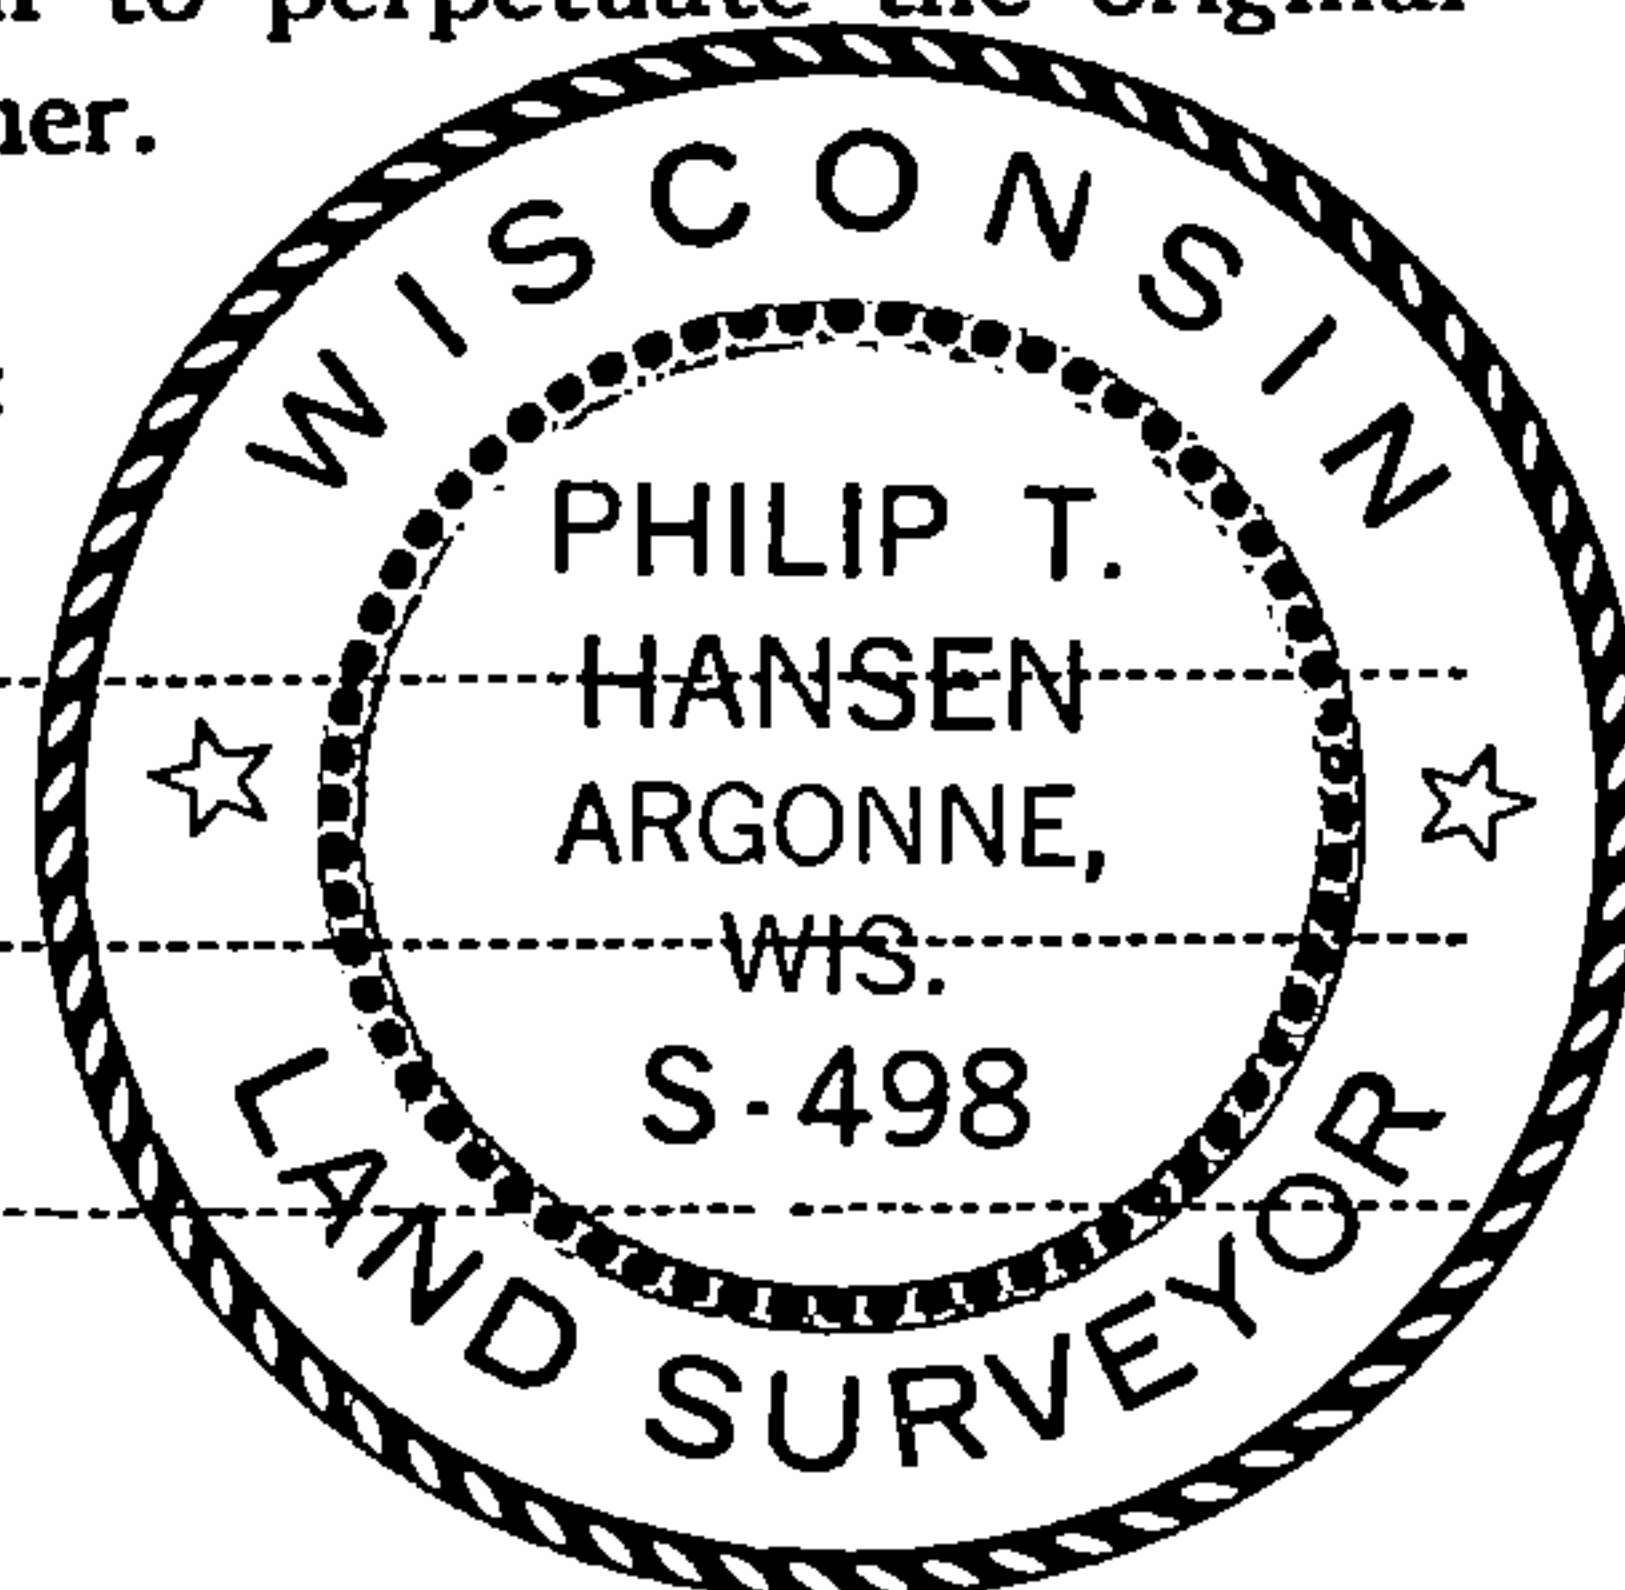

FORM 985 H. C. MILLER CO., MILWAUKEE

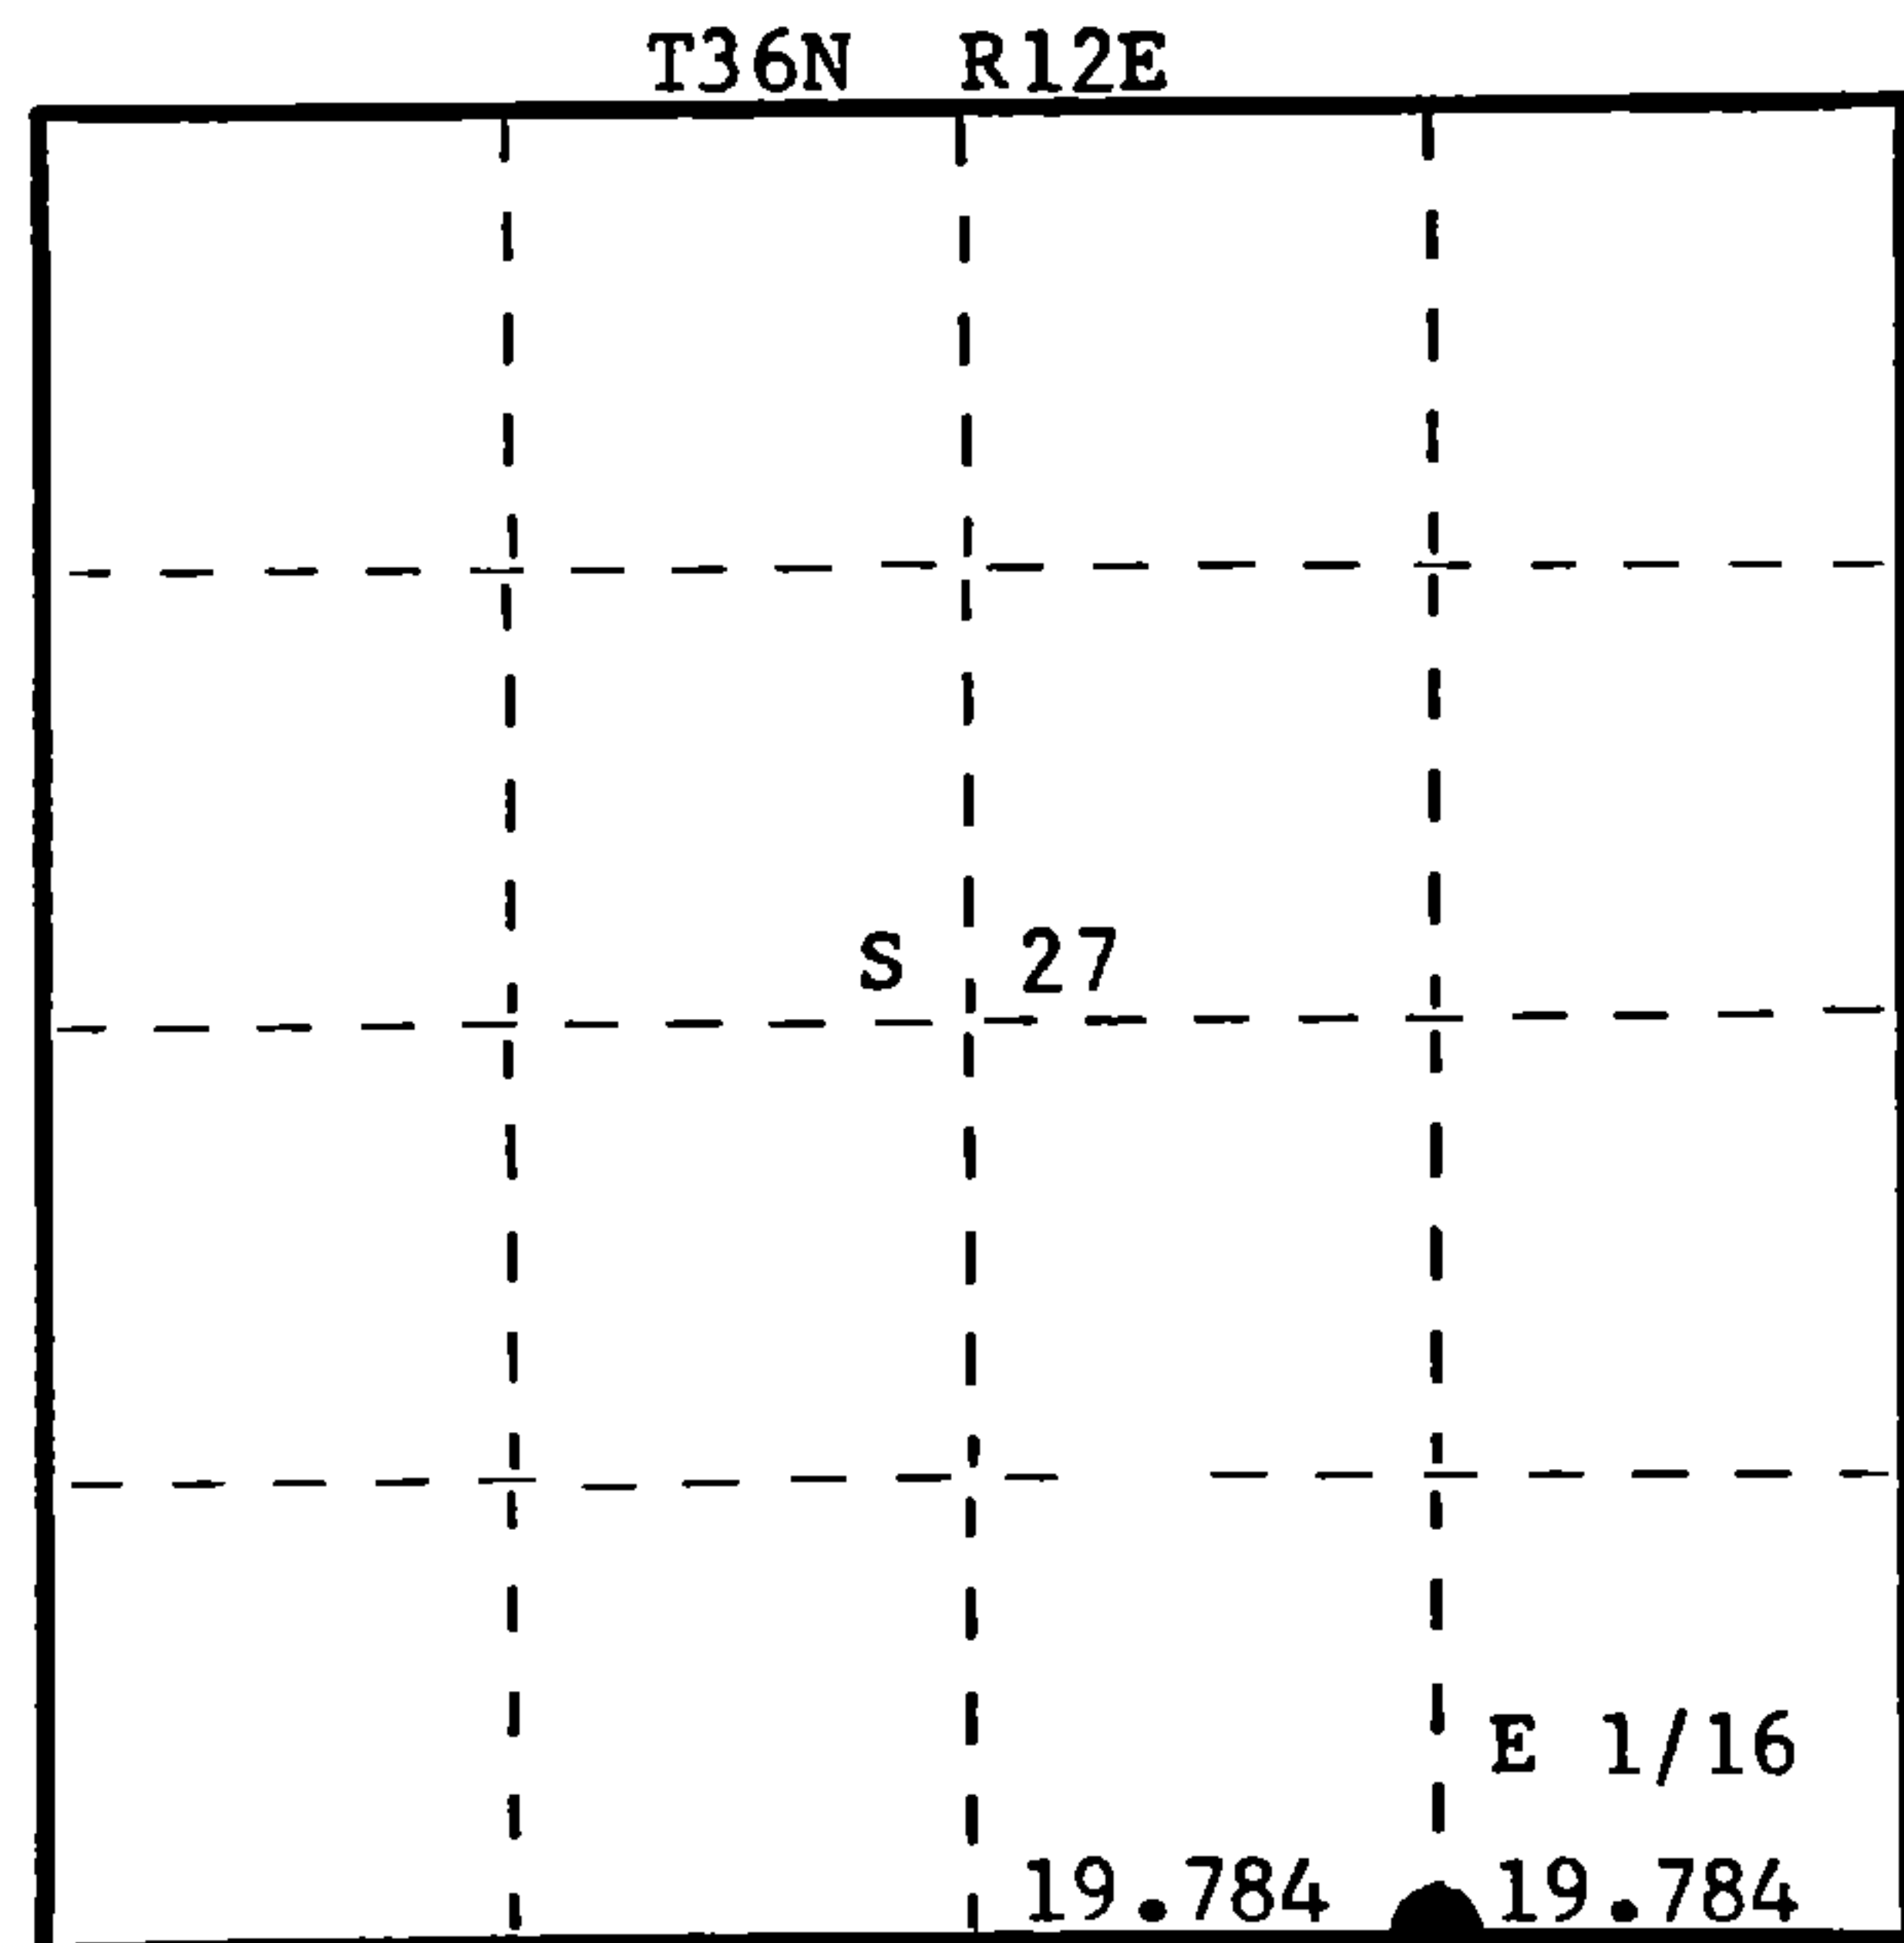

○ = Corner monument restored.

History of original corner establishment:
No records on any previous survey.

Description of corner evidence found:

Recovered 1 1/2" gear shaft buried 4" below the surface of old road at intersection of north-south and east-west roads.

Description of monument and accessories I established to perpetuate the original location of this corner.

Left the old gear shaft in place as recovered.
Set a 1 1/2" iron pipe with 2" brass cap 60 links south for witness corner.
Monument projects 24" above ground. Cap stamped:
Marked NBTs - Maple 7" N22°W, 98.7 links, scribed 1/16 BT.
Sugar 8" N64°W, 116 links, scribed 1/16 BT.

S498
T36N R12E
S 27
S 34
N 60 lks
CPI - 1977

Dated at Rhineland, Wis., this 9th day of August, 1977

Signature Philip T. Hansen Title Registered Land Surveyor Registration No. S-498
(County Surveyor, Registered Land Surveyor, or other duly authorized official)

Office of Register of Deeds, County of Forest, I hereby certify that the within instrument was filed in this office for record on the 22nd day of AUGUST, 1977 at 3:30 o'clock P. M.

Eugene Stutzman
(Register of Deeds)
By _____ Deputy

DOCUMENT NUMBER **112157**

43612270010