

CERTIFIED LAND CORNER RESTORATION

Index No. V-15

State of Wisconsin }  
County of Forest } ss.


I Philip T. Hansen, do hereby certify that on the 3rd day of August, 1977, I found evidence of the Quarter corner of Section 27 & 34 Township 36, North, Range 12 East, Fourth Principal Meridian, as described hereon; and that from this evidence I established a new monument and accessories as described hereon to perpetuate the original location of this corner.

Resident witnesses:


Glen Barker

Jim Claflin

Herb Wagoner

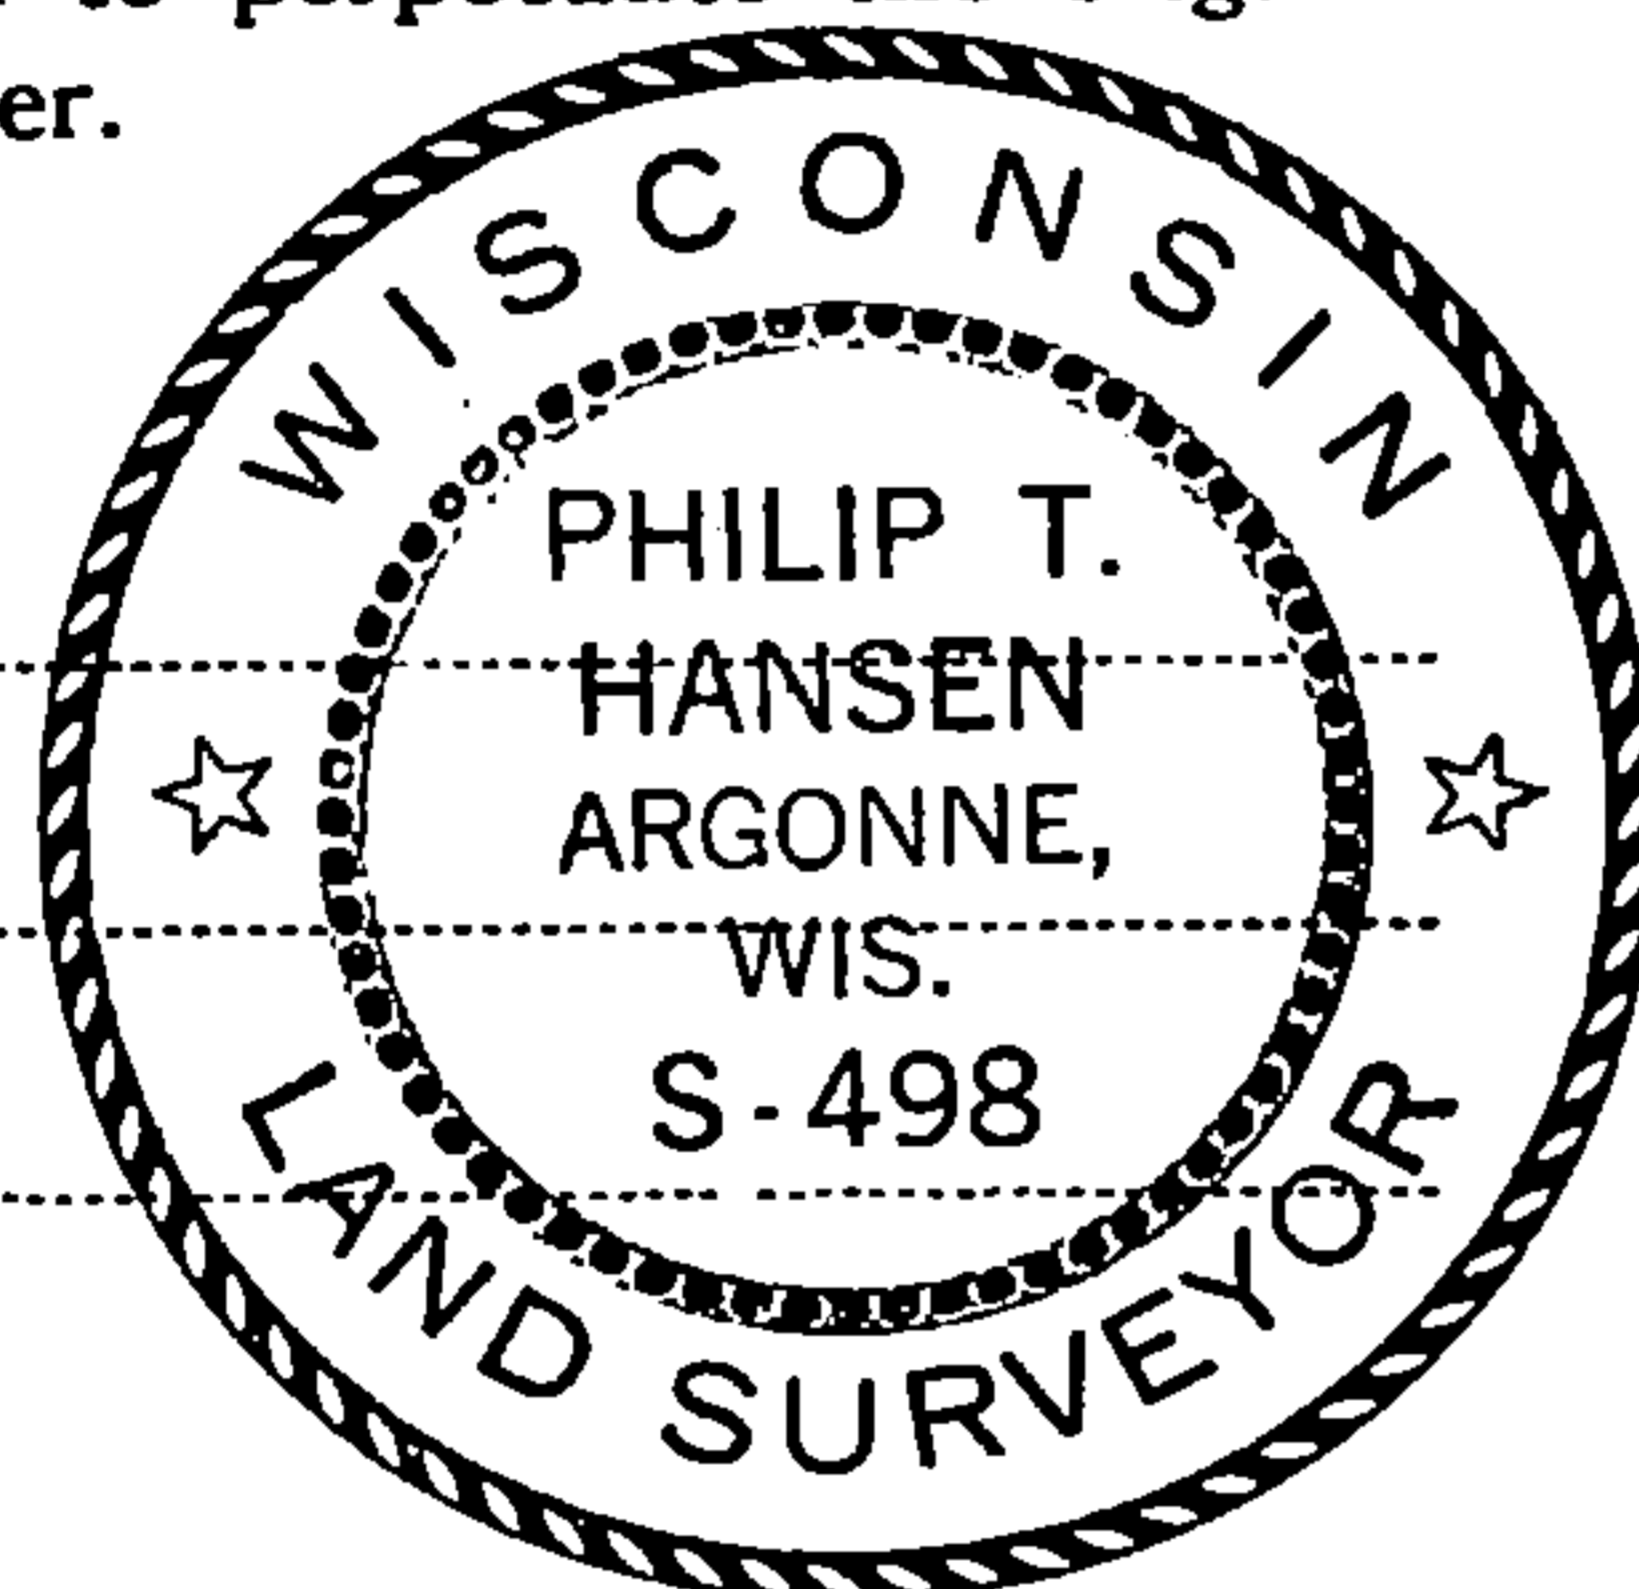

FORM 985 H. C. MILLER CO., MILWAUKEE

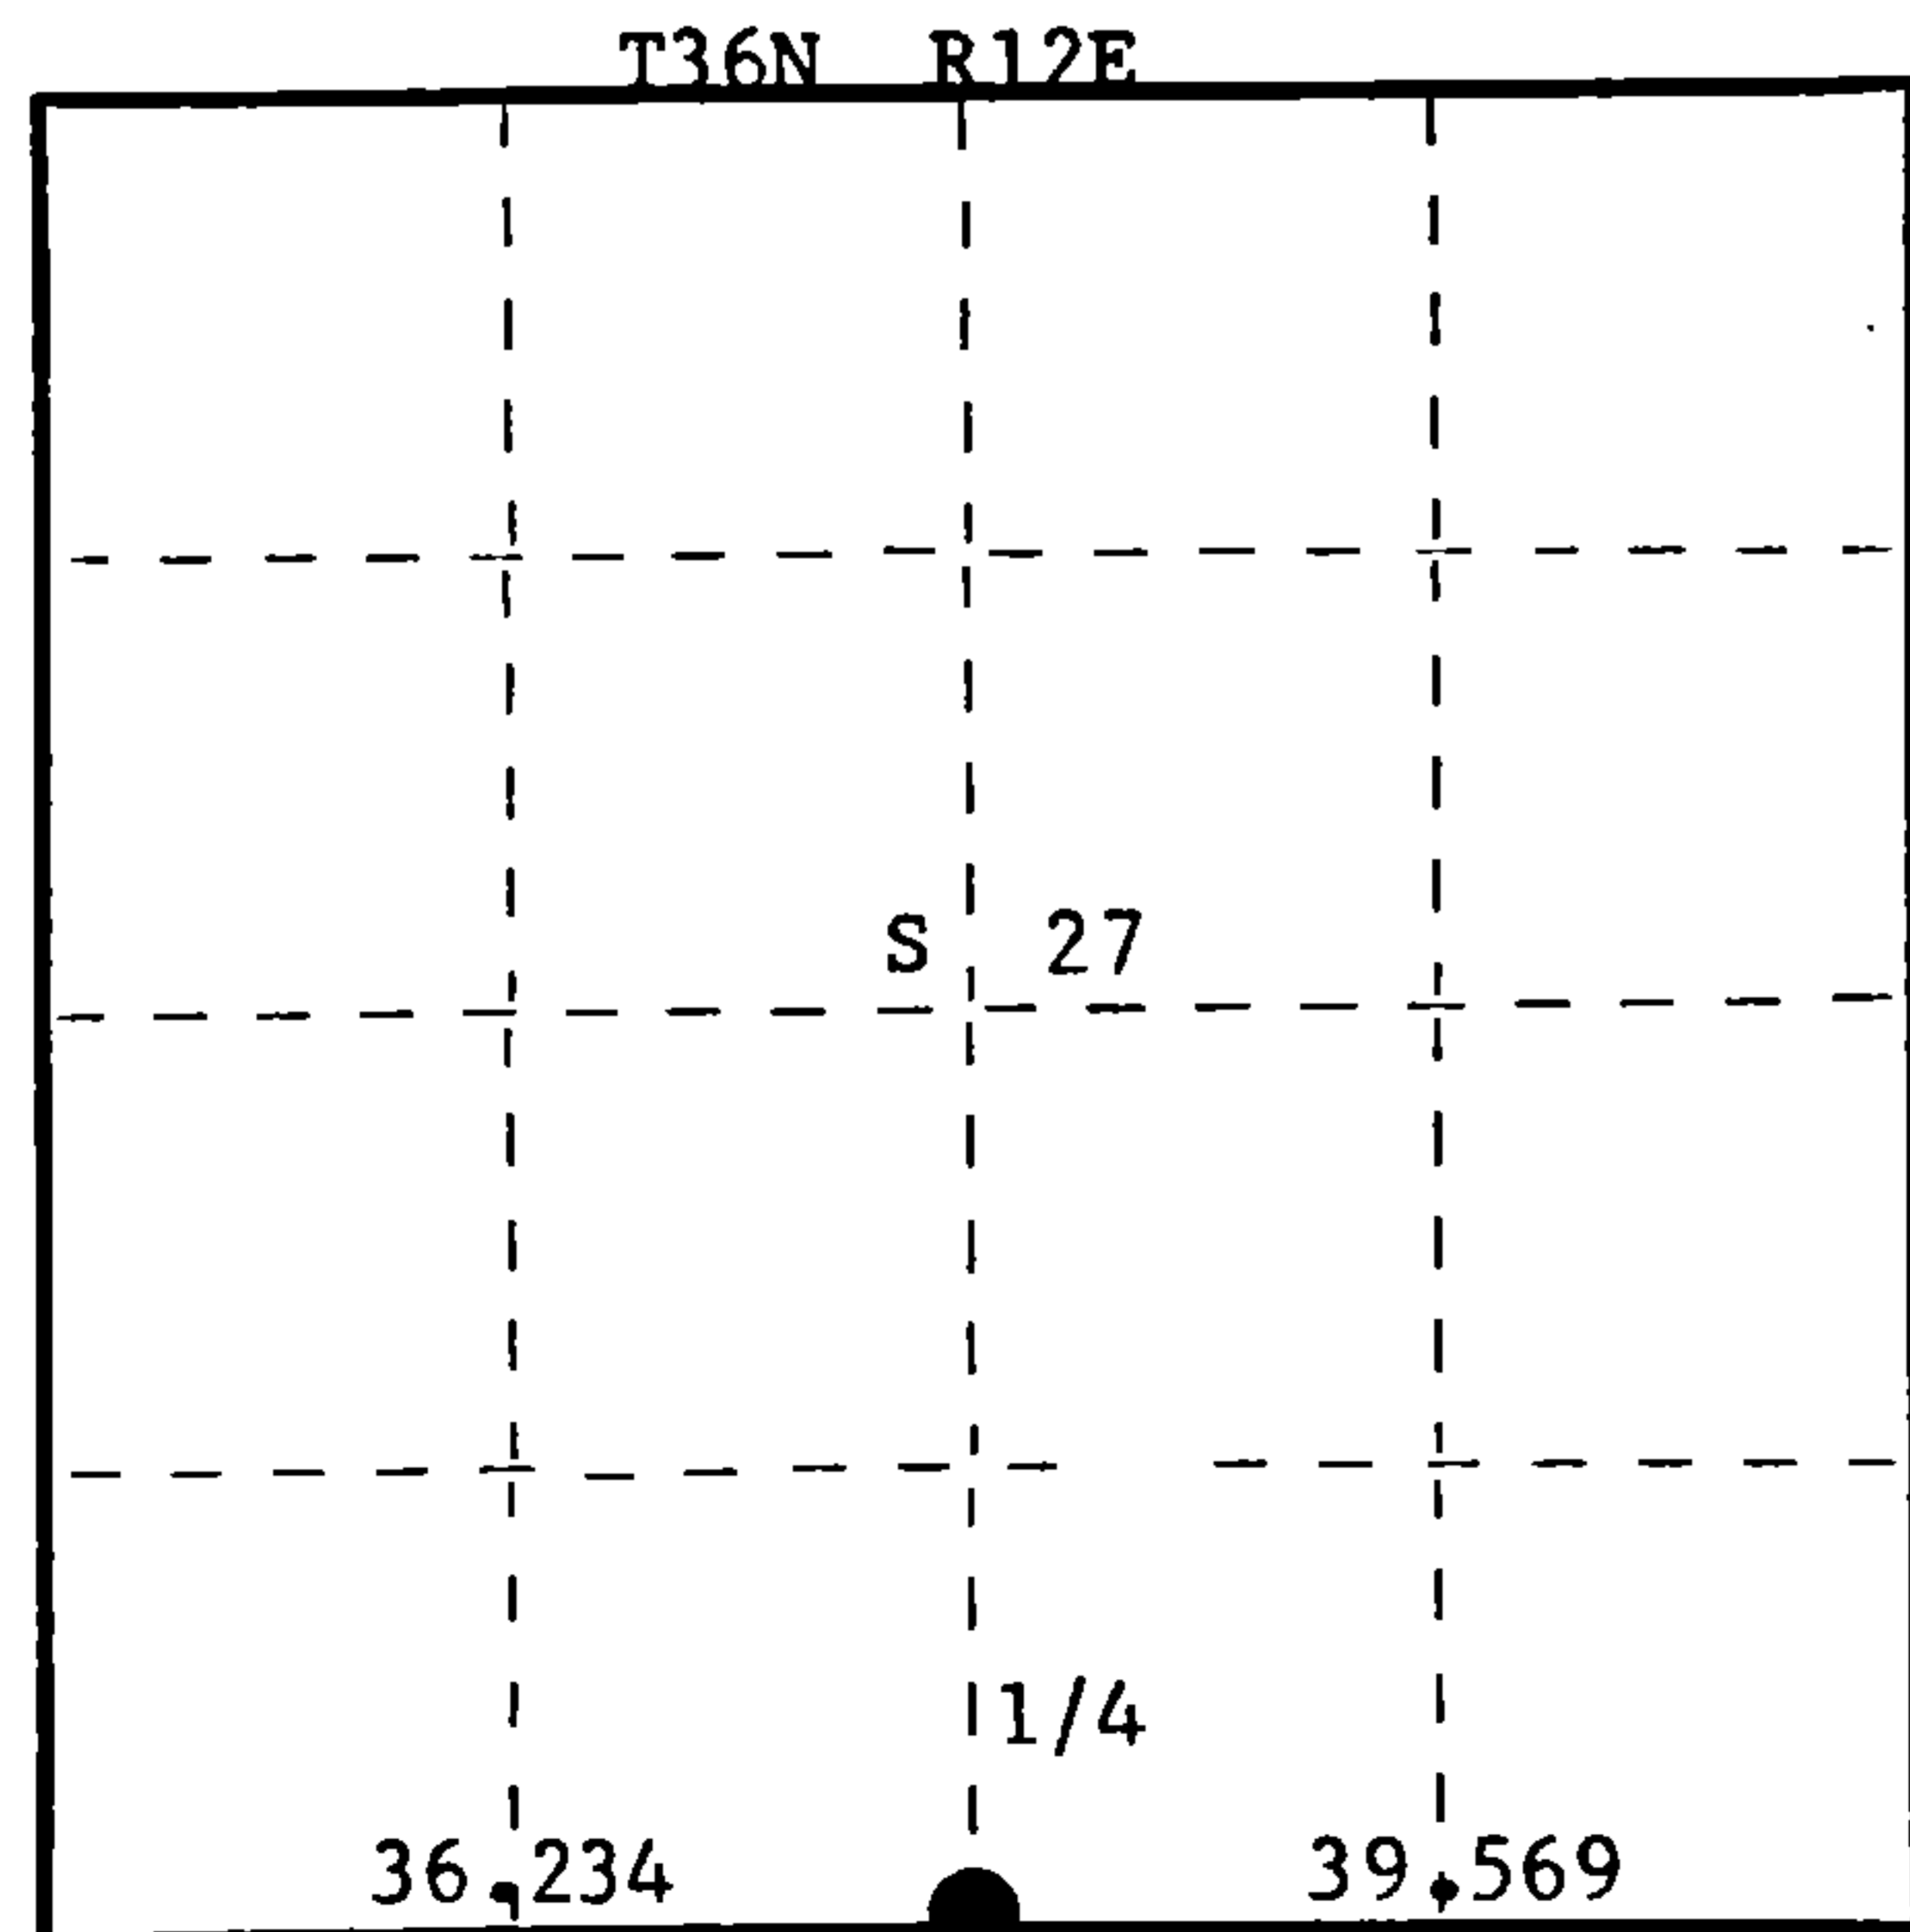

○ = Corner monument restored.

History of original corner establishment:

Original Corner established by J. Nowlin, Deputy Surveyor, in 1859, from which ironwood 6" bears S44°E, 11 links and Birch 12" bears N34°W, 17 links.

No records of any subsequent survey.

Description of corner evidence found:

Recovered a very old 1 1/2" iron pipe one foot above ground on the north ROW line of old section line road. George C. Ison stated that 32 years ago he was shown this iron pipe and also one that set on the south ROW line. The south one has since been lost. There is an old rock fence running south from this corner and an old wire fence running north. Distance from beginning of rock fence to the old fence is 3 rods.

Description of monument and accessories I established to perpetuate the original location of this corner.

Drove a 1 1/2" x 18" iron rod at 1 1/2 rods south of the iron pipe 5" below the surface. Set a 2 1/2" Berntsen A-1 Federal Monument for witness corner 50 links north. Monument projects 12" above ground. Cap stamped:

Marked NBTs from true corner:

- Sugar 8" N20°W, 48.5 links, scribed 1/4 BT.
- Sugar 6" N42°W, 59.6 links, scribed 1/4 BT.
- Sugar 10" N61°E, 91.3 links, scribed 1/4 BT.

T36N R12E  
1/4 S <sup>27</sup>/<sub>34</sub> W.C.  
S498 - 1977  
S 50 lks to corner

Dated at Rhineland, Wis., this 9th day of August, 1977

Signature Philip T. Hansen Title Registered Land Surveyor Registration No. S-498  
(County Surveyor, Registered Land Surveyor, or other duly authorized official)

Office of Register of Deeds, County of Forest, I hereby certify that the within instrument was filed in this office for record on the 22nd day of AUGUST, 1977 at 3:30 o'clock P. M.

Ernest Stutzman  
(Register of Deeds)

By..... Deputy

DOCUMENT NUMBER  
**112156**

43612270020