

CERTIFIED LAND CORNER RESTORATION

Index No. U-12

State of Wisconsin }
County of Forest } ss.


I Philip T. Hansen, do hereby certify that on the 26th day of October, 1979, I ~~found~~ established the SE 1/16 corner of Section 28 Township 36, North, Range 12 East, Fourth Principal Meridian, as described hereon; and that from this evidence I established a new monument and accessories as described hereon to perpetuate the original location of this corner.

Resident witnesses:


Glen Barker

Jim Claflin

Herb Wagoner

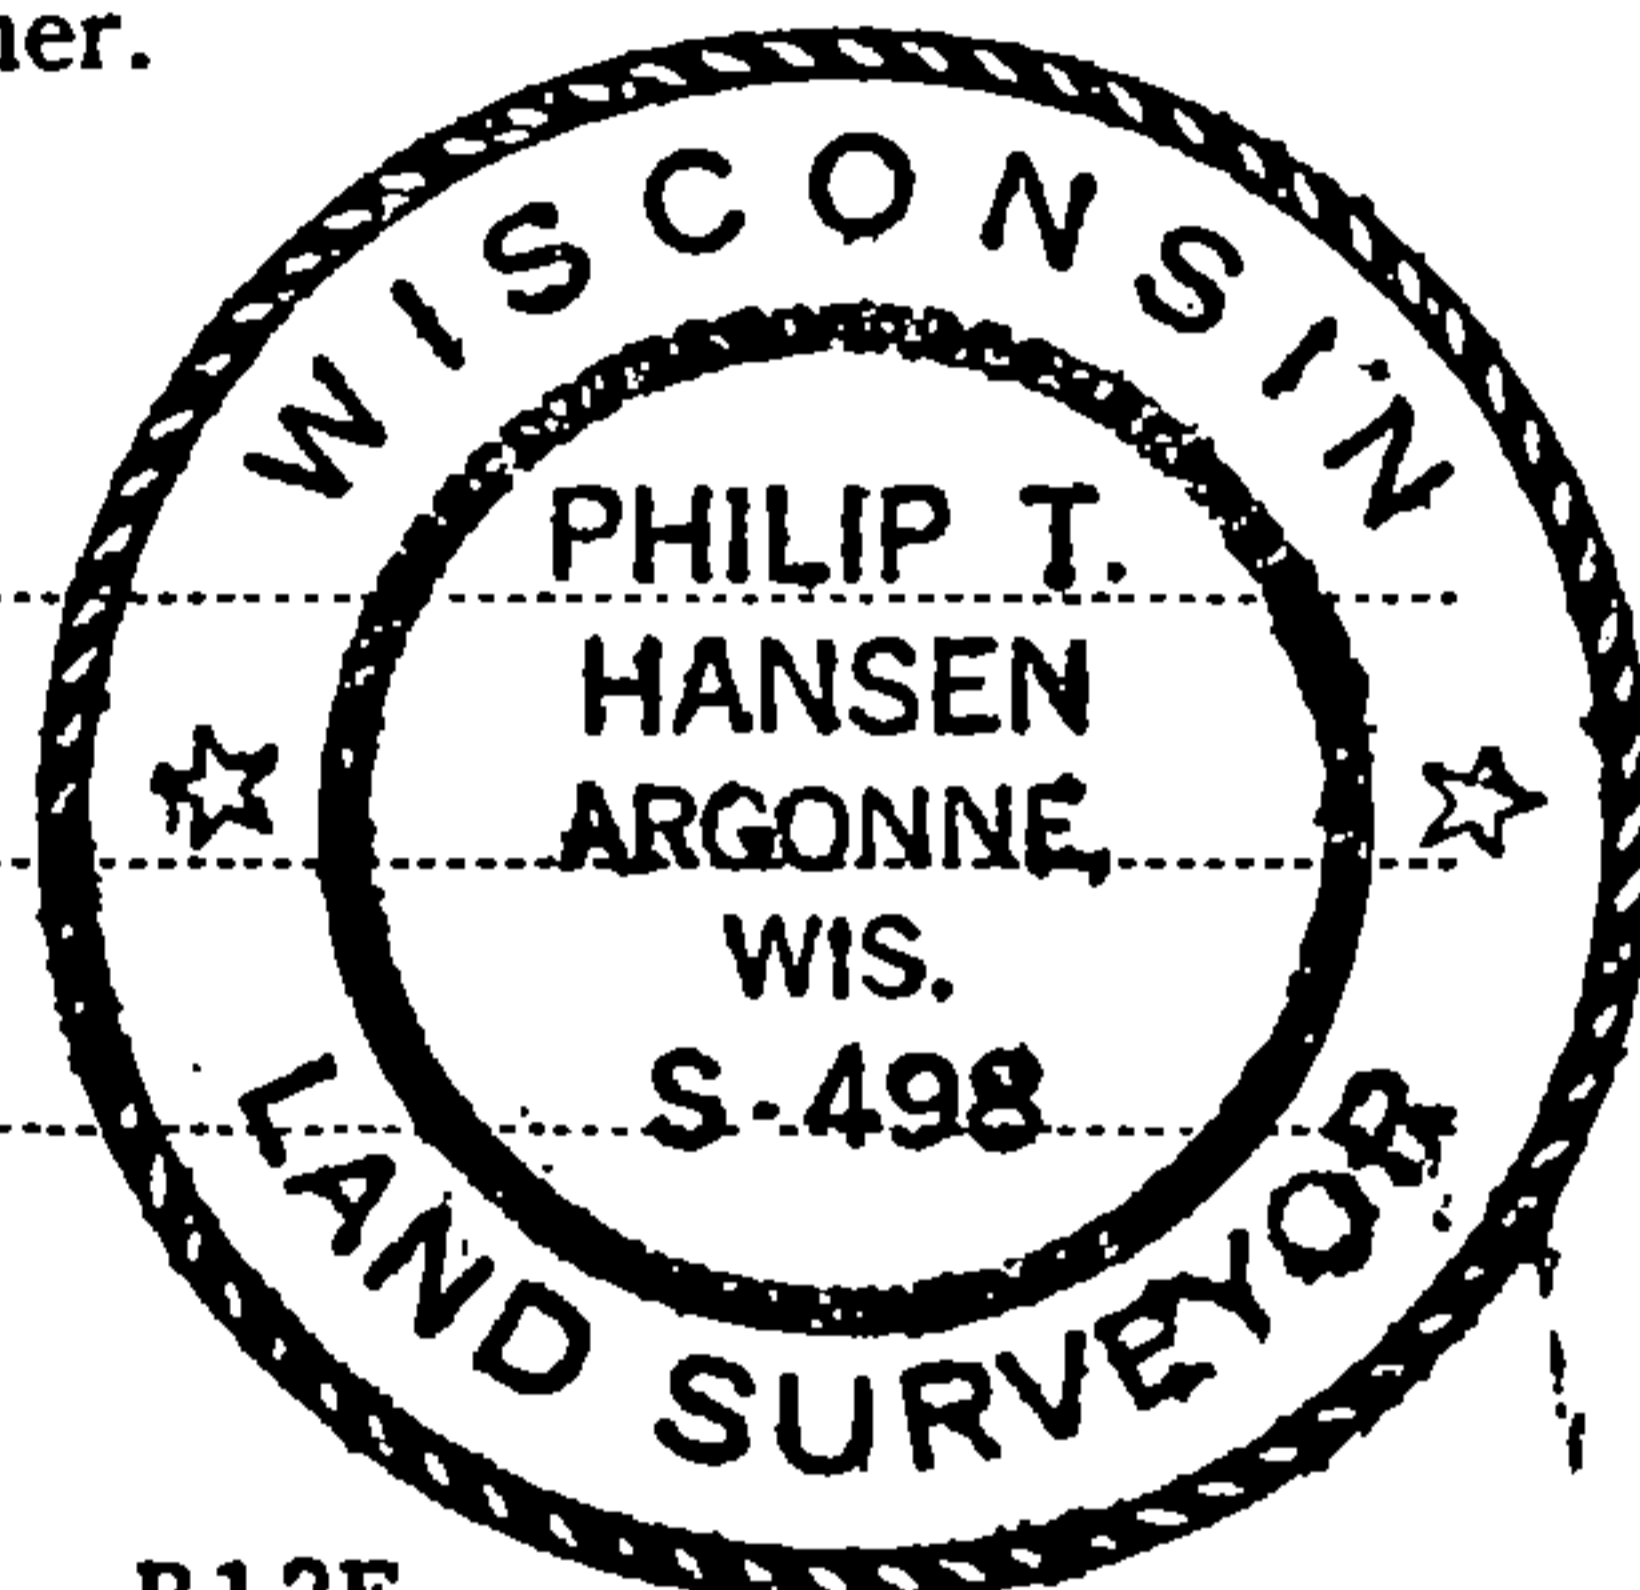

T36N R12E

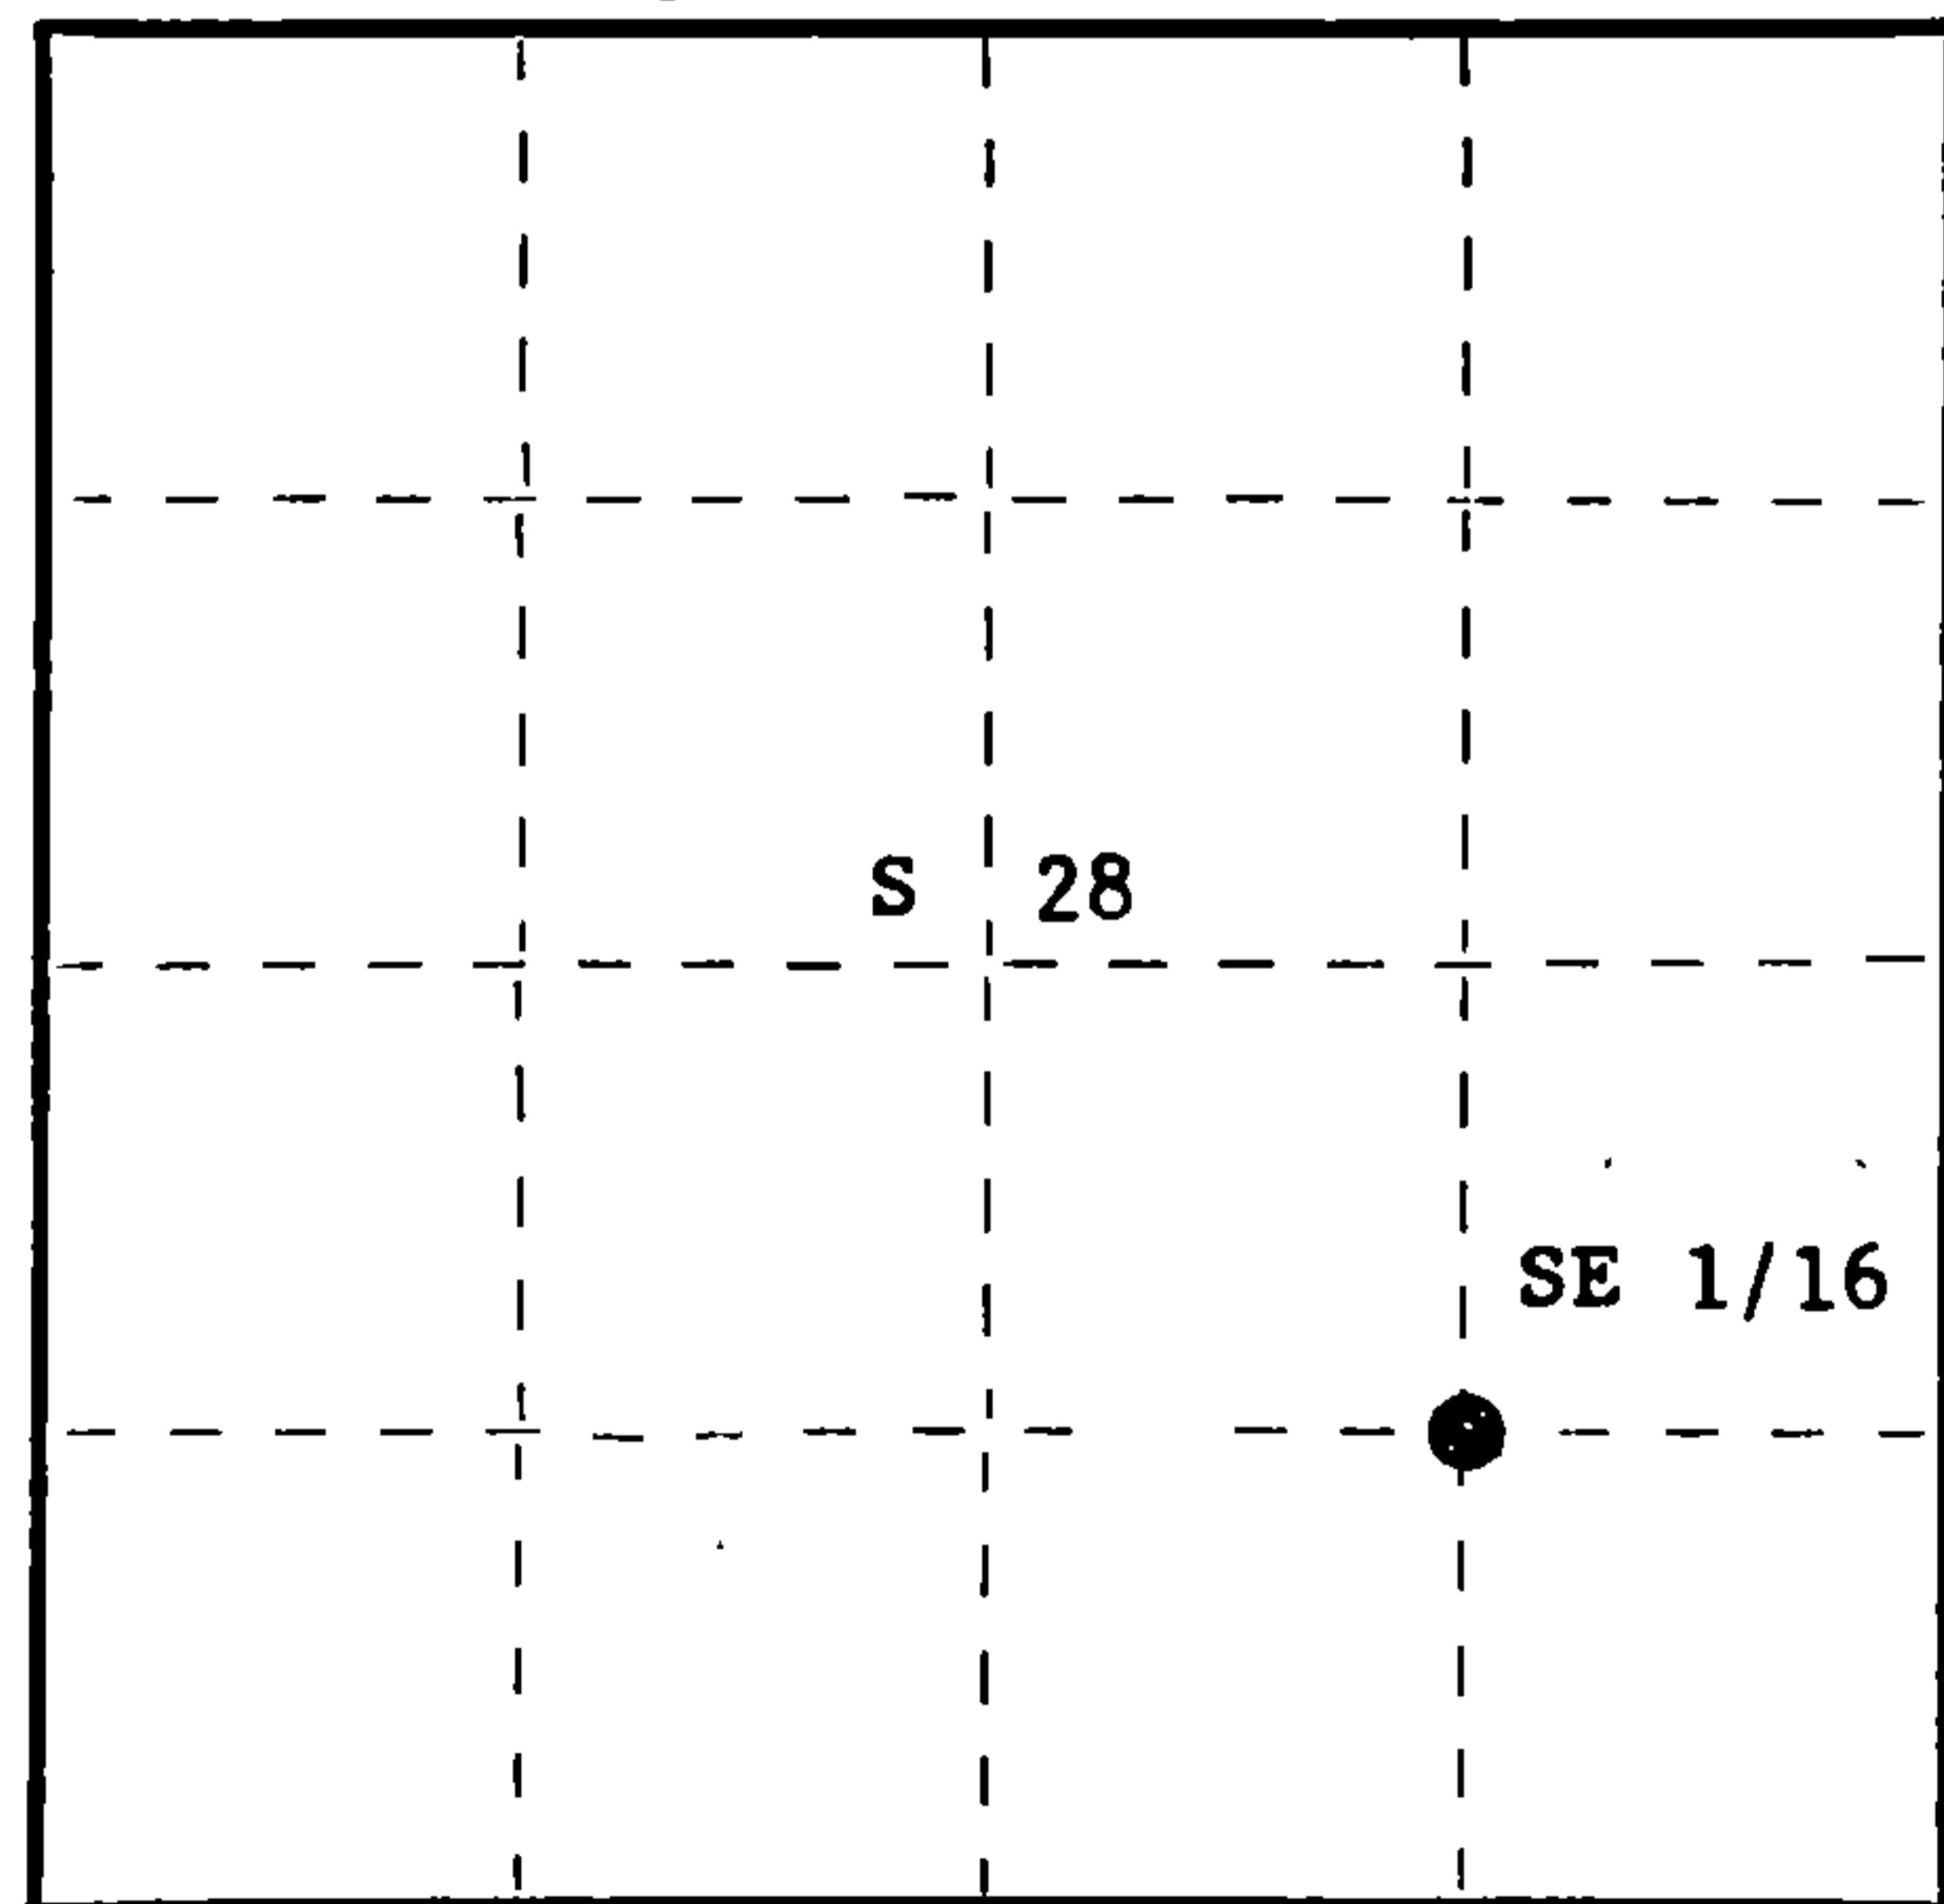

○ = Corner monument restored.

History of original corner establishment:

No records available from any previous survey.

Description of corner evidence found:

No evidence of any corner recovered.

Corner established by traverse and computation. Ran traverse from E 1/16 between sections 28 and 33 to EC 1/16, section 28. Computed distance is 2669.57' at bearing N 2° 22' 26" W. Computed location of SE 1/16 is 1334.78 feet, equidistant between E 1/16 and EC 1/16.

Description of monument and accessories I established to perpetuate the original location of this corner.

Set a 1-1/2" iron pipe with 2" brass cap, projecting 24", stamped:

Marked NBT's - Sugar 7" S50°W 12.71 feet
Sugar 8" N6°W 13.45 feet
both scribed 1/16 BT.

S498
T36N R12E
SE 1/16 S+28
CPI-1979

Dated at Rhineland, Wis., this 16th day of May, 19 80

Signature Philip T. Hansen Title Registered Land Surveyor Registration No. S-498
(County Surveyor, Registered Land Surveyor, or other duly authorized official)

Office of Register of Deeds, County of Forest, I hereby certify that the within instrument was filed in this office for record on the 2nd day of June, 19 80 at 8:30 o'clock A. M.

Eugene Stutzman
(Register of Deeds)

By _____ Deputy

DOCUMENT NO. **118005**

FORM 985 H. C. MILLER CO., MILWAUKEE

43612281010