

CERTIFIED LAND CORNER RESTORATION

Index No. T-13

State of Wisconsin }
County of Forest } ss.


I Philip T. Hansen, do hereby certify that on the 18th day of October, 1979, I ~~found~~ established ~~the~~ Quarter corner of Sections 27 and 28 Township 36, North, Range 12 East, Fourth Principal Meridian, as described hereon; and that from this evidence I established a new monument and accessories as described hereon to perpetuate the original location of this corner.

Resident witnesses:


Glen Barker

Jim Claflin

Herb Wagoner

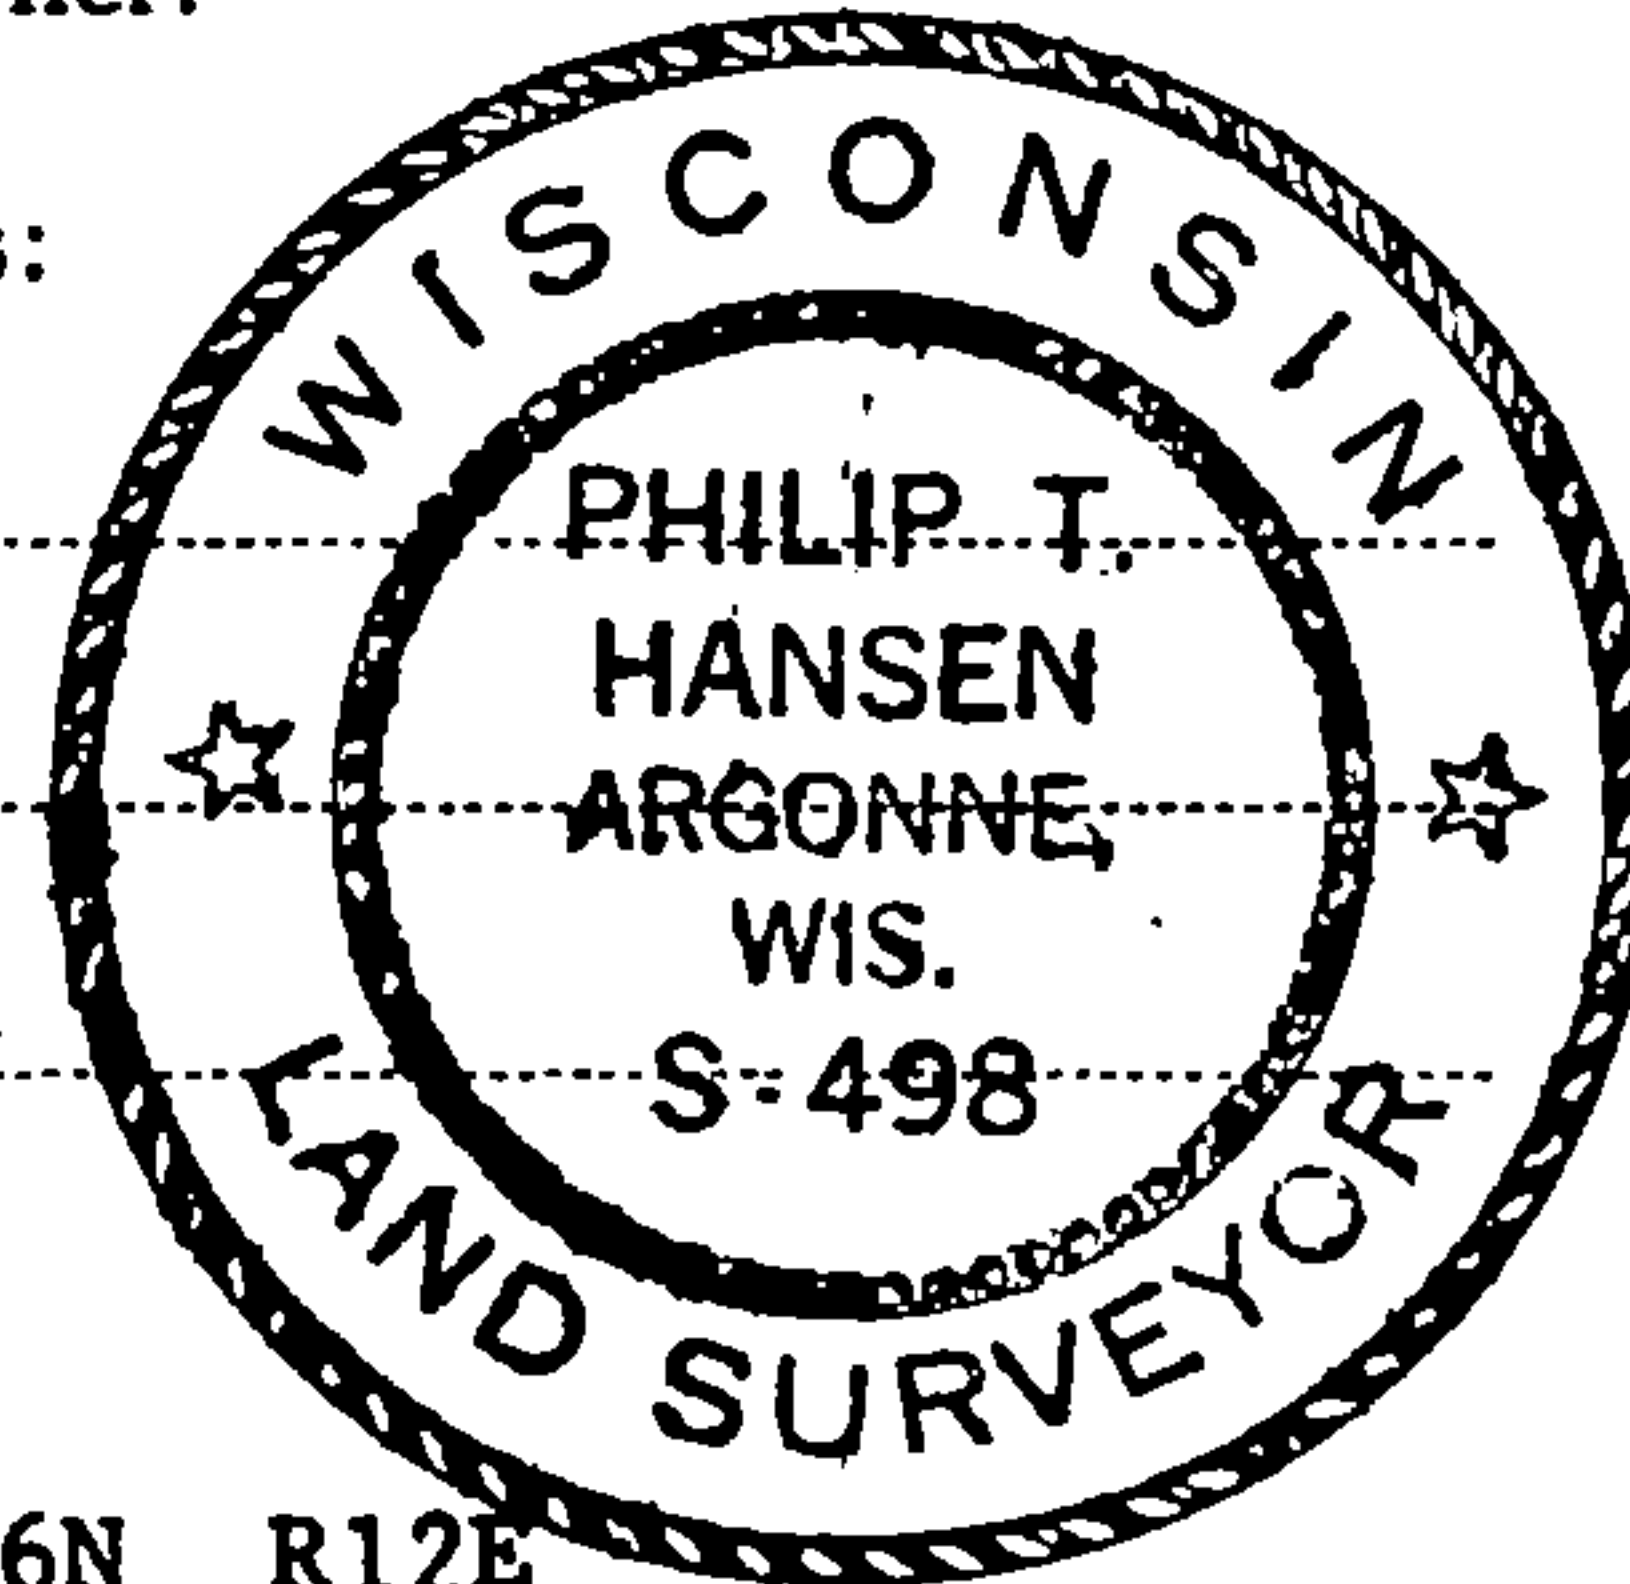

FORM 985 M. C. MILLER CO., MILWAUKEE

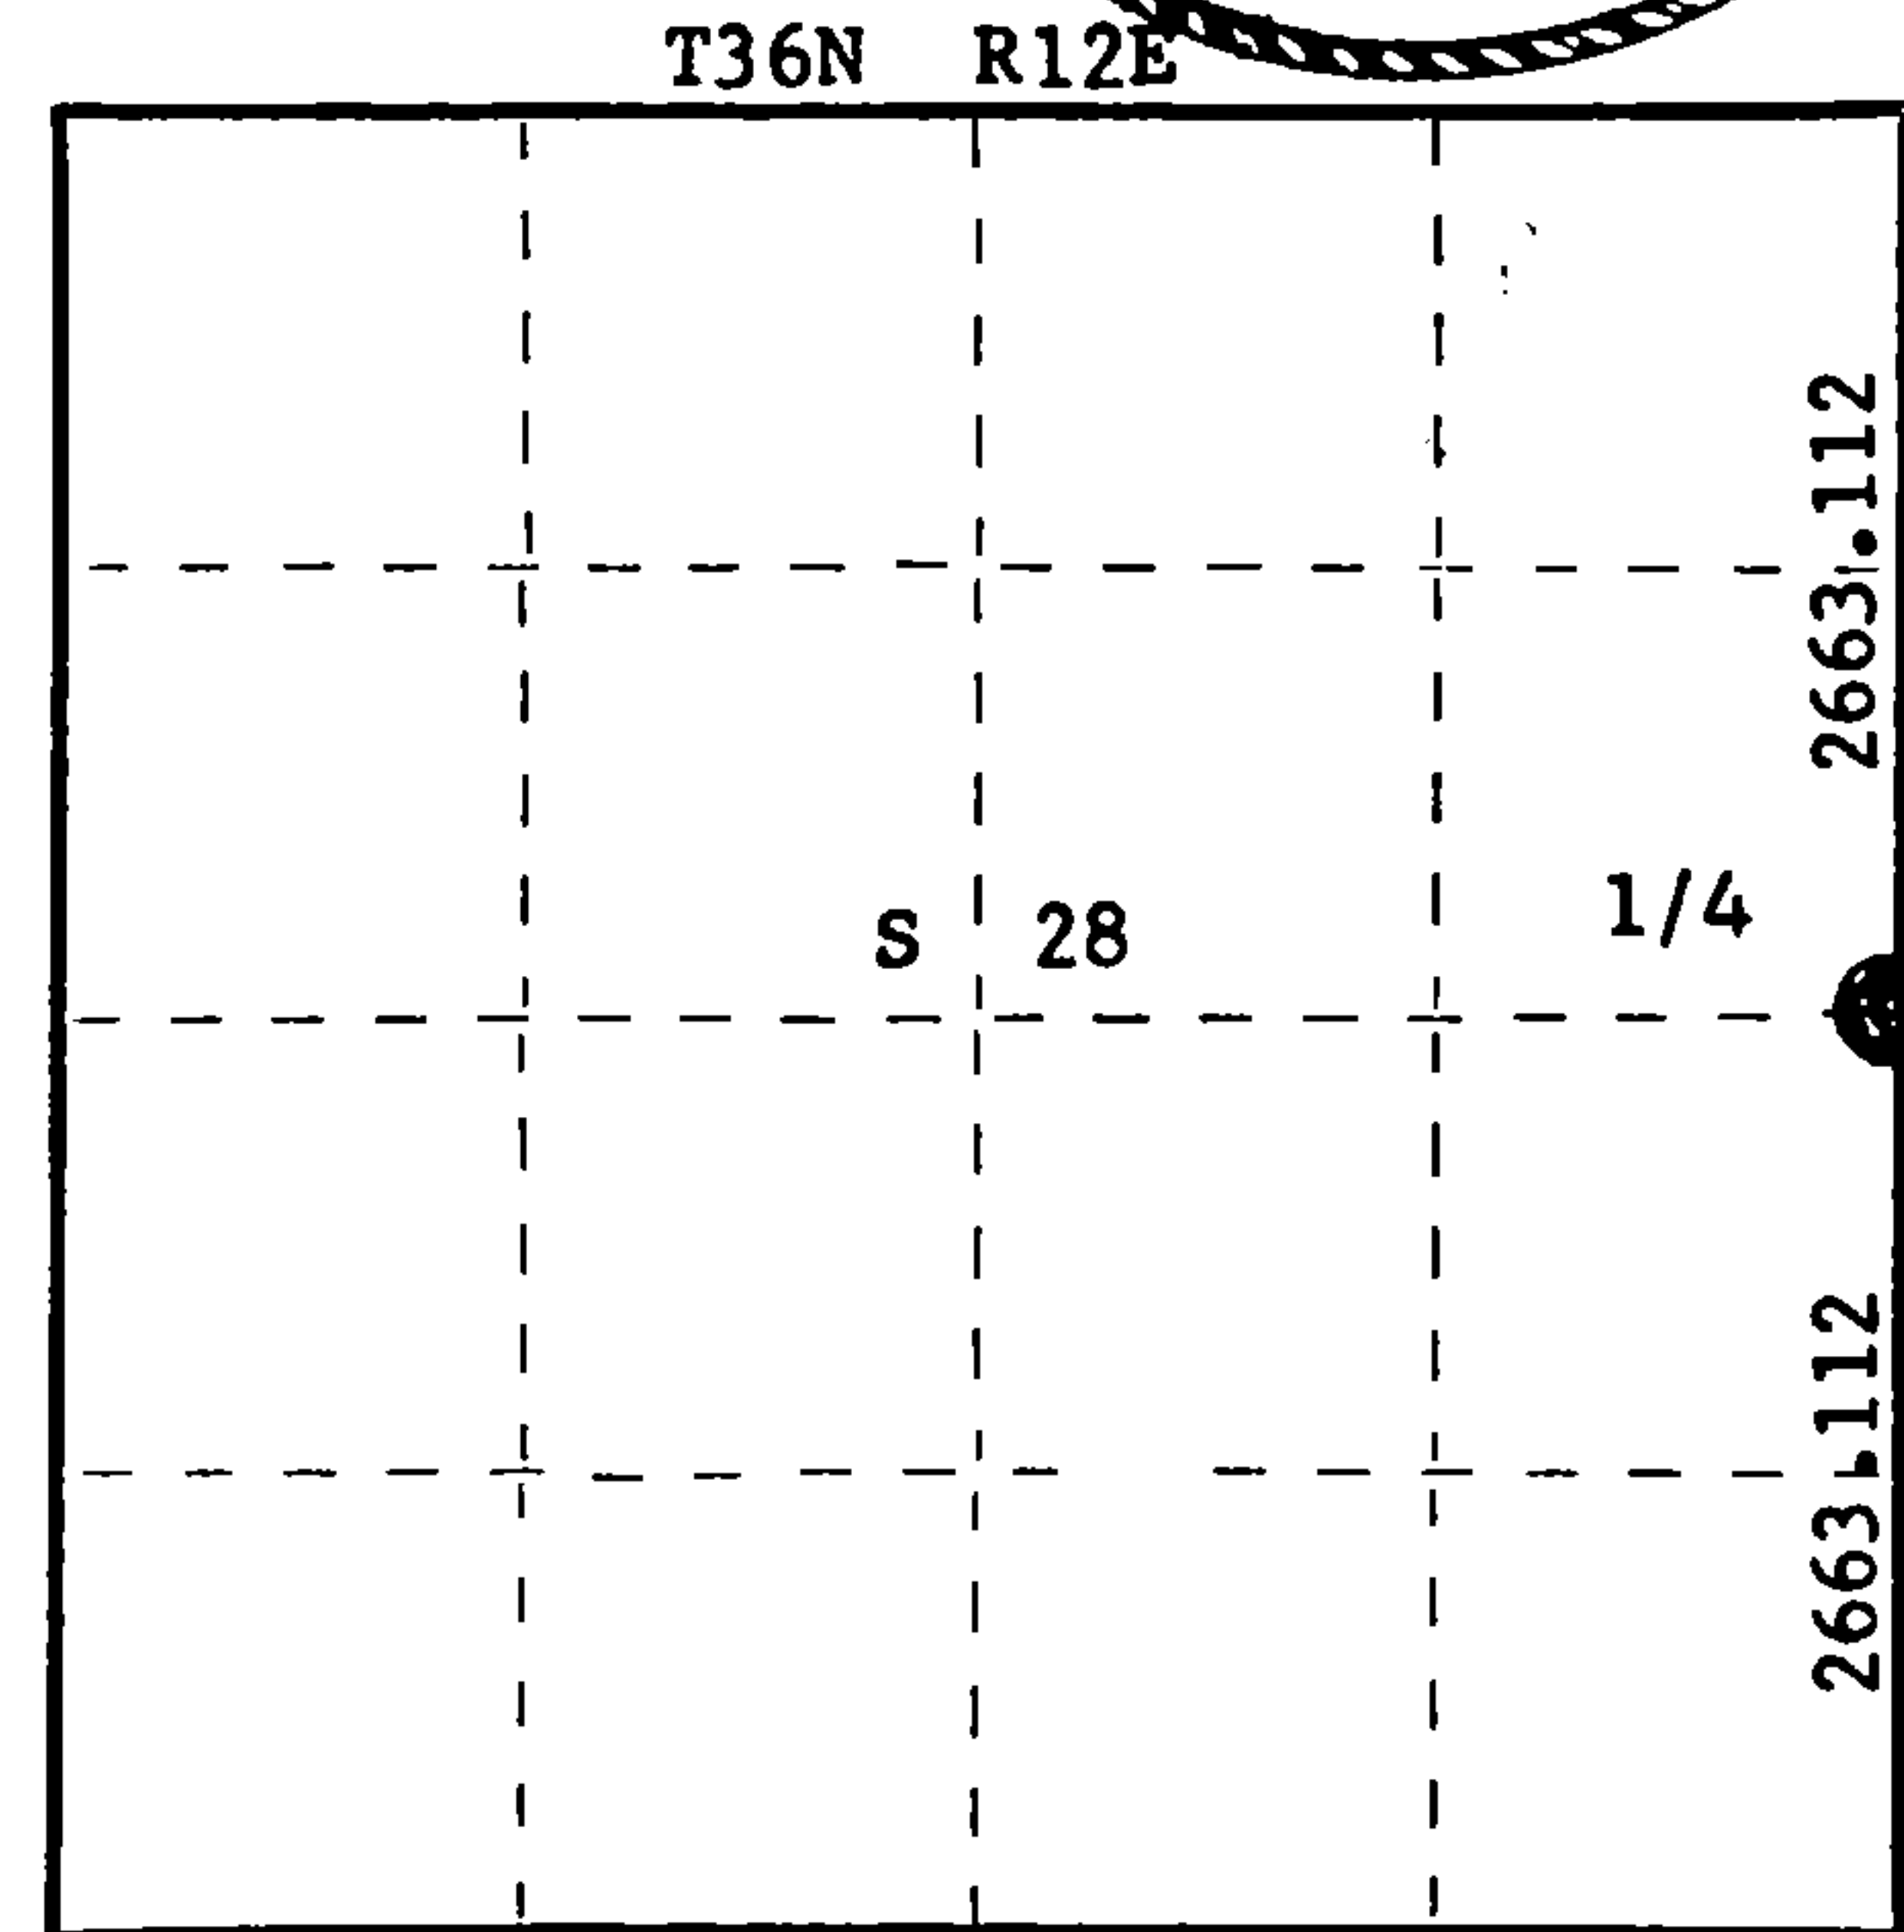

○ = Corner monument restored.

History of original corner establishment:

Original corner established by J.L. Nowlin, Deputy Surveyor, in 1859.

Description of corner evidence found:

No evidence of any corner recovered.

Corner established by traverse and computation. Ran traverse from section corners 21, 22, 27 and 28 to section corners 27, 28, 33 and 34. Computed distance is 5326.225 ft. at bearing S 2° 32' 41" E. Set 1/4 corner at 2663.112 feet intermediate.

Description of monument and accessories I established to perpetuate the original location of this corner.

Drove a 1-1/2" x 18" iron pipe 6" north of centerline of old Highway 8, 4 inches below the surface for true corner.

Set a 2-1/2" Berntsen A-1 Federal Monument 50' north for witness corner.

Monument projects 8" above ground - cap stamped:

Marked NBT's to true corner -

Sugar 6" N17°E 62.68' scribed 1/4 BT.

Sugar 5" N19°W 70.35' scribed 1/4 BT.

B.O. Power Pole #3612 27W N66°W 47.45.

T36N R12E
1/4 S28 + S27 W.C.
S 50' to Cor.
S498 - 1979

Dated at Rhineland, Wis., this 16th day of May, 1980

Signature Philip T. Hansen Title Registered Land Surveyor Registration No. S-498
(County Surveyor, Registered Land Surveyor, or other duly authorized official)

Office of Register of Deeds, County of Forest, I hereby certify that the within instrument was filed in this office for record on the 2nd day of June, 1980 at 8:30 o'clock A. M.

Rugene Stutzman
(Register of Deeds)
By _____ Deputy

DOCUMENT NO. **118000**

43012-282000

CERTIFIED LAND CORNER RESTORATION

Index No. T-13

State of Wisconsin }
County of Forest } ss.


I Philip T. Hansen, do hereby certify that on the 7th day of June, 1979, I ~~restored~~ established ~~corner~~ of the 1/4 corner of Section 27 Township 36N, North, Range 12 East, Fourth Principal Meridian, as described hereon; and that from this evidence I established a new monument and accessories as described hereon to perpetuate the original location of this corner.

Resident witnesses


Glen Barker

Jim Claflin

Herb Wagoner

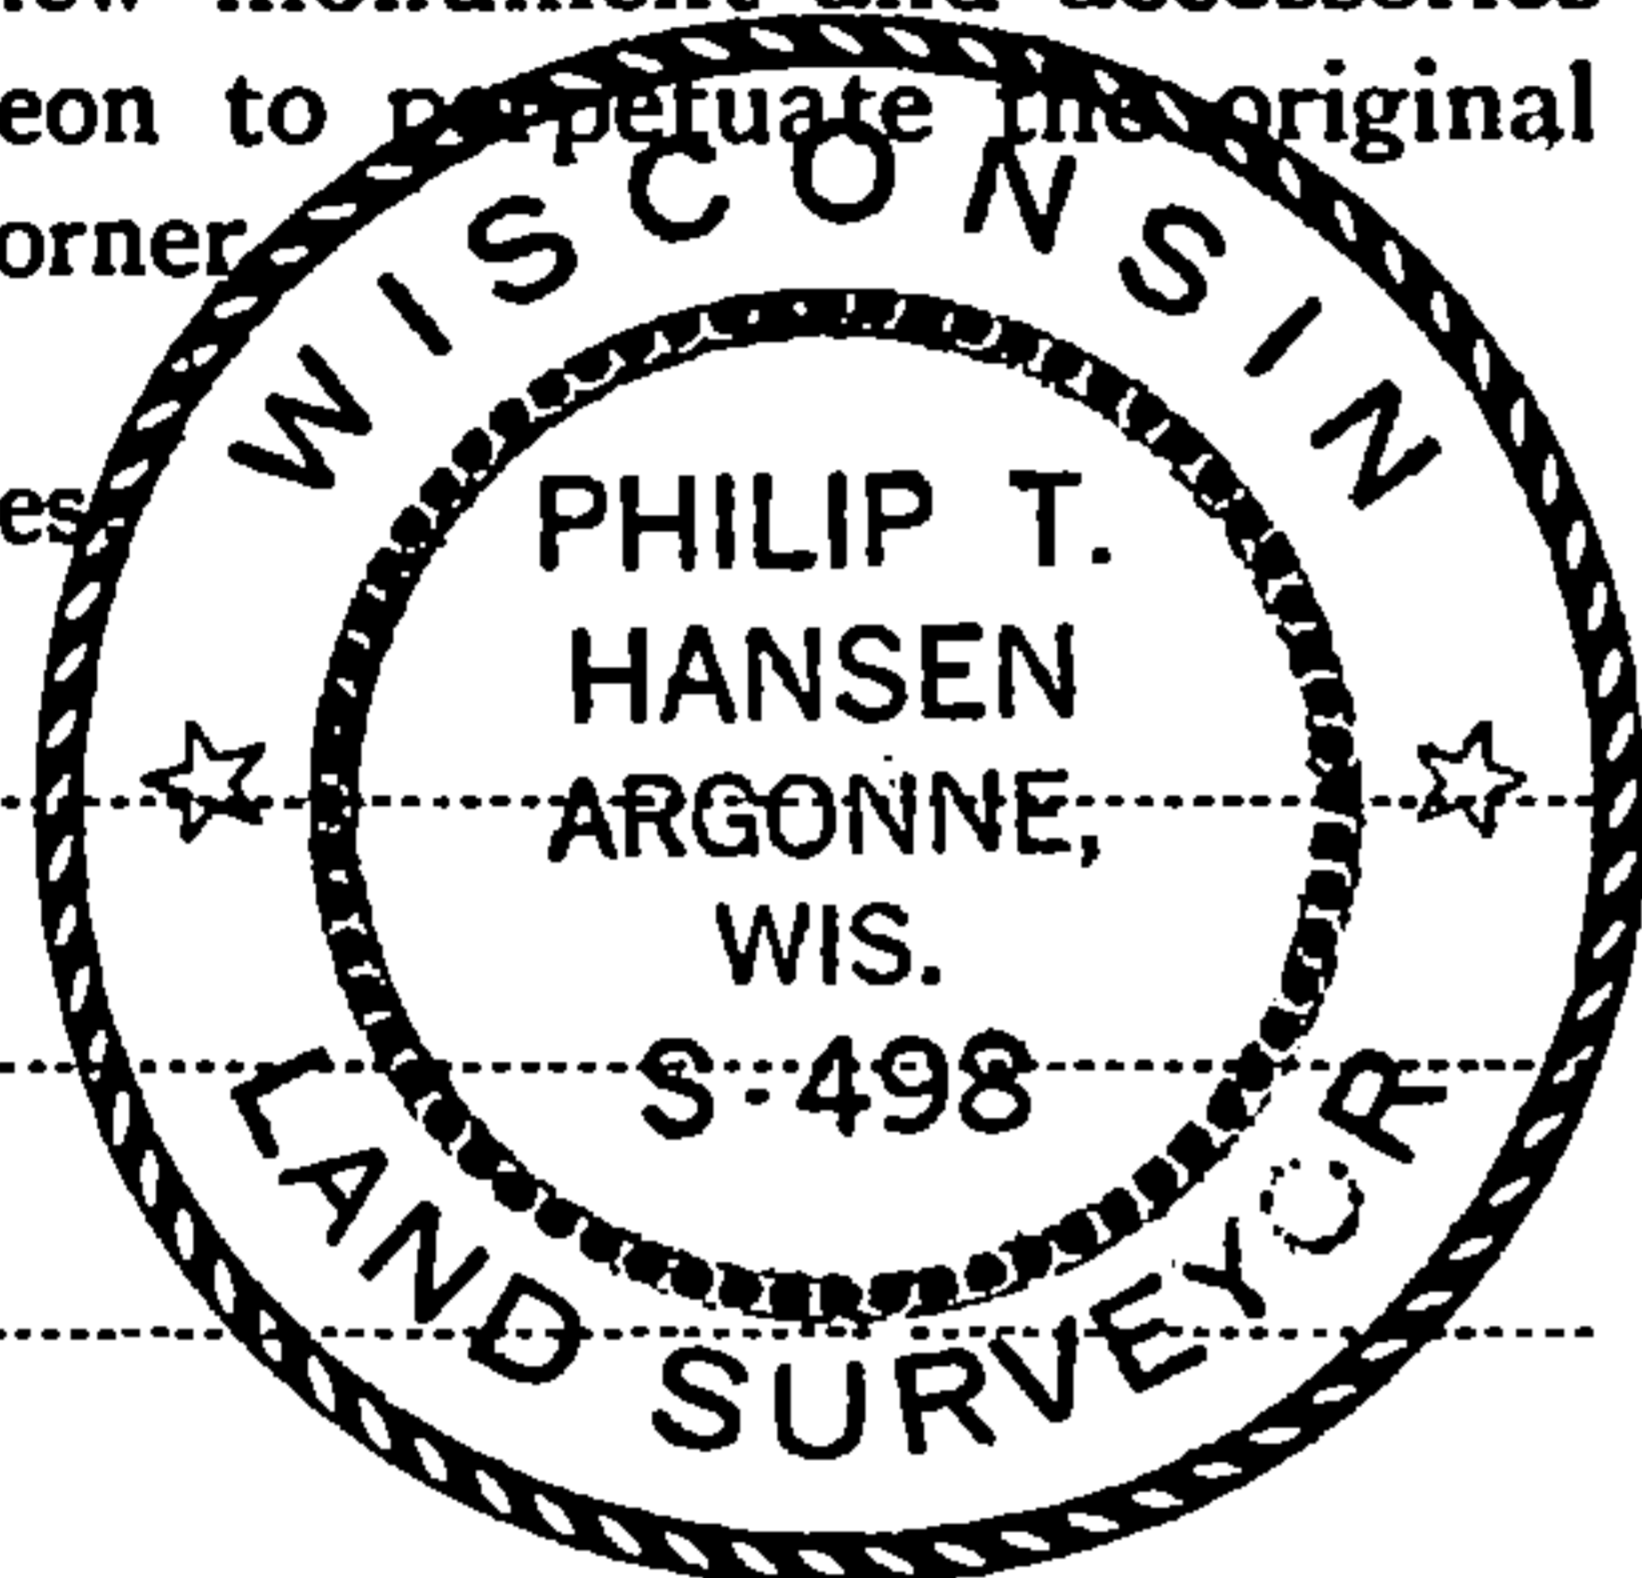

FORM 985 Wisconsin Planning Library Co.

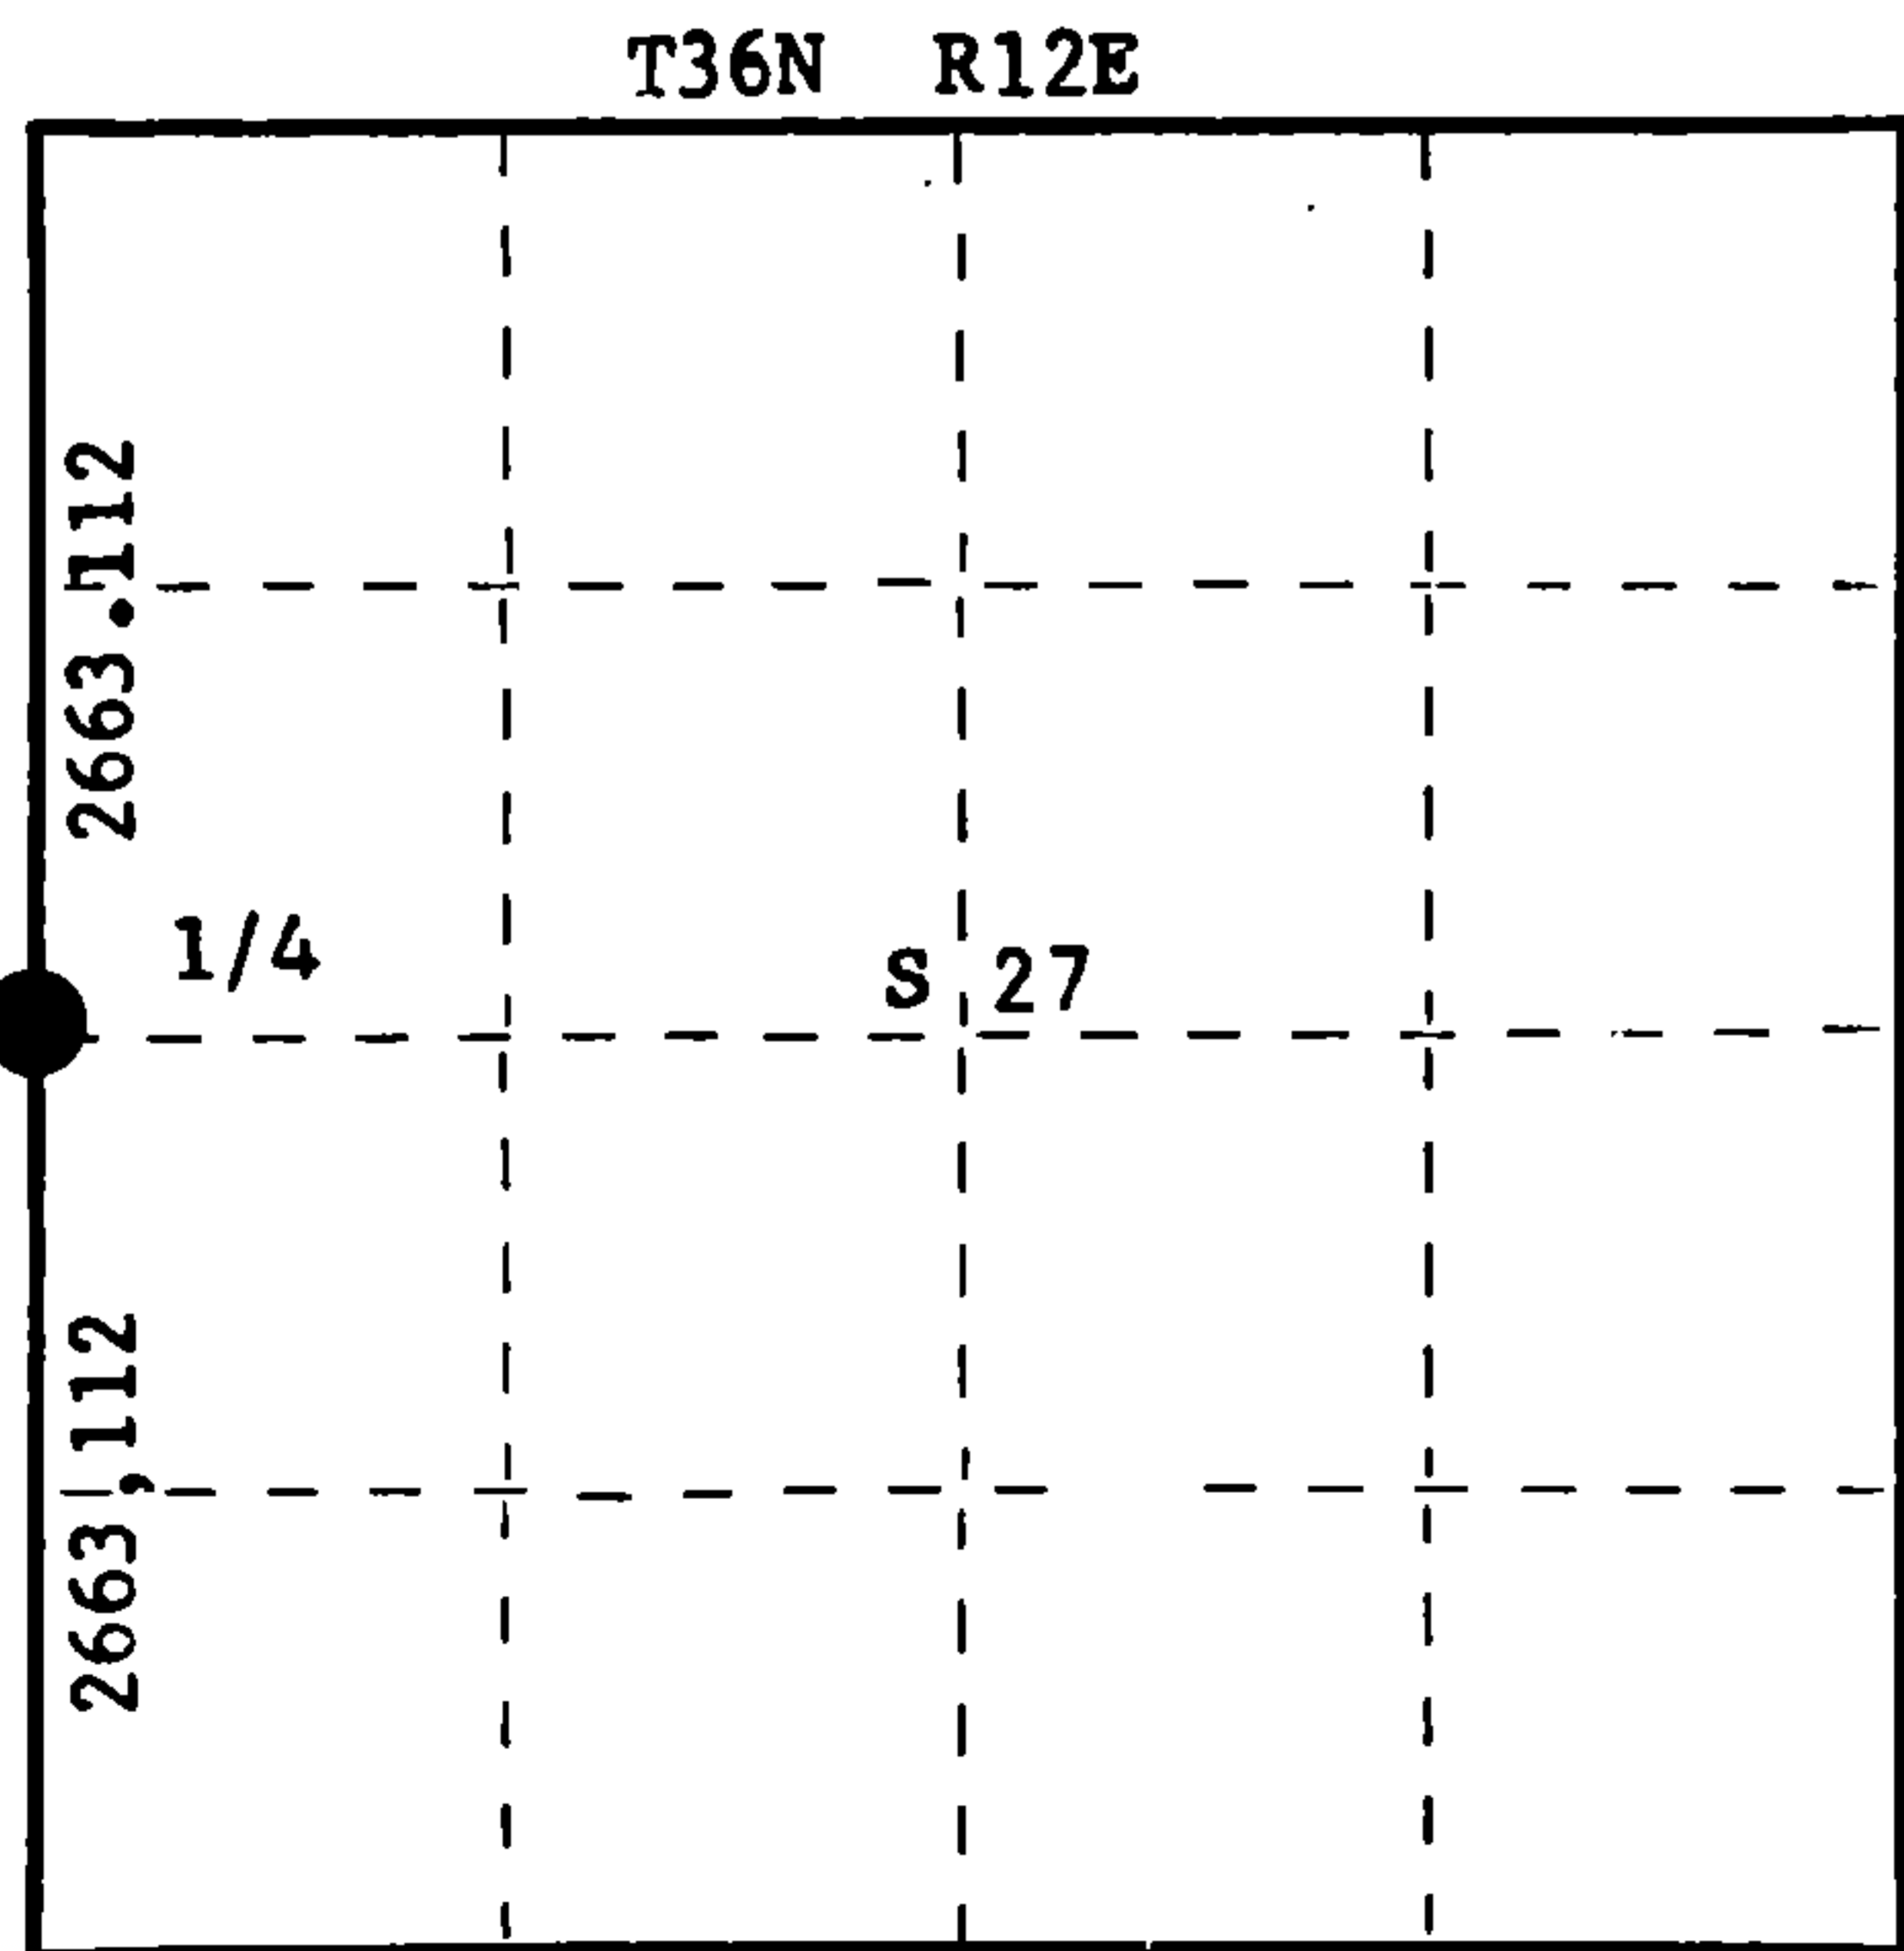

○ = Corner monument restored.

History of original corner establishment:

Original corner established by Wm. E. Dougherty, Deputy Surveyor, in 1859.
No records of any subsequent survey.

Description of corner evidence found:

No evidence of any corner recovered. All evidence destroyed during construction of old Highway 8. Corner established by traverse and computation. Ran traverse from section corner 21, 22, 27 and 28 to section corner 27, 28, 33 and 34. Computed distance at 5326.225 feet at bearing S 2° 32' 41" E. Set 1/4 corner at 2663.112 feet intermediate.

Description of monument and accessories I established to perpetuate the original location of this corner.

Drove a 1-1/2" x 18" iron pipe, 6" North of the centerline of old Highway 8, 4" below the surface of the road.

Set a 2-1/2" Berntsen A-1 Federal Monument, 50 feet north for a witness monument.

Monument projects 8" above ground - cap stamped:

Marked NBT's -

Sugar 6" N17°E 62.68 feet, scribed 1/4 BT.

Sugar 5" N19°W 70.35 feet, scribed 1/4 BT.

NBO - Power Pole #3612 27101 N66°W 47.45'

T36N R12E
1/4 28 + 27 W.C.
S 50 ft. to Cor.
S498 - 1979

Dated at Rhineland, Wis., this 12th day of June, 1979.

Signature Philip T. Hansen Title Registered Land Surveyor Registration No. S-498
(County Surveyor, Registered Land Surveyor, or other duly authorized official)

Office of Register of Deeds, County of Forest, I hereby certify that the within instrument was filed in this office for record on the 13th day of November, 1979 at 8:30 o'clock A. M.

Eugene Staszny
(Register of Deeds)

By _____ Deputy

DOCUMENT NO. **117078**

43012 282000