

CERTIFIED LAND CORNER RESTORATION



Index No. T-11

State of Wisconsin }
County of Forest } ss.

I Philip T. Hansen, do hereby
certify that on the 18th day
of October, 1979, I ~~found~~
~~recovered~~ established the C 1/4
corner of Section 28
Township 36, North, Range
12 East, Fourth Principal Meridian,
as described hereon; and that from this evidence
I established a new monument and accessories
as described hereon to perpetuate the original
location of this corner.

Resident witnesses:

Glen Barker
Jim Claflin
Herb Wagoner

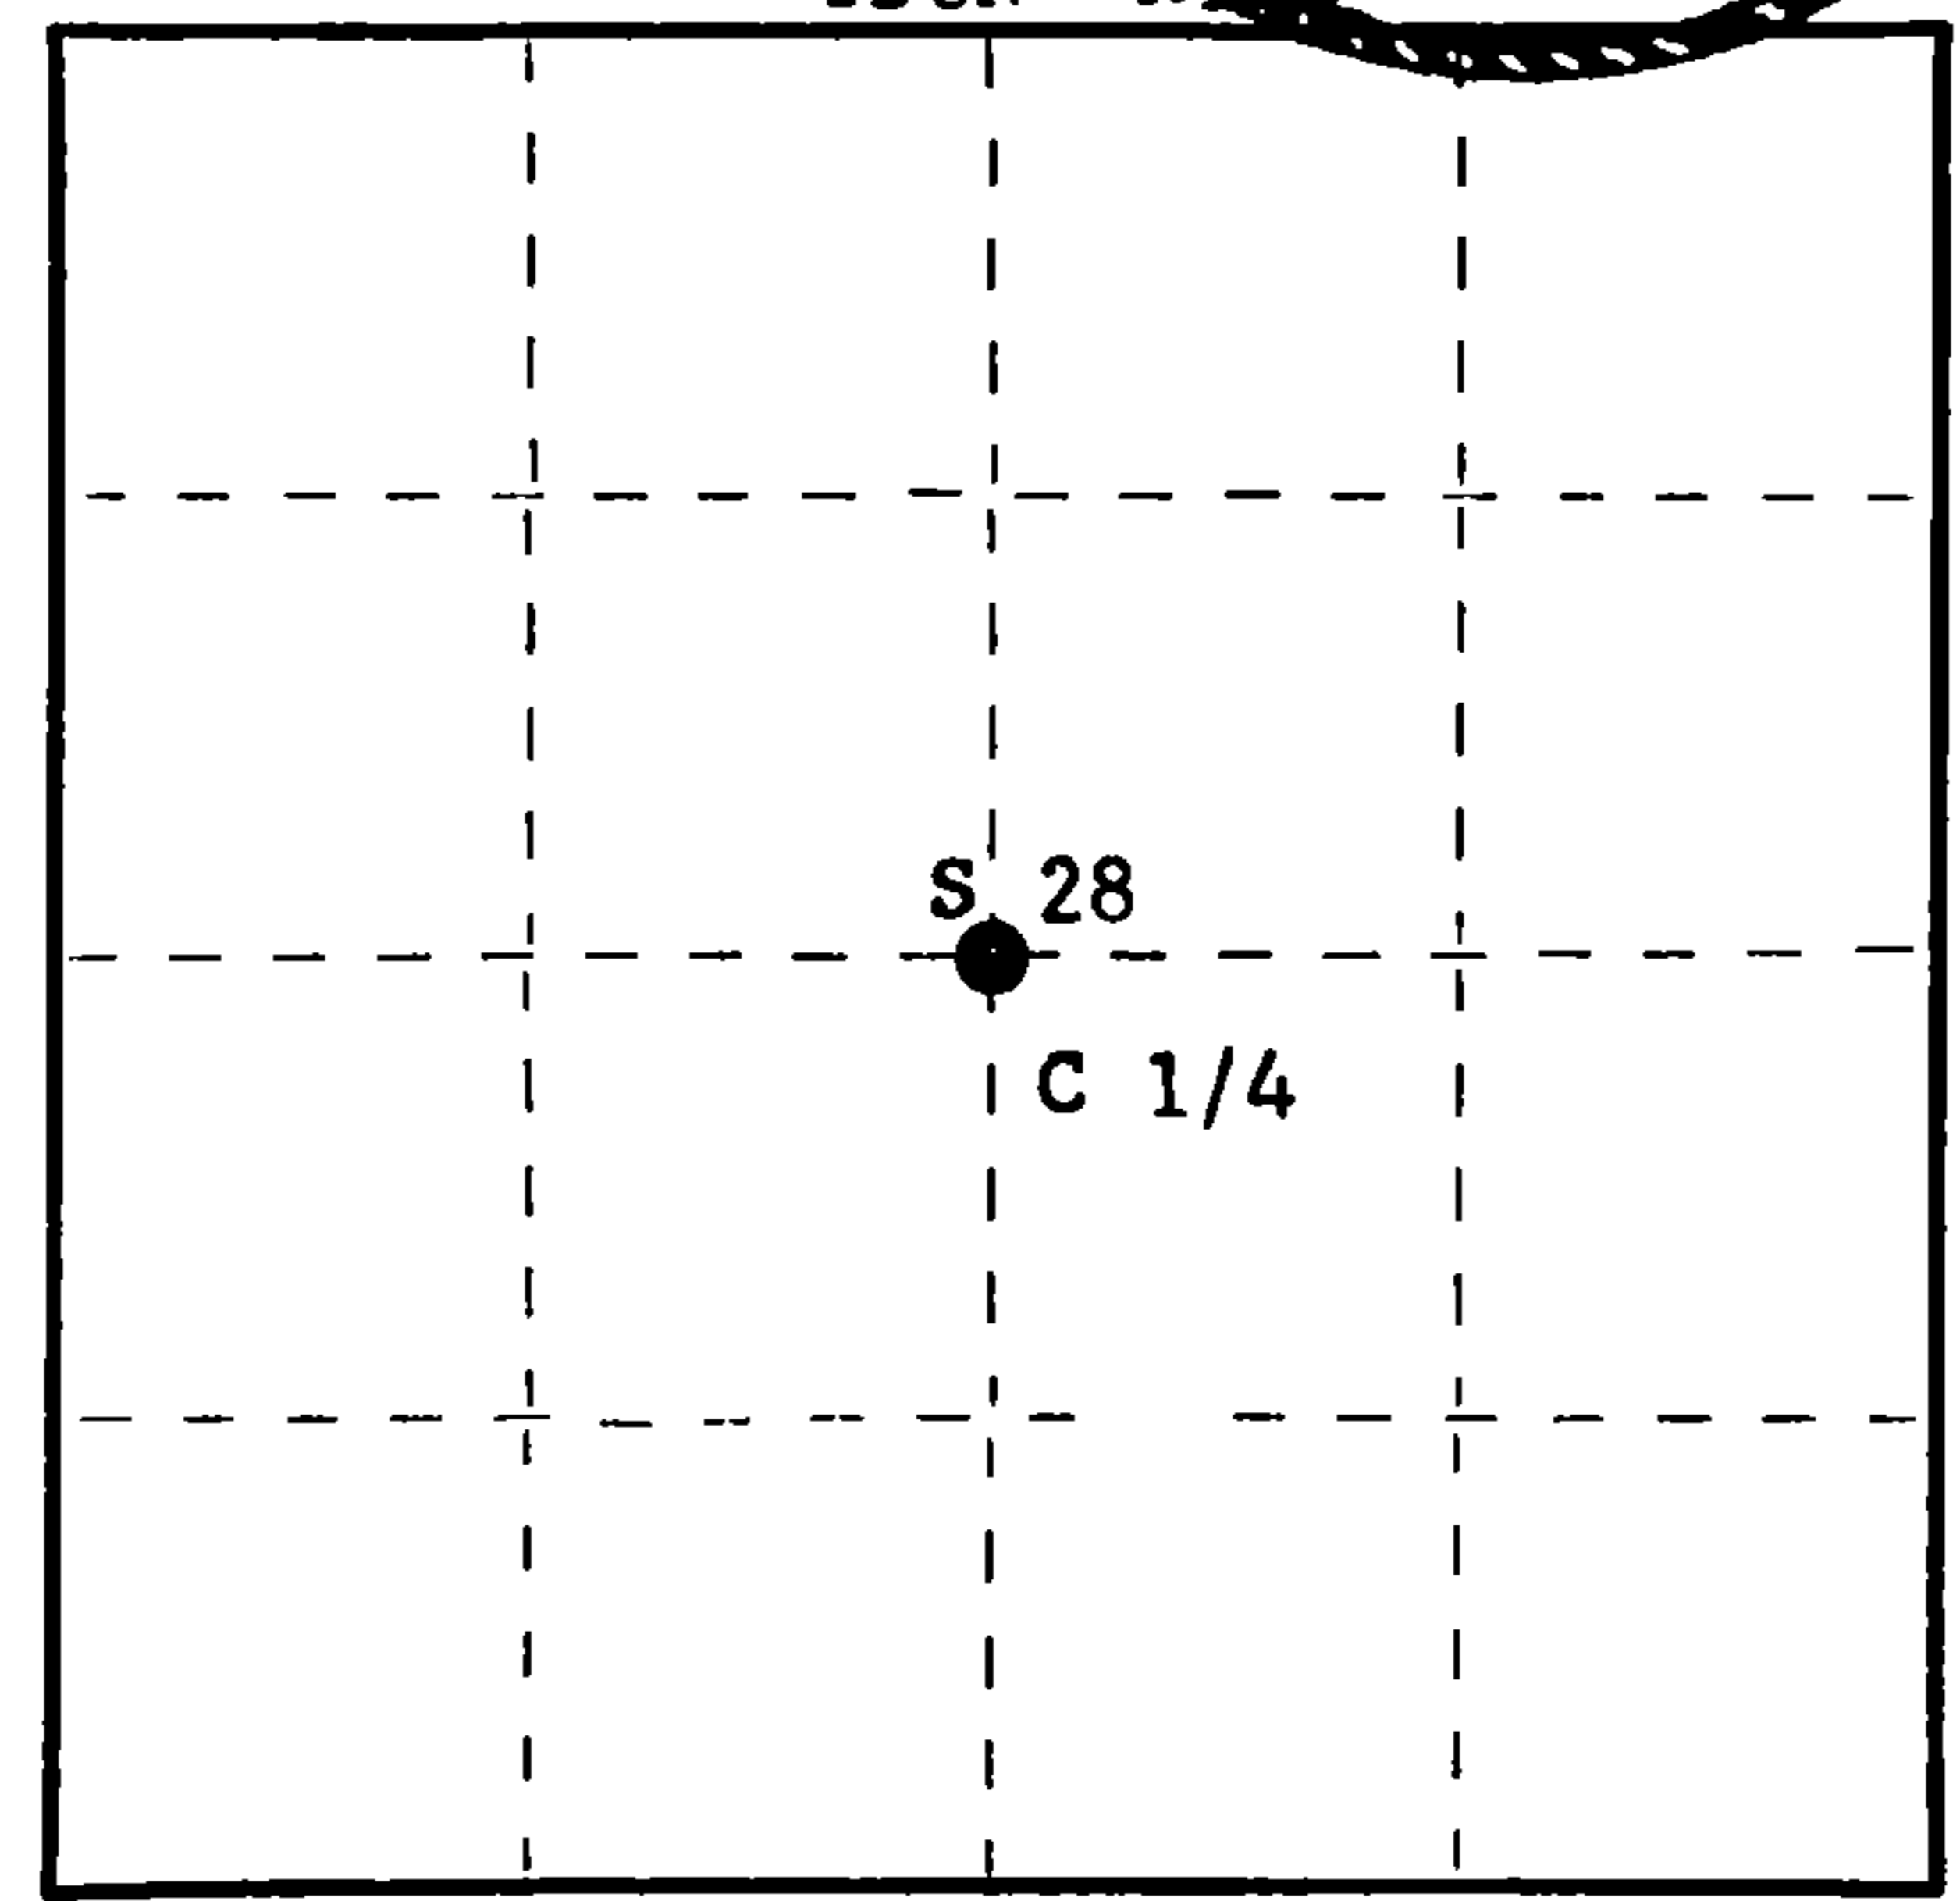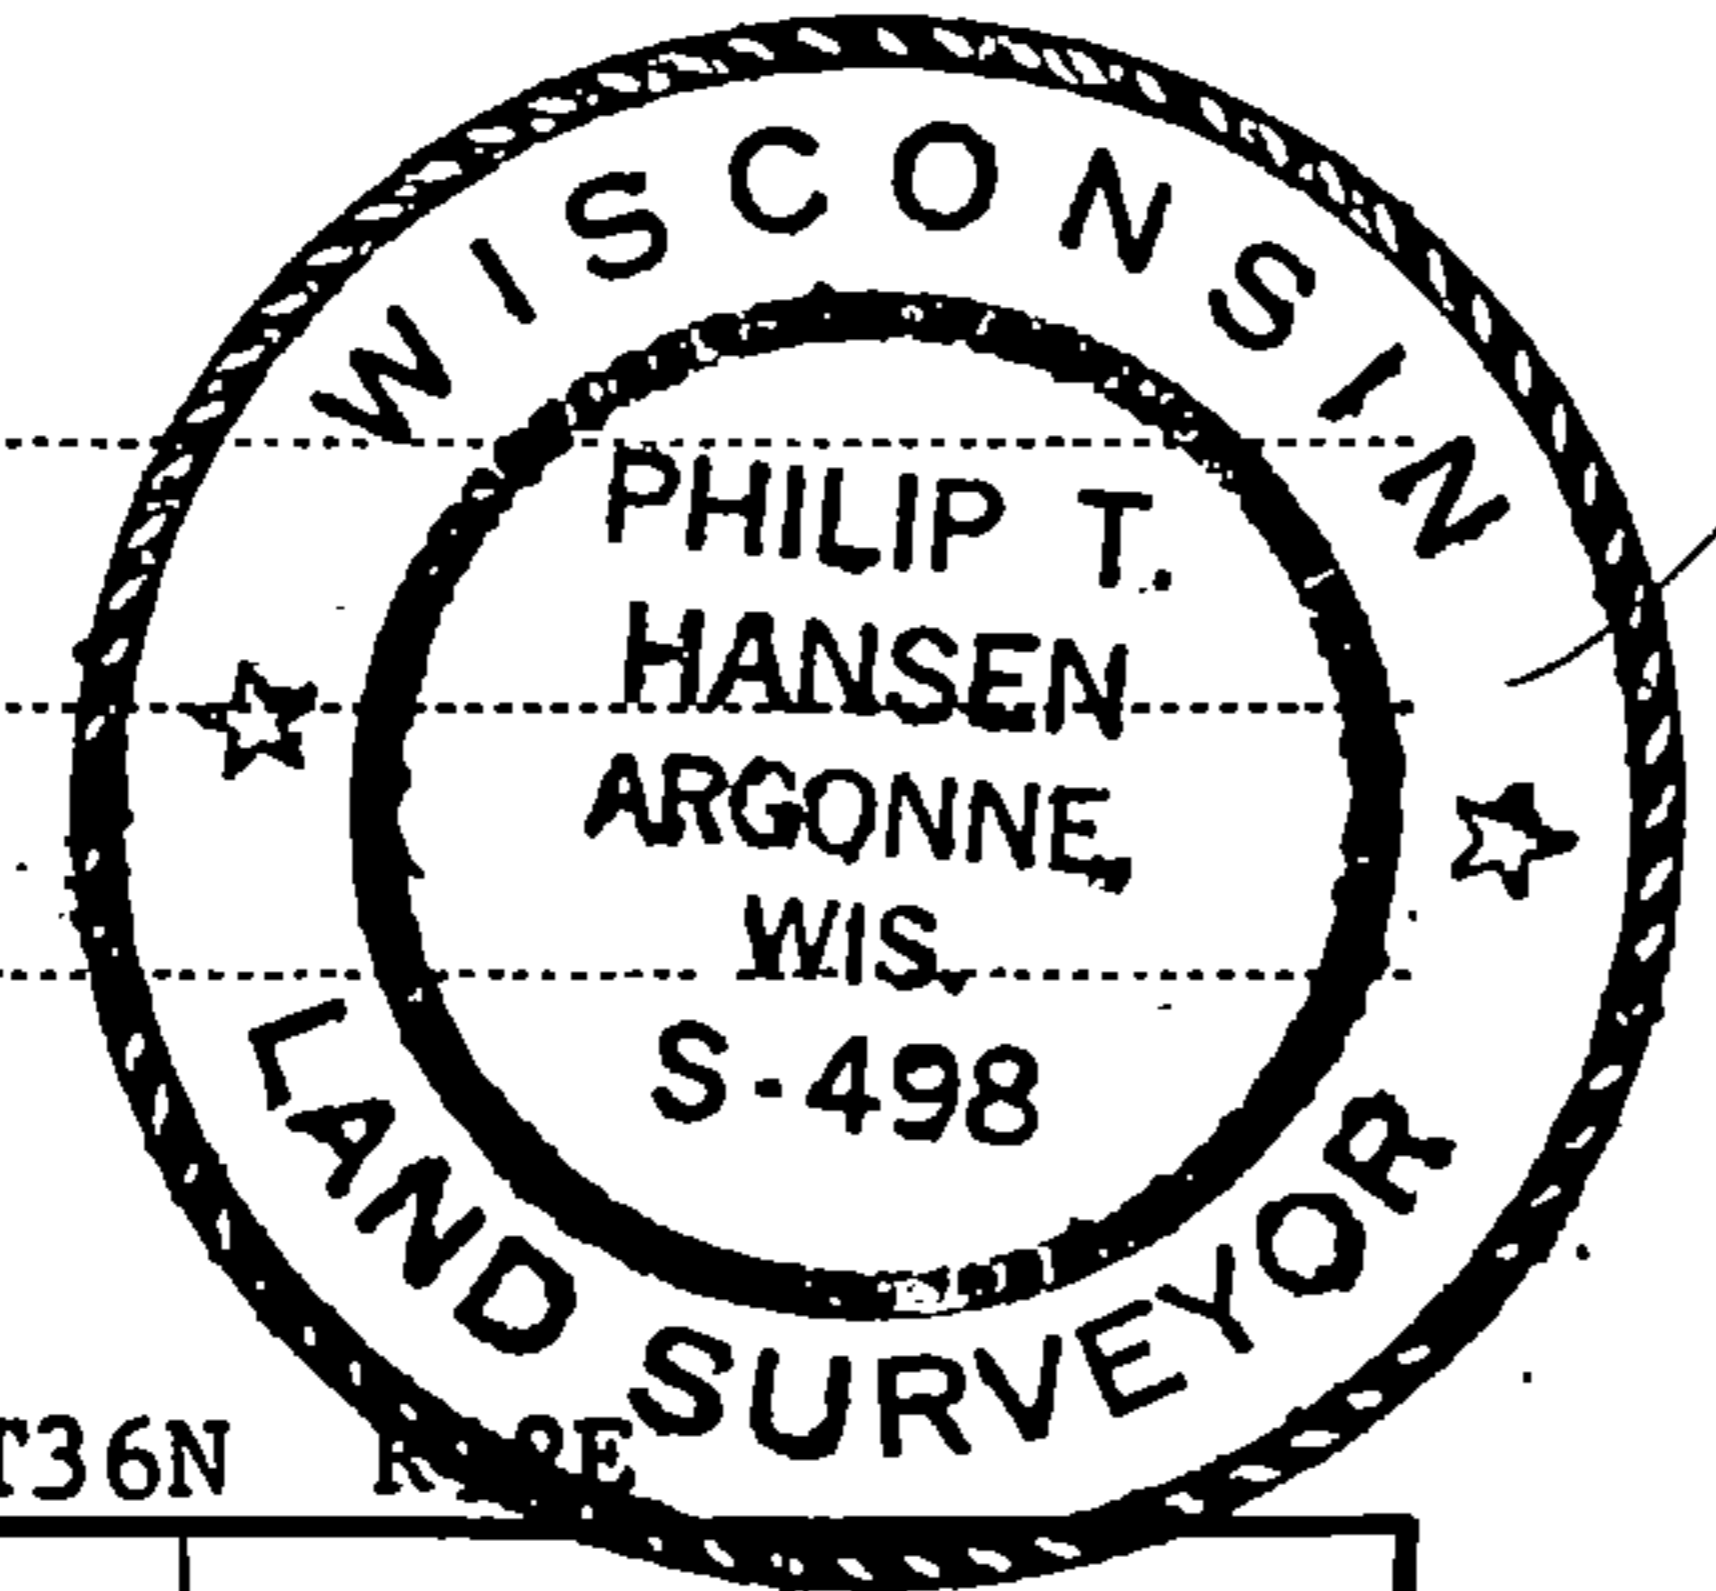

○ = Corner monument restored.

History of original corner establishment:

No records available on previous survey.

Description of corner evidence found:

No evidence of any corner recovered.
Corner established by traverse and computation.
Ran traverse from S 1/4 to N 1/4 and from E 1/4 to West 1/4 to establish C 1/4.
Corner sets S2°12'15"E, 2813.90 from N 1/4.
S84°04'18"W, 2760.03 from E 1/4.
N2°12'15"W, 2676.05 from S 1/4.
N84°04'18"E, 2647.39 from W 1/4.

Description of monument and accessories I established to perpetuate the original location of this corner.

Location of corner is 8' south of centerline of New Highway 8.
Set a 2-1/2" Berntsen A-1 Federal Monument, S2°12'15" E, 150' from C 1/4 corner,
projecting 18", cap stamped:
Set a 1-1/2" x 18" iron pipe, flush with ground, S2°12'15" E, 200 ft.
from C 1/4 corner in the N-S 1/4 line.
Marked NBT's - Sugar 6" N6°W 85.60 feet
Sugar 6" S71°E 8.90 feet
Sugar 5" S3°W 11.98 feet
all scribed C 1/4 BT

S498
T36N R12E
C 1/4 S + 28
N 2° 12' 15" W
150 ft. to Cor
1979

Dated at Rhineland, Wis., this 16th day of May, 1980

Signature Philip T. Hansen Title Registered Land Surveyor Registration No. S-498
(County Surveyor, Registered Land Surveyor, or other duly authorized official)

Office of Register of Deeds, County of Forest, I hereby certify that the within
instrument was filed in this office for record on the 2nd day of June, 1980
at 8:30 o'clock A. M.

Eugene Stutzman
(Register of Deeds)
By _____ Deputy

DOCUMENT NO. **118003**

FORM 985 M. C. MILLER CO., MILWAUKEE

H3612 28 2020