

CERTIFIED LAND CORNER RESTORATION

Index No. V-7

State of Wisconsin }  
County of Forest } ss.



I Philip T. Hansen, do hereby certify that on the 3rd day of May, 1976, I found evidence of the Quarter corner of Sec. 29 and 32 Township 36, North, Range 12 East, Fourth Principal Meridian, as described hereon; and that from this evidence I established a new monument and accessories as described hereon to perpetuate the original location of this corner.

Resident witnesses:

Glen Barker

Jim Claflin

Herb Wagoner

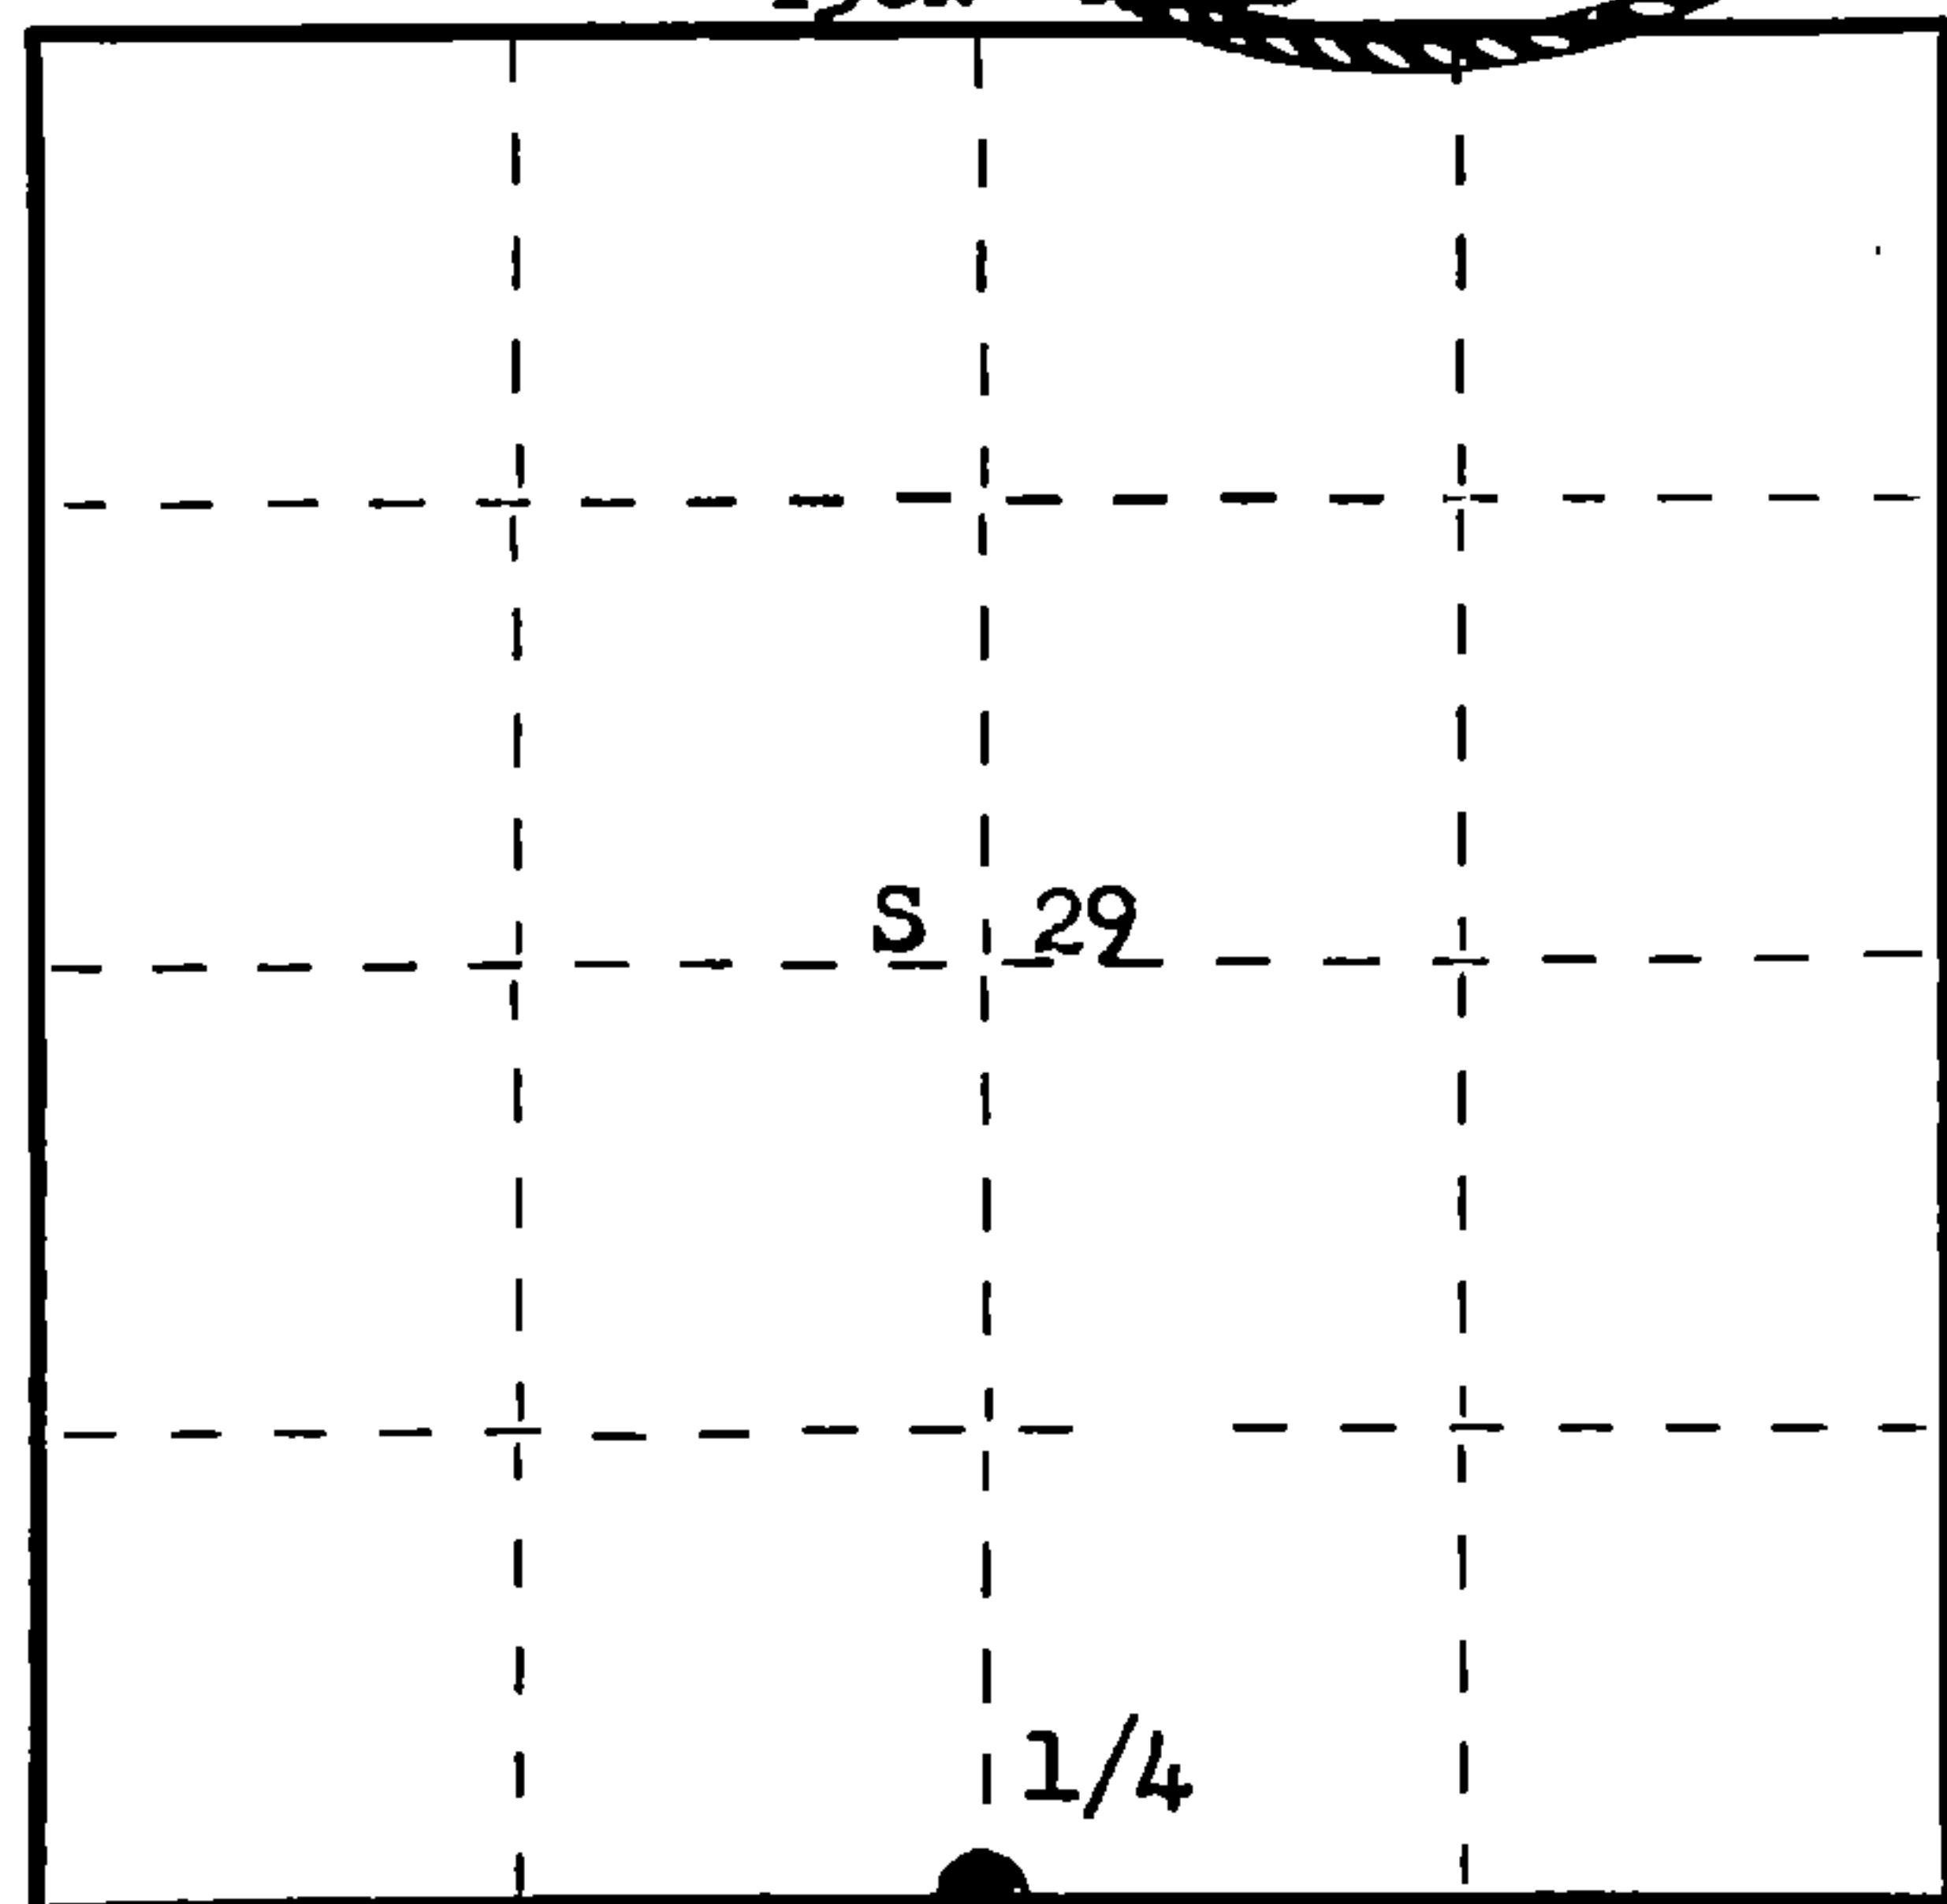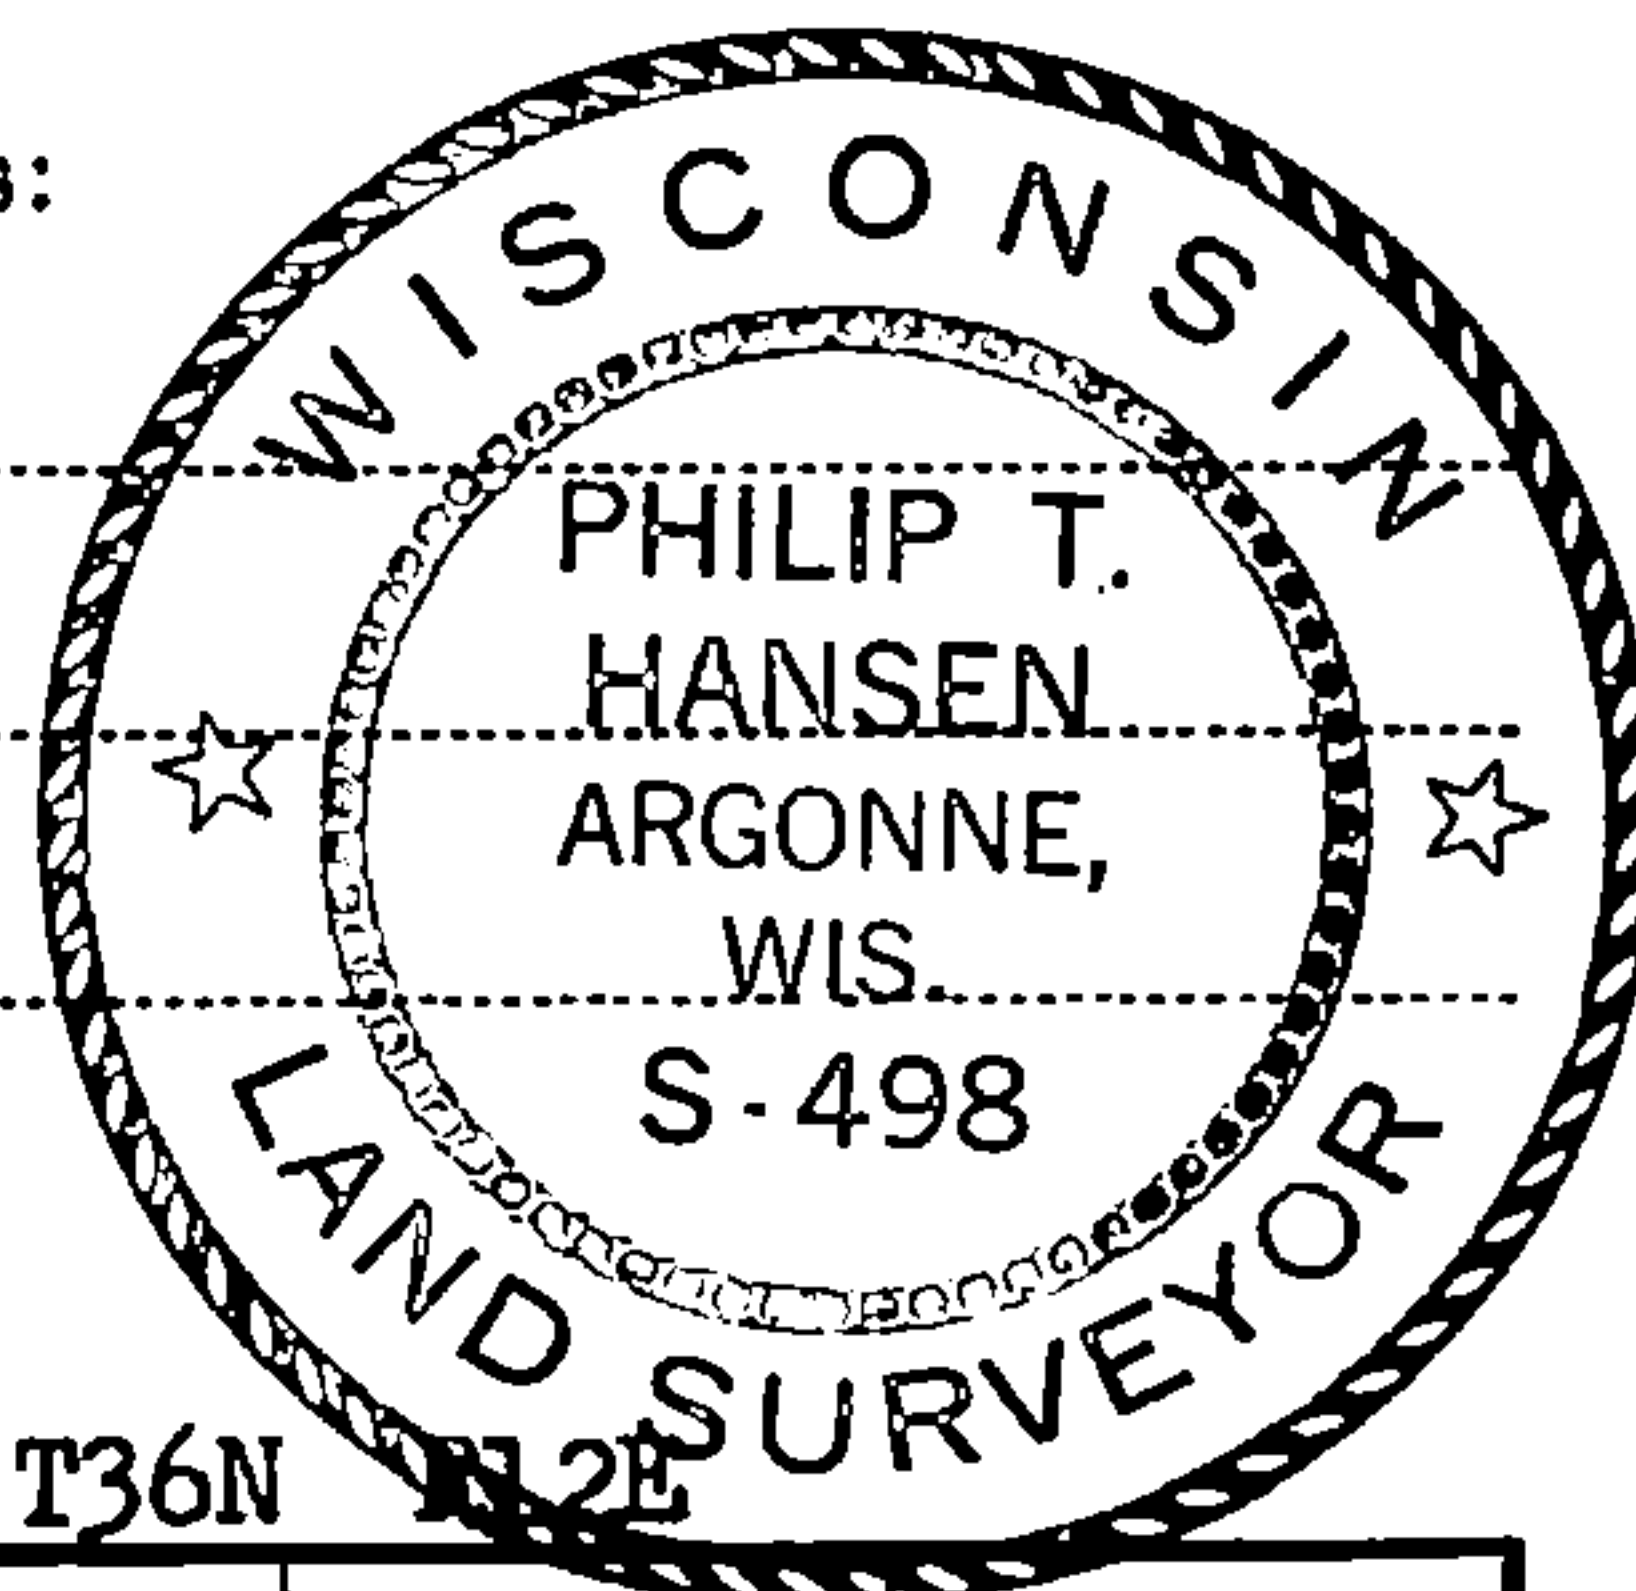

○ = Corner monument restored.

History of original corner establishment: Original corner established by J.L. Nowlin, Deputy Surveyor, in 1859, from which Ironwood 6" bears N12°W 9 lks and Maple 12" bears S27°E 22 lks.

Line ran and corner set by I.R. Ritter, County Surveyor, marked Sugar 5" S50°W 7 lks, survey made in 1921.

Robert Thiel, local resident stated that the State Foresters ran this line about 20 years ago, and they probably found this corner.

Description of corner evidence found: Recovered a 1 1/2" x 3' iron pipe, also a 2" x 6" x 2' stone shaped like arrow head beside the iron pipe.

Recovered a Sugar Maple 12" S54°W 7 lks. It had been chopped out to expose the 1/4S BT scribe marks, approximately 20 years ago.

Recovered Basswood 8" N14°E 23.5 lks. Scribed X BT.

Description of monument and accessories I established to perpetuate the original location of this corner.

Replaced iron pipe with 2 1/2" Berntsen A-1 Federal Monument, cap stamped.

Pipe projects 12" above ground.

NBTs - Sugar 8" N42°W 44 lks, scribed 1/4 BT.

Sugar 6" S52°E 50.8 lks, scribed 1/4 BT.

Sugar 10" S25°W 85.4 lks, scribed 1/4 BT.

Monument and BTs painted blue.

S498  
T36N R12E  
1/4 S | 29  
S | 32  
1976

Dated at Rhineland, Wis., this 24th day of May, 1976.

Signature Philip T. Hansen Title Registered Land Surveyor Registration No. S-498  
(County Surveyor, Registered Land Surveyor, or other duly authorized official)

Office of Register of Deeds, County of Forest, I hereby certify that the within instrument was filed in this office for record on the 9th day of June, 1976 at 3:30 o'clock P. M.

DOCUMENT NUMBER -- **109400**

Eugene Stutzman  
(Register of Deeds)  
By..... Deputy

FORM 985

43612-290020