

CERTIFIED LAND CORNER RESTORATION

Index No. T-5


State of Wisconsin }
County of Forest } ss.

I Milo E. Stefan, do hereby
certify that on the 14th day
of December, 1993, I found
evidence of the 1/4
corner ~~88~~ to Sections 29 & 30
Township 36, North, Range
12 East, Fourth Principal Meridian,
as described hereon; and that from this evidence
I established a new monument and accessories
as described hereon to perpetuate the original
location of this corner.

Resident witnesses:

Myron Smith

Charles Blomdahl

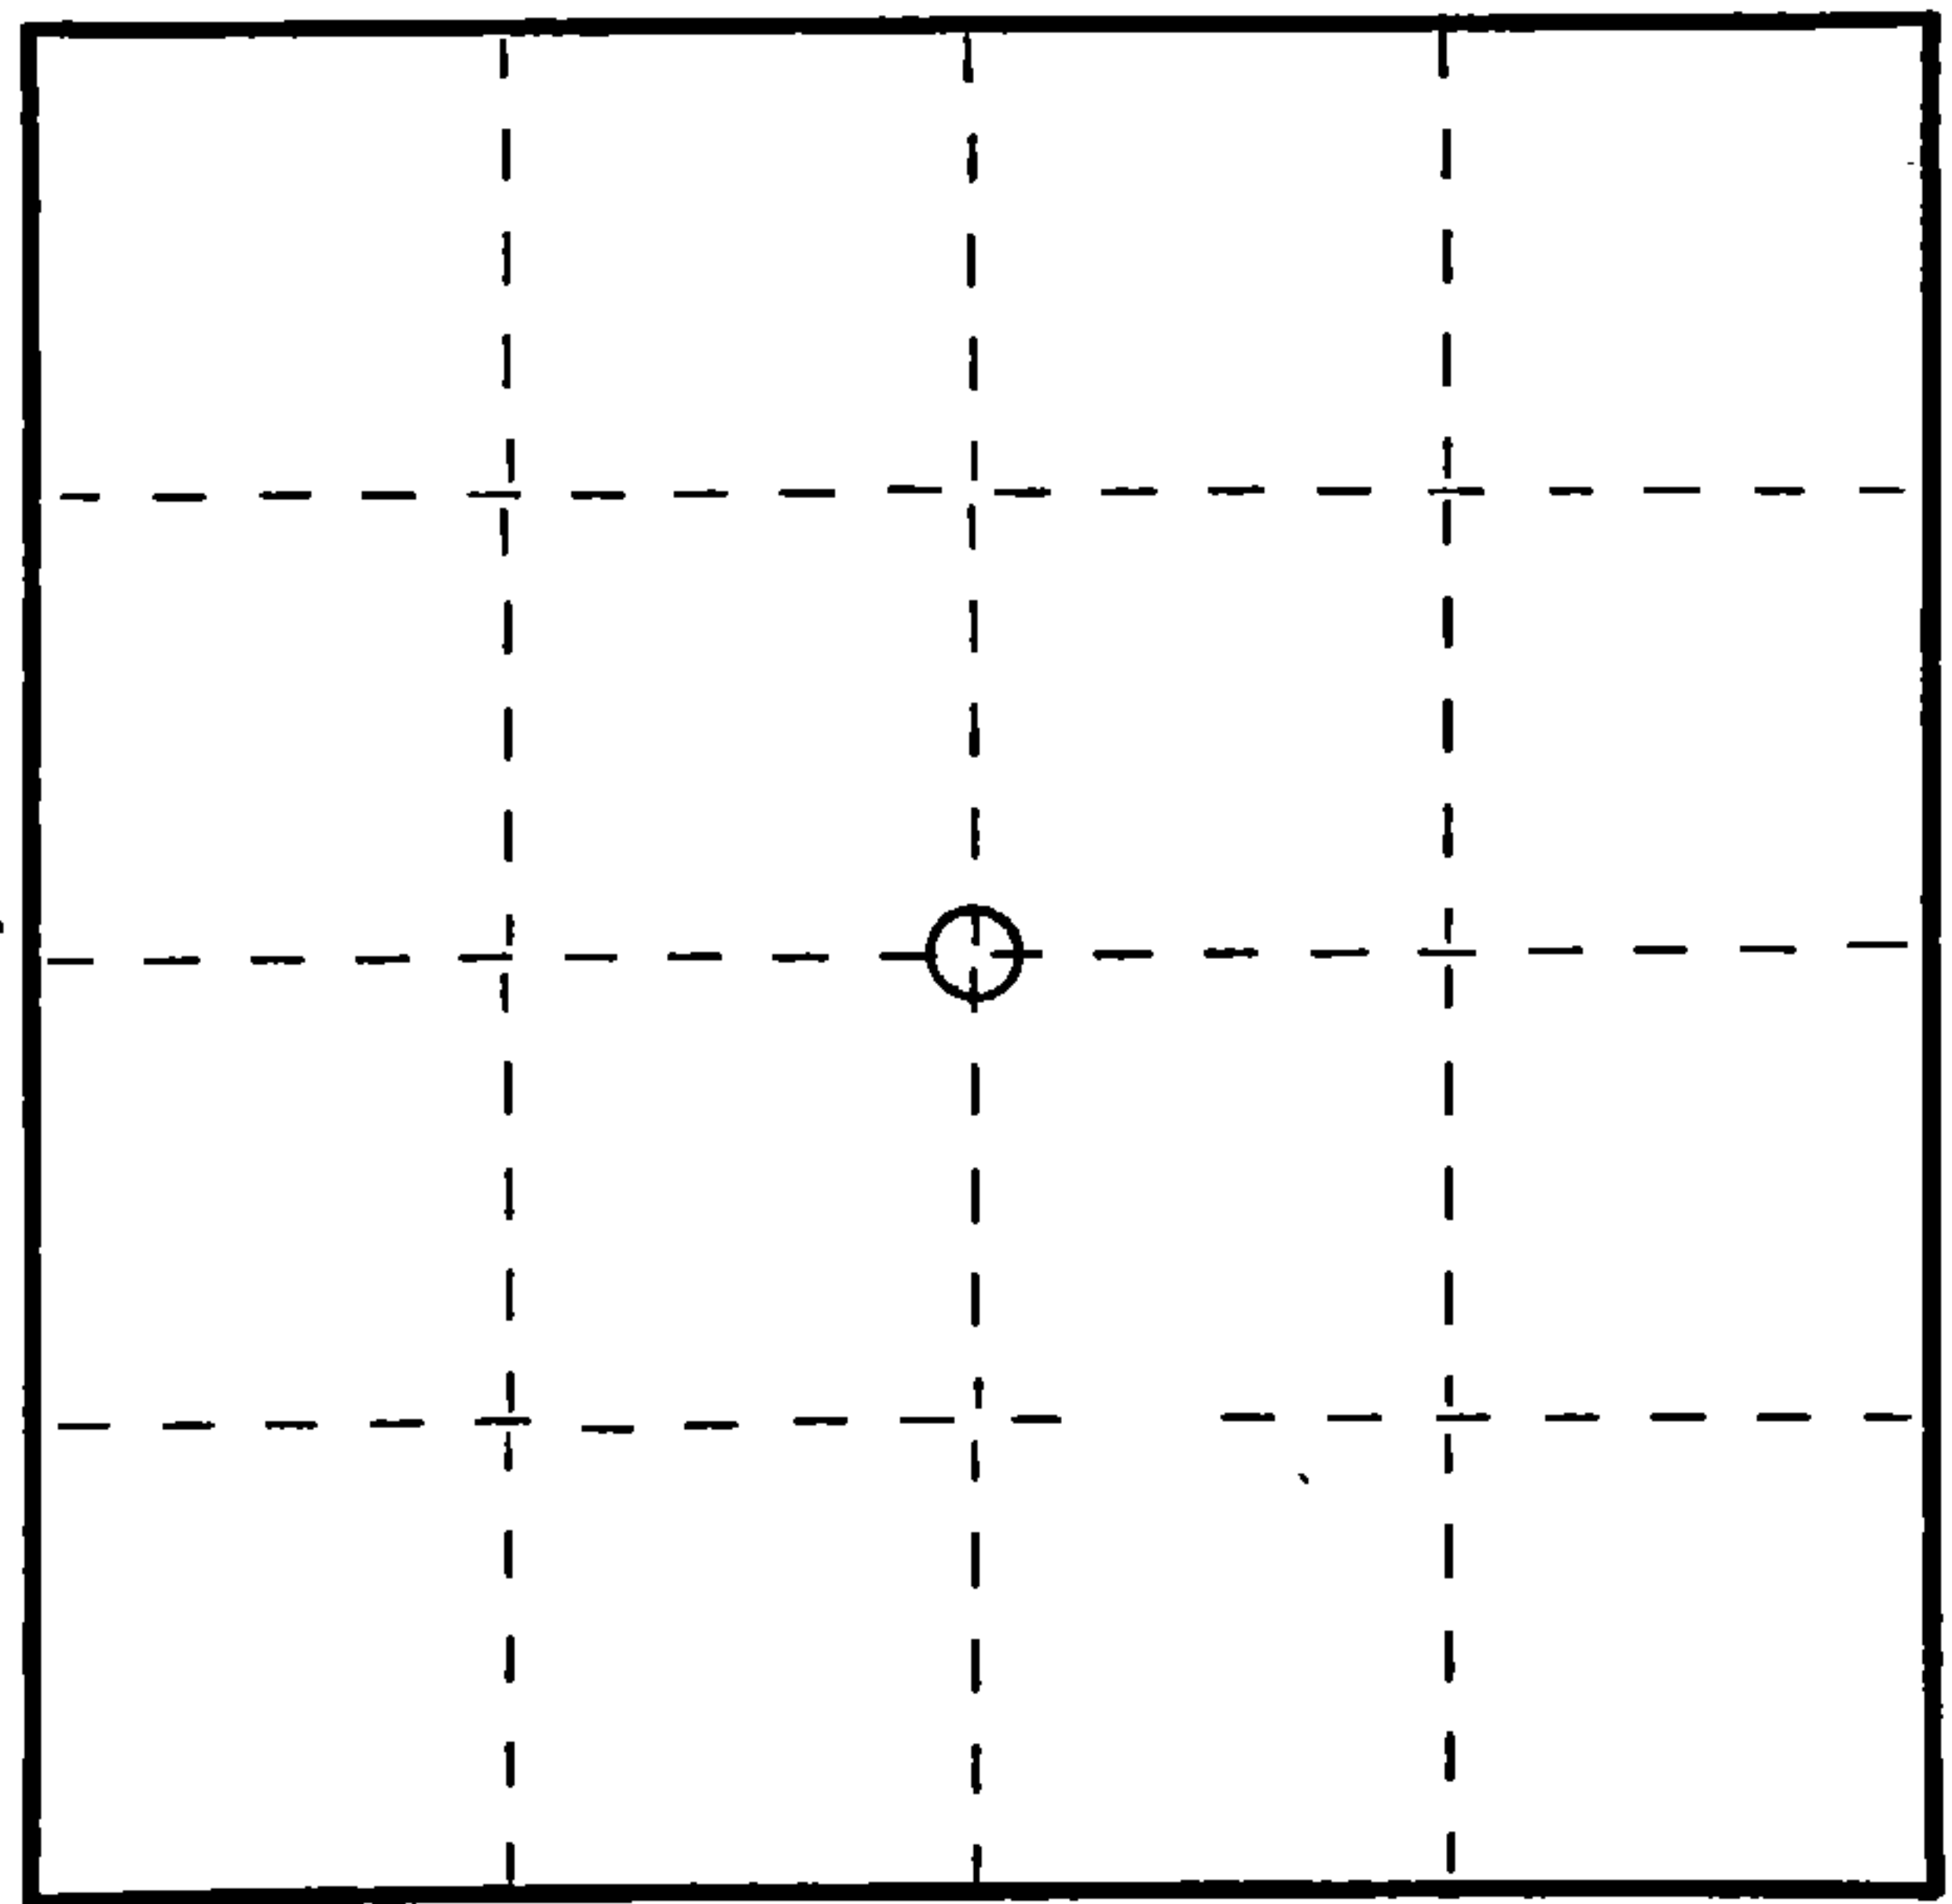


○ = Corner monument restored.

History of original corner establishment: By James L. Nowlan, 8/8/1859, at 40.00 Chains set
1/4 Section Post/two BTs:
9" White Pine, S57°E, 36 Lks (Found by Ritter 5/2/1921)
10" White Pine, N34°W, 90 Lks

Description of corner evidence found:
May 2, 1921 - I.R. Ritter's "Record of Survey" as filed with the Forest County Register of
Deeds indicates he found evidence of this corner and made a new BT: 12" Pine, N58°E, 16 Lks.
D.O.T.'s Route Survey of Highway "8" (Project #F.O. 21-3 [17]) calls this corner in centerline
of town road North and 135' North of centerline of this project.
12/14/1993 - We found corner marked by a railroad spike.

Description of monument and accessories I established to perpetuate the original location of this corner.
We set a 1" x 24" aluminum monument as a reference monument, N5°W, 188.61 feet with four
new BTs:
14" Red Pine, S45°W, 333.96 Feet
18" White Spruce, N5°W, 191.03 Feet
Power Pole #3612-29W5, N60°E, 48.15 Feet
Power Pole #3612-29L6, S7°E, 171.95 Feet

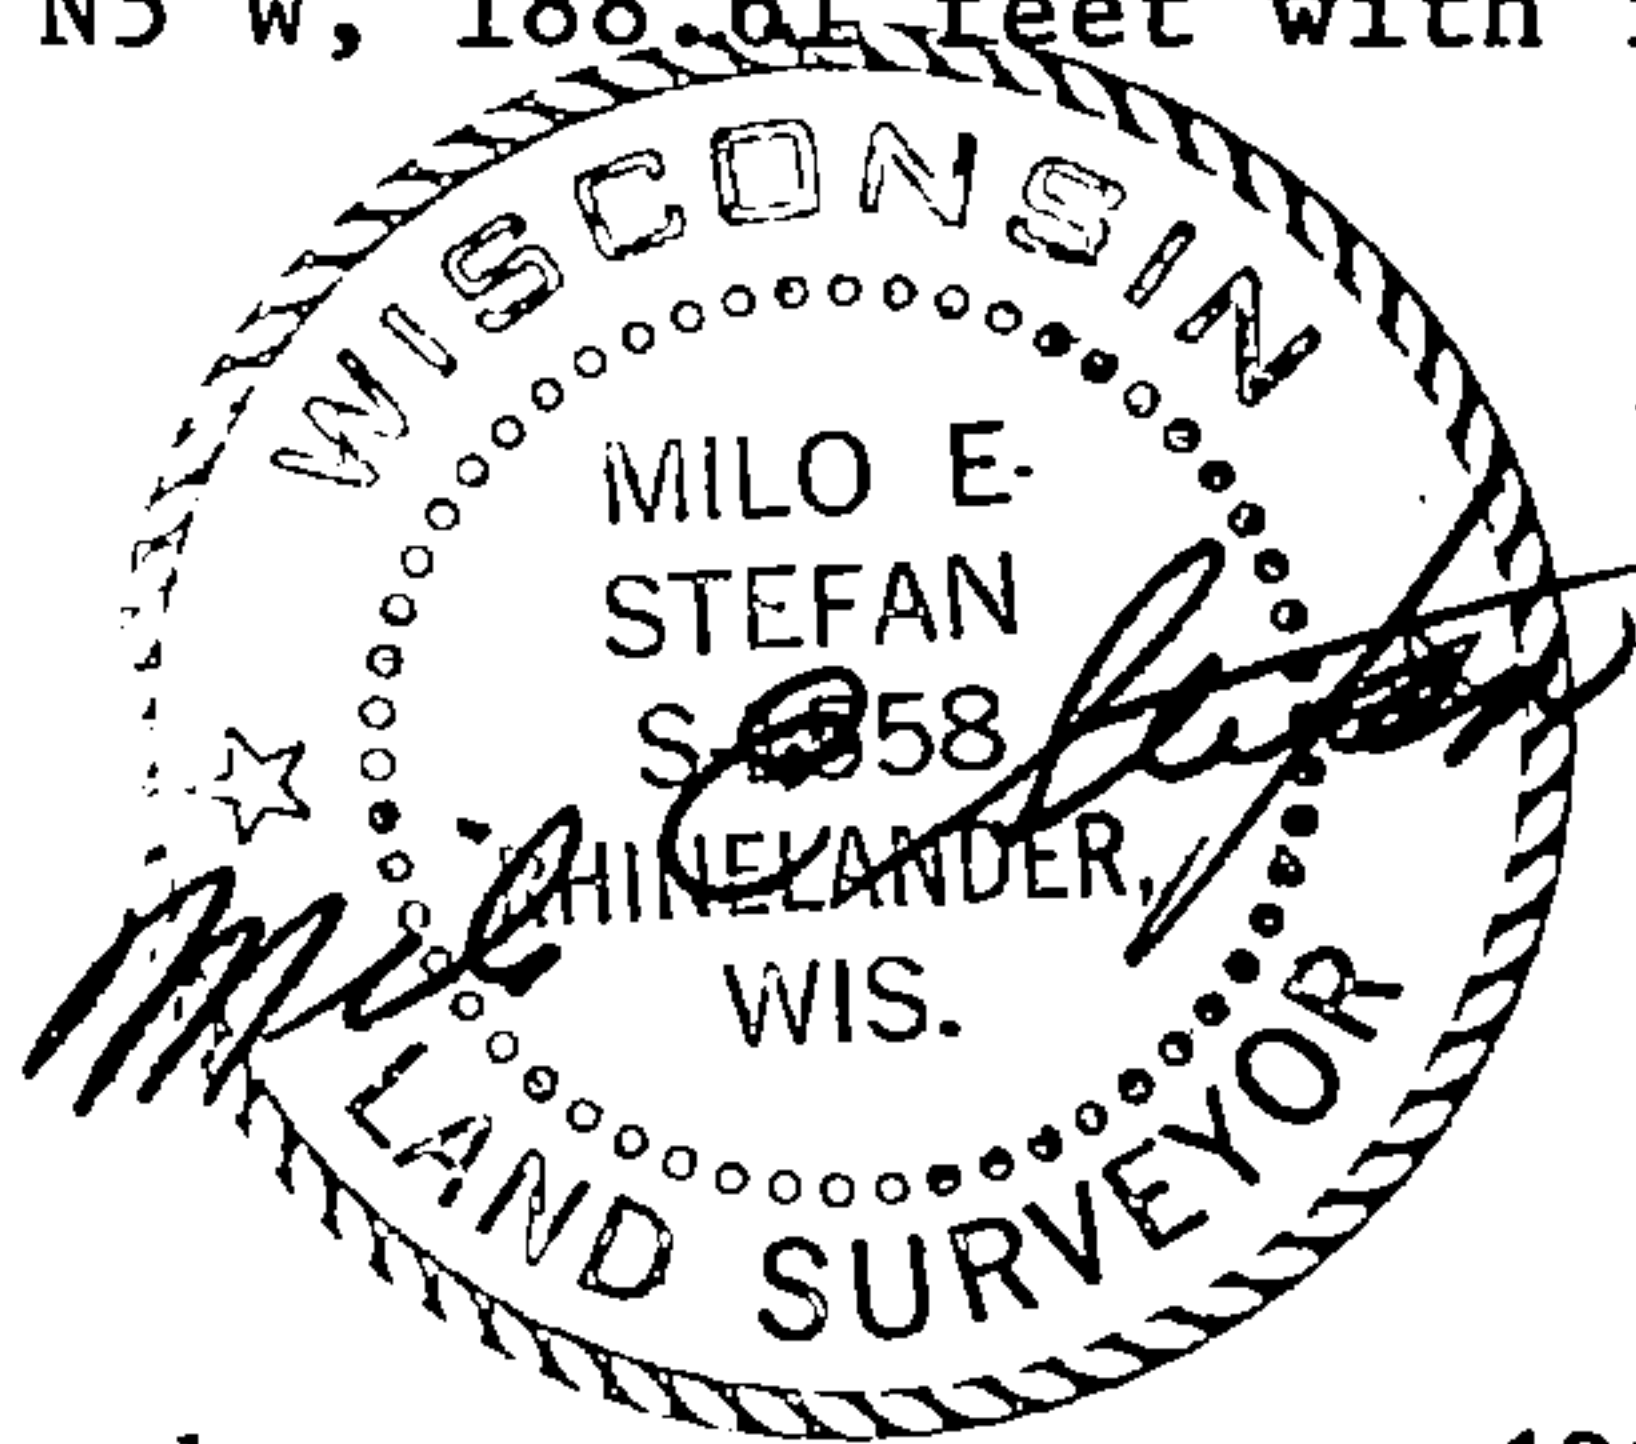

S. 29 Dated at Rhineland, Wis., this 30th day of December, 1993

Signature Milo E. Stefan Title Registered Land Surveyor Registration No. 1558
(County Surveyor, Registered Land Surveyor, or other duly authorized official)

Office of Register of Deeds, County of Forest, I hereby certify that the within
instrument was filed in this office for record on the 7th day of FEBRUARY, 1994
at 1:30 o'clock P. M.

Paul Ackermann
(Register of Deeds)

By Deputy

DOCUMENT NUMBER
149579

FORM 985 H. C. MILLER CO., MILWAUKEE

43612302000

- (e) Describe any material discrepancy between the location of the corner as restored or reestablished and the location of that corner as previously restored or reestablished by distance and direction. Show the discrepancy on the plan view drawing under (d), above. Show the distances between the corner as previously restored or reestablished and (1) the corner as restored or reestablished, and (2) to at least 2 of the witness monuments shown on the drawing in (d), above.

N/A

- (f) Was the corner restored through acceptance of (1) an obliterated evidence location, or, (2) a found perpetuated location?

(2) a found perpetuated location

- (g&h) Was the corner reestablished through lost corner proportionate methods? If so, show the method, including the directions and distances to other public land survey corners used as evidence or used for proportioning in determining the corner location?

N/A

- (i) I, Milo E. Stefan
(type or print name) certify that the corner location shown on this record was determined by me or under my direction and control and that this U.S. Public Land Survey Monument Record is correct and complete to the best of my knowledge and belief.

Milo E. Stefan
Signature

12/30/93
Date

