

CERTIFIED LAND CORNER RESTORATION

Index No. A-5

State of Wisconsin }  
County of Forest } ss.


I, Philip T. Hansen, do hereby certify that on the 14th day of May, 1976, I found evidence of the Section corner of 31 - 32 - 5 and 6 Township 35 - 36, North, Range 12 East, Fourth Principal Meridian, as described hereon; and that from this evidence I established a new monument and accessories as described hereon to perpetuate the original location of this corner.

Resident witnesses:


Glen Barker

Jim Claflin

Herb Wagoner

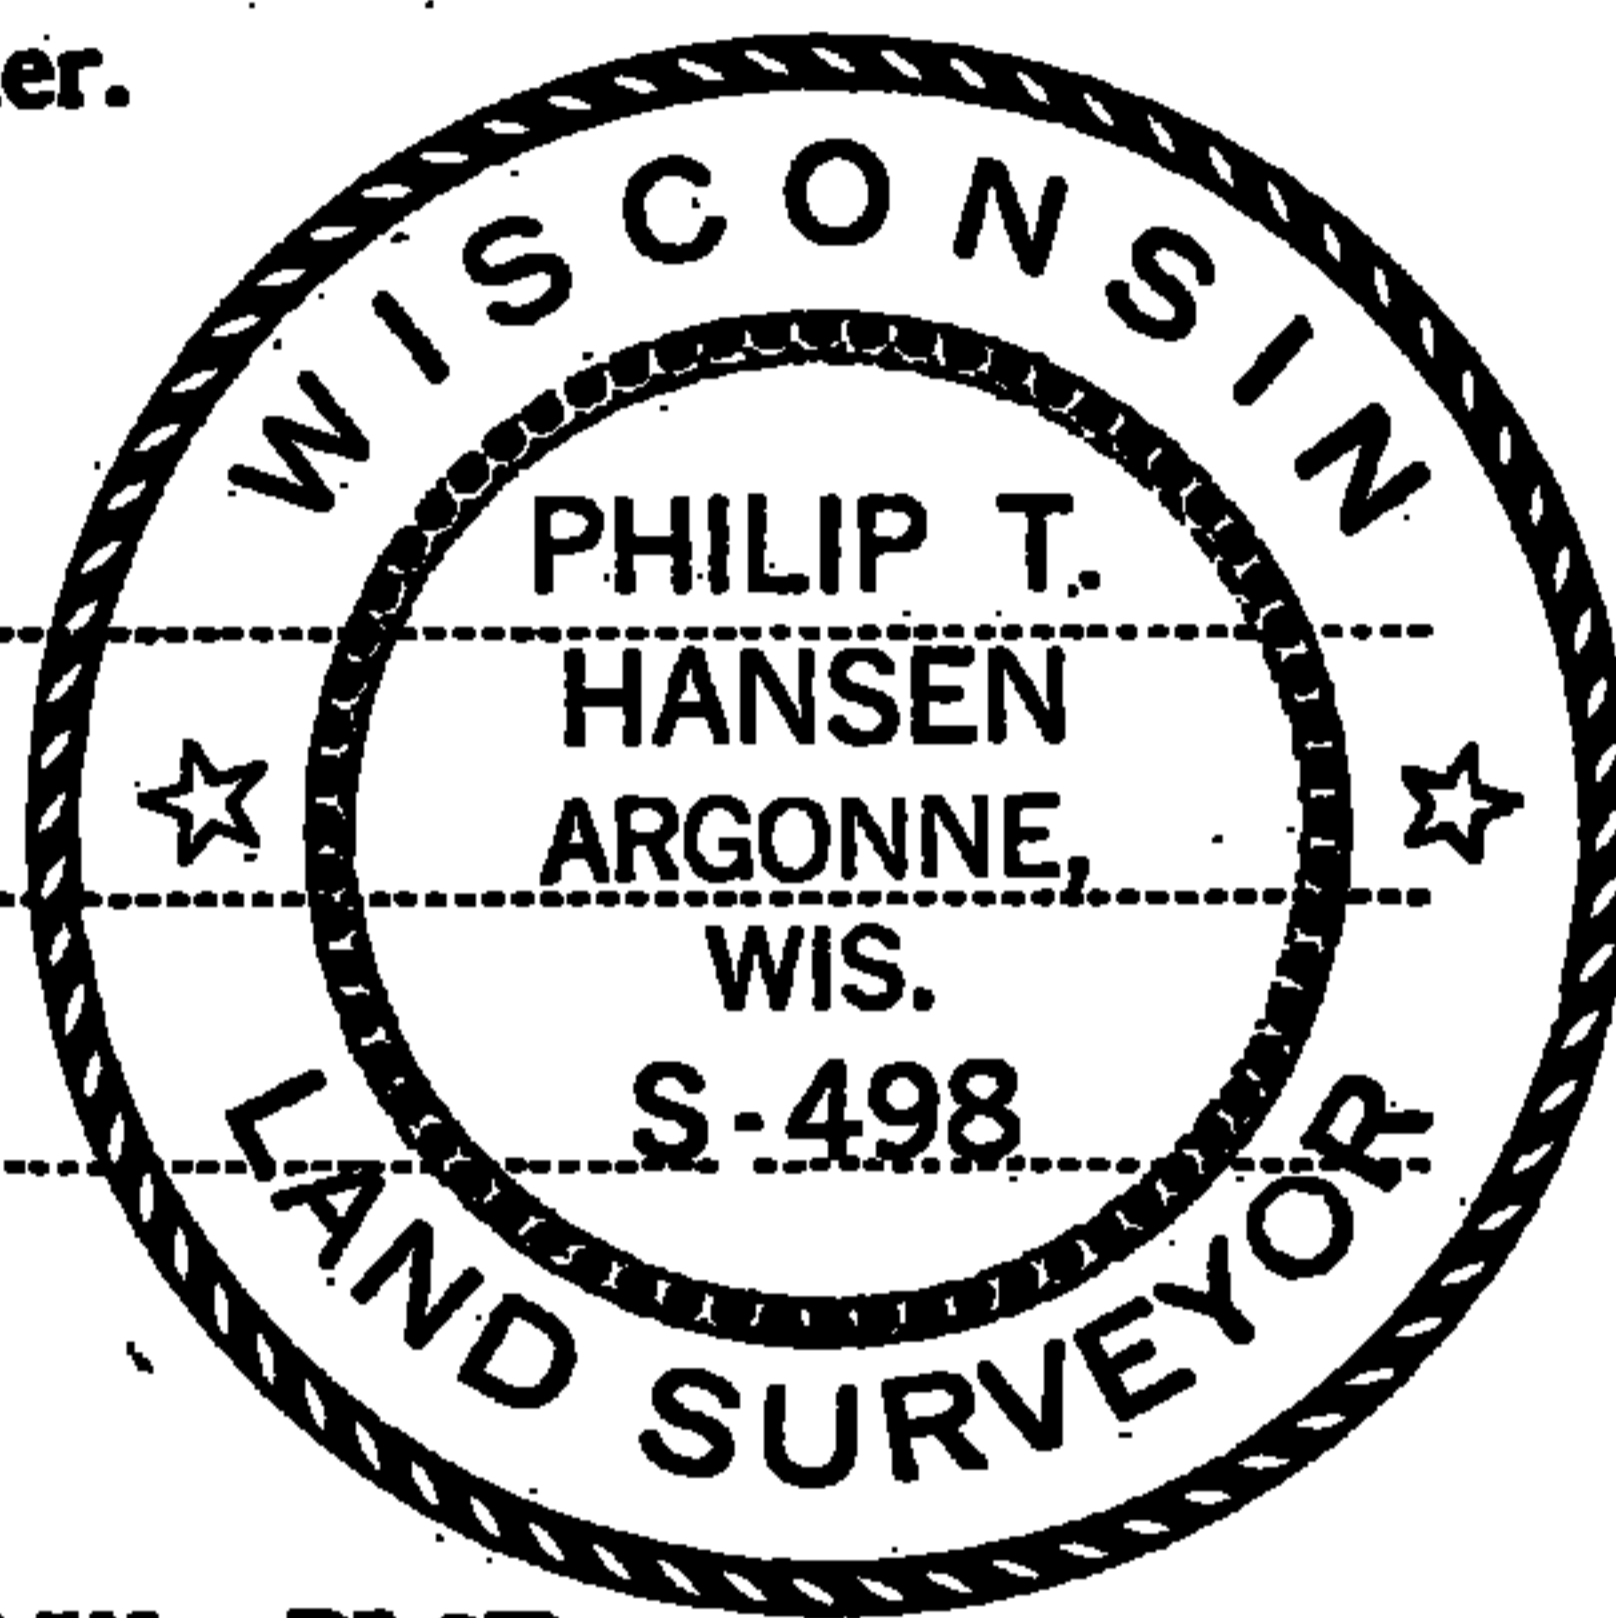

FORM 985

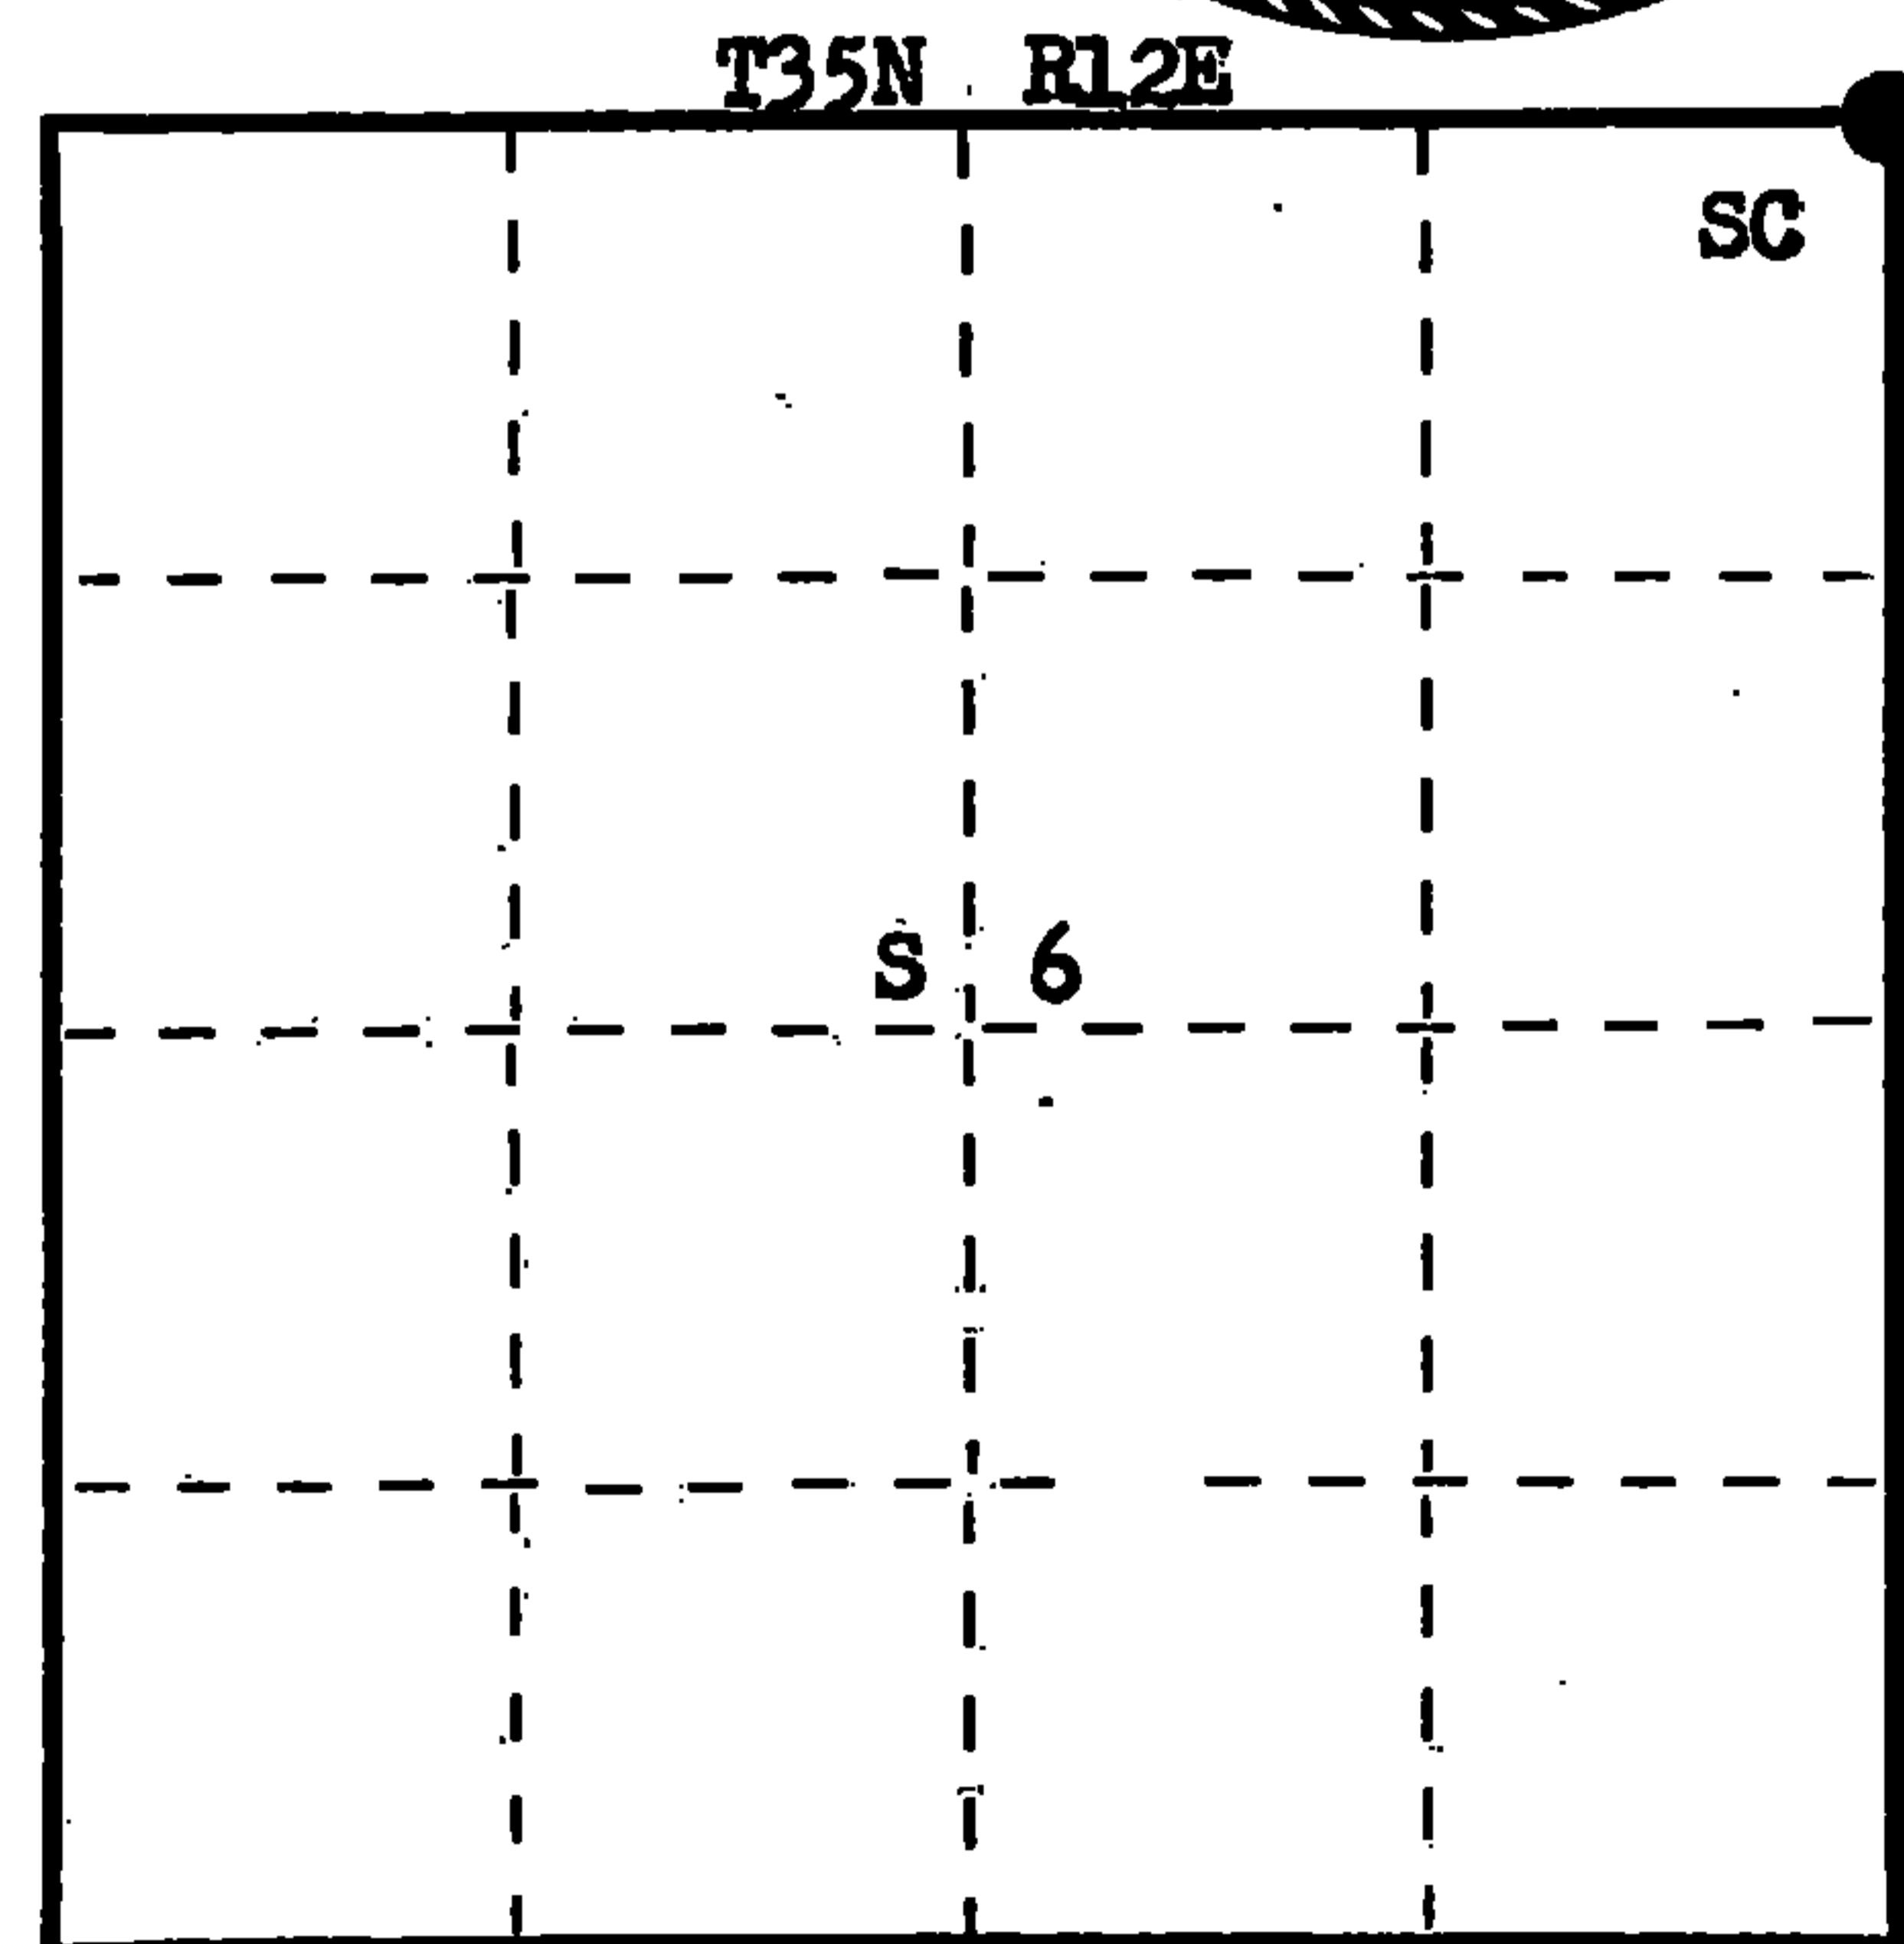

○ = Corner monument restored.

History of original corner establishment: Corner established by H.C. Fellows, Deputy Surveyor, in 1858, from which Spruce 8" N88°W 42 lks, Spruce 5" S10°E 10 lks, Spruce 5" N25°E 65 lks E.R. Cole, adjacent and local land owner states that this corner sets in the center line of Cole road (section line) and on the North edge of an old E-W town road. The town of Nashville built this road in the 1920's for S.H. Howard, an early settler, who owned the NW-NE, Section 6. Senator Cole, who owned the land north of the line, and Howard had the E-W line surveyed between the E 1/16 and 1/4 corner and the fence was built on this line. The road was then built, south of the line fence, in the town of Nashville. The old fence line on the north line of section line road is in direct alignment with old fence line.

Description of corner evidence found:

Found the alignment of fences mentioned above.

Description of monument and accessories I established to perpetuate the original location of this corner.

Drove a RR spike in center of Cole road, in line with old fence line. Set a 2 1/2" Berntsen A-1 Federal Monument, N60°W 90 lks for Witness Monument.

Pipe projects 2' above ground. Cap stamped.

NBTs - W.M. - 1 1/2" iron pipe w/2" brass cap. W/C W.75 lks.

Tamarack 8" S64°W 145.5 lks, scribed SC BT.  
Measurements and bearings to true corner

S498  
T36N R12E  
Sec. 31 | 32 W.C.  
      6 | 5  
T35N R12E  
S60°E 90 lks  
1976

Dated at Rhineland, Wis., this 24th day of May, 1976

Signature Philip T. Hansen Title Registered Land Surveyor Registration No. S-498  
(County Surveyor, Registered Land Surveyor, or other duly authorized official)

Office of Register of Deeds, County of Forest, I hereby certify that the within instrument was filed in this office for record on the 9th day of June, 1976 at 3:30 o'clock P. M.

DOCUMENT NUMBER **109399**

Eugene Stutzman  
(Register of Deeds)  
By \_\_\_\_\_ Deputy

43612310000