

CERTIFIED LAND CORNER RESTORATION

Index No. W-5

State of Wisconsin }
County of Forest } ss.


I Philip T. Hansen, do hereby certify that on the 9th day of August, 1976, I ~~found~~ ^{established} ~~existence of~~ the N 1/16 corner of Section 31 and 32 Township 36, North, Range 12 East, Fourth Principal Meridian, as described hereon; and that from this evidence I established a new monument and accessories as described hereon to perpetuate the original location of this corner.

Resident witnesses:


Glen Barker

Jim Claflin

Herb Wagoner

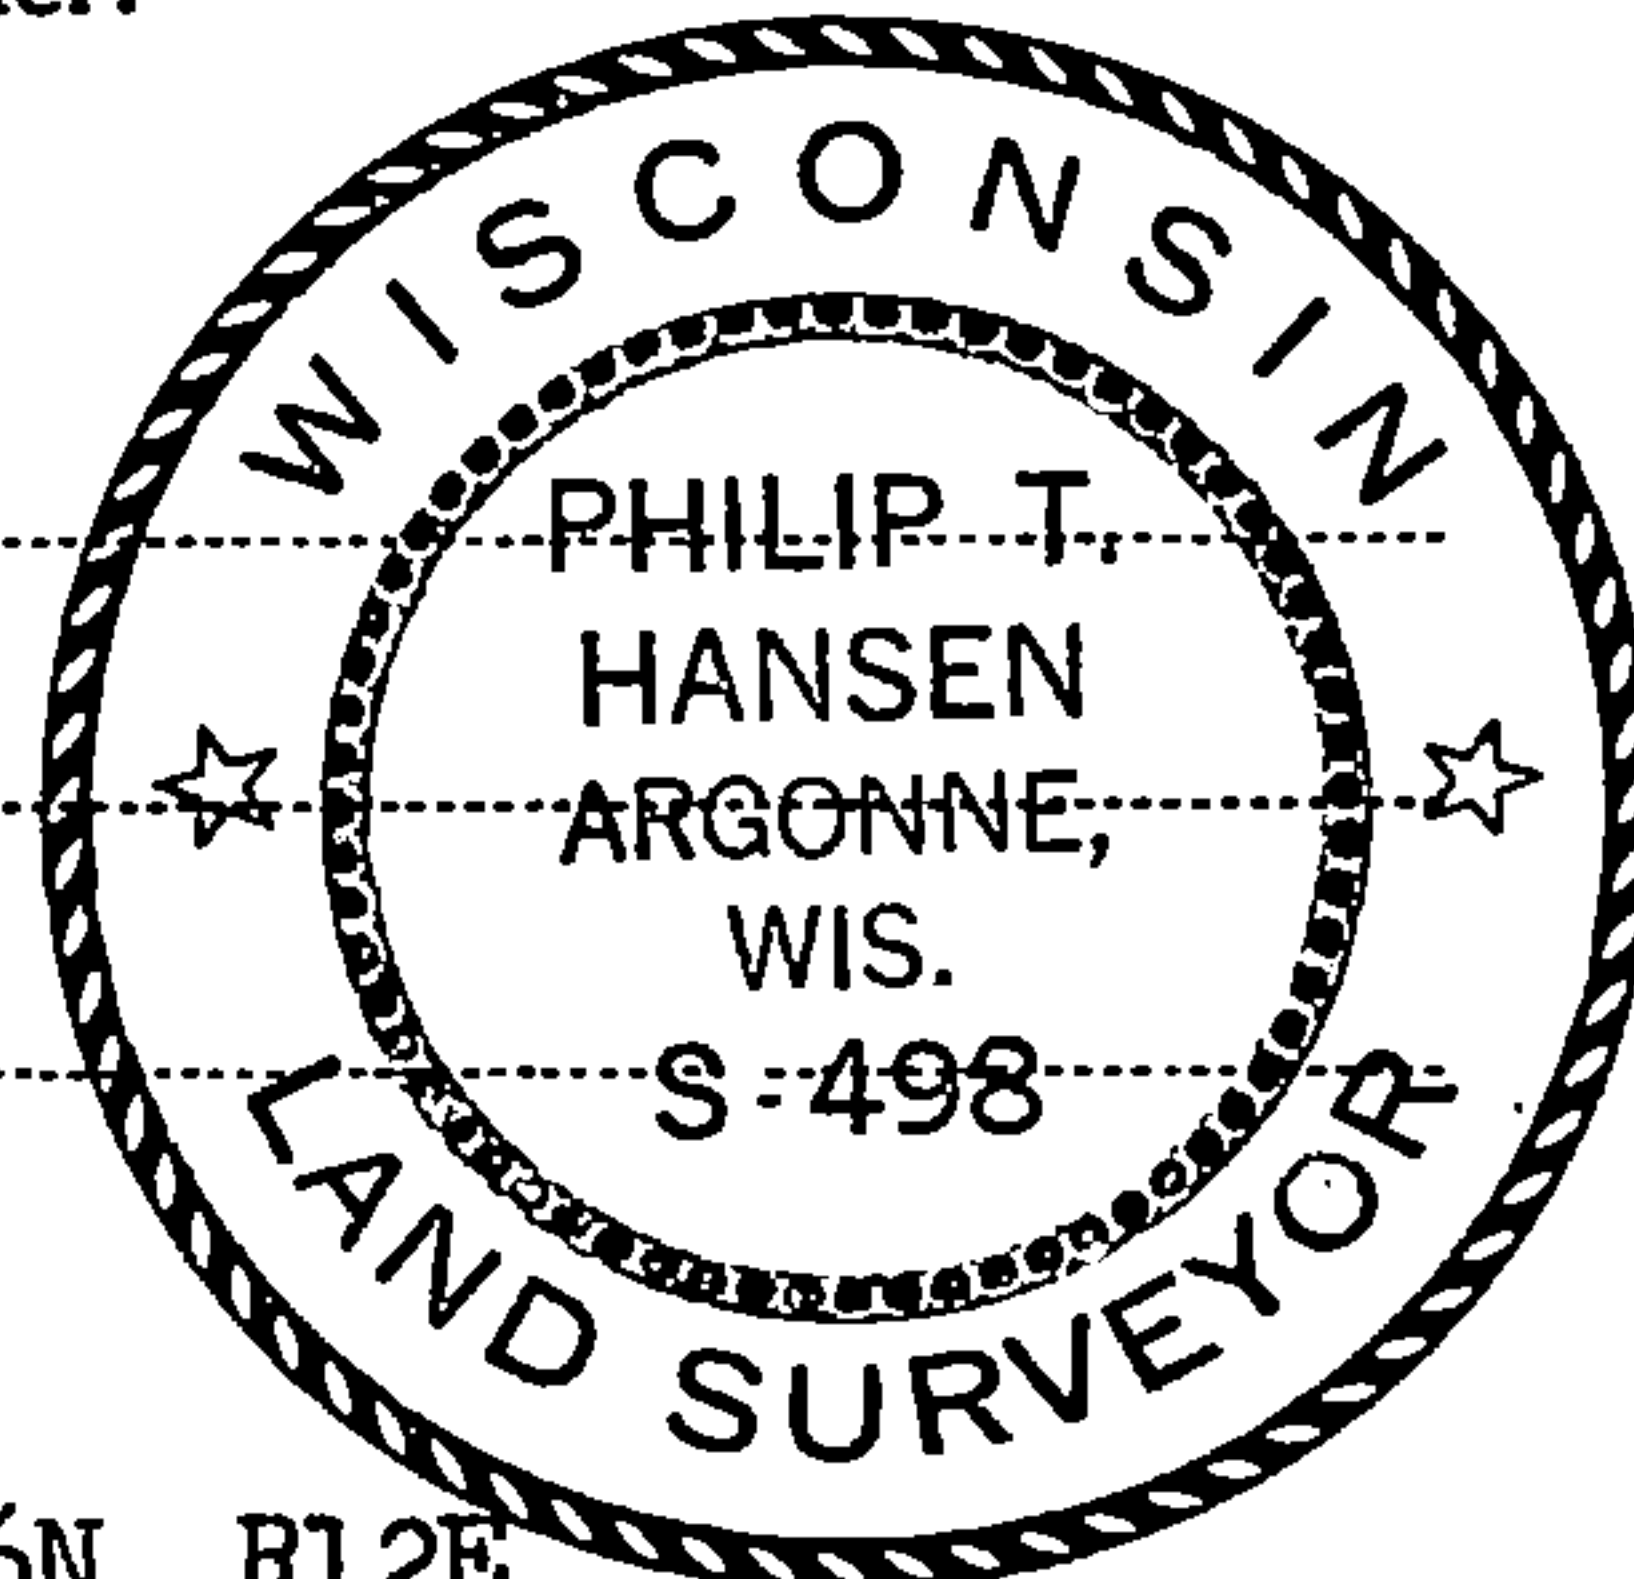

FORM 985 W. G. MILLER CO., MILWAUKEE

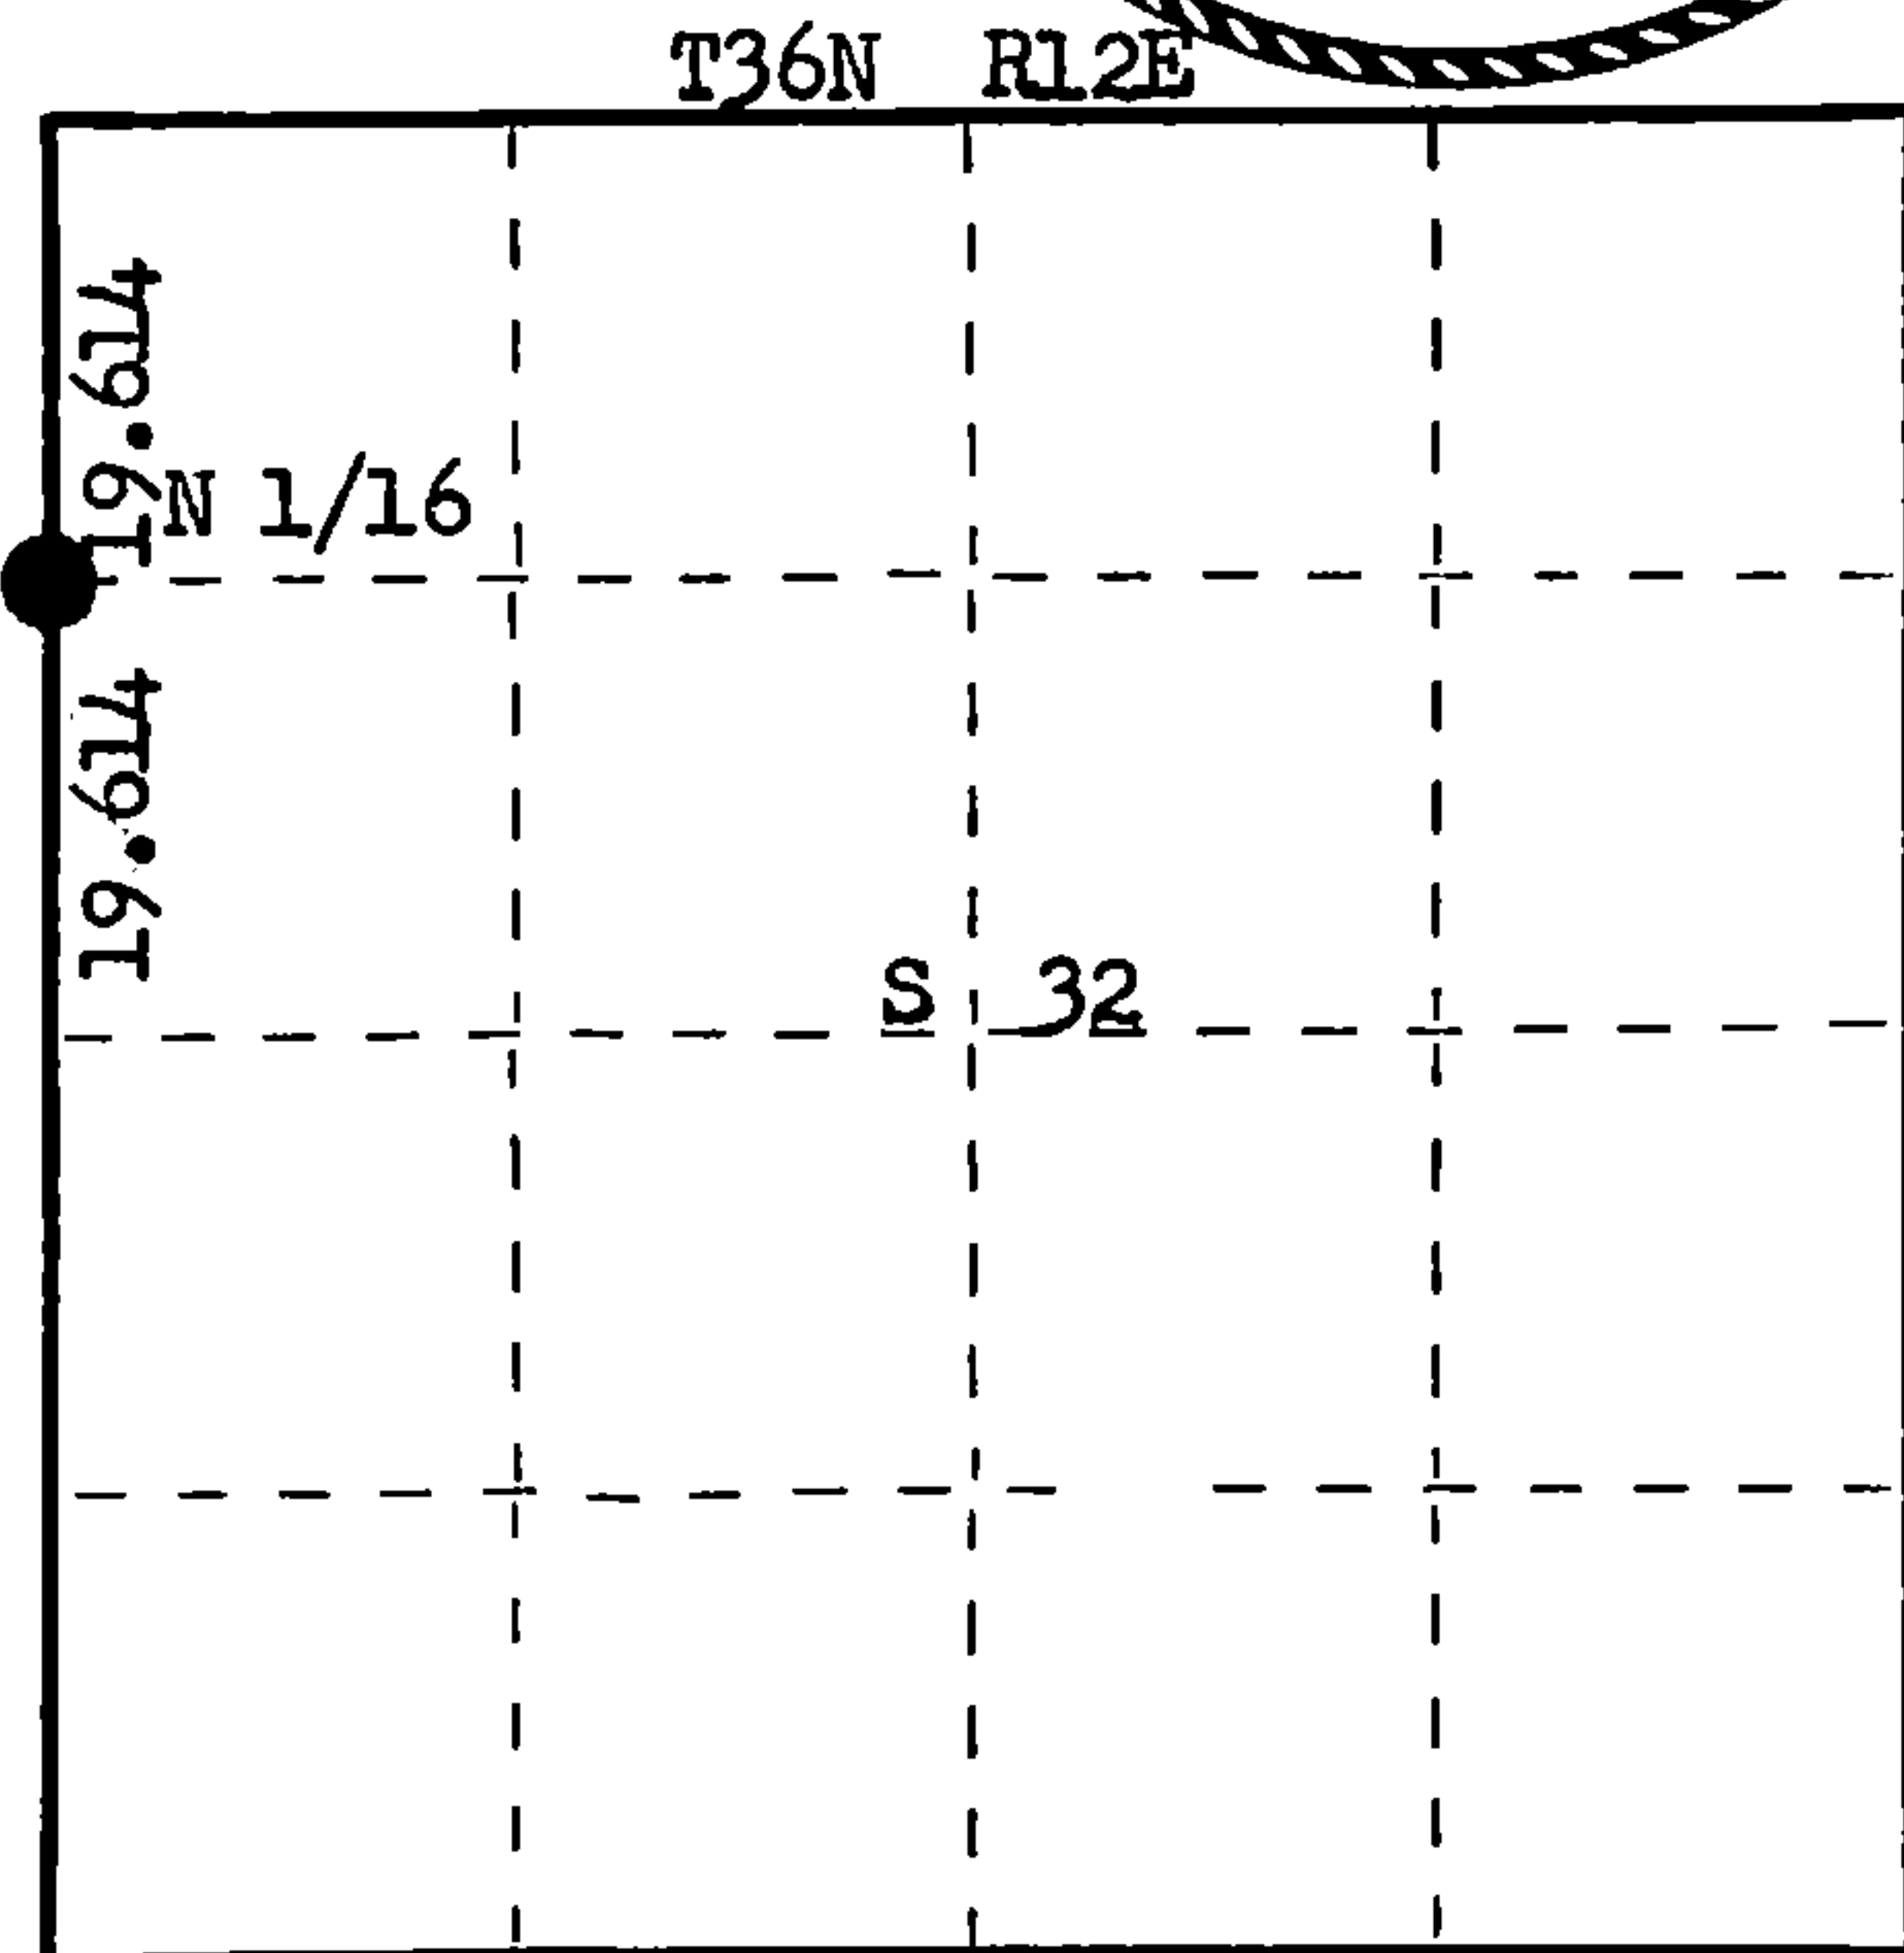

○ = Corner monument restored.

History of original corner establishment:

No evidence of any corner remaining. E.R. Cole, local and adjacent land owner, remembers the corner being in a number of years ago, but was unable to identify exact point, area having been bulldozed for operation of gravel pit.

Description of corner evidence found: Corner established by proportion measurement by traverse run between established 1/4 corner and Section Corner Sec. 29, 30, 31 and 32. Computed distance between Corners 39,229 chains at bearing N 1° 56' 49" W. Established Corner on line, equidistant at 19.614 chains. Point fell 3 lks South of old E-W fence line and approximately 4 chains west of Cole Road.

Description of monument and accessories I established to perpetuate the original location of this corner.

Set 1 1/2" iron pipe with 2" brass cap for Corner. Cap stamped.

Monument projects 18" above ground.

NBTs - Sugar 8" N 86° W 1.286 chs, scribed 1/16 BT.

Sugar 10" N 69° W 1.698 chs, scribed 1/16 BT.

Monument and BTs painted blue.

S498
T36N R12E
N 1/16 31 | 32
CPI-1976

Dated at Rhineland, Wis., this 10th day of August, 1976.

Signature Philip T. Hansen Title Registered Land Surveyor Registration No. S-498
(County Surveyor, Registered Land Surveyor, or other duly authorized official)

Office of Register of Deeds, County of Forest, I hereby certify that the within instrument was filed in this office for record on the 8TH day of September, 1976 at 10 o'clock A. M.

Eugene Stetson
(Register of Deeds)
By _____ Deputy

DOCUMENT NUMBER **110111**

43612313000