

CERTIFIED LAND CORNER RESTORATION

Index No. **Z-8**

State of Wisconsin }  
County of Forest } ss.

History of original corner establishment:

No record of any previous survey or Corner established.

I Philip T. Hansen, do hereby certify that on the 28th day of June, 1976, I ~~found~~ <sup>established</sup> ~~corner~~ of the E 1/16 corner of Section 5 and 32 Township 35 and 36, North, Range 12 East, Fourth Principal Meridian, as described hereon; and that from this evidence I established a new monument and accessories as described hereon to perpetuate the original location of this corner.


Description of corner evidence found: Searched for, but found no evidence of Corner. Established Corner by proportionate measurement between Section Corner 32 - 33, 5 and 4 and Section Corner 31, 32, 5 and 6. Ran traverse between established corners, total computed distance 79.907 chains bearing S 89° 08' 55" W. Set corner equidistant between established 1/4 Corner and Section Corner 19.974 chains.

Resident witnesses:

Glen Barker

Jim Claflin

Herb Wagoner

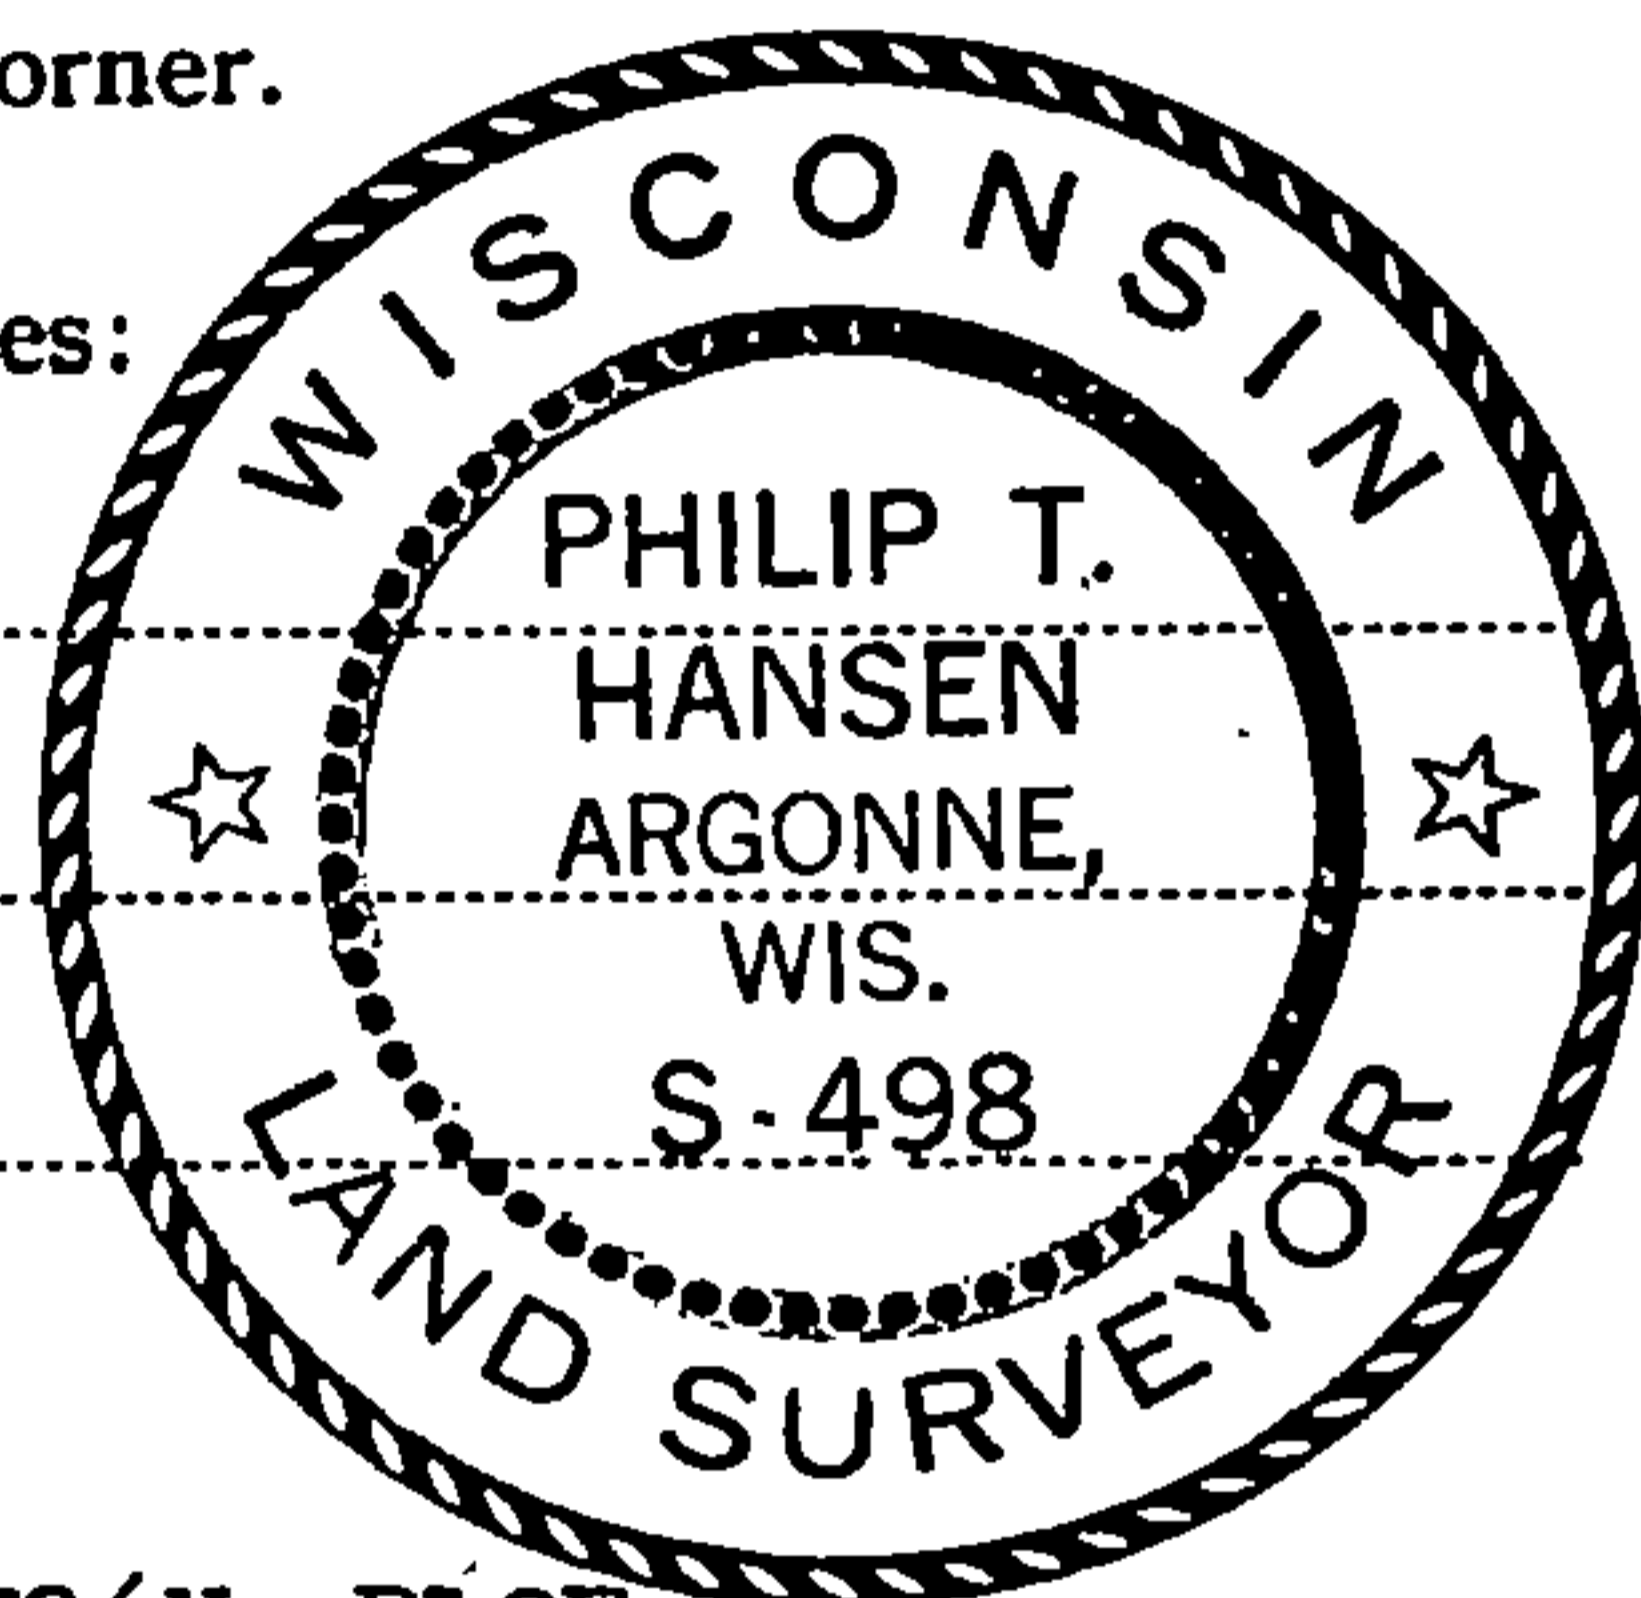


Description of monument and accessories I established to perpetuate the original location of this corner. Set 1 1/2" iron pipe with 2" brass cap 50 lks South from centerline of Tower Road. Pipe projects 2 ft. above ground. Cap stamped.

NBTs - Sugar 6" S 40° W 34.7 lks, scribed 1/16 BT.  
Sugar 6" S 84° E 15.3 lks, scribed 1/16 BT.

S498  
T36N RL2E  
E 1/16 S | 32  
S | 5  
CPI - 1976

Pipe and BTs painted blue.

FORM 985 H. C. MILLER CO., MILWAUKEE

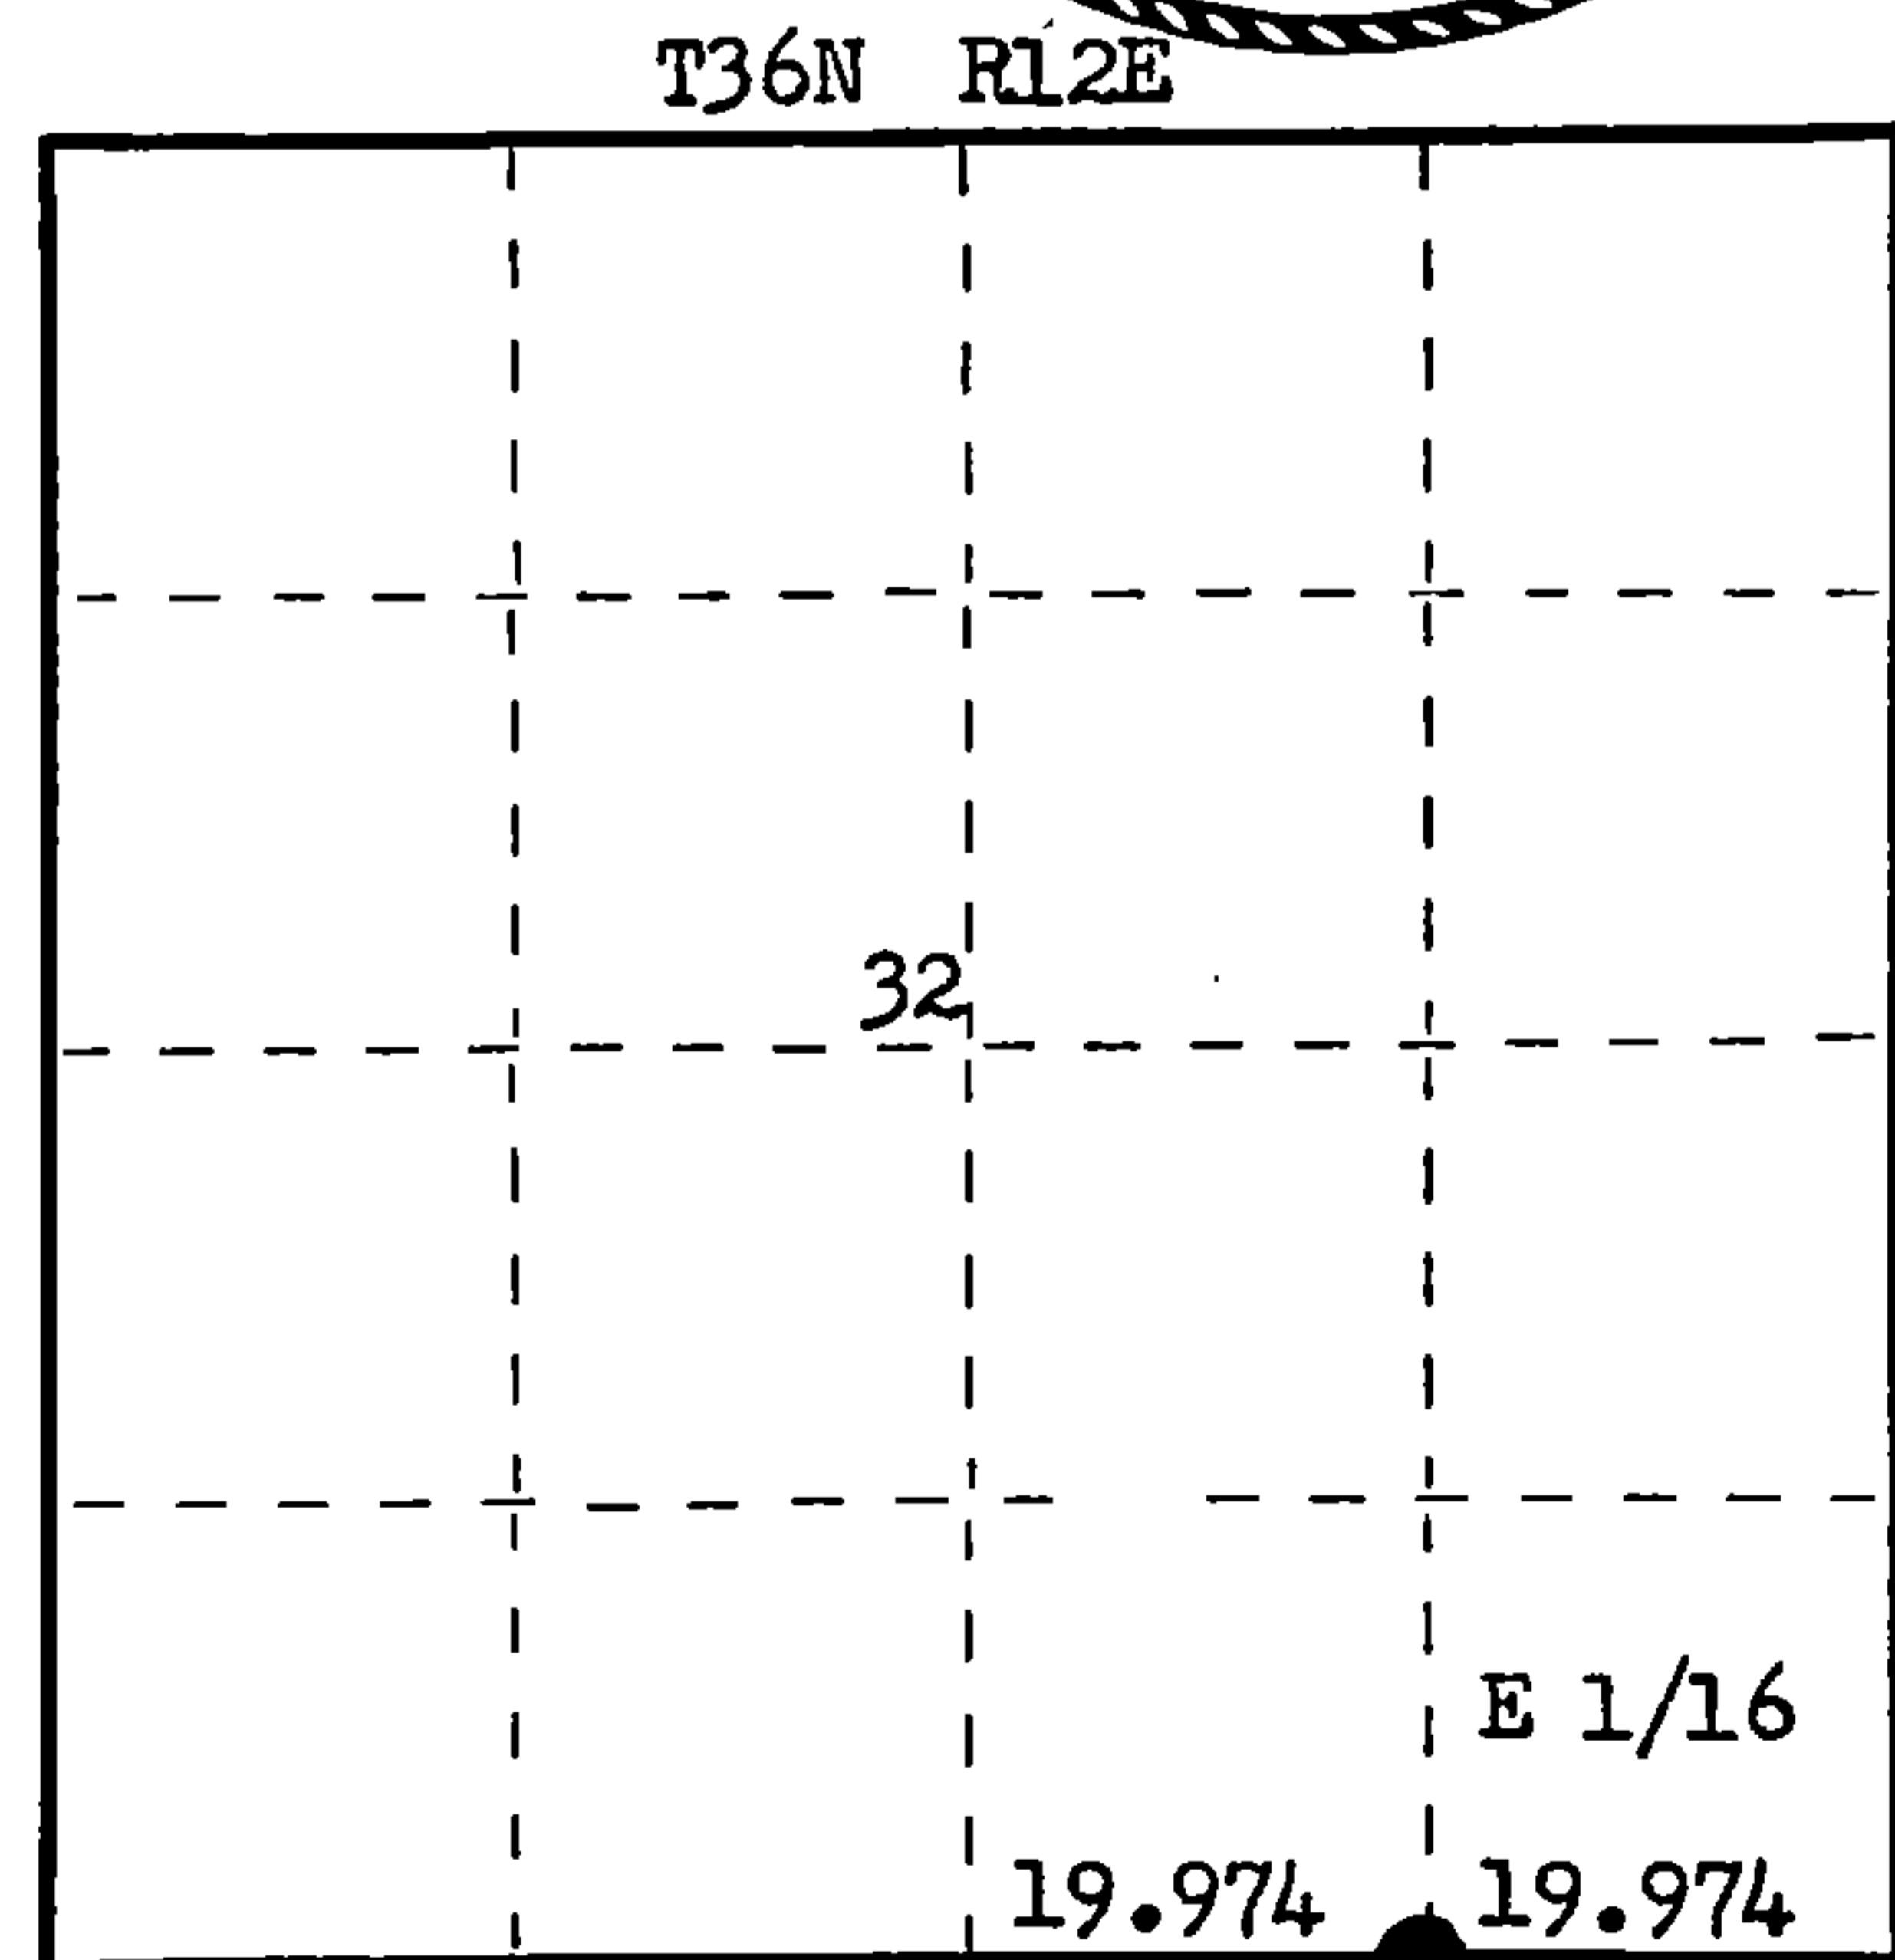

Dated at Rhineland, Wis., this 6th day of July, 1976.

Signature Philip T. Hansen Title Registered Land Surveyor Registration No. S-498  
(County Surveyor, Registered Land Surveyor, or other duly authorized official)

Office of Register of Deeds, County of Forest, I hereby certify that the within instrument was filed in this office for record on the 23rd day of July, 1976 at 3:00 o'clock P. M.

EUGENE STATEZNY

(Register of Deeds)

DOCUMENT NUMBER

**109753**

By Eileen Schmidt Deputy

○ = Corner monument restored.

43612320010