

CERTIFIED LAND CORNER RESTORATION

Index No. Y-8

State of Wisconsin }
County of Forest } ss.


I Philip T. Hansen, do hereby certify that on the 21st day of March, 1977, I ~~was~~ **established** ~~corner~~ of the SE 1/16 corner of Section 32 Township 36, North, Range 12 East, Fourth Principal Meridian, as described hereon; and that from this evidence I established a new monument and accessories as described hereon to perpetuate the original location of this corner.

Resident witnesses:


Glen Barker

Jim Claflin

Herb Wagoner

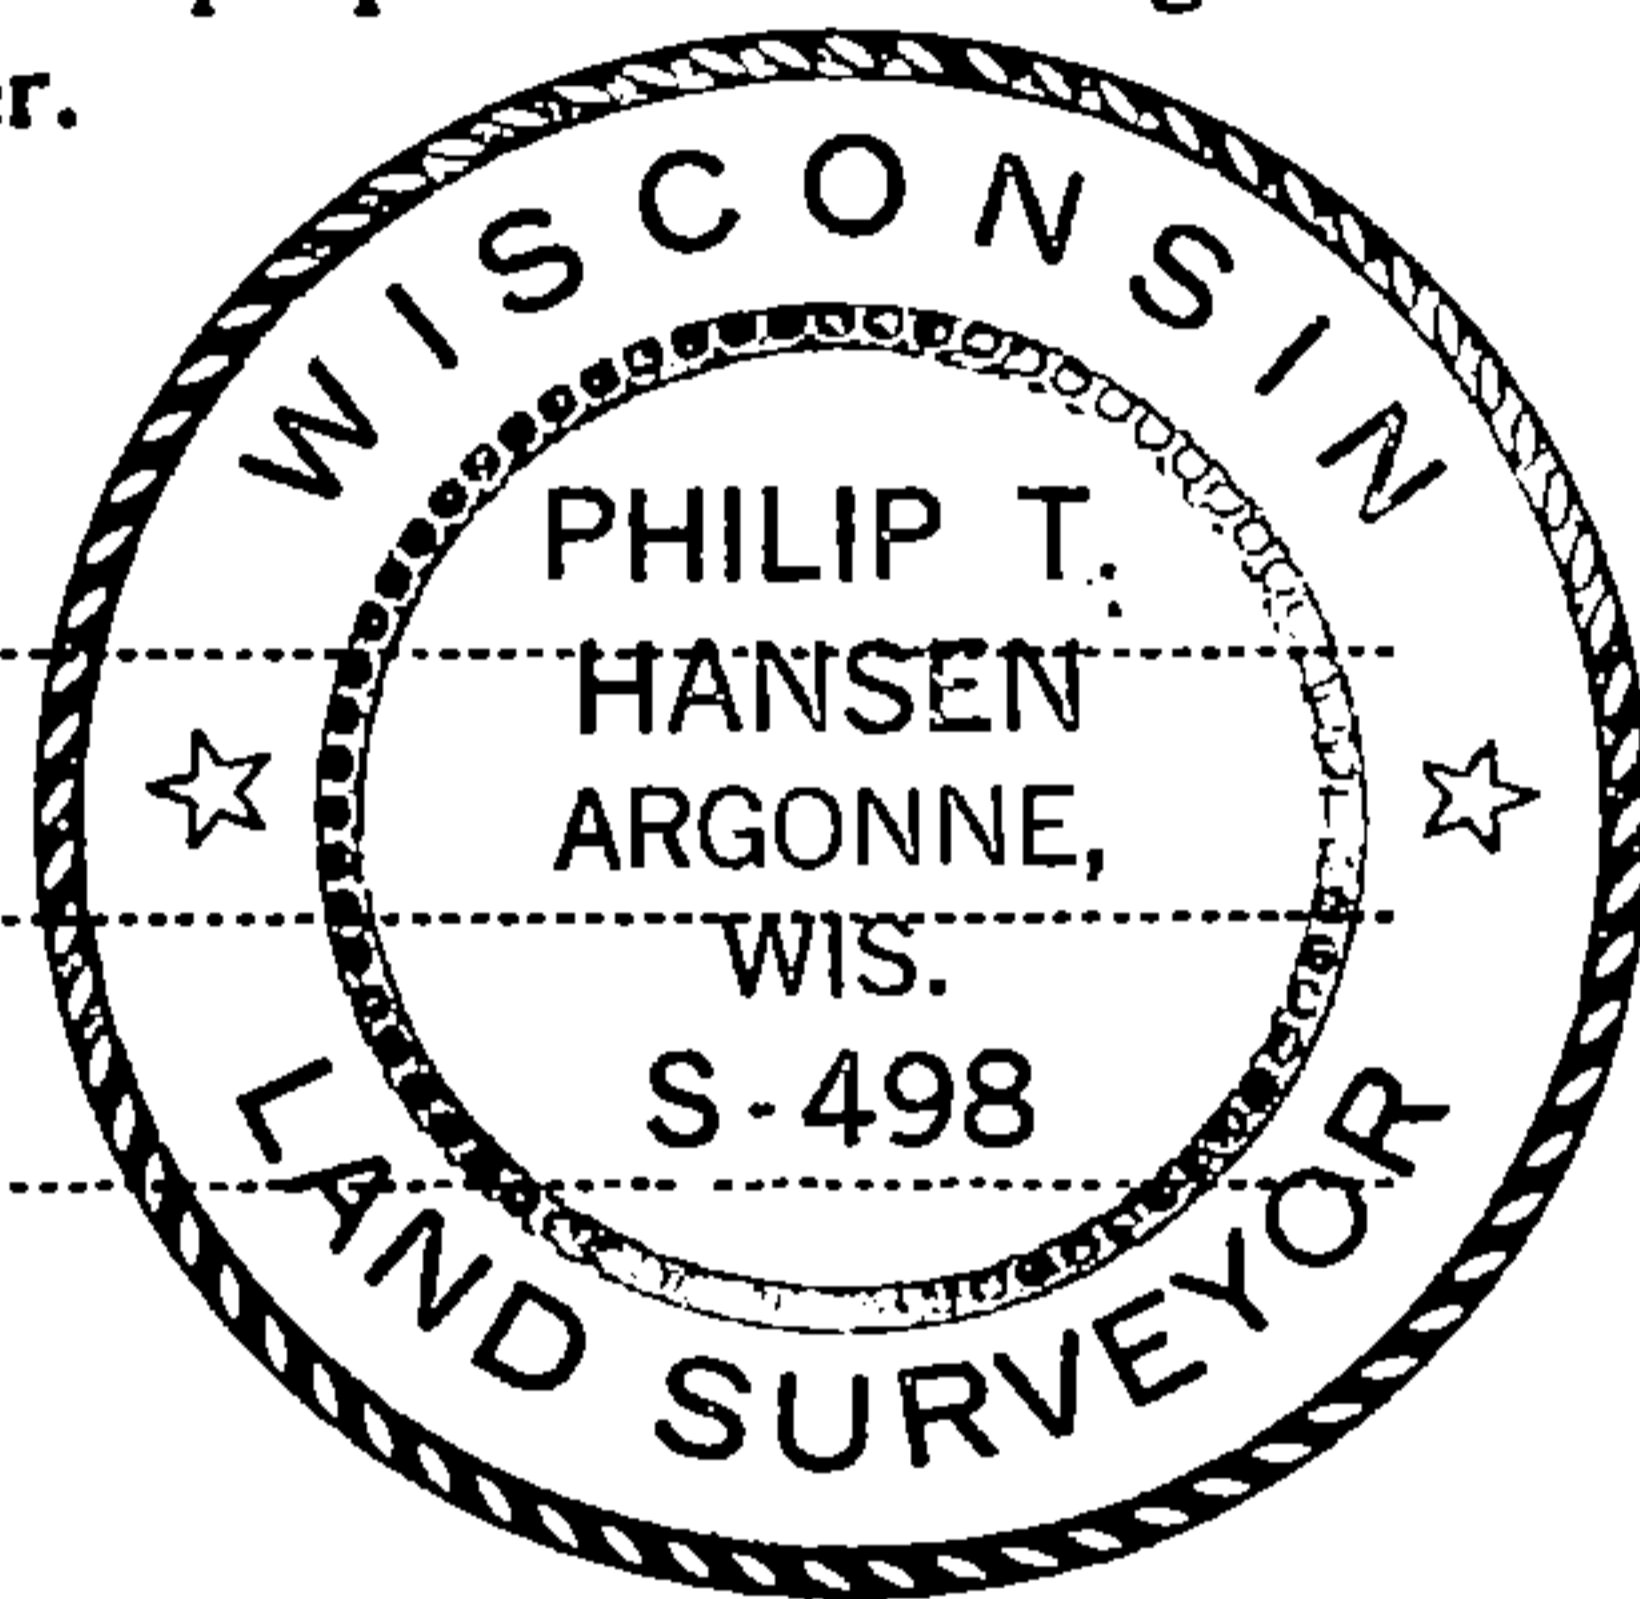

FORM 985

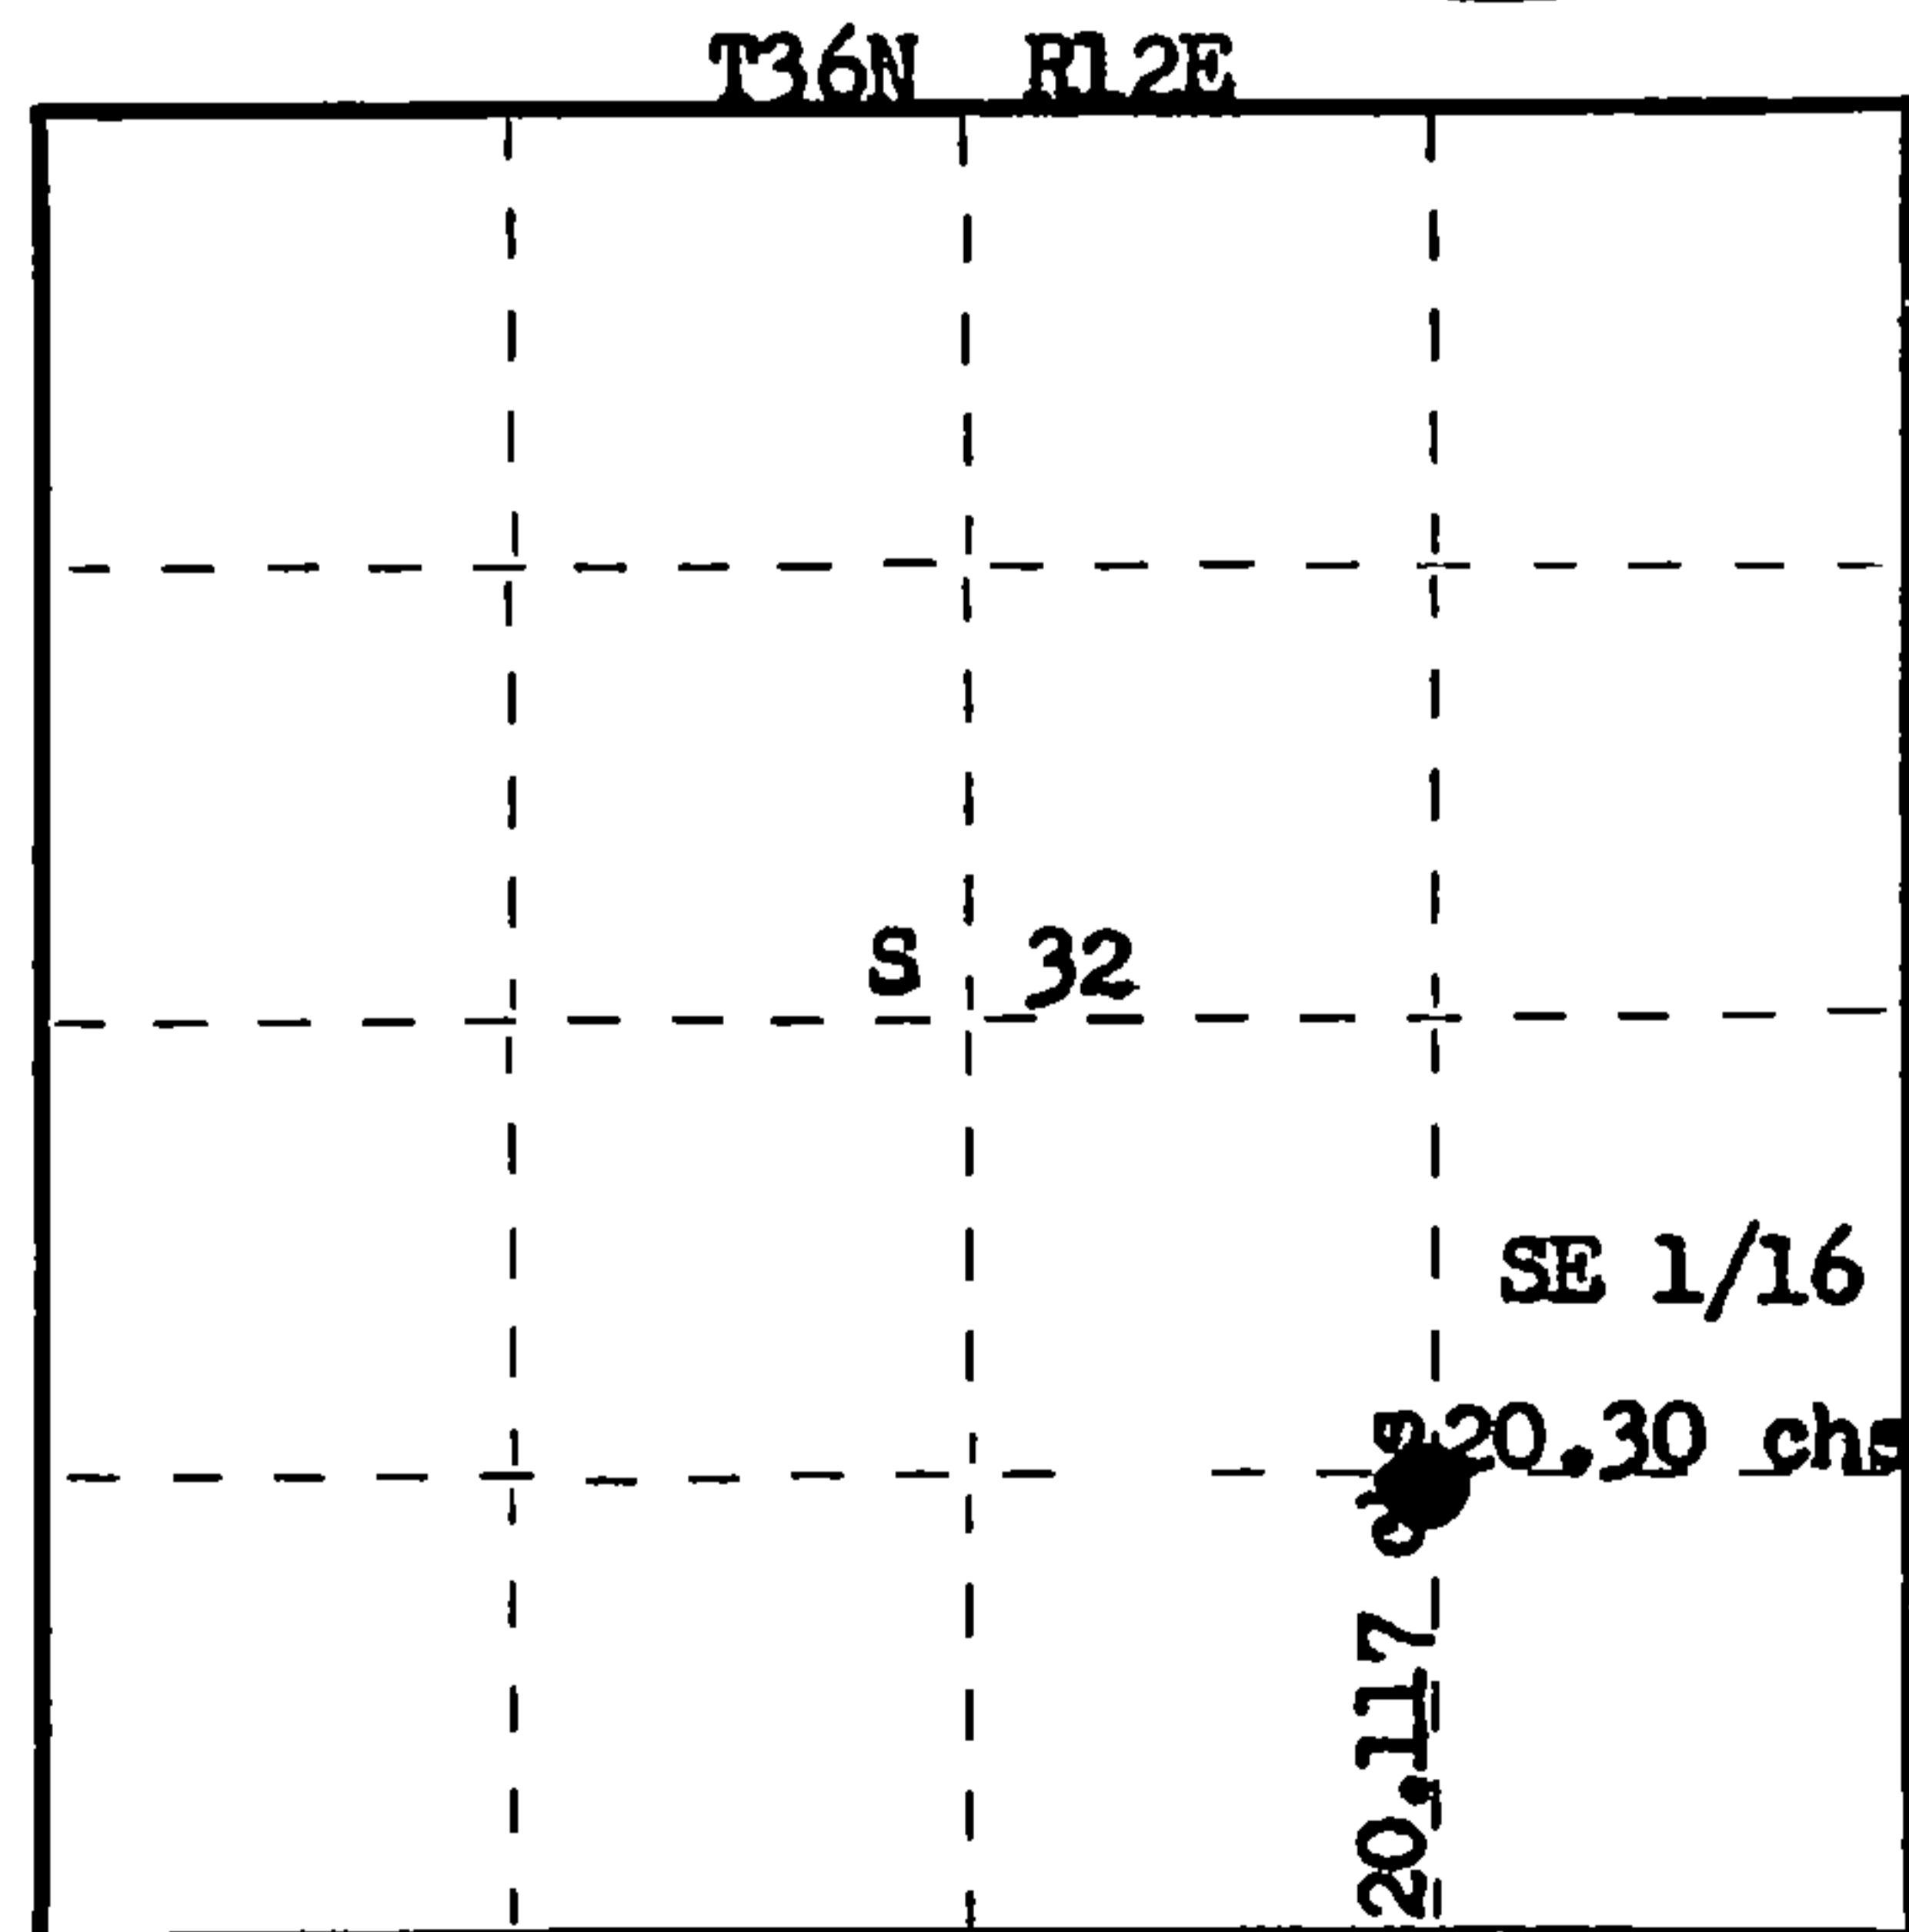

○ = Corner monument restored.

History of original corner establishment:

No records of any previous corner having been set. No evidence of any corner.

Description of corner evidence found:

Unable to recover any evidence of this corner.
Corner established by traverse and computations from established S 1/16 corner and SC 1/16 corner and the E 1/16 corner and EC 1/16 corner.
Computed location is N 89° 56' 14" W, 20.30 chains from S 1/16 corner on east line and N 1° 29' 59" E, 20.117 chains from E 1/16 corner.

Description of monument and accessories I established to perpetuate the original location of this corner.

Set 1 1/2" iron pipe with 2" brass cap, stamped:
Monument projects 18" above ground.
Marked NBTs - Sugar 7" N 2° E, 32.5 links, scribed 1/16 BT.
Sugar 6" N 68° W, 64.3 links, scribed 1/16 BT.

S498
T36N R12E
SE 1/16 S 32
CPI-1977

Dated at Rhineland, Wis., this 25th day of April, 1977.

Signature _____ Title Registered Land Surveyor Registration No. S-498
(County Surveyor, Registered Land Surveyor, or other duly authorized official)

Office of Register of Deeds, County of Forest, I hereby certify that the within instrument was filed in this office for record on the 5th day of May, 1977 at 4:00 o'clock P. M.

Eugene Stutzman
(Register of Deeds)

By _____ Deputy

DOCUMENT NUMBER
111373

H3612321010