

CERTIFIED LAND CORNER RESTORATION

Index No. **X-9**

State of Wisconsin } ss.  
County of Forest



I Philip T. Hansen, do hereby  
certify that on the 29th day  
of June, 1976, I found  
evidence of the Quarter  
corner of Sec. 32 - 33  
Township 36, North, Range  
12 East, Fourth Principal Meridian,  
as described hereon; and that from this evidence  
I established a new monument and accessories  
as described hereon to perpetuate the original  
location of this corner.

Resident witnesses:

Glen Barker

Jim Claflin

Herb Wagoner

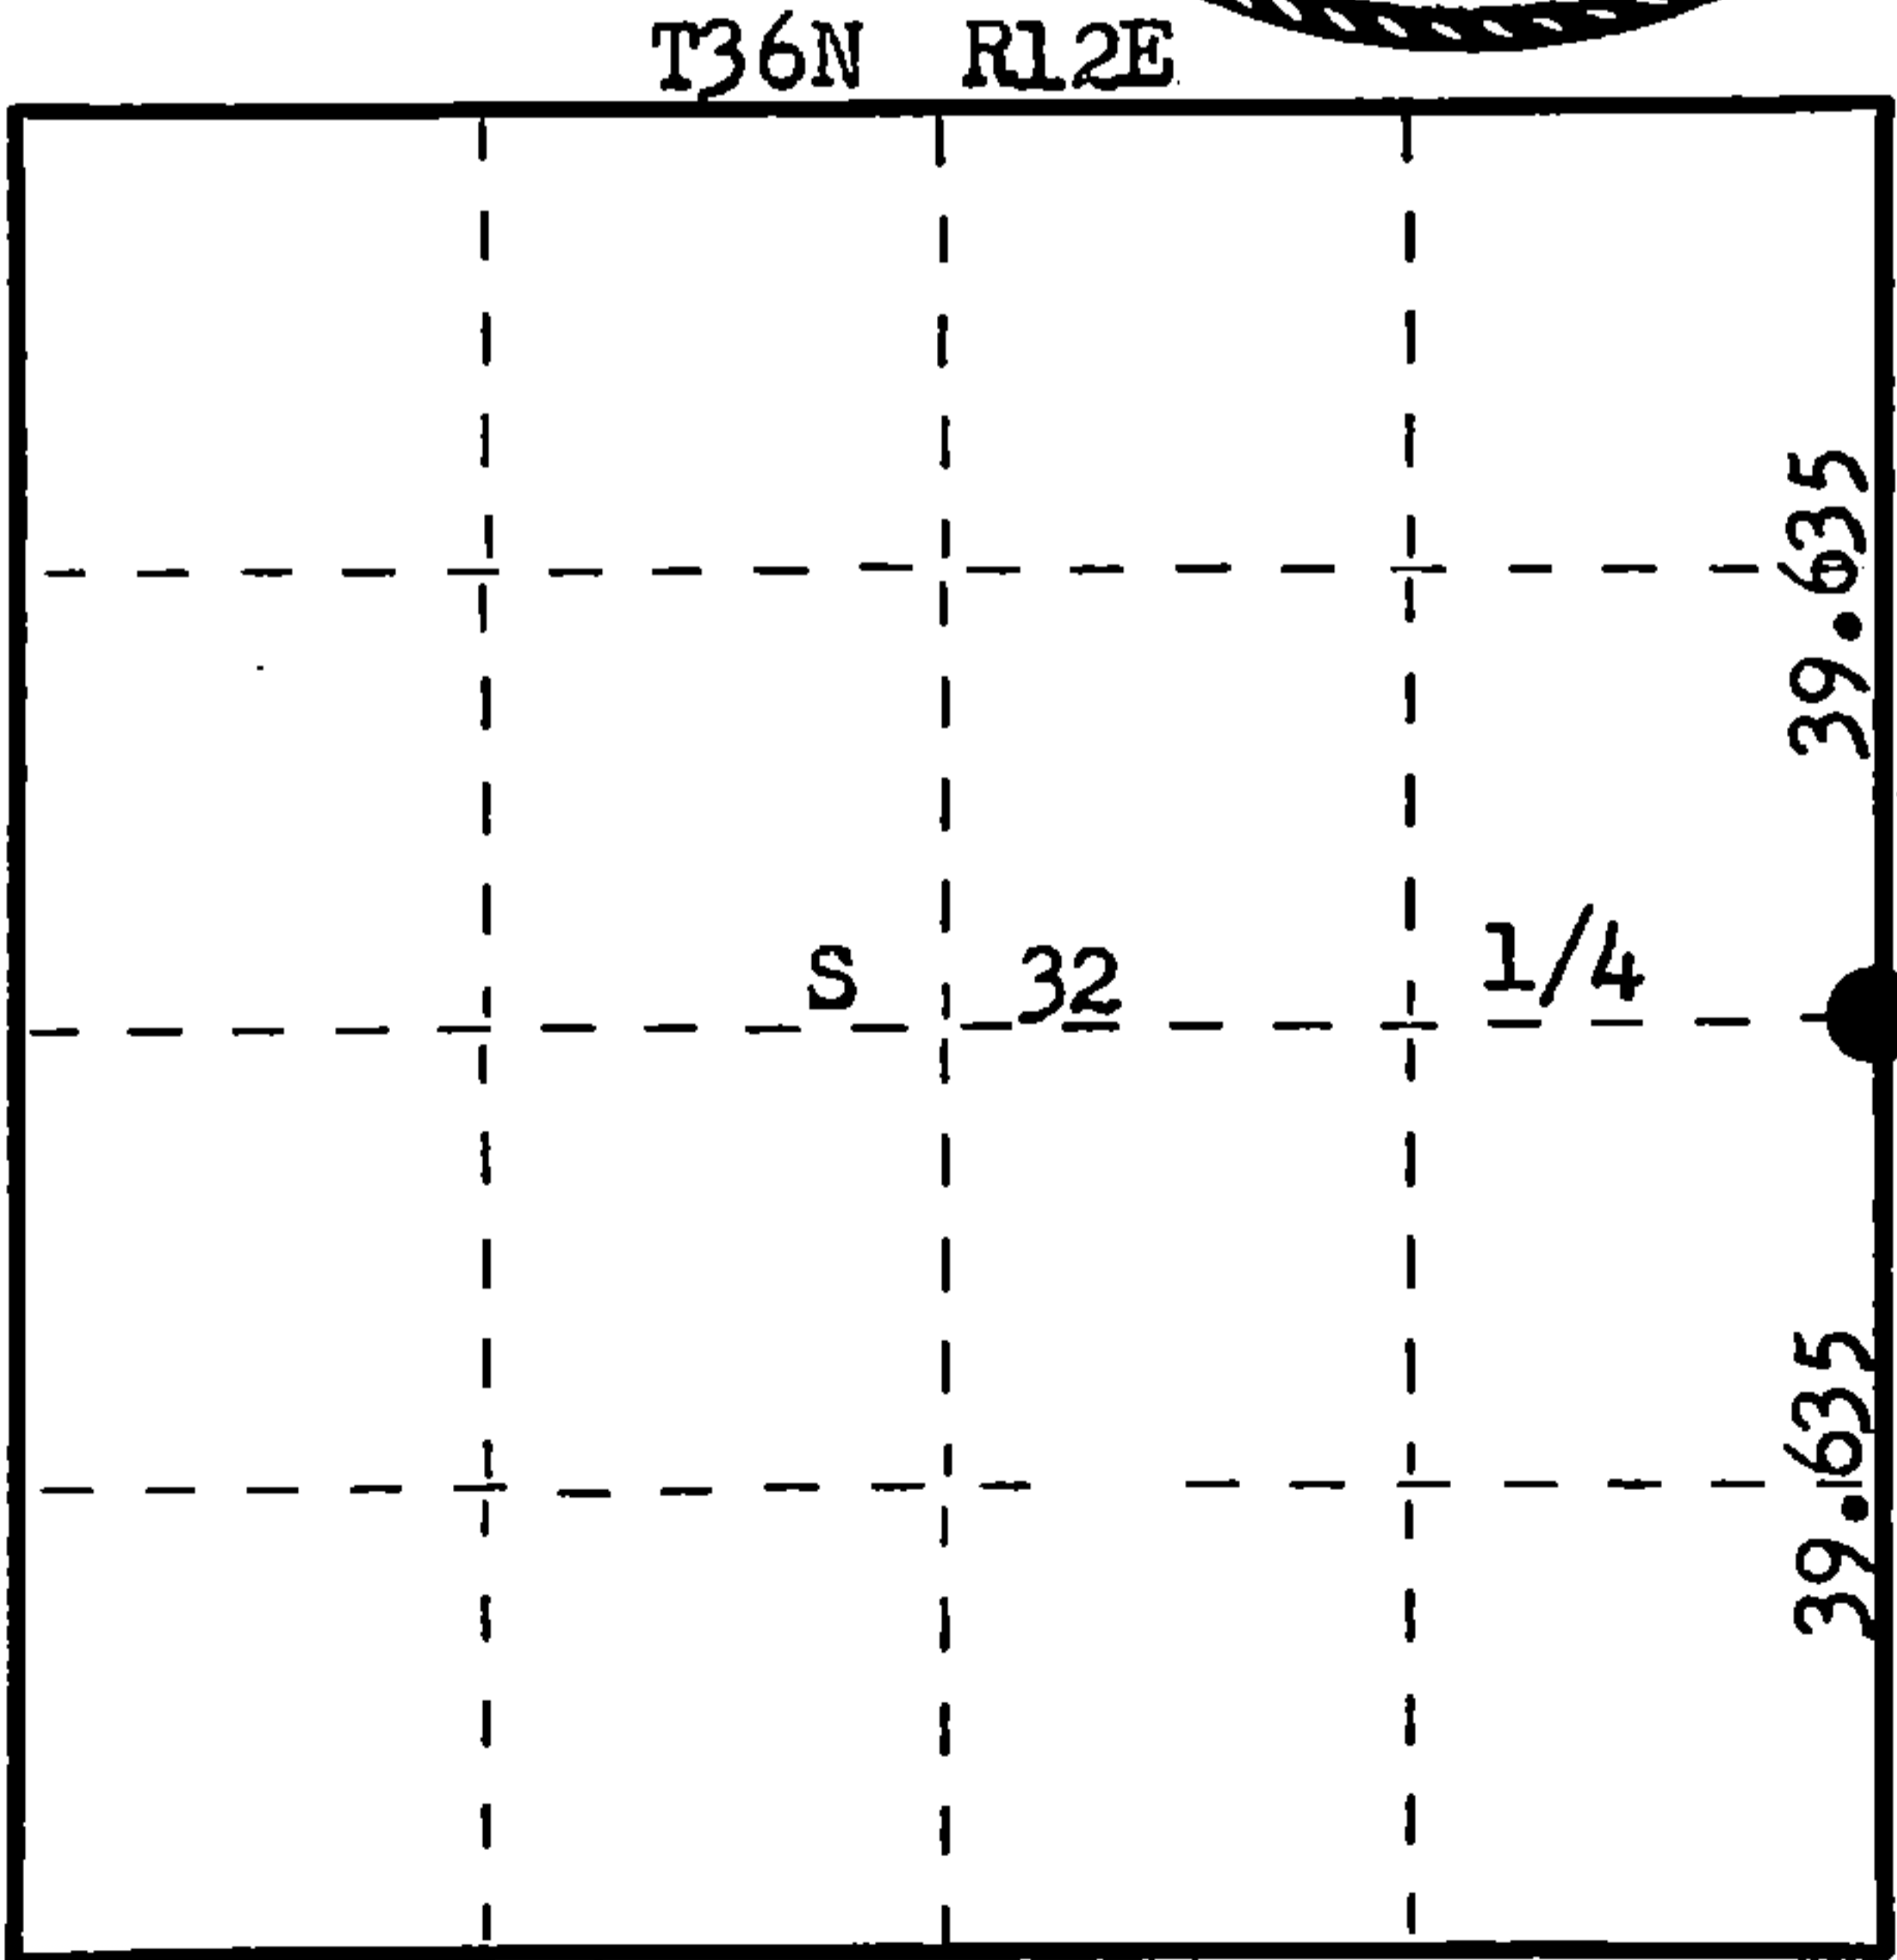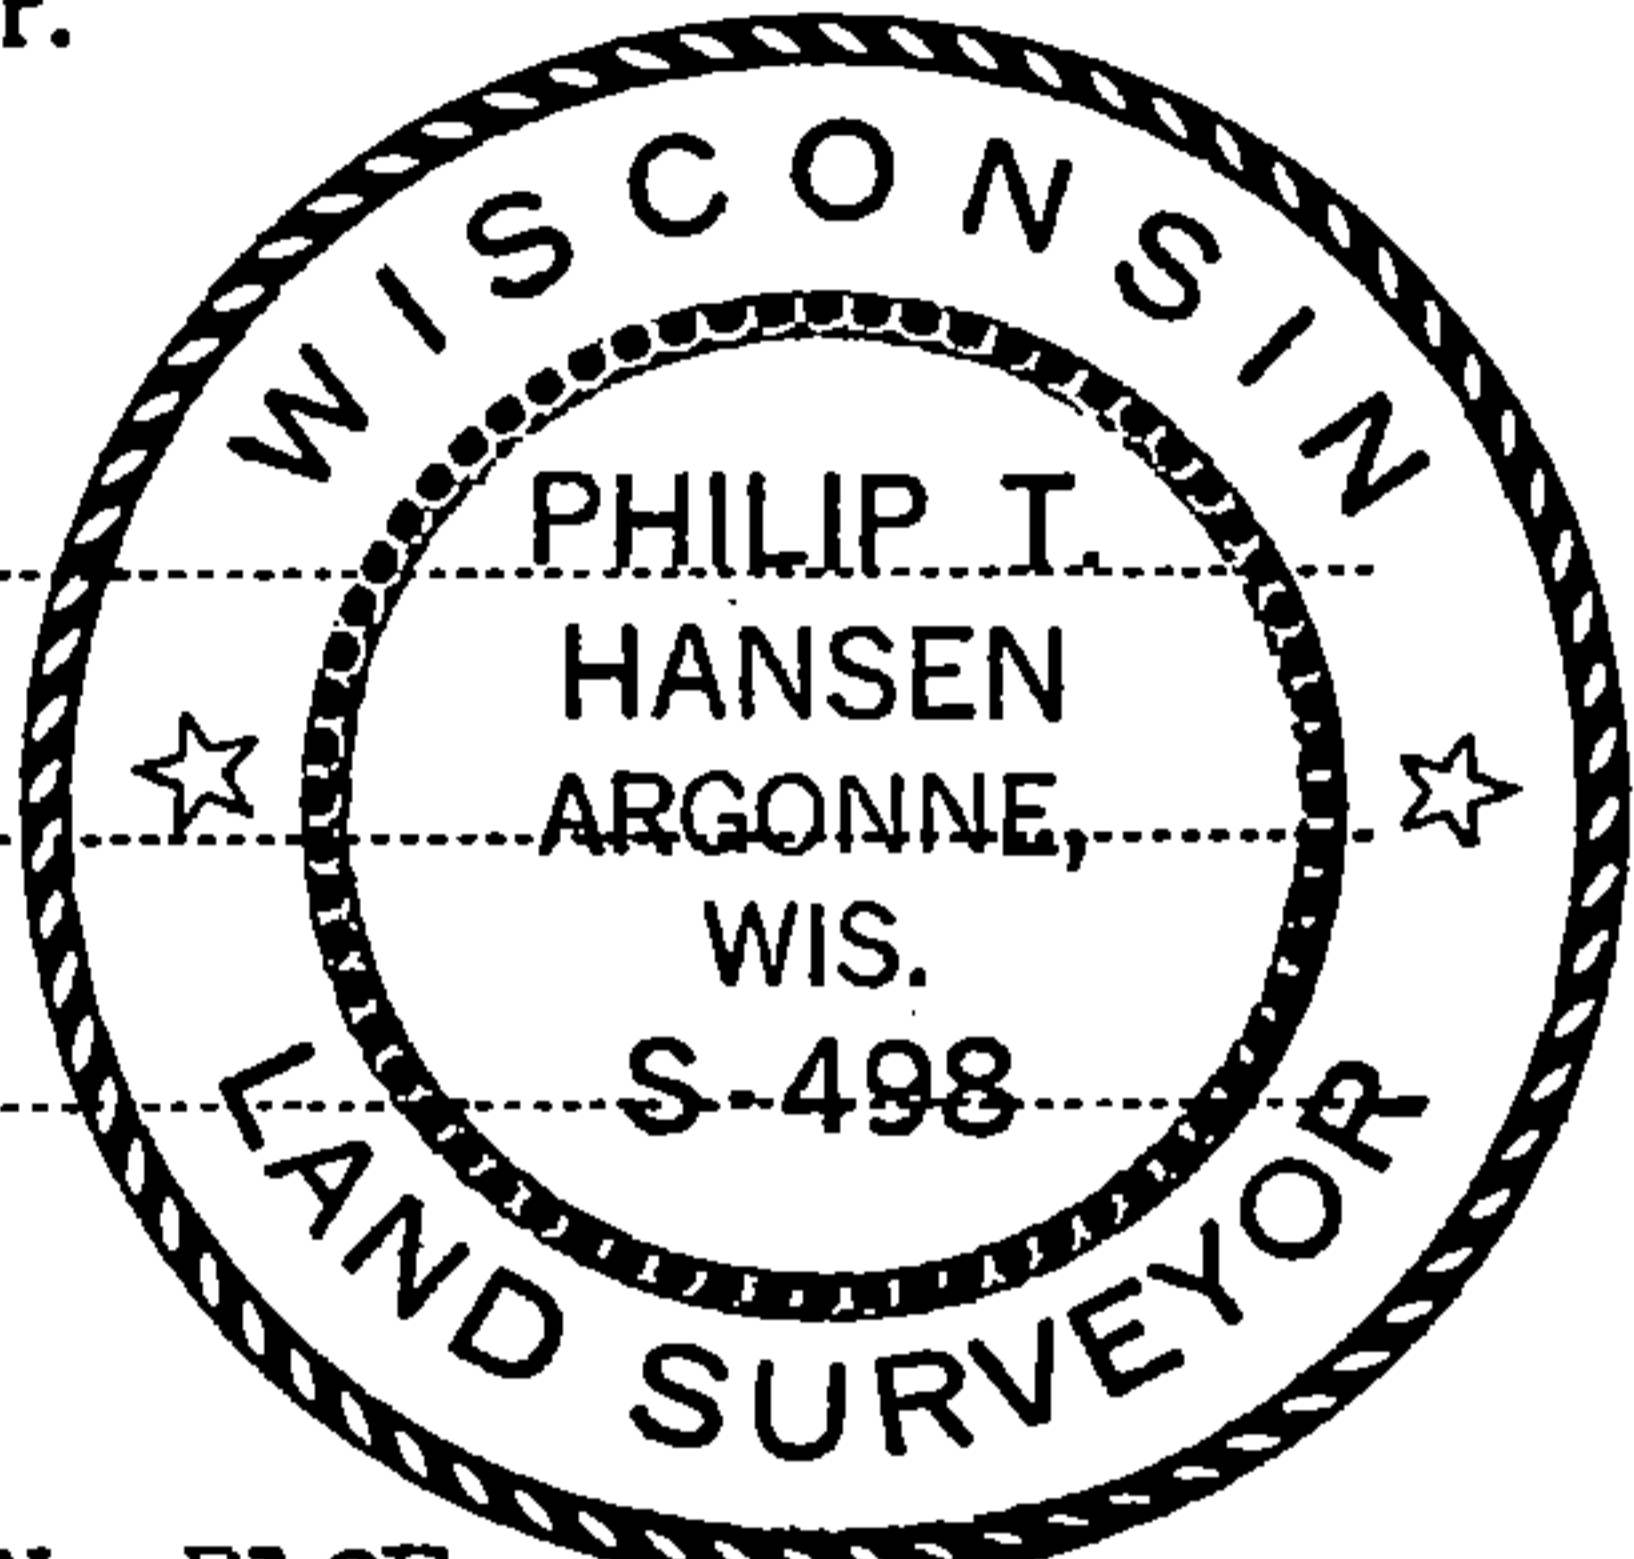

○ = Corner monument restored.

History of original corner establishment: Original corner established by Wm. E. Dougherty, Deputy Surveyor, in 1859 from which Birch 12" bears N 25° E 55 lks and Birch 12" bears S 87° W 60 lks.

No record of subsequent surveys. Sanford Ison states that he worked on the Tower Road about 1930 and that the road was built on line between Section 32 and 33.

Description of corner evidence found: Set corner by proportionate measurement between Sec. Corner 28 - 29, 32, 33, and Sec. Corner 32, 33, 5 and 4. Total distance 79.272 chains, bearing N 2° 22' 55" E.

Set corner on line, equidistant at 39.635 chains from Section Corner 28, 29, 32 and 33.

Description of monument and accessories I established to perpetuate the original location of this corner.  
Set a 1 1/2" x 18" iron pipe in the centerline of Tower Road, 6" below surface.  
Set a 2 1/2" Berntsen A-1 Federal Monument for Witness Corner 50 lks East.  
Monument projects 1 ft. above ground. Cap stamped.  
NBTs - Sugar 5" N 61° E 65.5 lks, scribed 1/4 BT.  
Sugar 6" N 35° W 91.2 lks, scribed 1/4 BT.  
Sugar 6" S 73° W 54.8 lks, scribed 1/4 BT.  
Measurements and bearings made to true corner.  
Monument and BTs painted blue.

T36N R12E  
1/4 S32 | S33 W.C.  
50 lks. W. to Cor.  
S498 - 1976

Dated at Rhineland, Wis., this 1st day of July, 1976.

Signature Philip T. Hansen Title Registered Land Surveyor Registration No. S-498  
(County Surveyor, Registered Land Surveyor, or other duly authorized official)

Office of Register of Deeds, County of Forest, I hereby certify that the within  
instrument was filed in this office for record on the 23rd day of July, 1976  
at 3:00 o'clock P. M.

EUGENE STATEZNY

(Register of Deeds)

By Eileen Schmidt Deputy

DOCUMENT NUMBER **109749**