

CERTIFIED LAND CORNER RESTORATION

Index No. X-8

State of Wisconsin }
County of Forest } ss.


I Philip T. Hansen, do hereby certify that on the 21st day of March, 1977, I ~~restored~~ **established** the EC 1/16 corner of Section 32 Township 36, North, Range 12 East, Fourth Principal Meridian, as described hereon; and that from this evidence I established a new monument and accessories as described hereon to perpetuate the original location of this corner.

Resident witnesses:


Glen Barker

Jim Claflin

Herb Wagoner

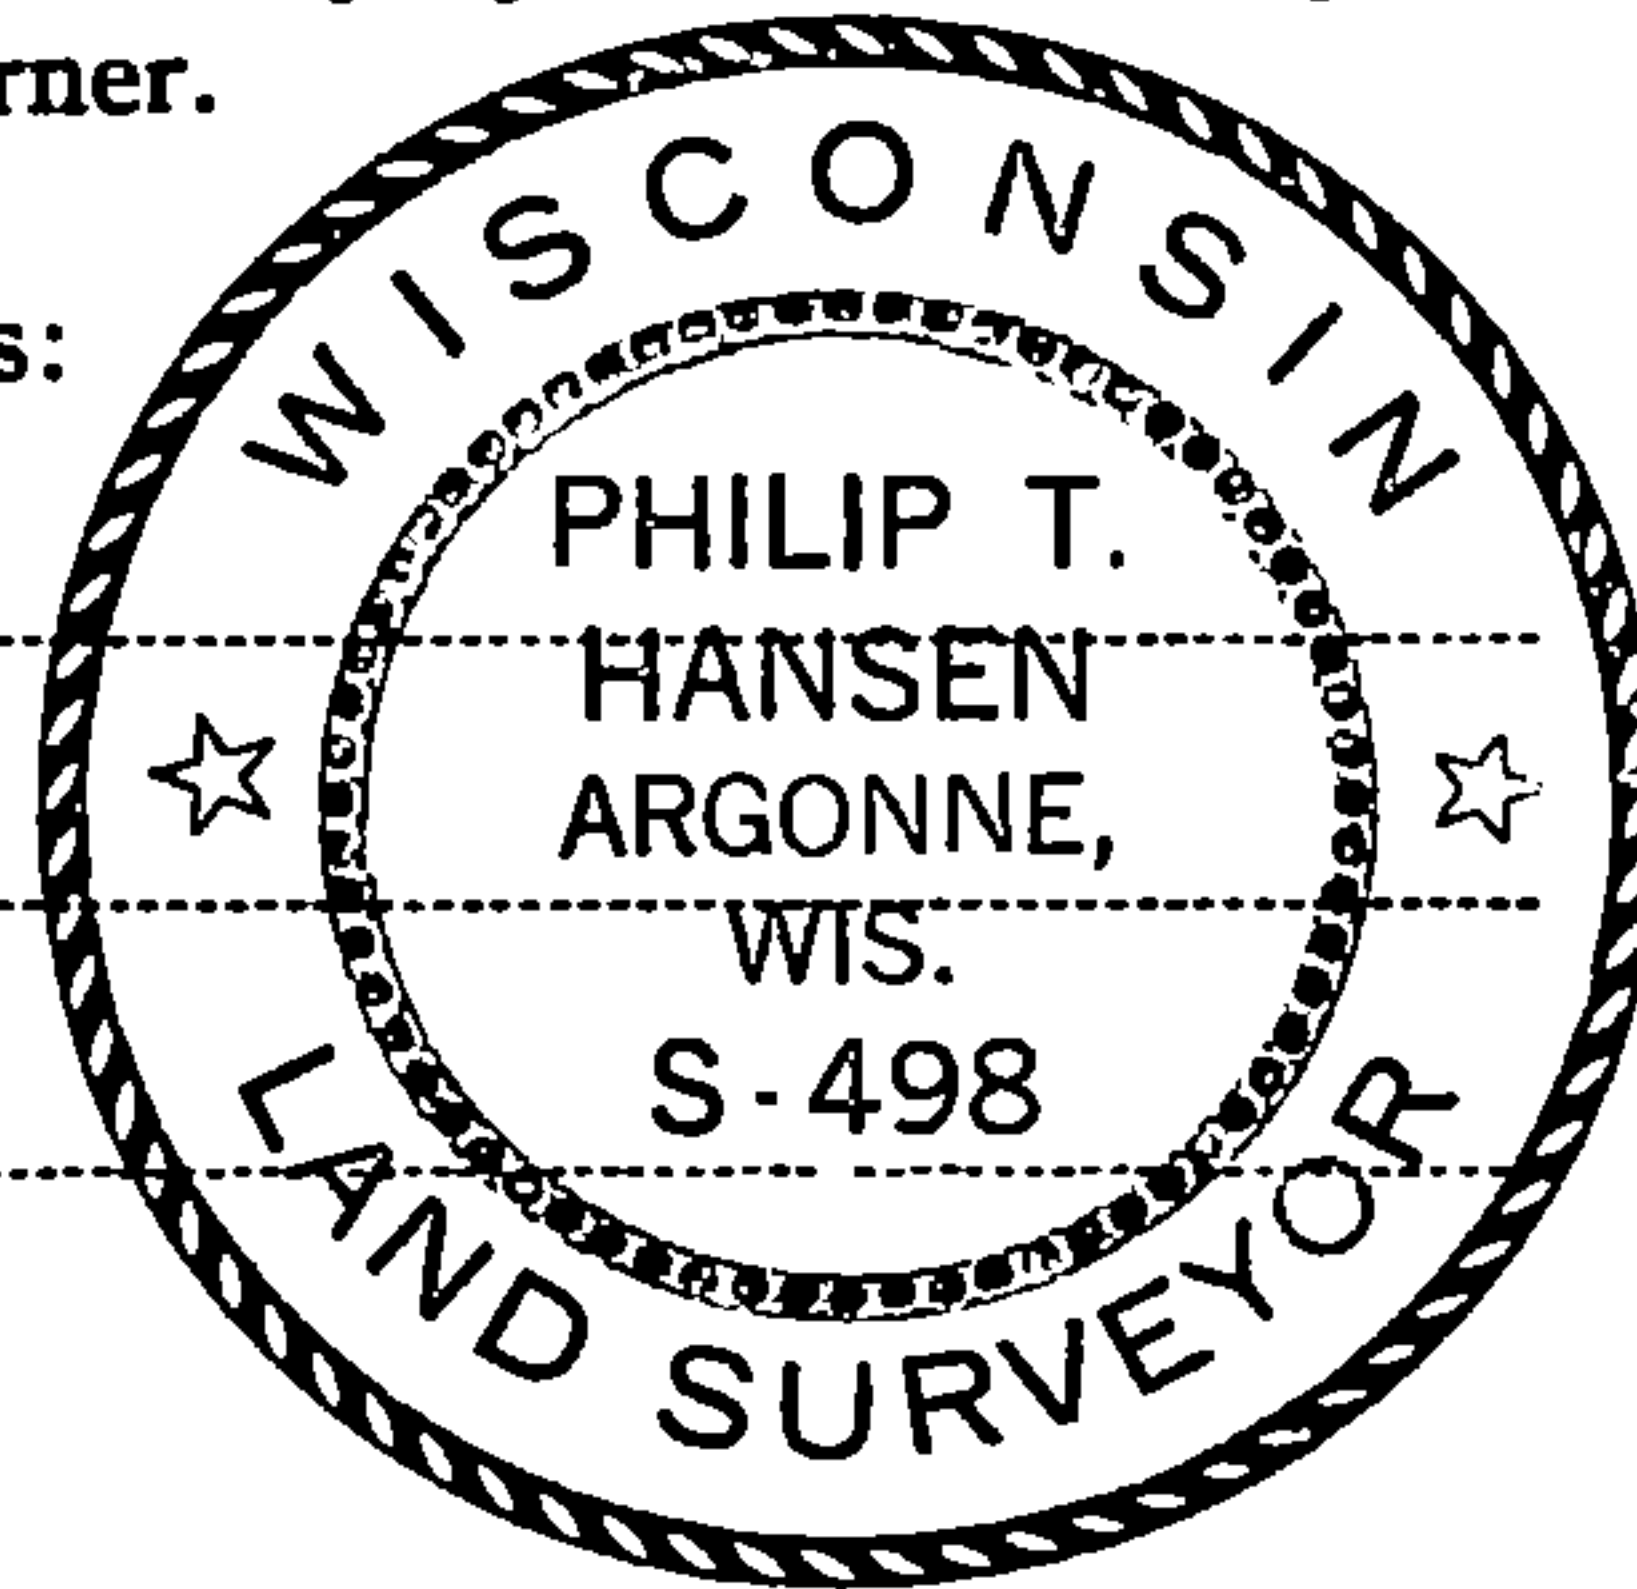

FORM 985

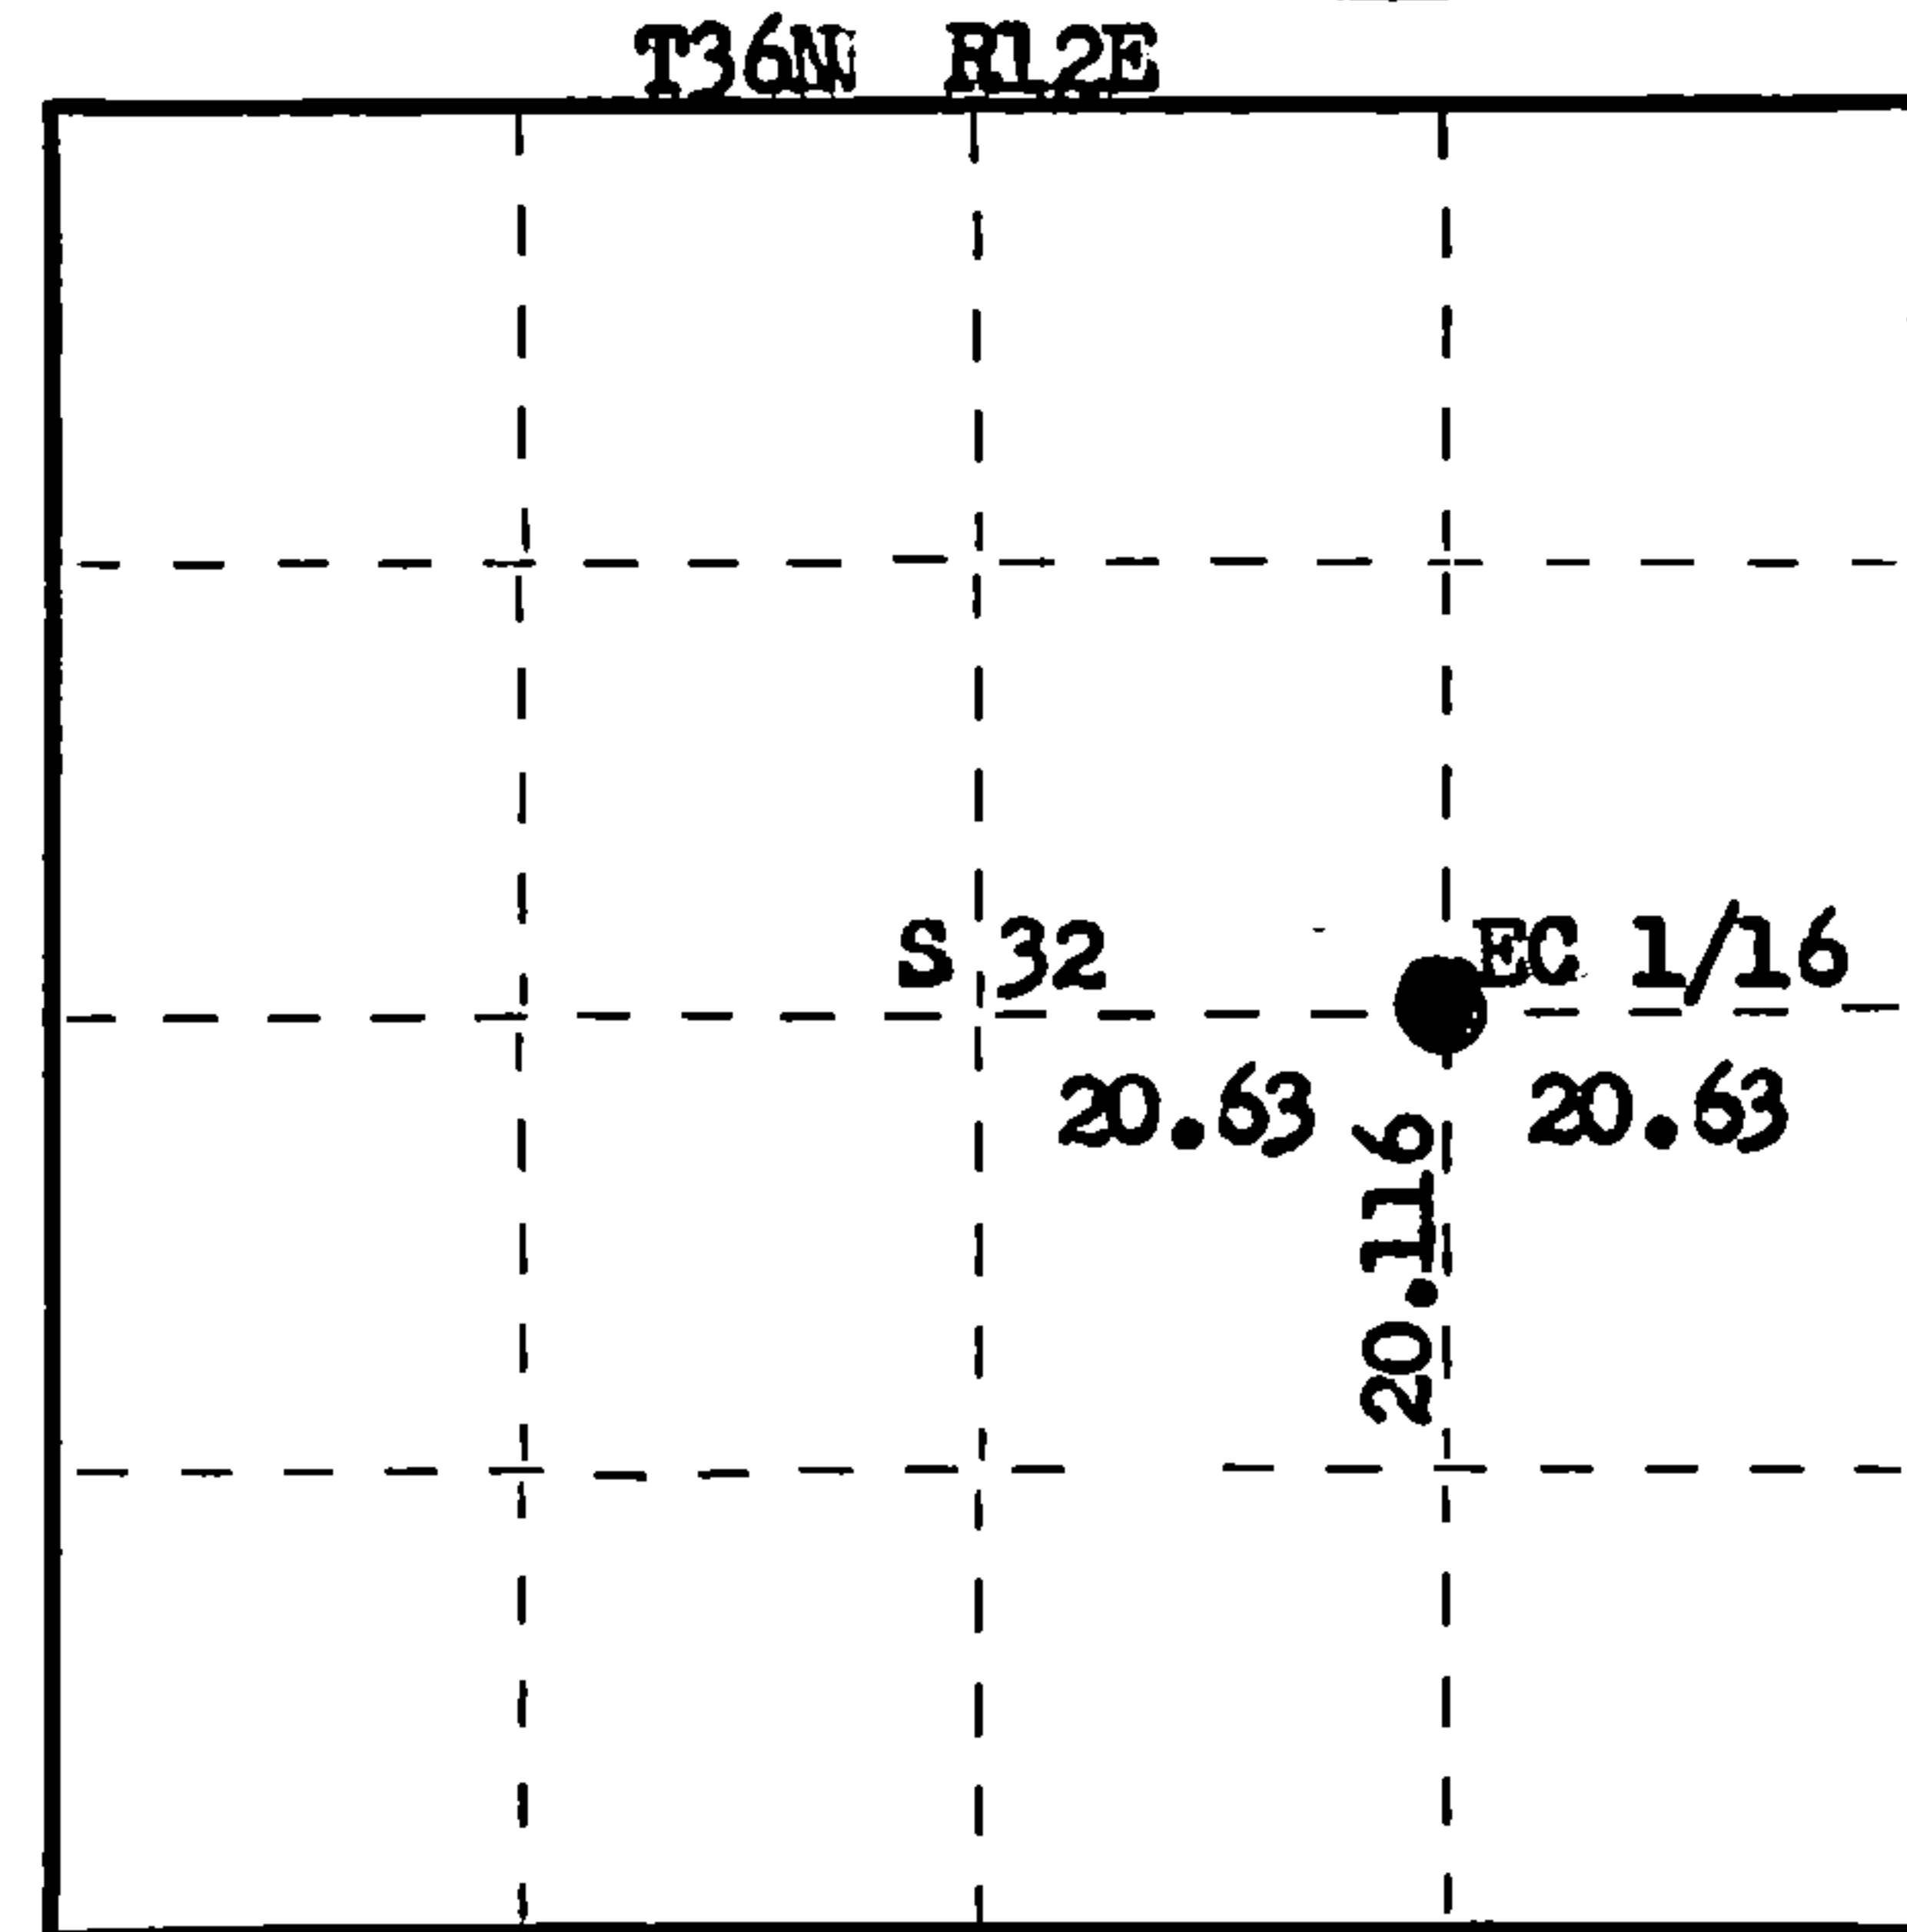

○ = Corner monument restored.

History of original corner establishment:
No record or evidence of any corner having been previously established.

Description of corner evidence found:

Corner established by traverse and computation from previously established 1/4 corners to establish the C 1/4 corner. Set the EC 1/16 corner at 20.63 chains N 89° 03' 05" W of E 1/4, equidistant between it and the C 1/4 corner, N 1° 29' 59" E, 20.116 chains from SE 1/16 corner.

Description of monument and accessories I established to perpetuate the original location of this corner.
Set 1 1/2" iron pipe with 2" brass cap, projecting 24" above ground - cap stamped:

Marked NBTs - Sugar 7" N48°W, 37.3 links, scribed 1/16 BT.
Sugar 10" N7°W, 108.9 links, scribed 1/16 BT.

S498
T36N R12E
EC 1/16 S 32
CPI-1977

Dated at Rhineland, Wis., this 6th day of April, 1977.

Signature Philip T. Hansen Title Registered Land Surveyor Registration No. S-498
(County Surveyor, Registered Land Surveyor, or other duly authorized official)

Office of Register of Deeds, County of Forest, I hereby certify that the within instrument was filed in this office for record on the 5th day of May, 1977 at 4:00 o'clock P. M.

Eugene Staszny
(Register of Deeds)

By.....Deputy

DOCUMENT NUMBER
111371

43012322010