

CERTIFIED LAND CORNER RESTORATION

Index No. X-6

State of Wisconsin }
County of Forest } ss.



I Philip T. Hansen, do hereby
certify that on the 17th day
of March, 19 77, I ~~restored~~
established ~~corner~~ of the WC 1/16
corner of Section 32
Township 36, North, Range
12 East, Fourth Principal Meridian,
as described hereon; and that from this evidence
I established a new monument and accessories
as described hereon to perpetuate the original
location of this corner.

Resident witnesses:

Glen Barker

Jim Claflin

Herb Wagoner

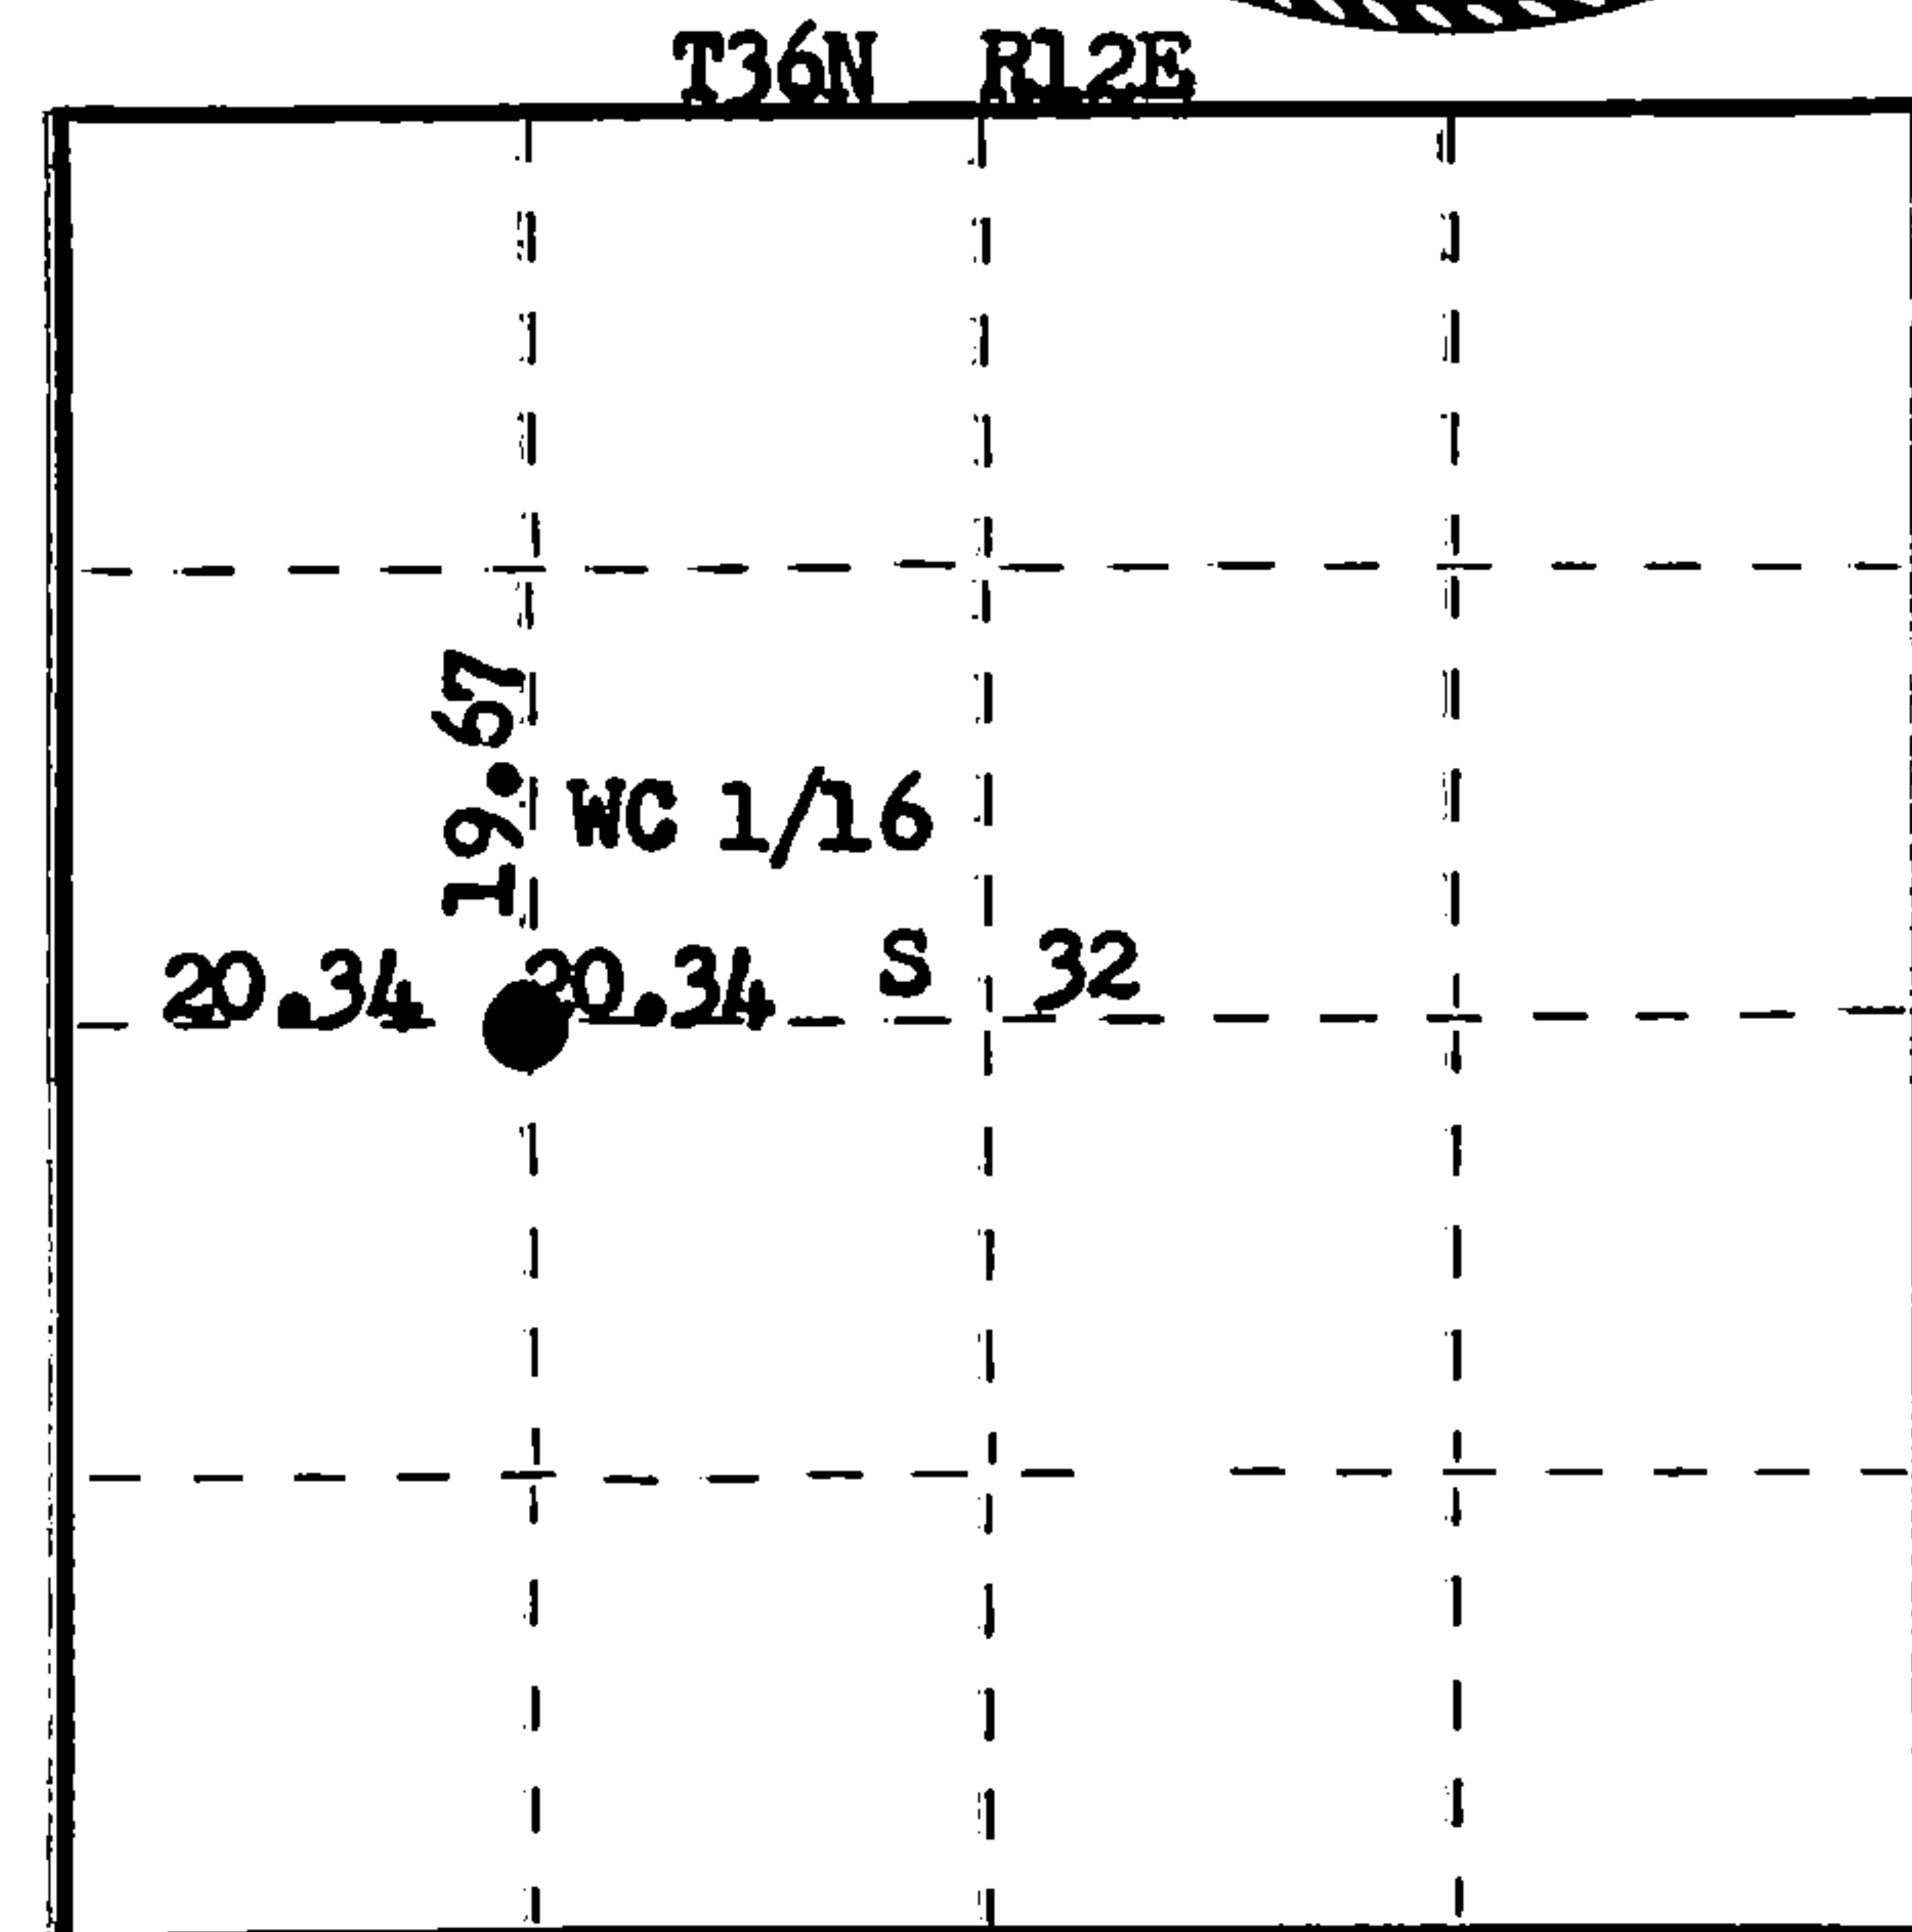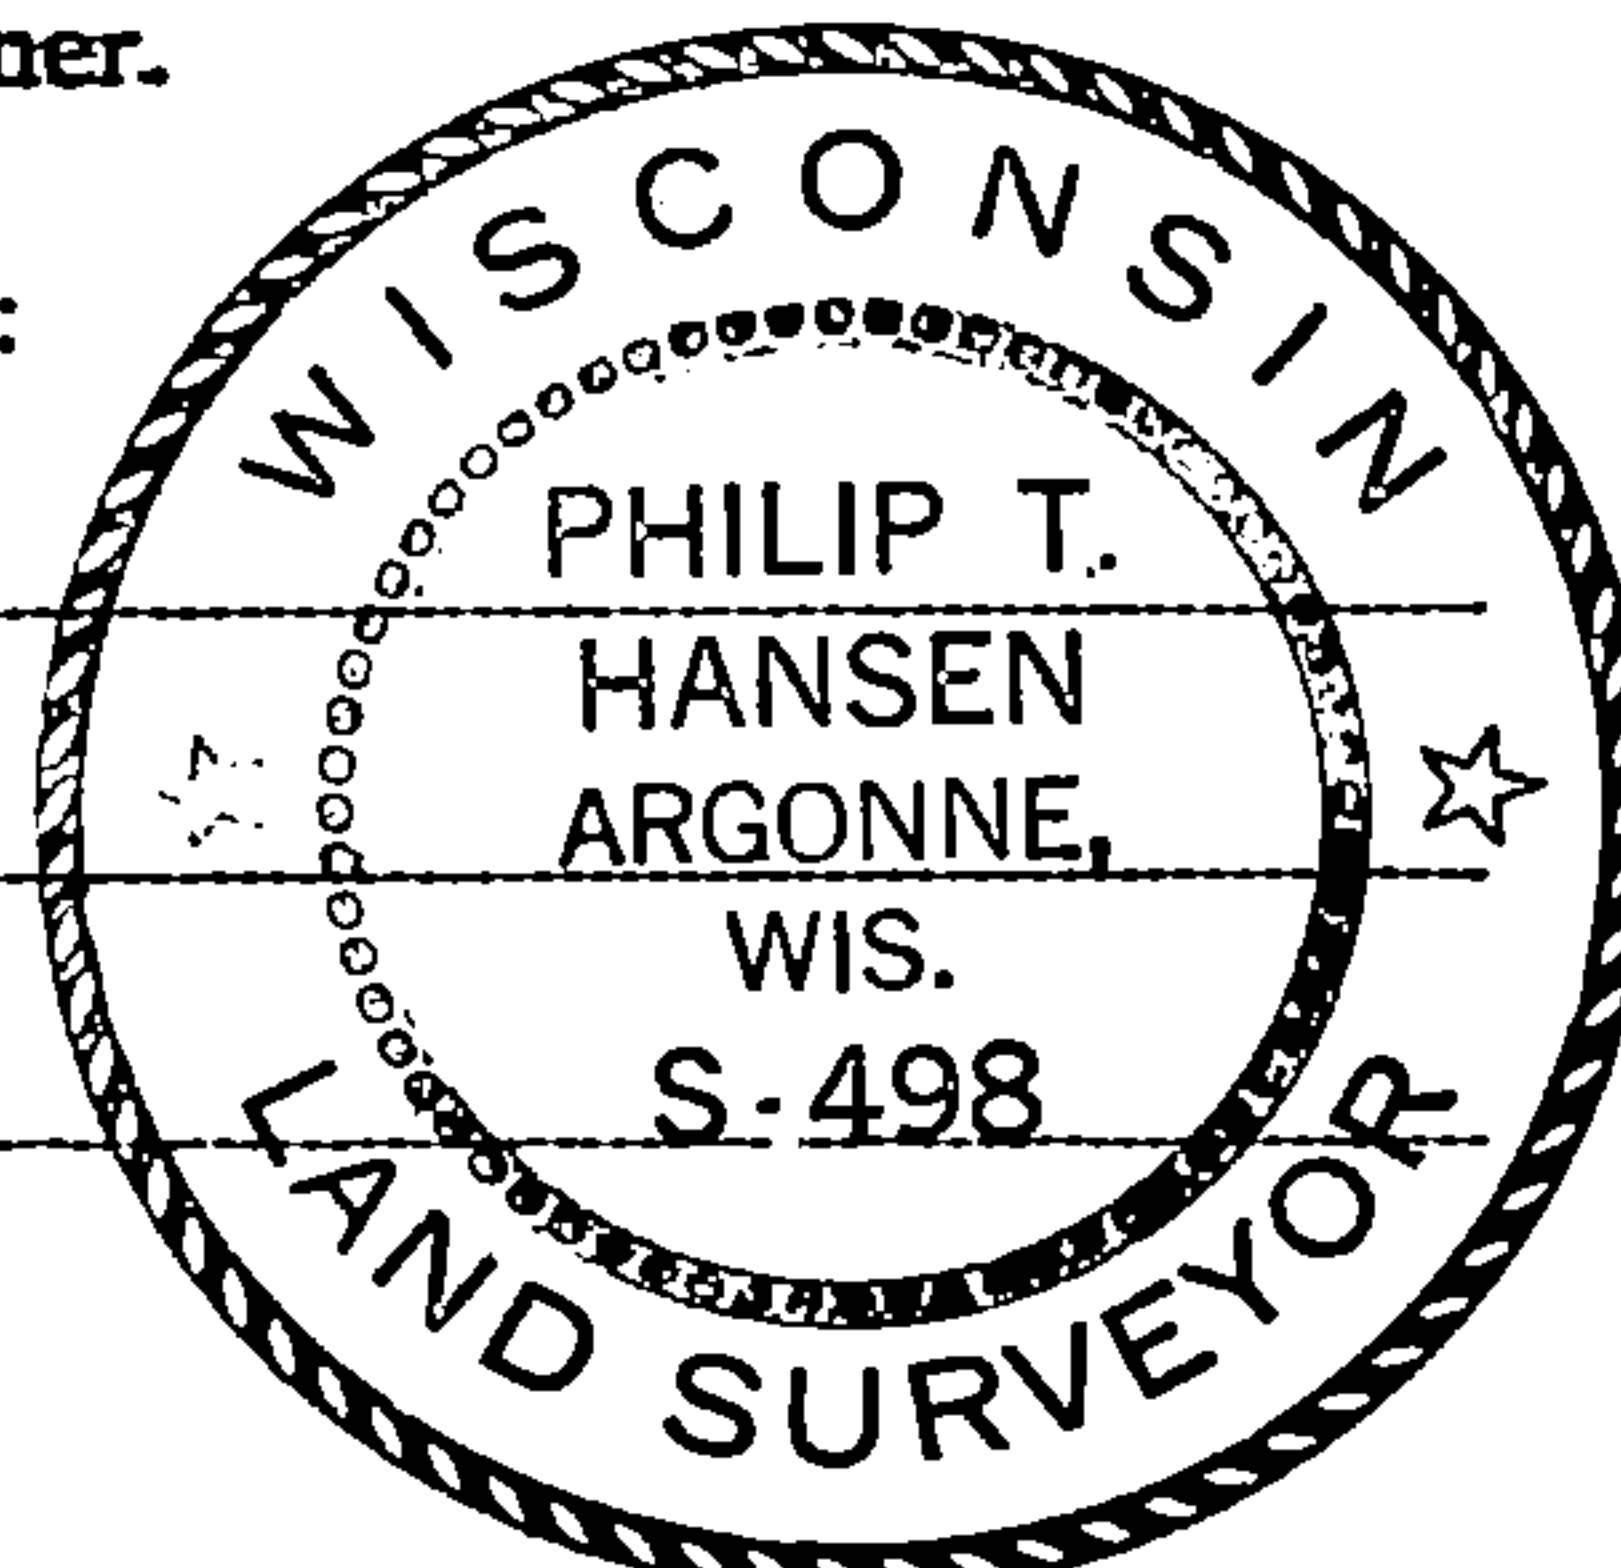

○ = Corner monument restored.

History of original corner establishment:

No record or evidence of this corner having been previously established.

Description of corner evidence found:

Corner established by traverse and computation from previously established 1/4 corners.
Corner sets 20.34 chains from W 1/4 corner bearing S 89° 03' 05" E and 19.67 chains
S 0° 41' 19" E.

Description of monument and accessories I established to perpetuate the original location of this corner.

Set 1½" iron pipe with 2" brass cap projecting 24" above ground. Cap stamped:

Marked NBTs - Sugar 7" N52°E, 36.7 links, scribed 1/16 BT.
Maple 6" N61°W, 27.1 links, scribed 1/16 BT.

S498
T36N R12E
WC 1/16 S 32
CPI-1977

Dated at Rhineland, Wis., this 6th day of April, 19 77.

Signature Philip T. Hansen Title Registered Land Surveyor Registration No. S-498
(County Surveyor, Registered Land Surveyor, or other duly authorized official)

Office of Register of Deeds, County of Forest, I hereby certify that the within
instrument was filed in this office for record on the 5th day of May, 19 77
at 4:00 o'clock P. M.

Eugene Stutzman
(Register of Deeds)

By _____ Deputy

DOCUMENT NUMBER
111369

FORM 985

43612-32 2030