

CERTIFIED LAND CORNER RESTORATION

Index No. WX-7

State of Wisconsin }
County of Forest } ss.


I Philip T. Hansen, do hereby certify that on the 22nd day of March, 19 77, I ~~found~~ ^{established} ~~the~~ 1/32 between C_{1/2} & NC 1/16 corner of Section 32 Township 36, North, Range 12 East, Fourth Principal Meridian, as described hereon; and that from this evidence I established a new monument and accessories as described hereon to perpetuate the original location of this corner.

Resident witnesses:

Glen Barker

Jim Claflin

Herb Wagoner

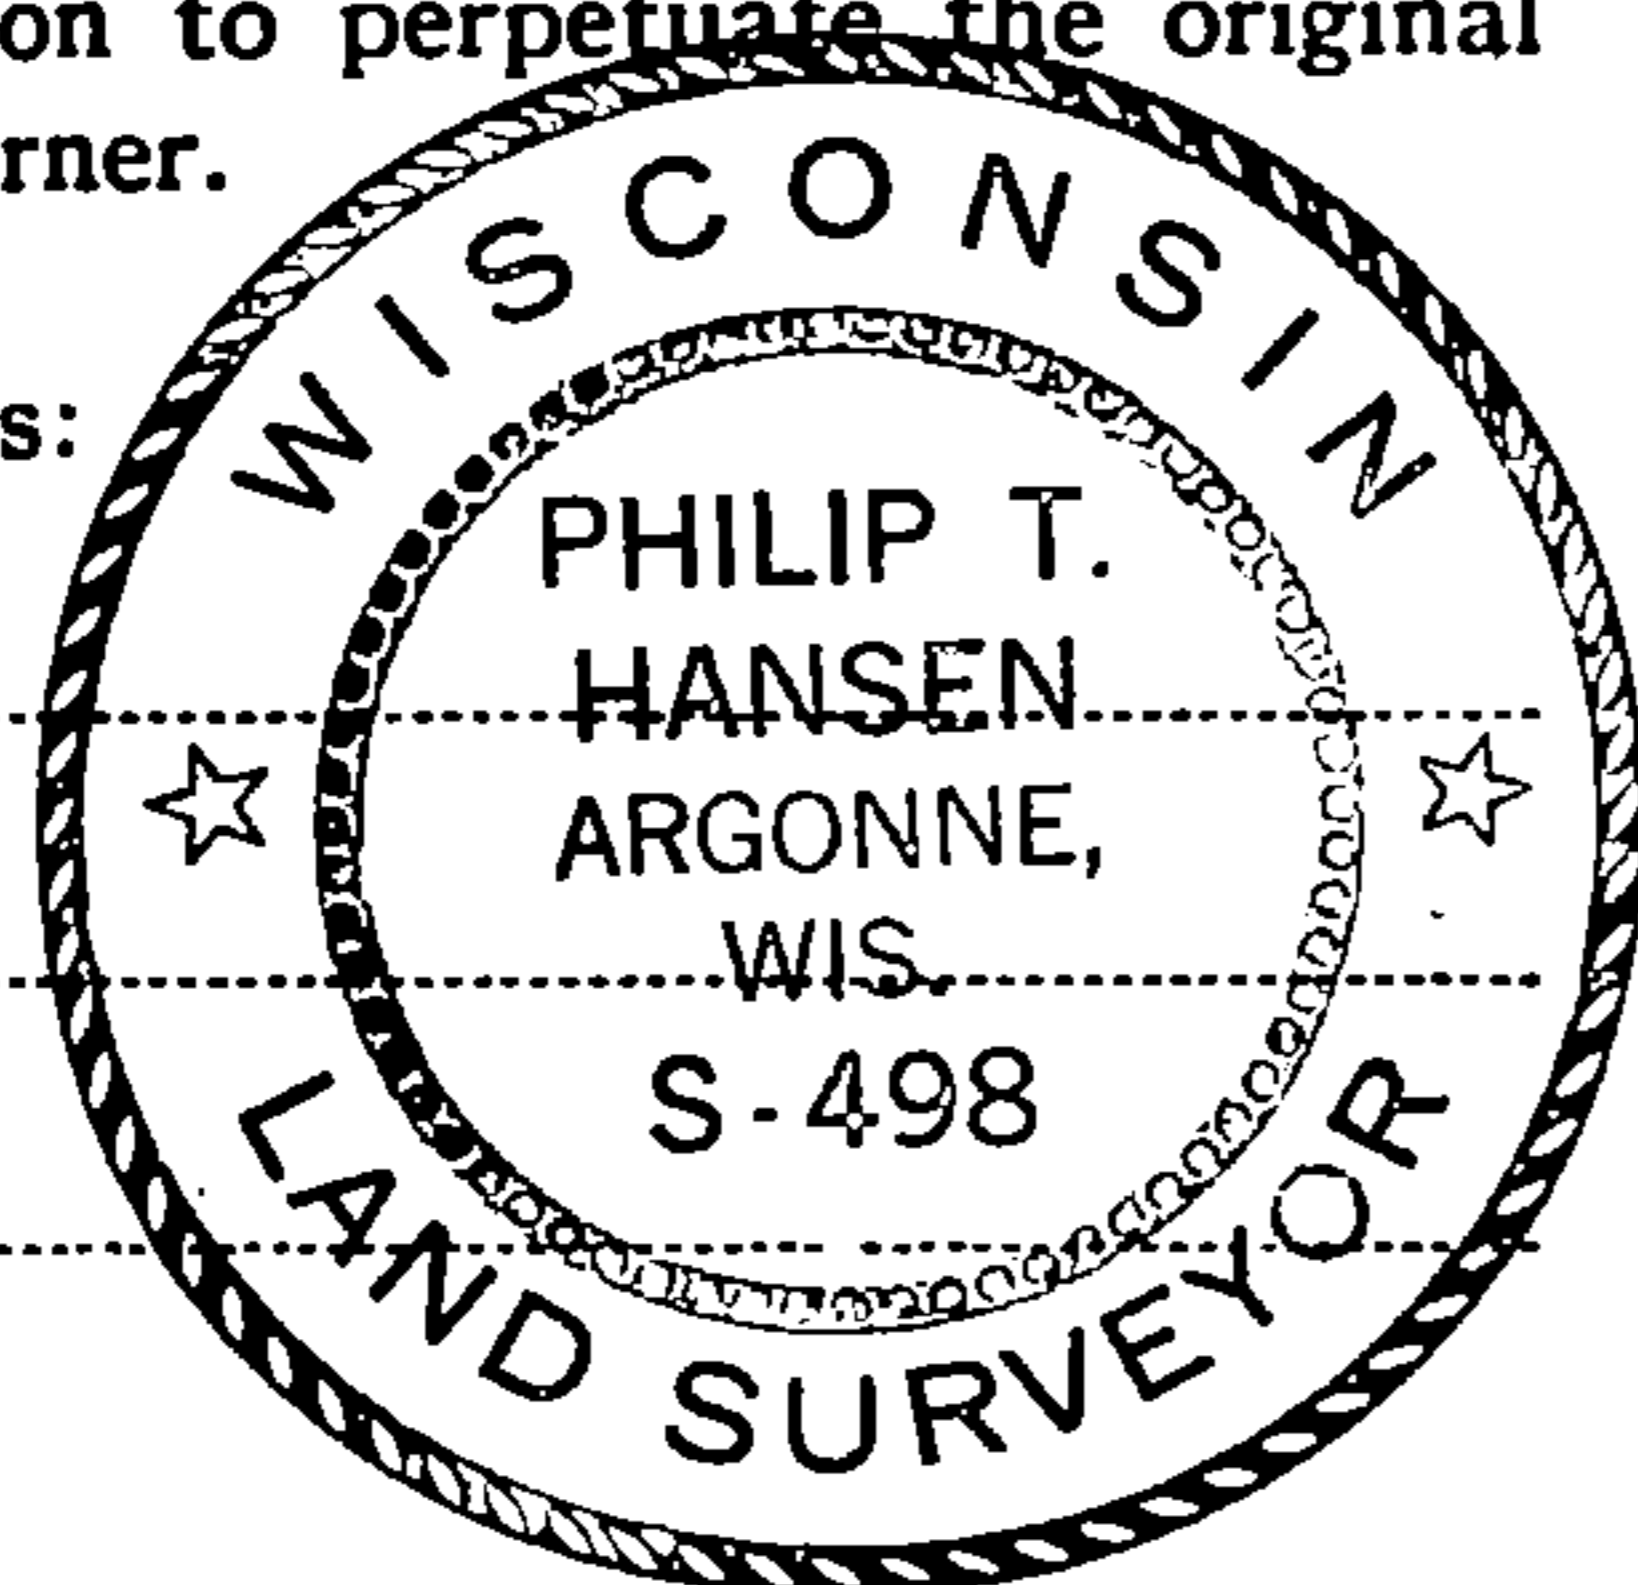

History of original corner establishment:

No records of any corner having been previously established.

Description of corner evidence found:

Corner established by traverse and computation by proportional measurement. Set Corner at 9.865 chains, intermediate between C 1/2 and NC 1/16 corner. Bearing N 0° 33' 28" E.


Description of monument and accessories I established to perpetuate the original location of this corner.

Set 1 1/2" iron pipe with 2" brass cap, stamped: Monument projects 8" above ground.

Marked NBTs - Tamarack 7" S 57° E, 89.3 links, scribed 1/32 BT.
Tamarack 7" N 68° E, 87.4 links, scribed 1/32 BT.

S498
T36N R12E
1/32 S | 32
CPI-1977

FORM 985

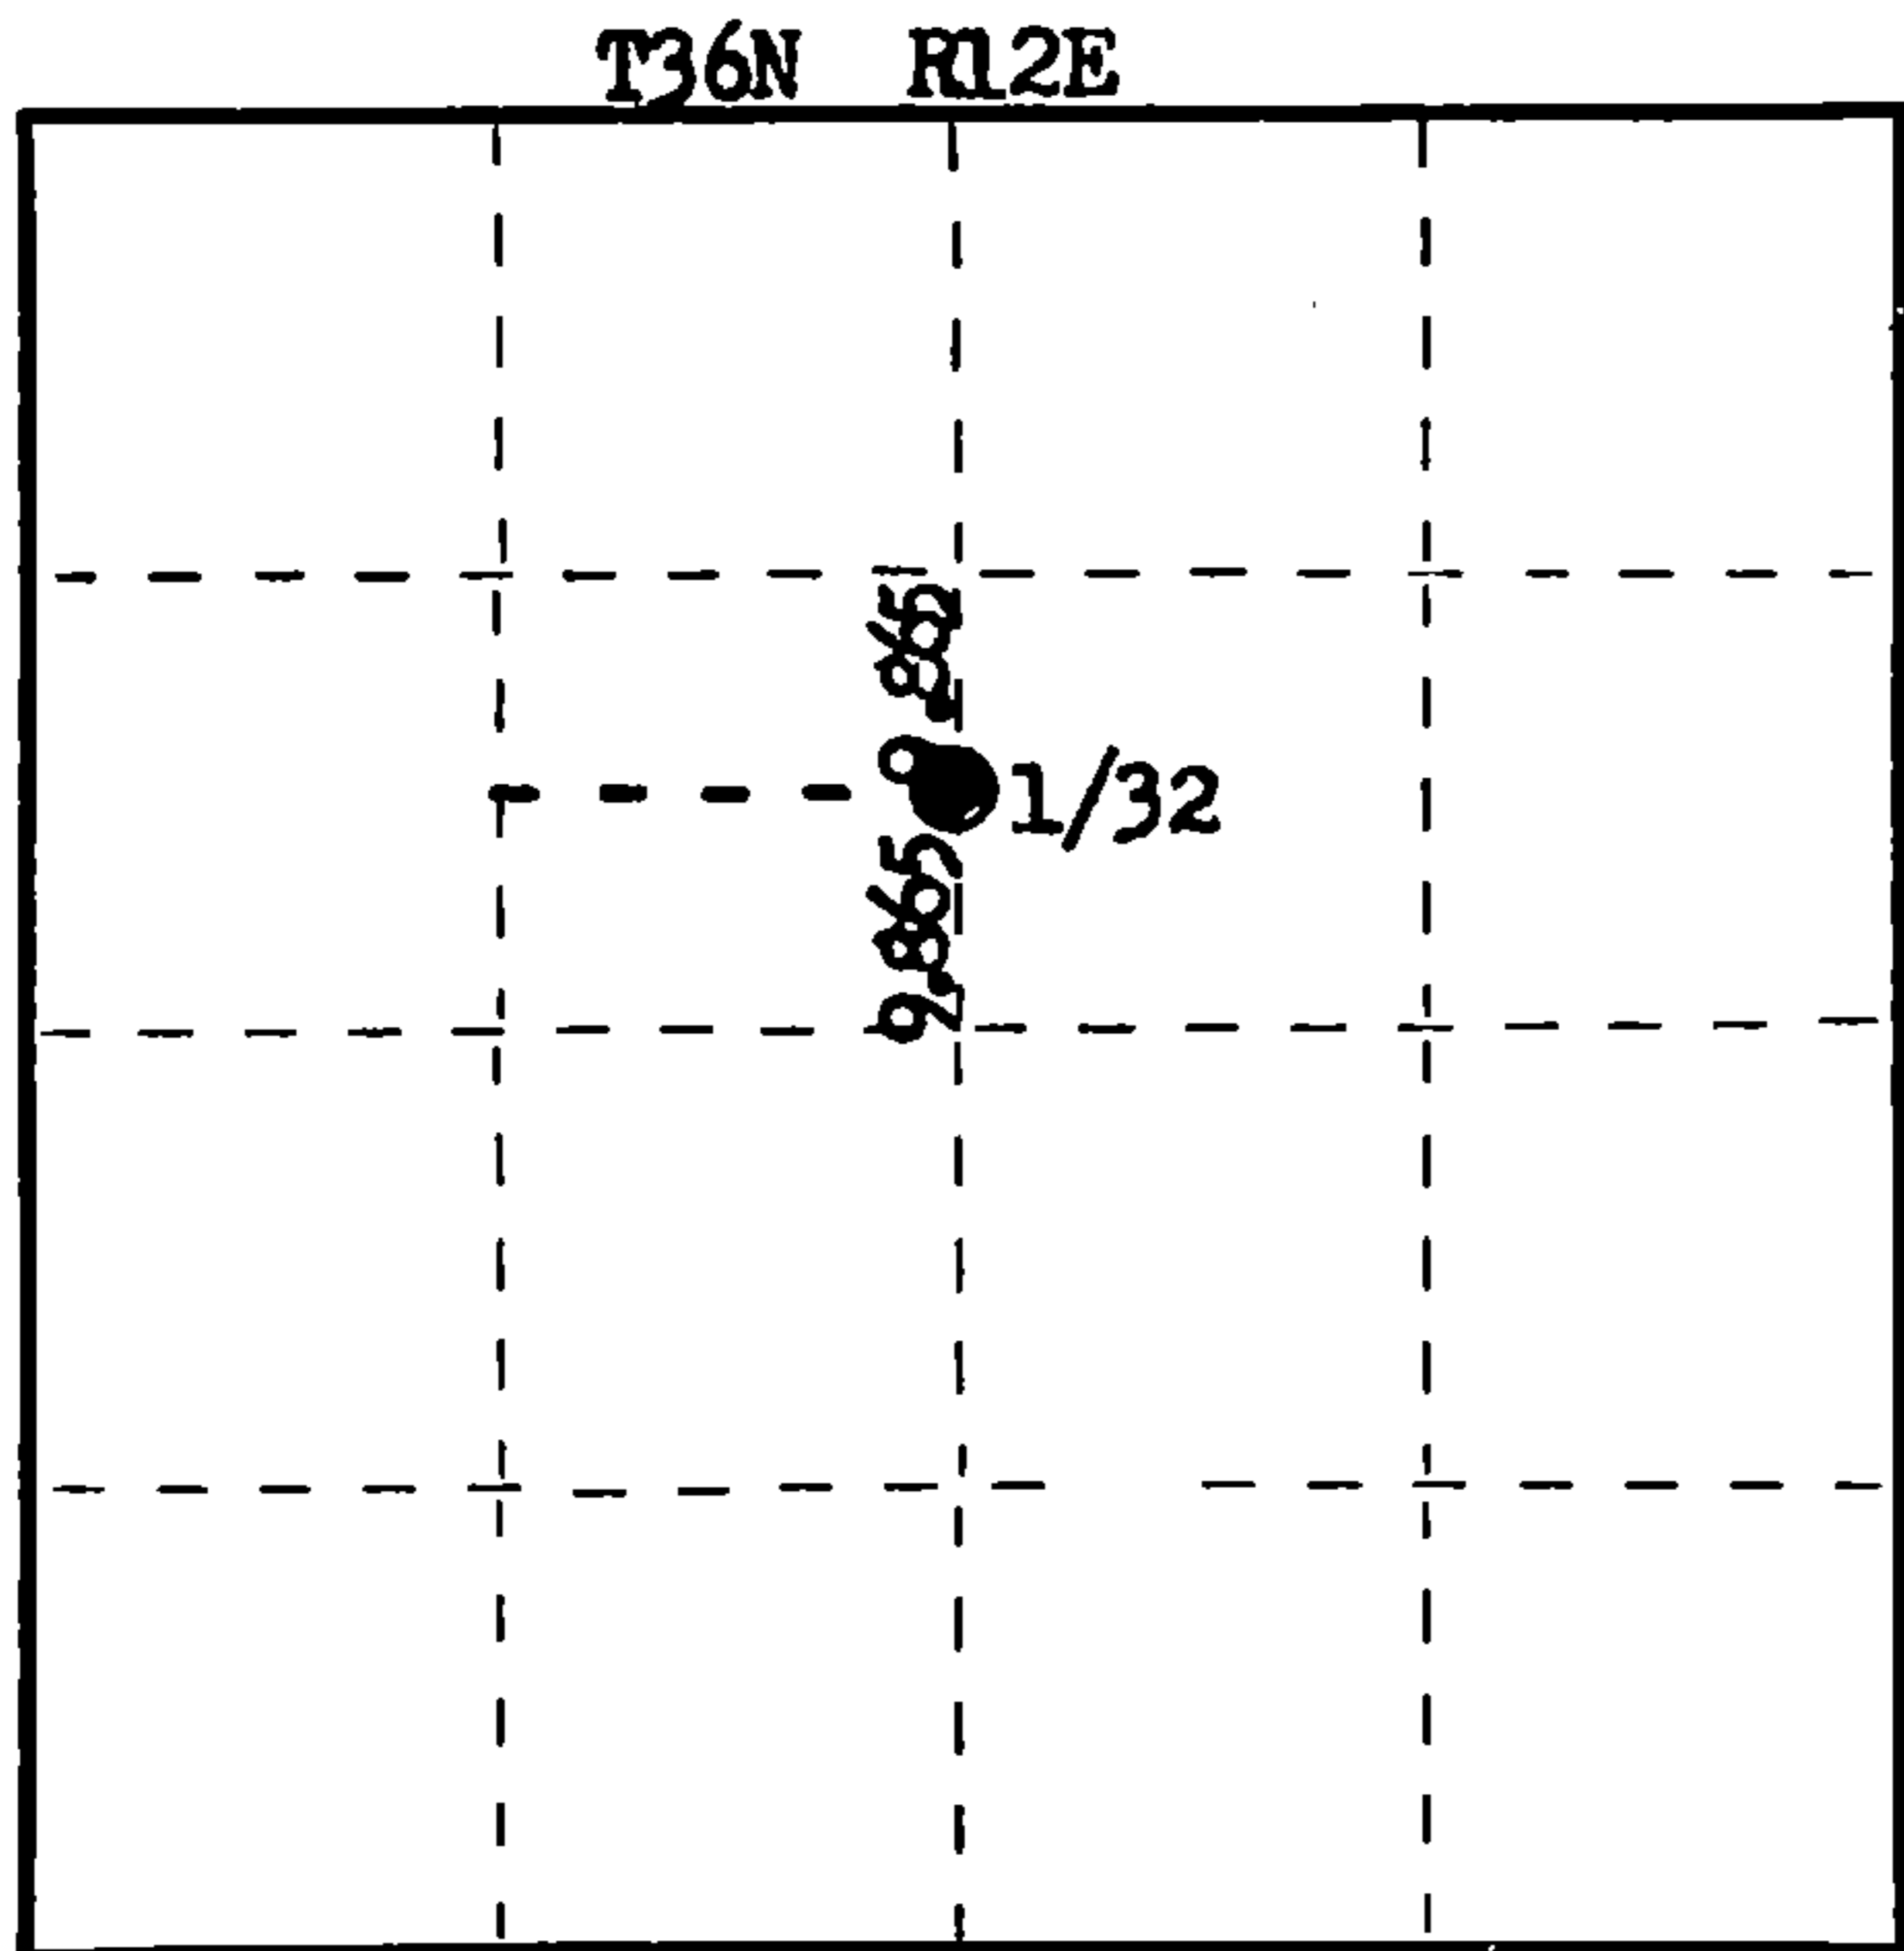

○ = Corner monument restored.

Dated at Rhineland, Wis., this 25th day of April, 19 77.

Signature Philip T. Hansen Title Registered Land Surveyor Registration No. S-498
(County Surveyor, Registered Land Surveyor, or other duly authorized official)

Office of Register of Deeds, County of Forest, I hereby certify that the within instrument was filed in this office for record on the 5th day of May, 19 77 at 4:00 o'clock P. M.

Eugene Staszny
(Register of Deeds)

By _____ Deputy

DOCUMENT NUMBER
111368

4361232-2520