

CERTIFIED LAND CORNER RESTORATION

Index No. A-13

State of Wisconsin }
County of Forest } ss.


I Philip T. Hansen, do hereby certify that on the 28th day of January, 1977, I ~~restored~~ **established** the Section Corner corner of Section 33 & 34, 3 & 4 Township 35 & 36, North, Range 12 East, Fourth Principal Meridian, as described hereon; and that from this evidence I established a new monument and accessories as described hereon to perpetuate the original location of this corner.

Resident witnesses:


Glen Barker

Jim Claflin

Herb Wagoner

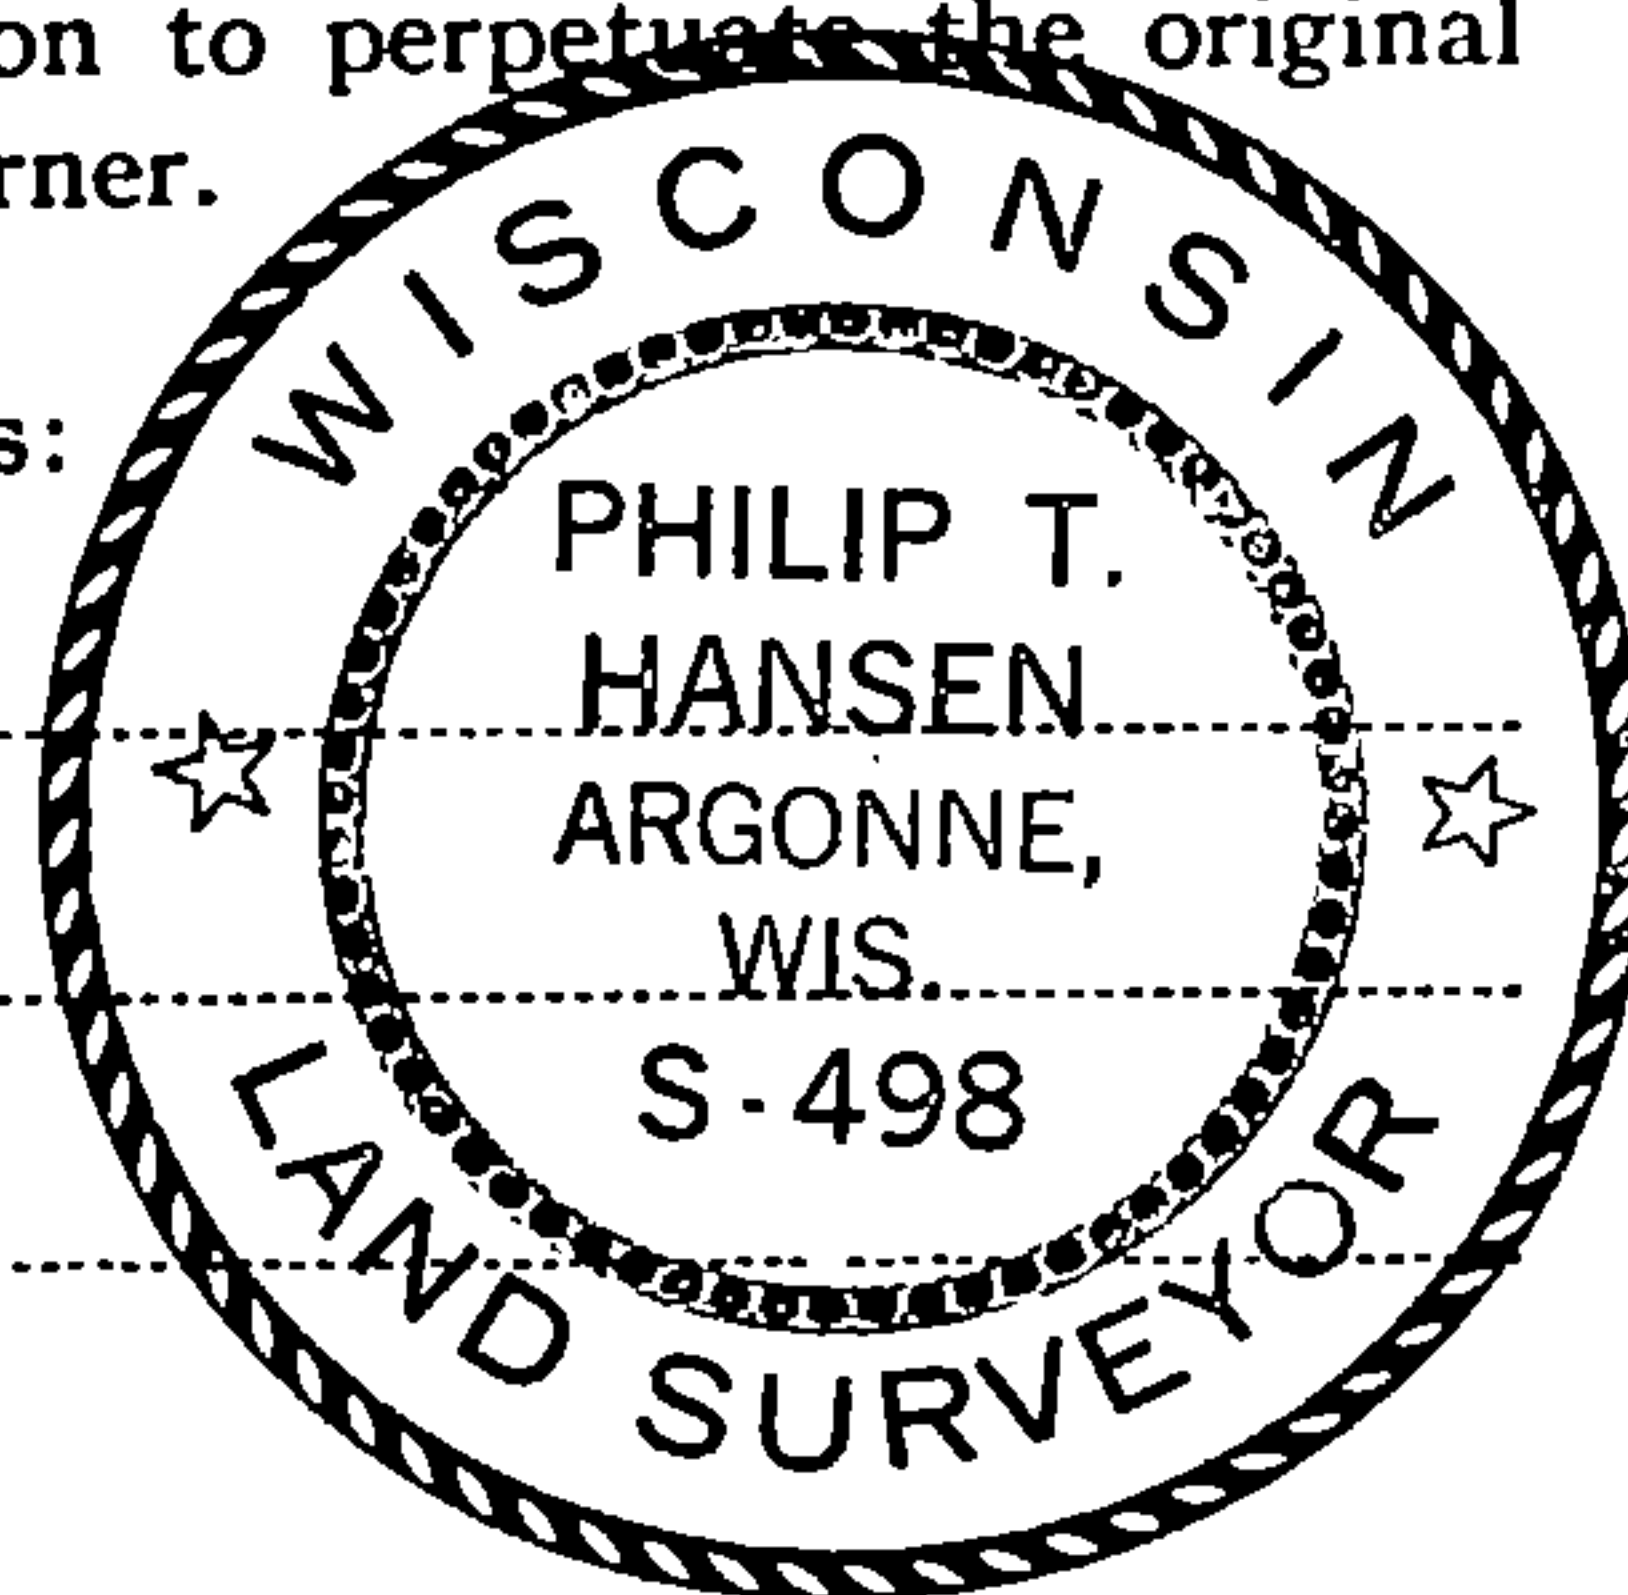

FORM 985 H. C. MILLER CO., MILWAUKEE

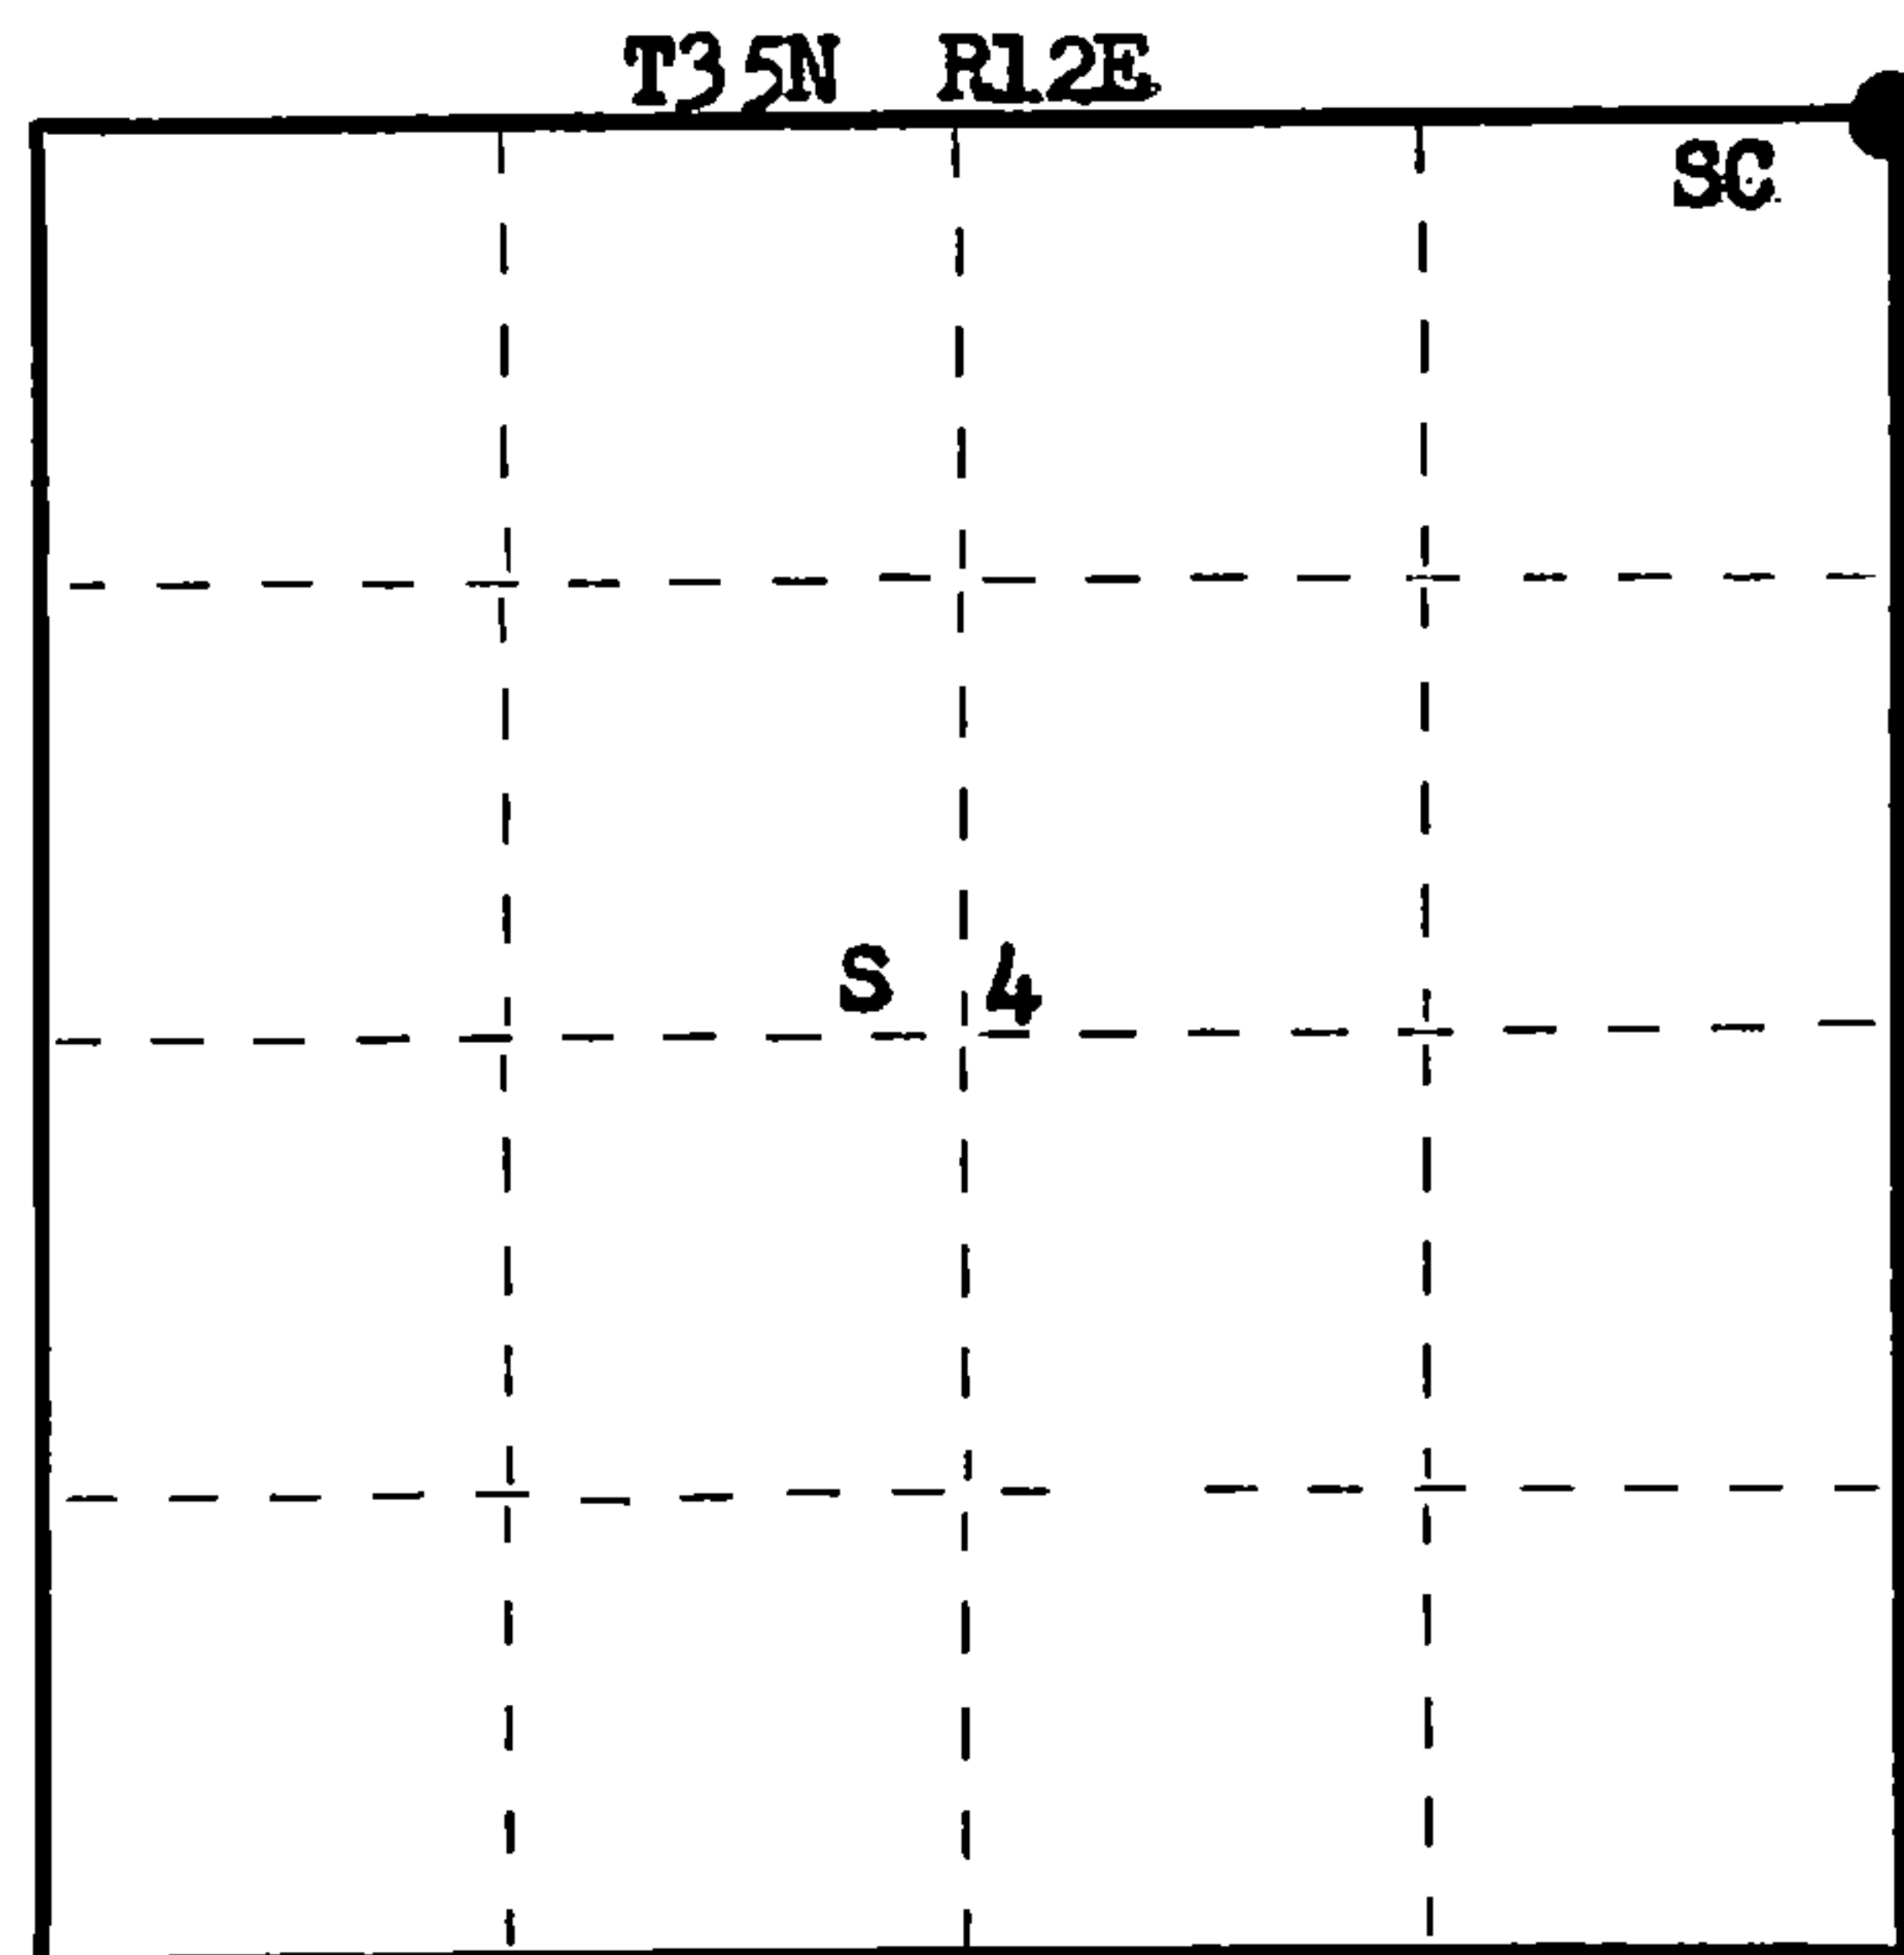

○ = Corner monument restored.

History of original corner establishment:

Corner established by Alfred Millard, Deputy Surveyor, in 1858, from which Sugar 12" bears N20°E, 13 links; Sugar 12" bears N28°W, 28 links; Sugar 12" bears S55°E, 37 links and Yellow Birch 8" bears S20°W, 11 links.

Description of corner evidence found:

No evidence of corner or BTs recovered. Accepted the intersection of the centerline of Walnut Hill Road (N-S) and the centerline of Sipple Road east for corner. This has been accepted by local land owners and by Town of Nashville and Town of Crandon for many years.

Description of monument and accessories I established to perpetuate the original location of this corner.

Drove a 1 1/2" x 12" iron pipe 4" below the surface of the road to mark the true corner. Set a 2 1/2" Berntsen A-1 Federal Monument for Witness Corner 50 links east.

Monument projects 1 ft. above ground, cap stamped:

NBTs - Sugar 10" N58°W, 26.4 links
Sugar 8" N70°E, 117.7 links
Sugar 6" S36°W, 67.9 links, scribed SC BT.

T36N R12E
Sec. 33 | 34 W.C.
4 | 3
T35N R12E
E 50 lks to Cor.
S498 1977

43612330000

Dated at Rhineland, Wis., this 5th day of April, 1977

Signature Philip T. Hansen Title Registered Land Surveyor Registration No. S-498
(County Surveyor, Registered Land Surveyor, or other duly authorized official)

Office of Register of Deeds, County of Forest, I hereby certify that the within instrument was filed in this office for record on the 5th day of May, 1977 at 4:00 o'clock P. M.

Eugene Staszny
(Register of Deeds)

DOCUMENT NUMBER

111358

By..... Deputy