

CERTIFIED LAND CORNER RESTORATION

Index No. Y-12

State of Wisconsin }
County of Forest } ss.

History of original corner establishment:
No evidence or records of Corner previously established.

I Philip T. Hansen, do hereby certify that on the 17th day of March, 19 77, I ~~found~~ ~~located~~ evidence of the SE 1/16 corner of Section 32 Township 36 North, Range 12 East, Fourth Principal Meridian, as described hereon; and that from this evidence I established a new monument and accessories as described hereon to perpetuate the original location of this corner.

Description of corner evidence found:


Corner established by traverse and computations from E 1/16 corner between Section 33 & 4 and EC 1/16 corner and S 1/16 corner between S 1/16 between Section 33 & 34 and the SC 1/16 corner sets N 6° 49' 38" E, 22.426 chains from E 1/16 corner and S 86° 36' 22" W of S 1/16 corner.

Resident witnesses:

Glen Barker

Jim Claflin

Herb Wagoner

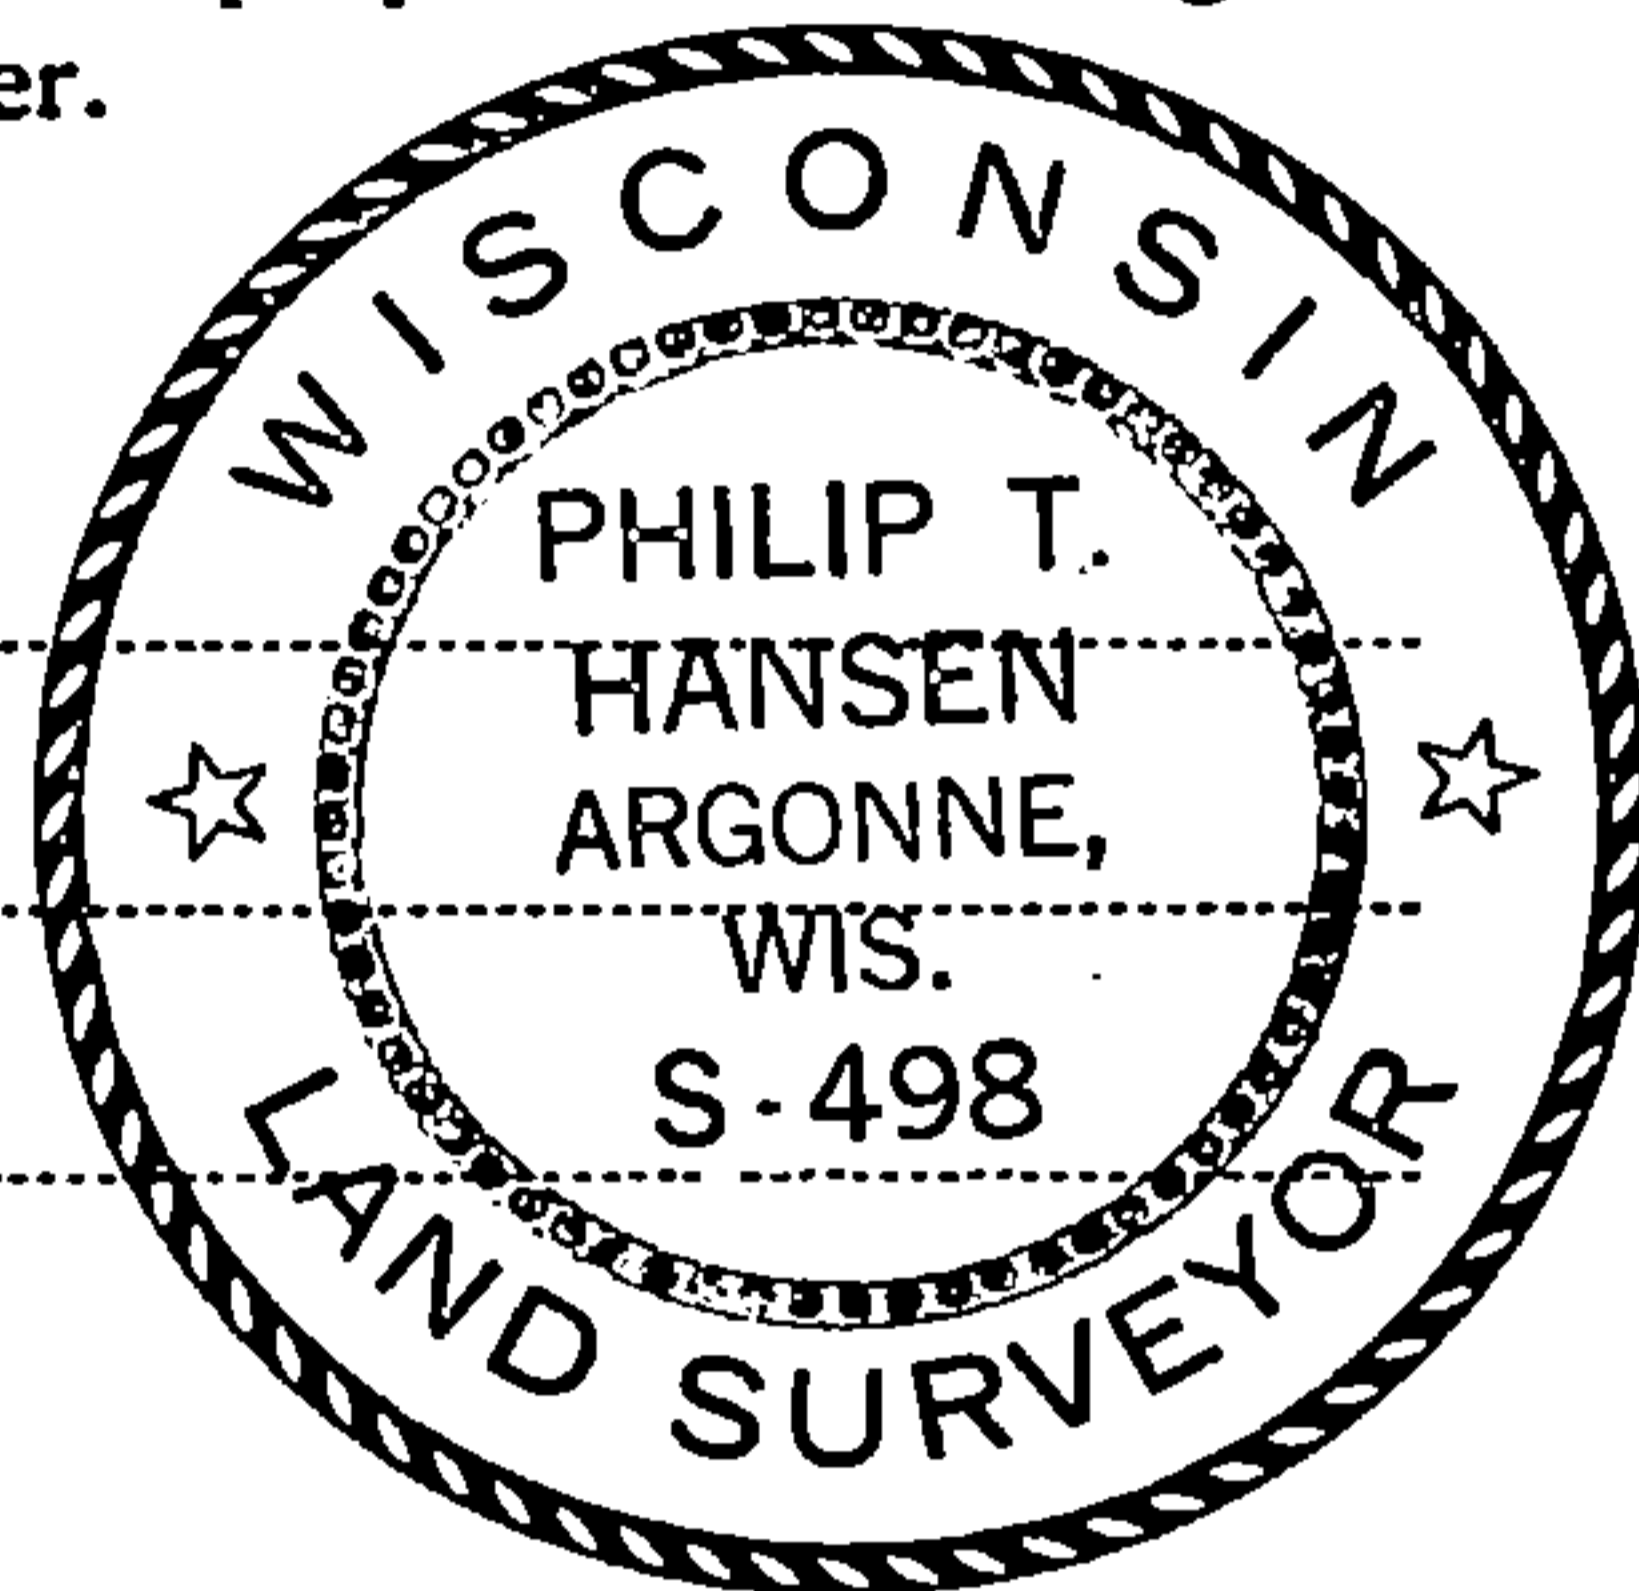


Description of monument and accessories I established to perpetuate the original location of this corner.
Set a 1 1/2" iron pipe with 2" brass cap, projecting 24" above ground, cap stamped:

Marked NBTs - Sugar 12" S27°W, 59 links.
Sugar 7" N20°W, 70.5 links, scribed 1/16 BT.

S498
T36N R12E
SE 1/16 S | 33
CPI-1977

FORM 985

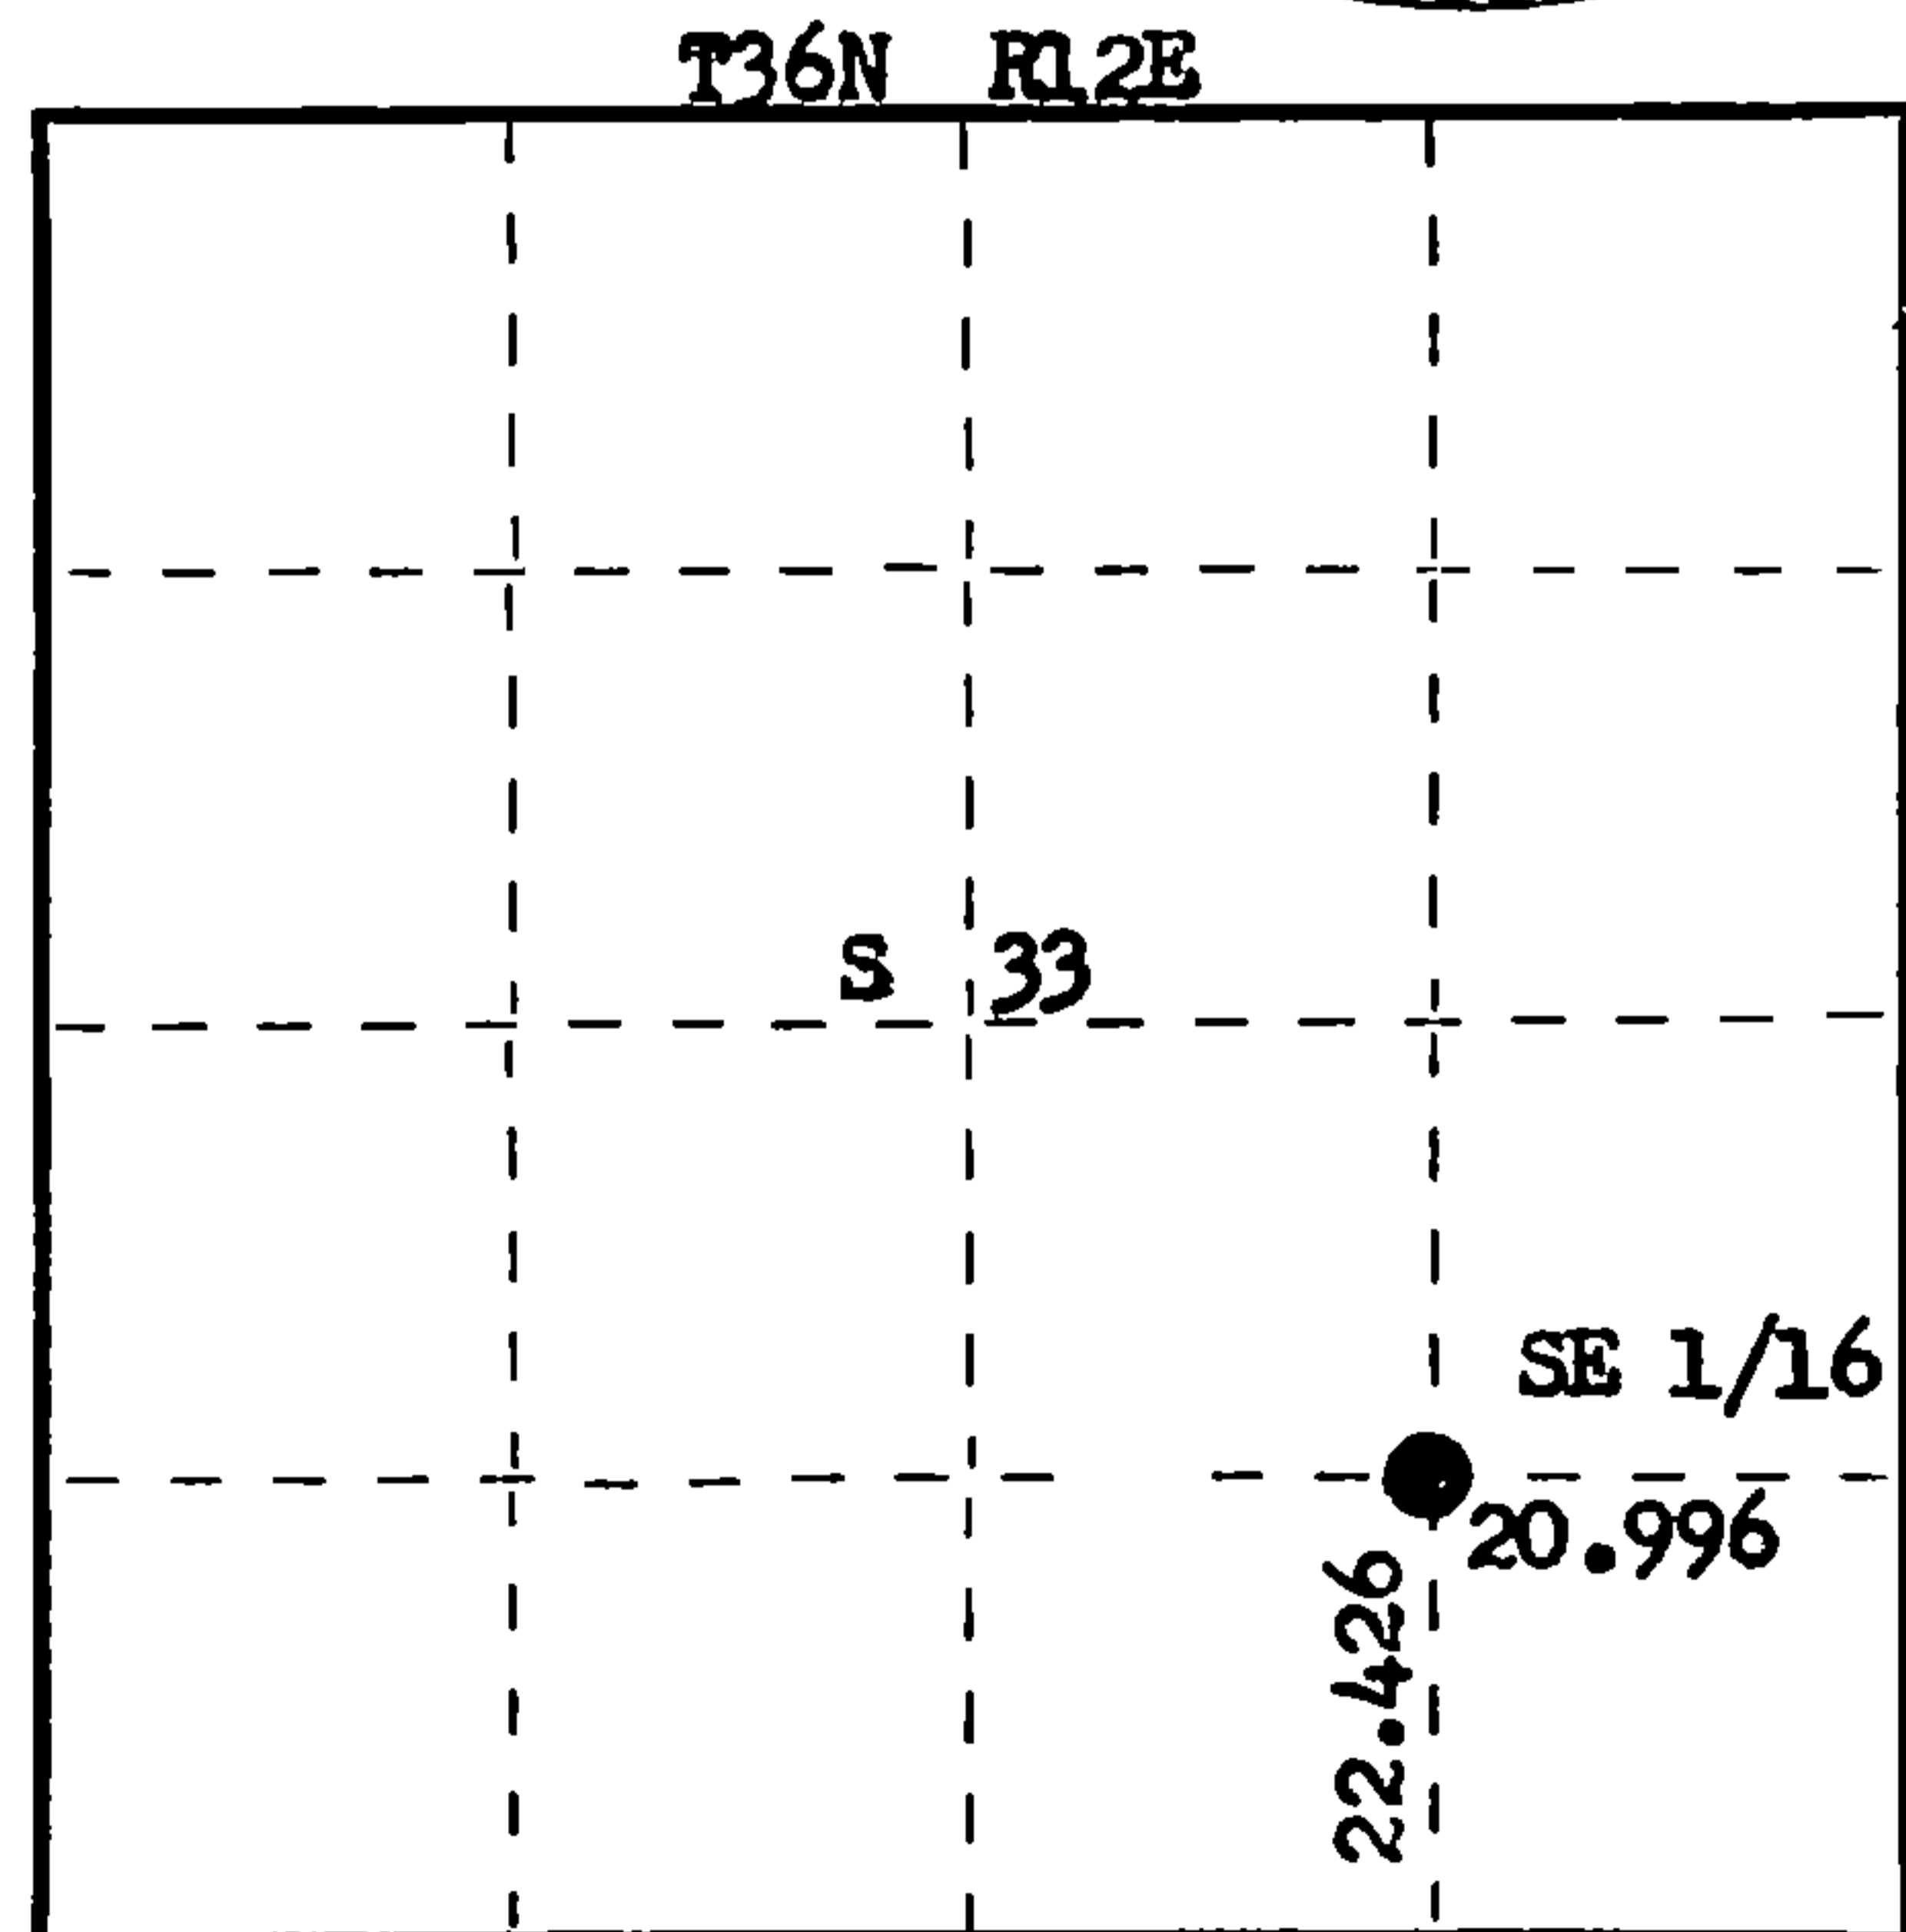

○ = Corner monument restored.

Dated at Rhineland, Wis., this 6th day of April, 1977

Signature Philip T. Hansen Title Registered Land Surveyor Registration No. S-498
(County Surveyor, Registered Land Surveyor, or other duly authorized official)

Office of Register of Deeds, County of Forest, I hereby certify that the within instrument was filed in this office for record on the 5th day of May, 1977 at 4:00 o'clock P. M.

Eugene Rotz
(Register of Deeds)

DOCUMENT NUMBER
111379

By..... Deputy

43612331010