

CERTIFIED LAND CORNER RESTORATION

Index No. Y-11

State of Wisconsin }
County of Forest } ss.


I Philip T. Hansen, do hereby certify that on the 10th day of March, 1977, I ~~found~~ established ~~at~~ the SC 1/16 corner of Section 33 Township 36, North, Range 12 East, Fourth Principal Meridian, as described hereon; and that from this evidence I established a new monument and accessories as described hereon to perpetuate the original location of this corner.

Resident witnesses:

Glen Barker

Jim Claflin

Herb Wagoner

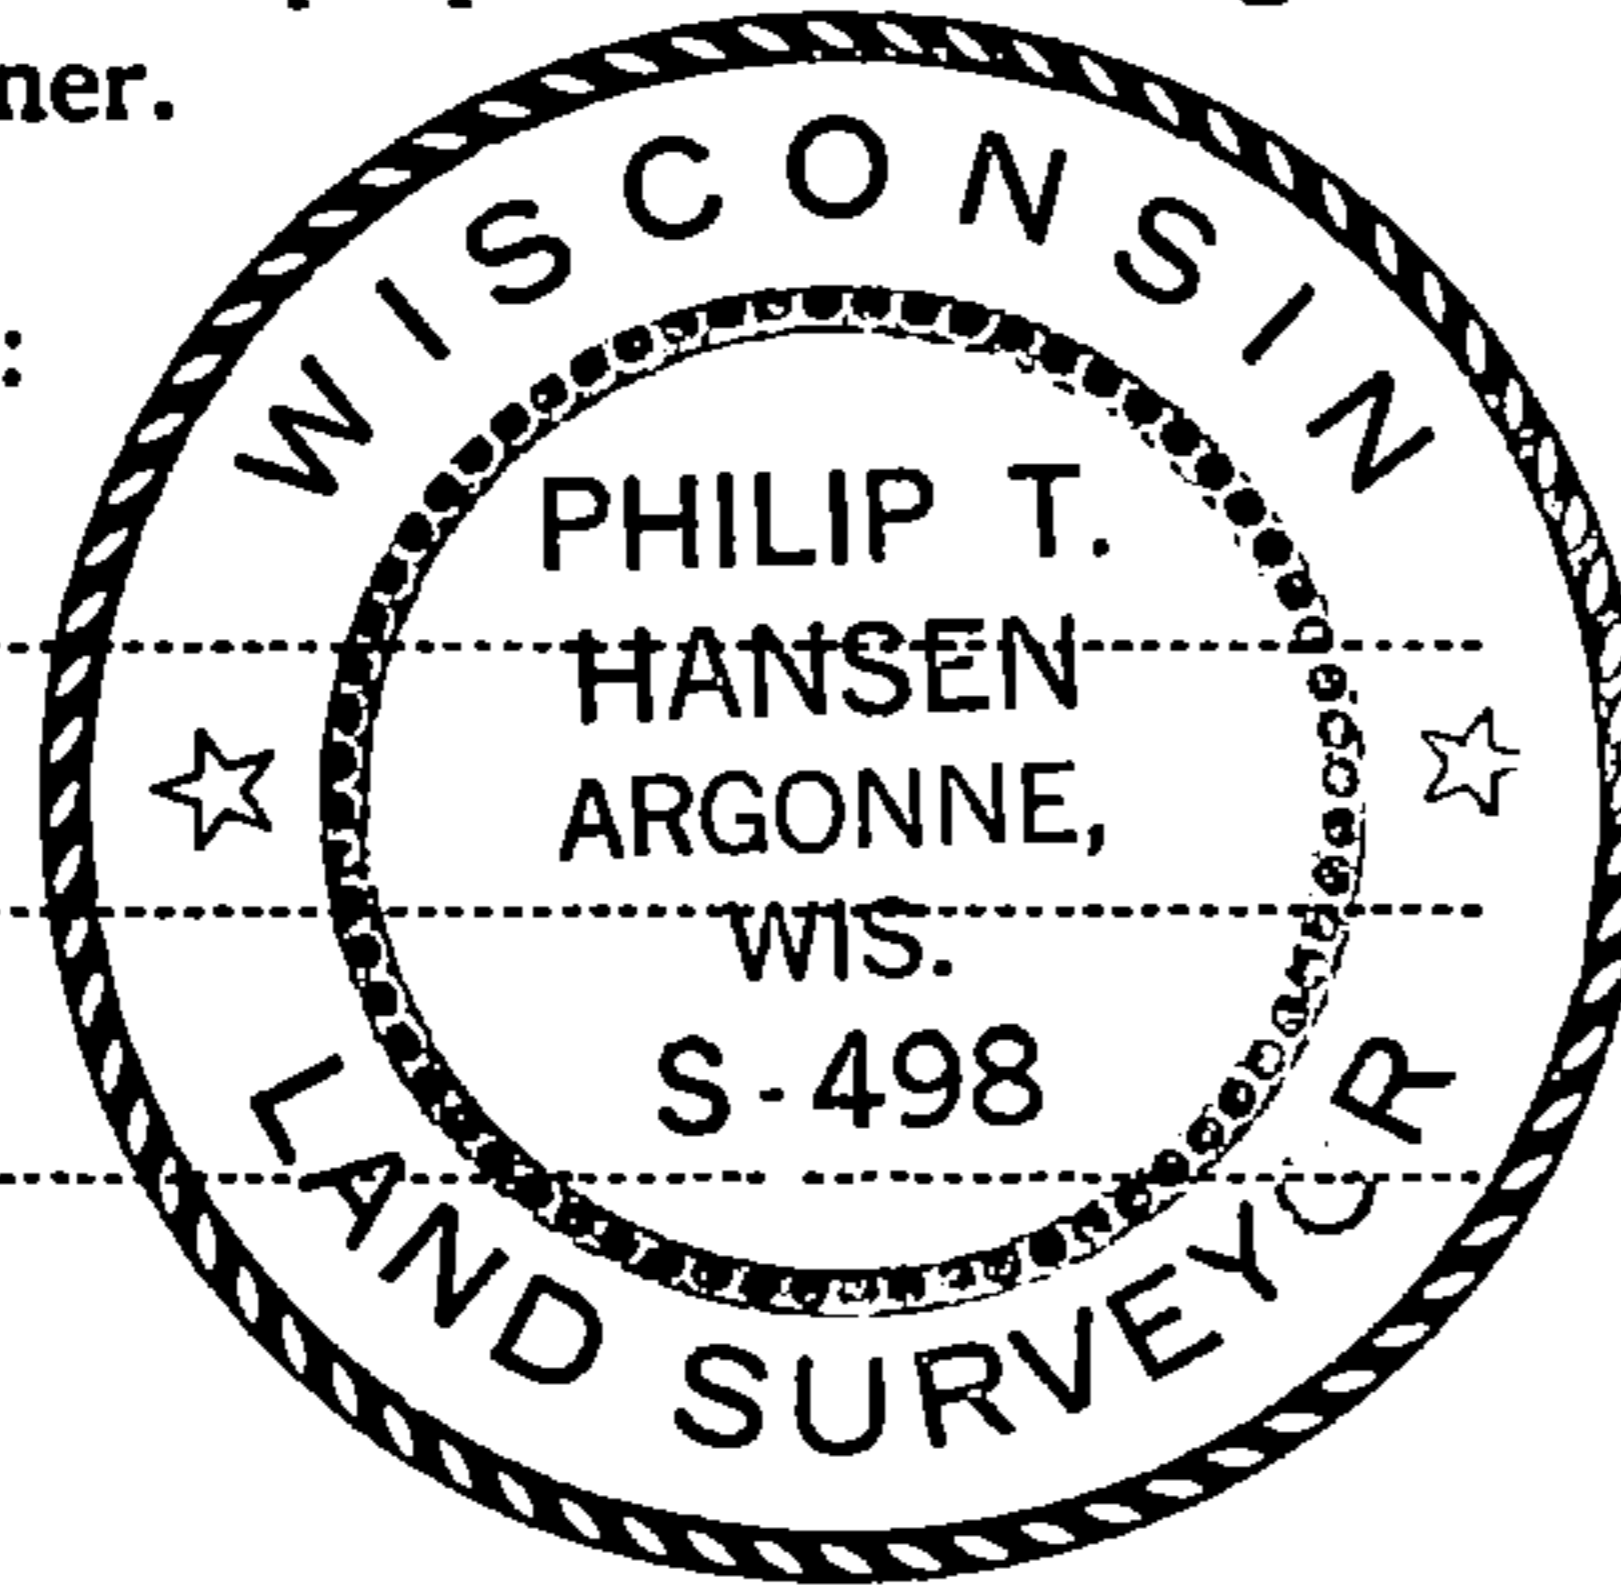

Description of corner evidence found:


Corner established by measurements by traverse from previously established S 1/4 corner and C 1/4 corner. Corner sets 21.431 chains N 3° 51' 46" E from S 1/4 corner and S 86° 36' 22" W 20.999 chains from SE 1/16 corner.

Description of monument and accessories I established to perpetuate the original location of this corner.

Set 1 1/2" iron pipe with 2" brass cap, projecting 24" above ground. Cap stamped: Marked NBTs - Sugar 6" N57°E, 76.5 links, scribed 1/16 BT. Maple 6" N 3° W, 76.5 links, scribed 1/16 BT.

S498
T36N R12E
SC 1/16 S 33
CPI-1977

FORM 985

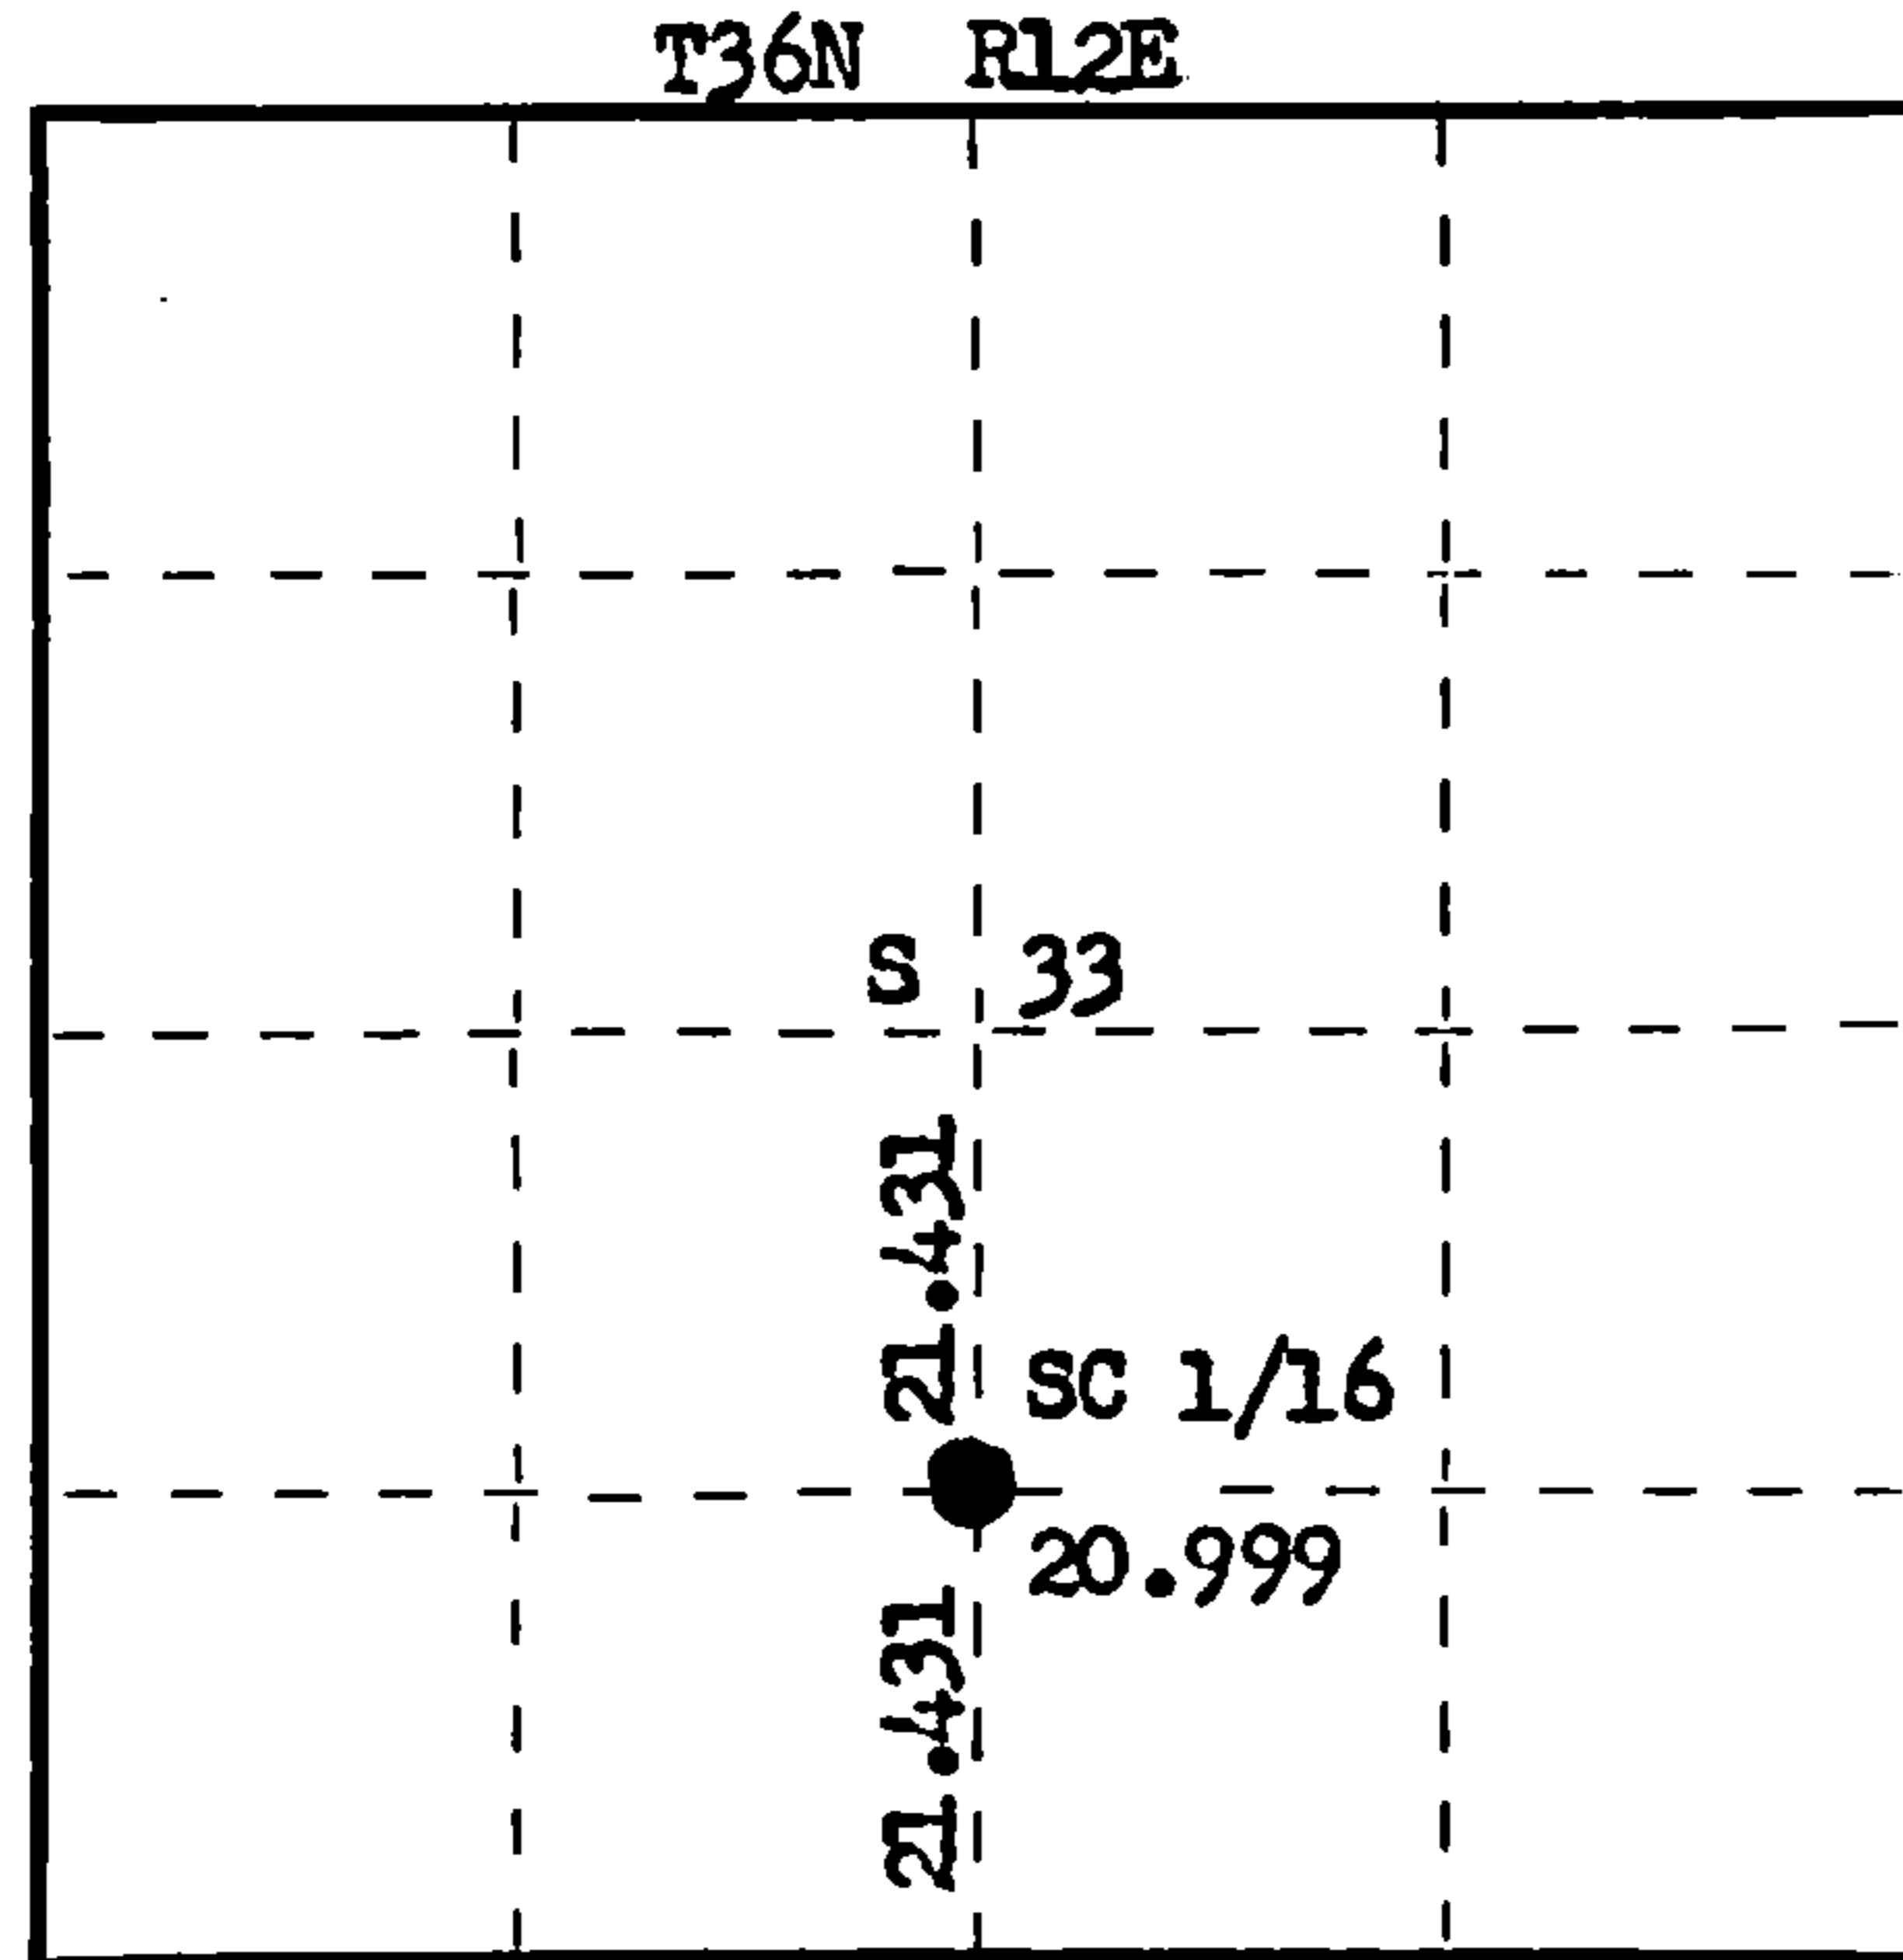

○ = Corner monument restored.

Dated at Rhineland, Wis., this 6th day of April, 1977

Signature Philip T. Hansen Title Registered Land Surveyor Registration No. S-498
(County Surveyor, Registered Land Surveyor, or other duly authorized official)

Office of Register of Deeds, County of Forest, I hereby certify that the within instrument was filed in this office for record on the 5th day of May, 1977 at 4:00 o'clock P. M.

Eugene Stetson
(Register of Deeds)

By.....Deputy

DOCUMENT NUMBER
111378

43012331020