

CERTIFIED LAND CORNER RESTORATION

Index No. X-11

State of Wisconsin }
County of Forest } ss.


I Philip T. Hansen, do hereby certify that on the 10th day of March, 1977, I ~~found~~ established ~~corner~~ of the C 1/4 corner of Section 33 Township 36, North, Range 12 East, Fourth Principal Meridian, as described hereon; and that from this evidence I established a new monument and accessories as described hereon to perpetuate the original location of this corner.

Resident witnesses:


Glen Barker

Jim Claflin

Herb Wagoner

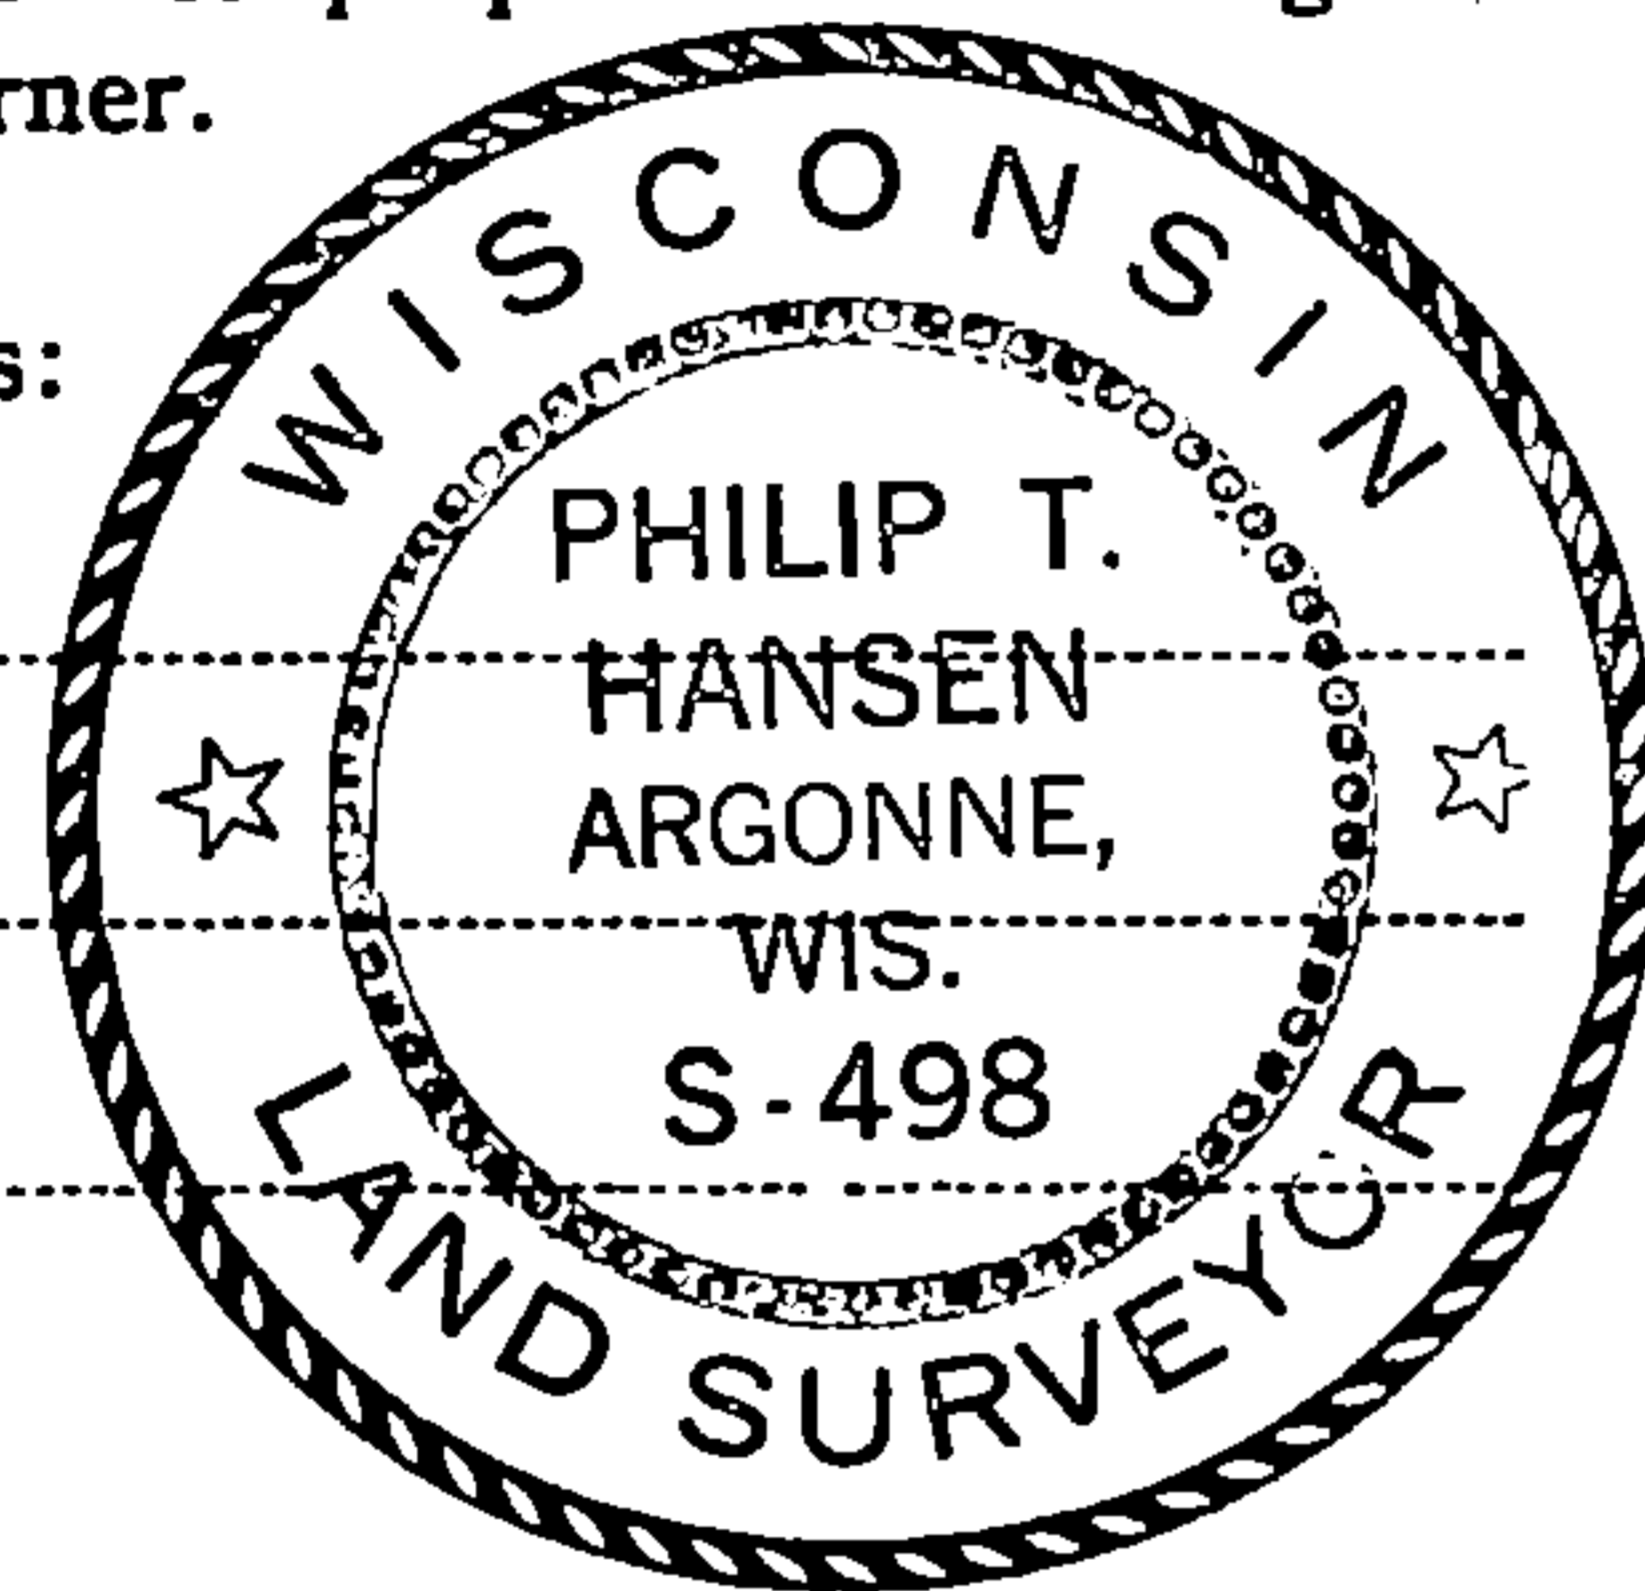

FORM 985
Wisconsin Land Surveyors' Association, Inc.

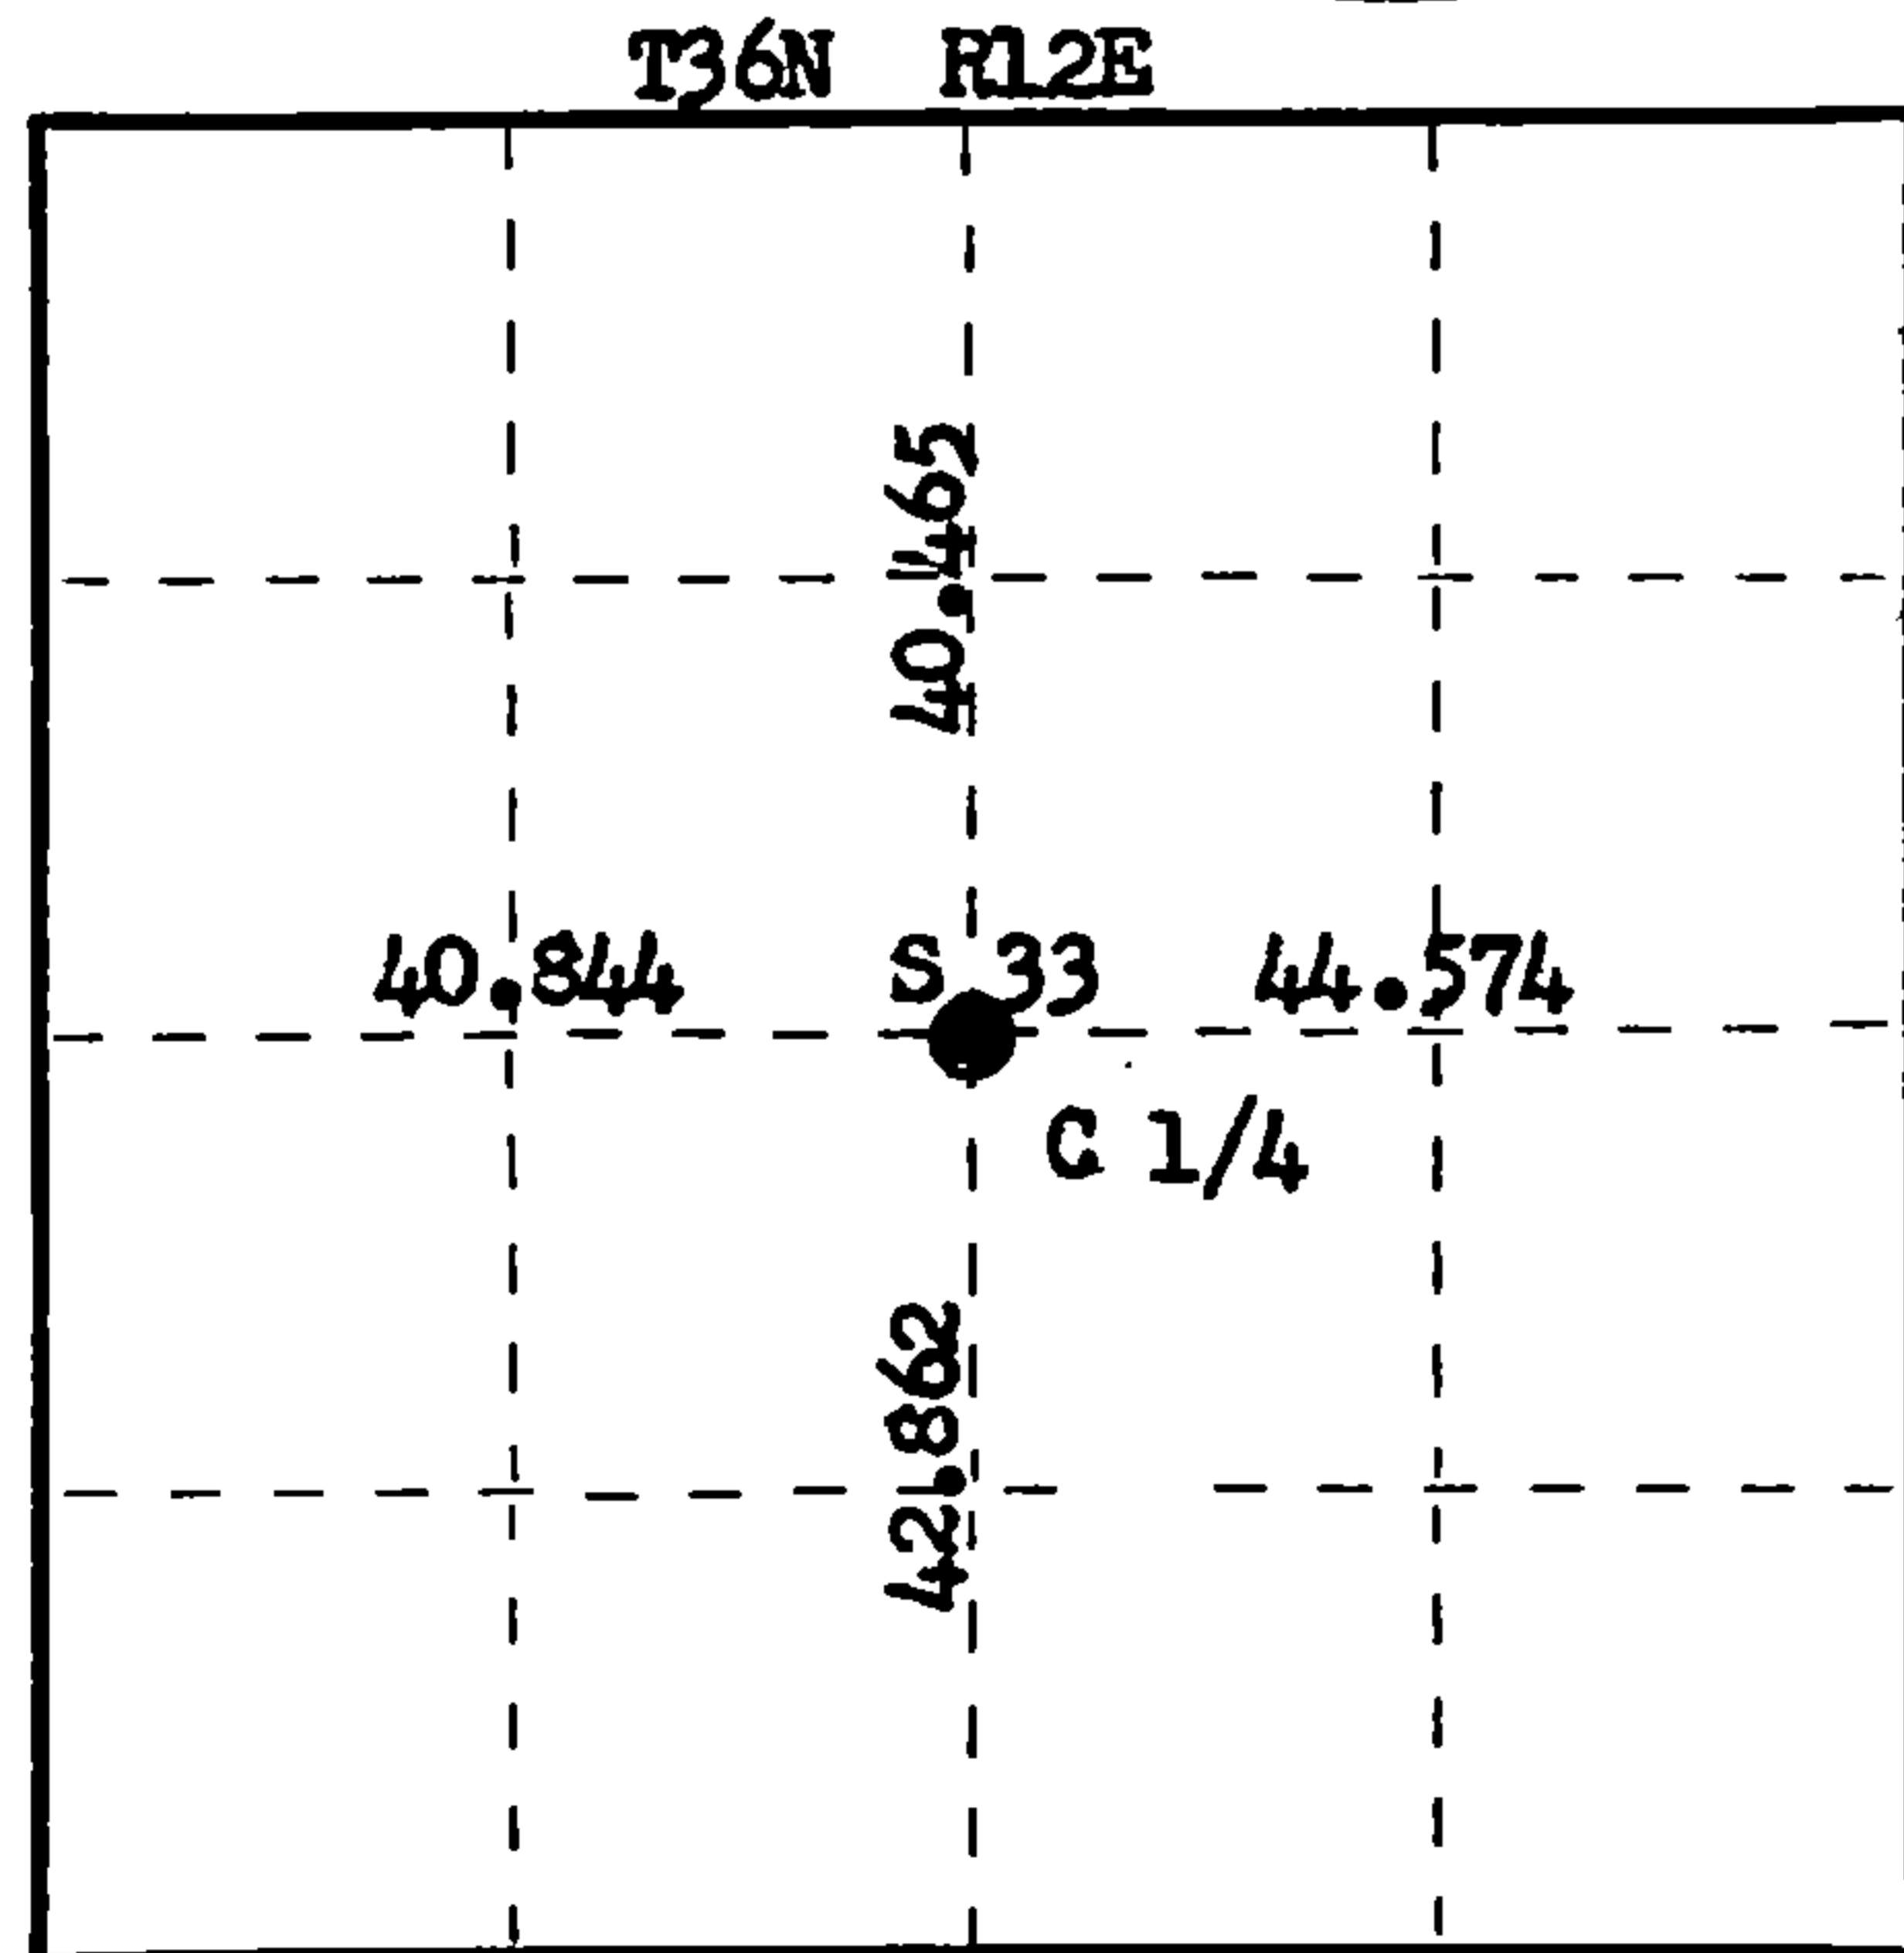

○ = Corner monument restored.

History of original corner establishment:

No evidence or record of survey establishing this corner.

Description of corner evidence found:

Corner set by proportional measurements. From previously established E-W-N-S 1/4 corners established C 1/4 corner by traverse and computation. Set C 1/4 corner at 40.465 chains S 3° 51' 46" W of N 1/4 corner, 44.574 chains S 84° 31' 12" W from E 1/4 corner, 42.862 chains N 3° 51' 46" E of S 1/4 corner and 40.844 chains N 84° 31' 12" E of W 1/4.

Description of monument and accessories I established to perpetuate the original location of this corner.

Set 2 1/2" Berntsen A-1 Federal Monument with alloy cap, aluminum with magnet installed in cap and base. Monument projects 24" above ground, cap stamped:

Marked NBTs - Sugar 8" N18°E, 17.9 links, scribed 1/4 BT.
Sugar 8" N33°W, 76.9 links, scribed 1/4 BT.
Red Oak 12" S88°W, 59.5 links, scribed 1/4 BT.

T36N R12E
C 1/4 S 33
S498 - 1977

Dated at Rhineland, Wis., this 6th day of April, 1977.

Signature Philip T. Hansen Title Registered Land Surveyor Registration No. S-498
(County Surveyor, Registered Land Surveyor, or other duly authorized official)

Office of Register of Deeds, County of Forest, I hereby certify that the within instrument was filed in this office for record on the 5th day of May, 1977 at 4:00 o'clock P. M.

Eugene Staszny
(Register of Deeds)

DOCUMENT NUMBER
111377

By..... Deputy

43612332020