

CERTIFIED LAND CORNER RESTORATION

Index No. W-11

State of Wisconsin }
County of Forest } ss.


I Philip T. Hansen, do hereby certify that on the 10th day of March, 1977, I ~~found~~ ^{Established} evidence of the NC 1/16 corner of Section 33 Township 36, North, Range 12 East, Fourth Principal Meridian, as described hereon; and that from this evidence I established a new monument and accessories as described hereon to perpetuate the original location of this corner.

Resident witnesses:


Glen Barker

Jim Claflin

Herb Wagoner

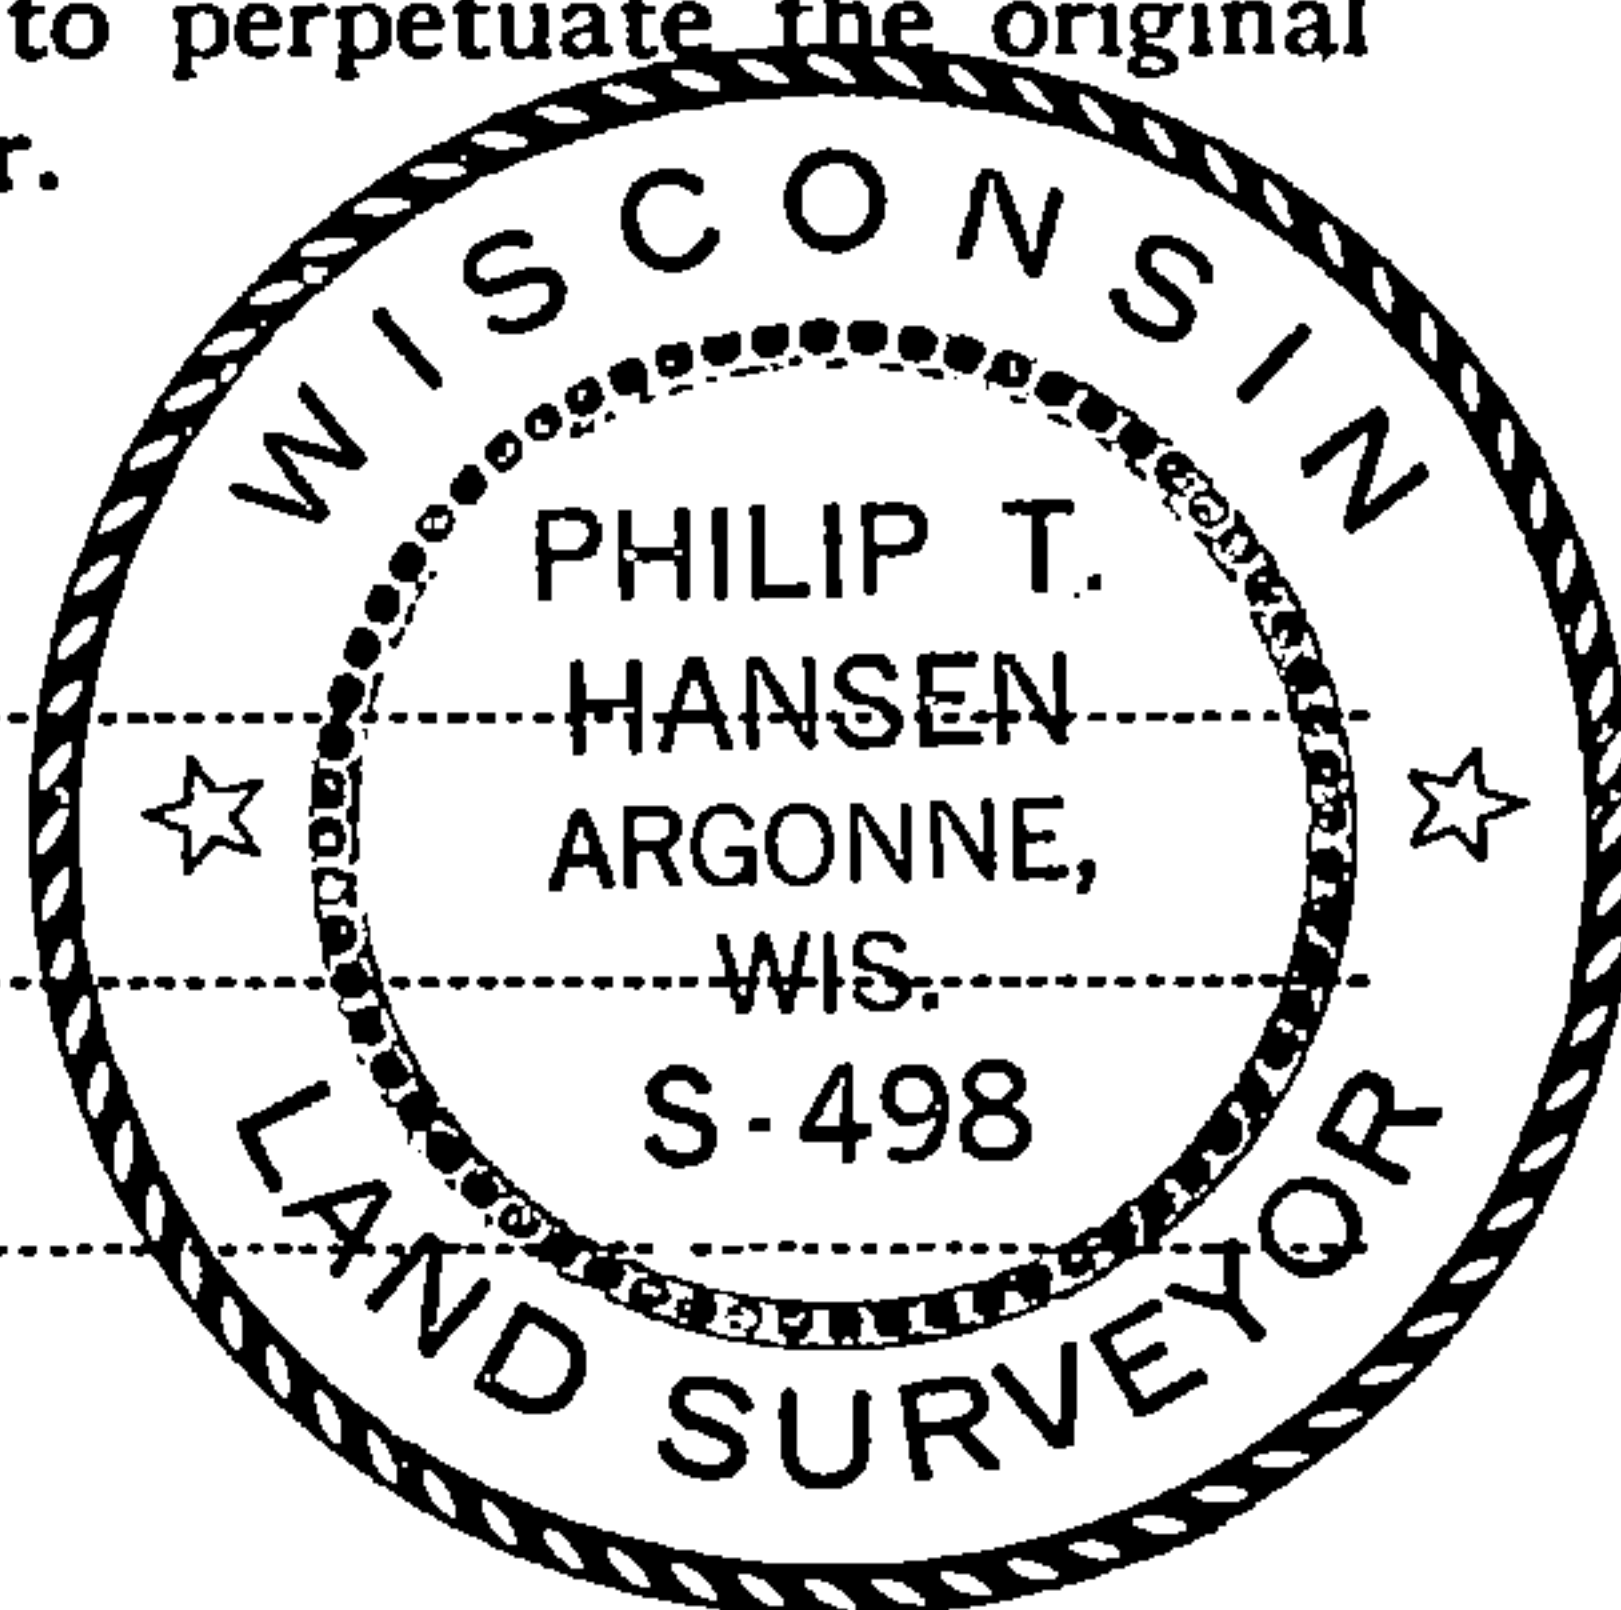

FORM 985
Wisconsin Printing Industry Co.
Madison, Wisconsin

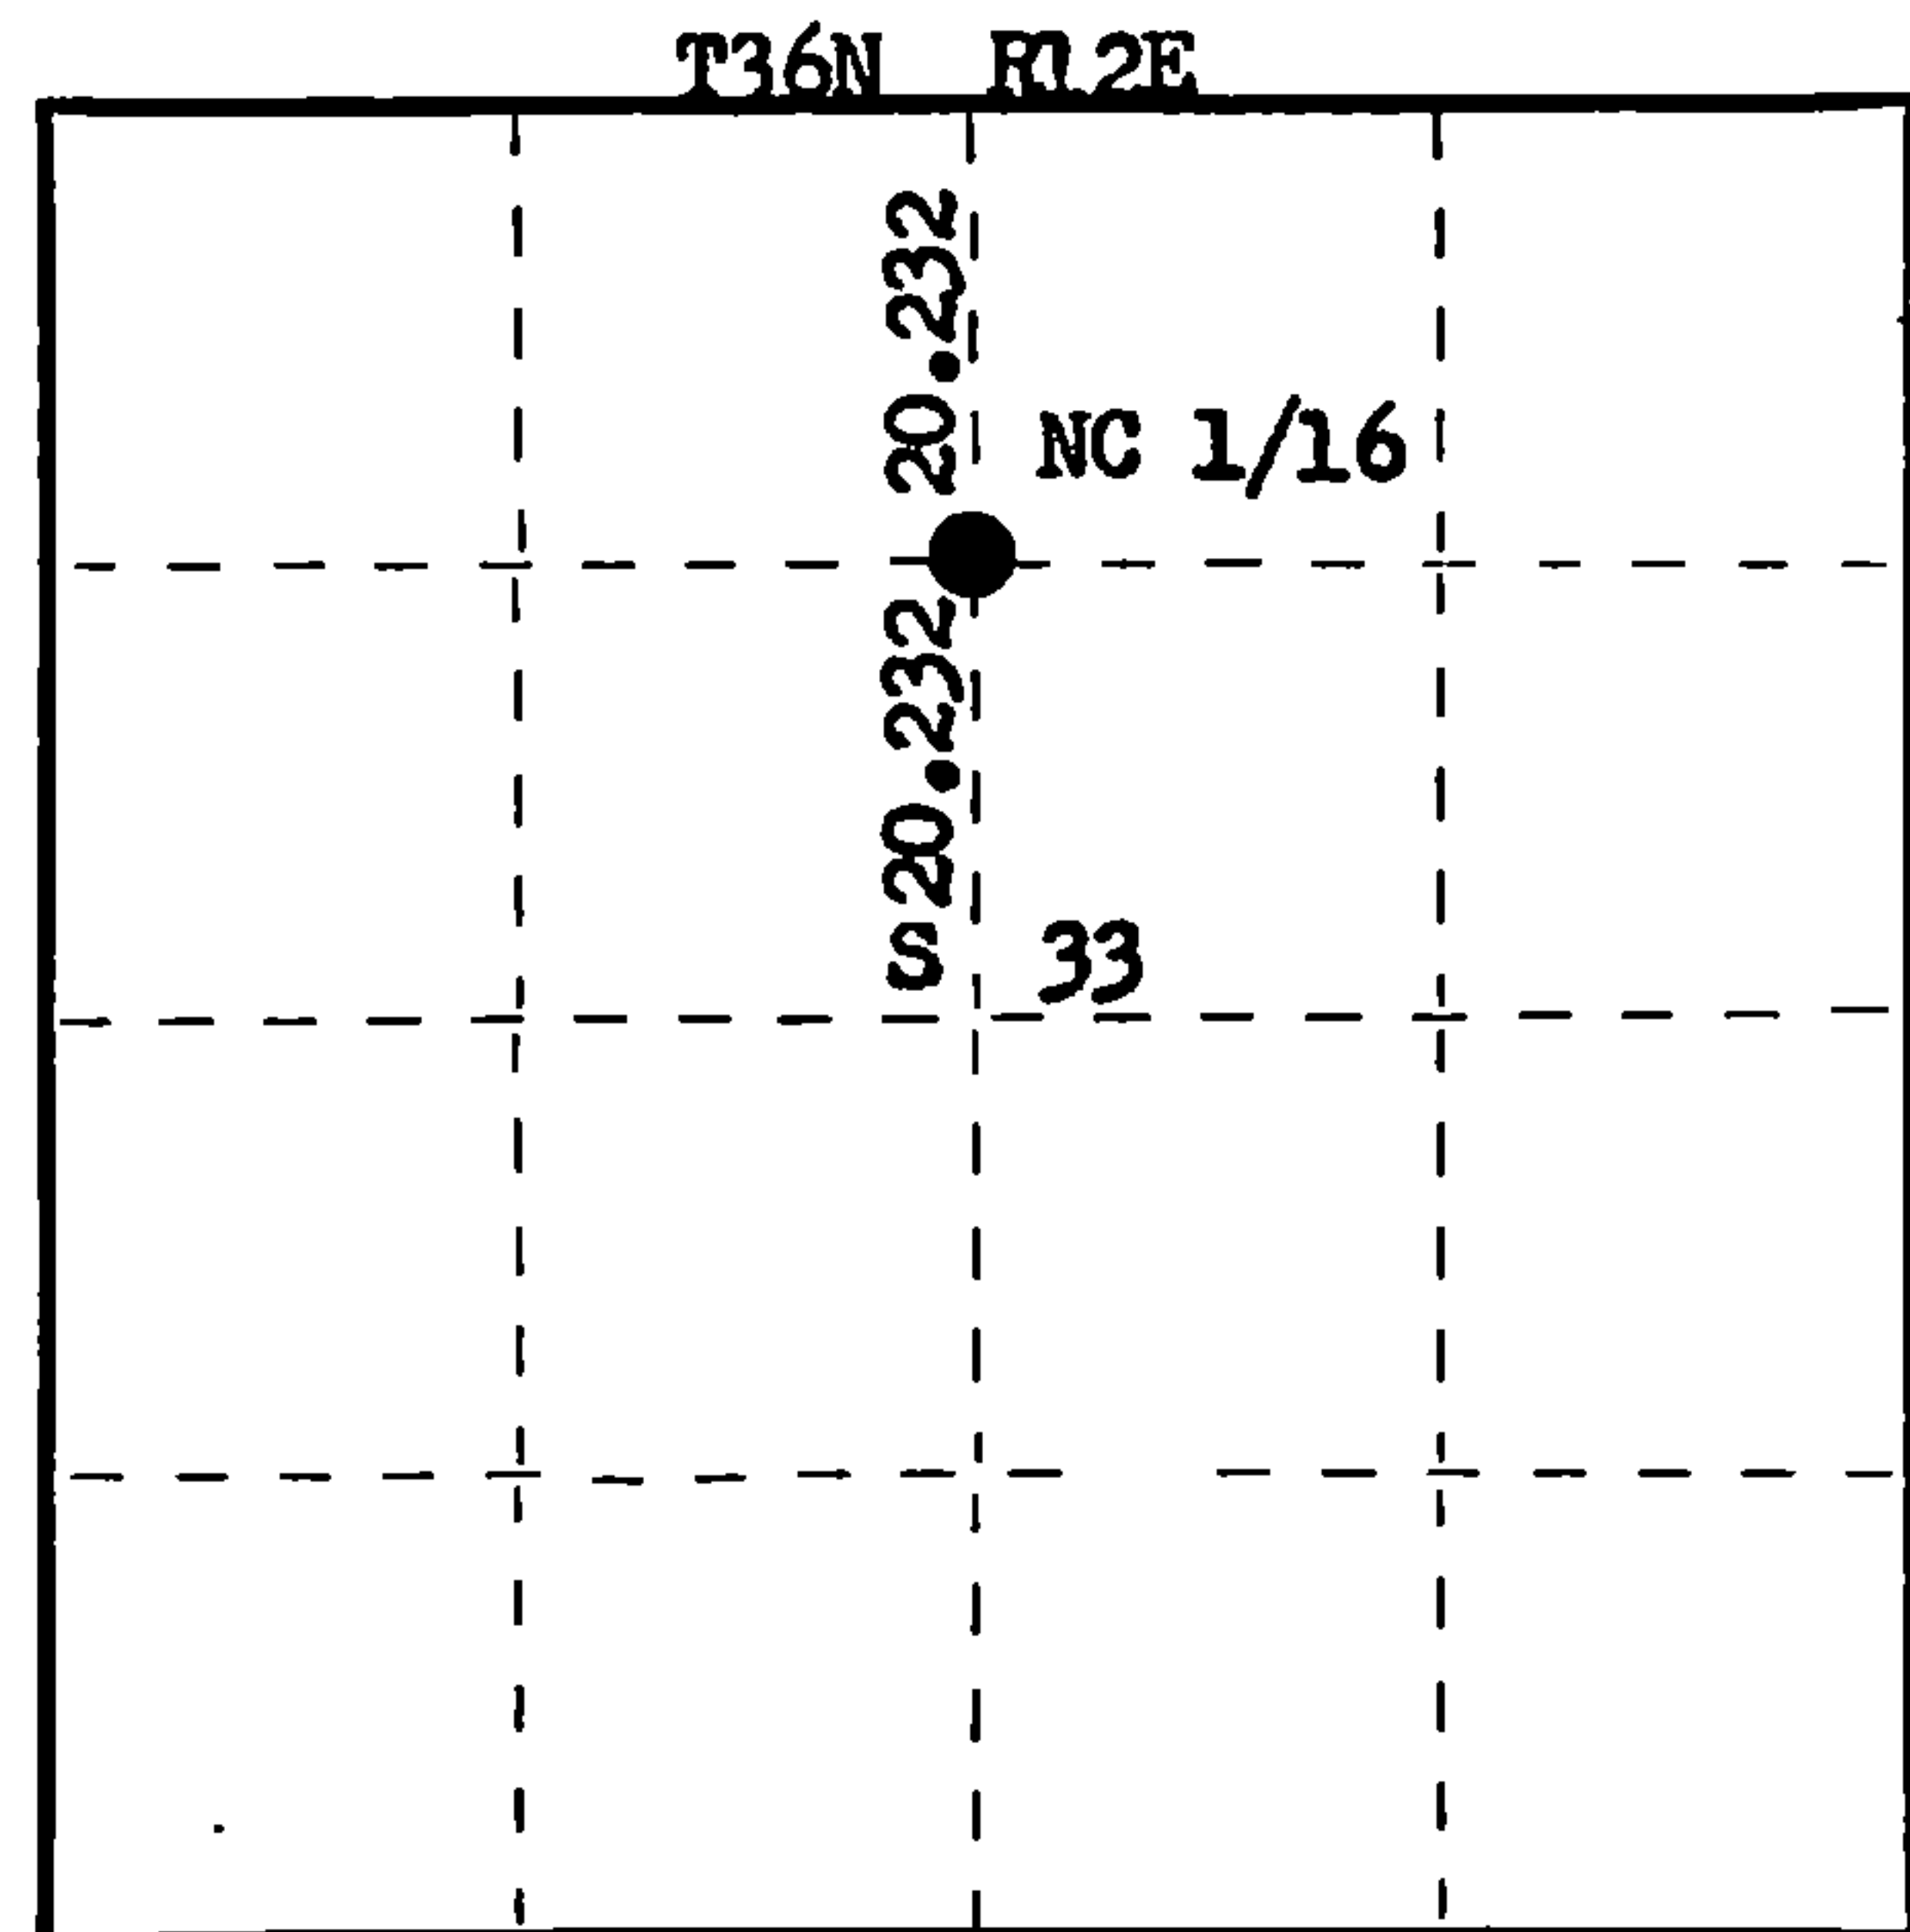

○ = Corner monument restored.

History of original corner establishment:

No record or evidence of any previous survey establishing this corner.

Description of corner evidence found:

Corner established by proportional measurement. Ran traverse from previously established C 1/4 established by traverse and proportional measurement Ran traverse to N 1/4 corner. Set NC 1/16 at 20.232 chains intermediate at N 3° 51' 46" E of C 1/4 corner.

Description of monument and accessories I established to perpetuate the original location of this corner.

Set 1 1/2" iron pipe with 2" brass cap projecting 24" above ground - cap stamped: Corner sets in an old open field, no trees near suitable for BTs. Set 3/4" iron pipe west 20 links for witness post. Set 3/4" iron pipe north 30 links for witness post. Both witness posts project 18" above ground.

S498
T36N R12E
NC 1/16 S 33
CPI-1977

Dated at Rhineland, Wis., this 6th day of April, 1977.

Signature Philip T. Hansen Title Registered Land Surveyor Registration No. S-498
(County Surveyor, Registered Land Surveyor, or other duly authorized official)

Office of Register of Deeds, County of Forest, I hereby certify that the within instrument was filed in this office for record on the 5th day of May, 1977 at 4:00 o'clock P. M.

Eugene Staszynski
(Register of Deeds)

DOCUMENT NUMBER ---- **111375**

By.....Deputy

43012 33 3020