

CERTIFIED LAND CORNER RESTORATION

Index No. A-16

State of Wisconsin }
County of Forest } ss.


I Philip T. Hansen, do hereby
certify that on the 28th day
of July, 19 77, I ~~found~~
~~established~~ re-established the E 1/16
corner of Section 34 & 3
Township 36 & 35, North, Range
12 East, Fourth Principal Meridian,
as described hereon; and that from this evidence
I established a new monument and accessories
as described hereon to perpetuate the original
location of this corner.

Resident witnesses:

Glen Barker

Jim Claflin

Herb Wagoner

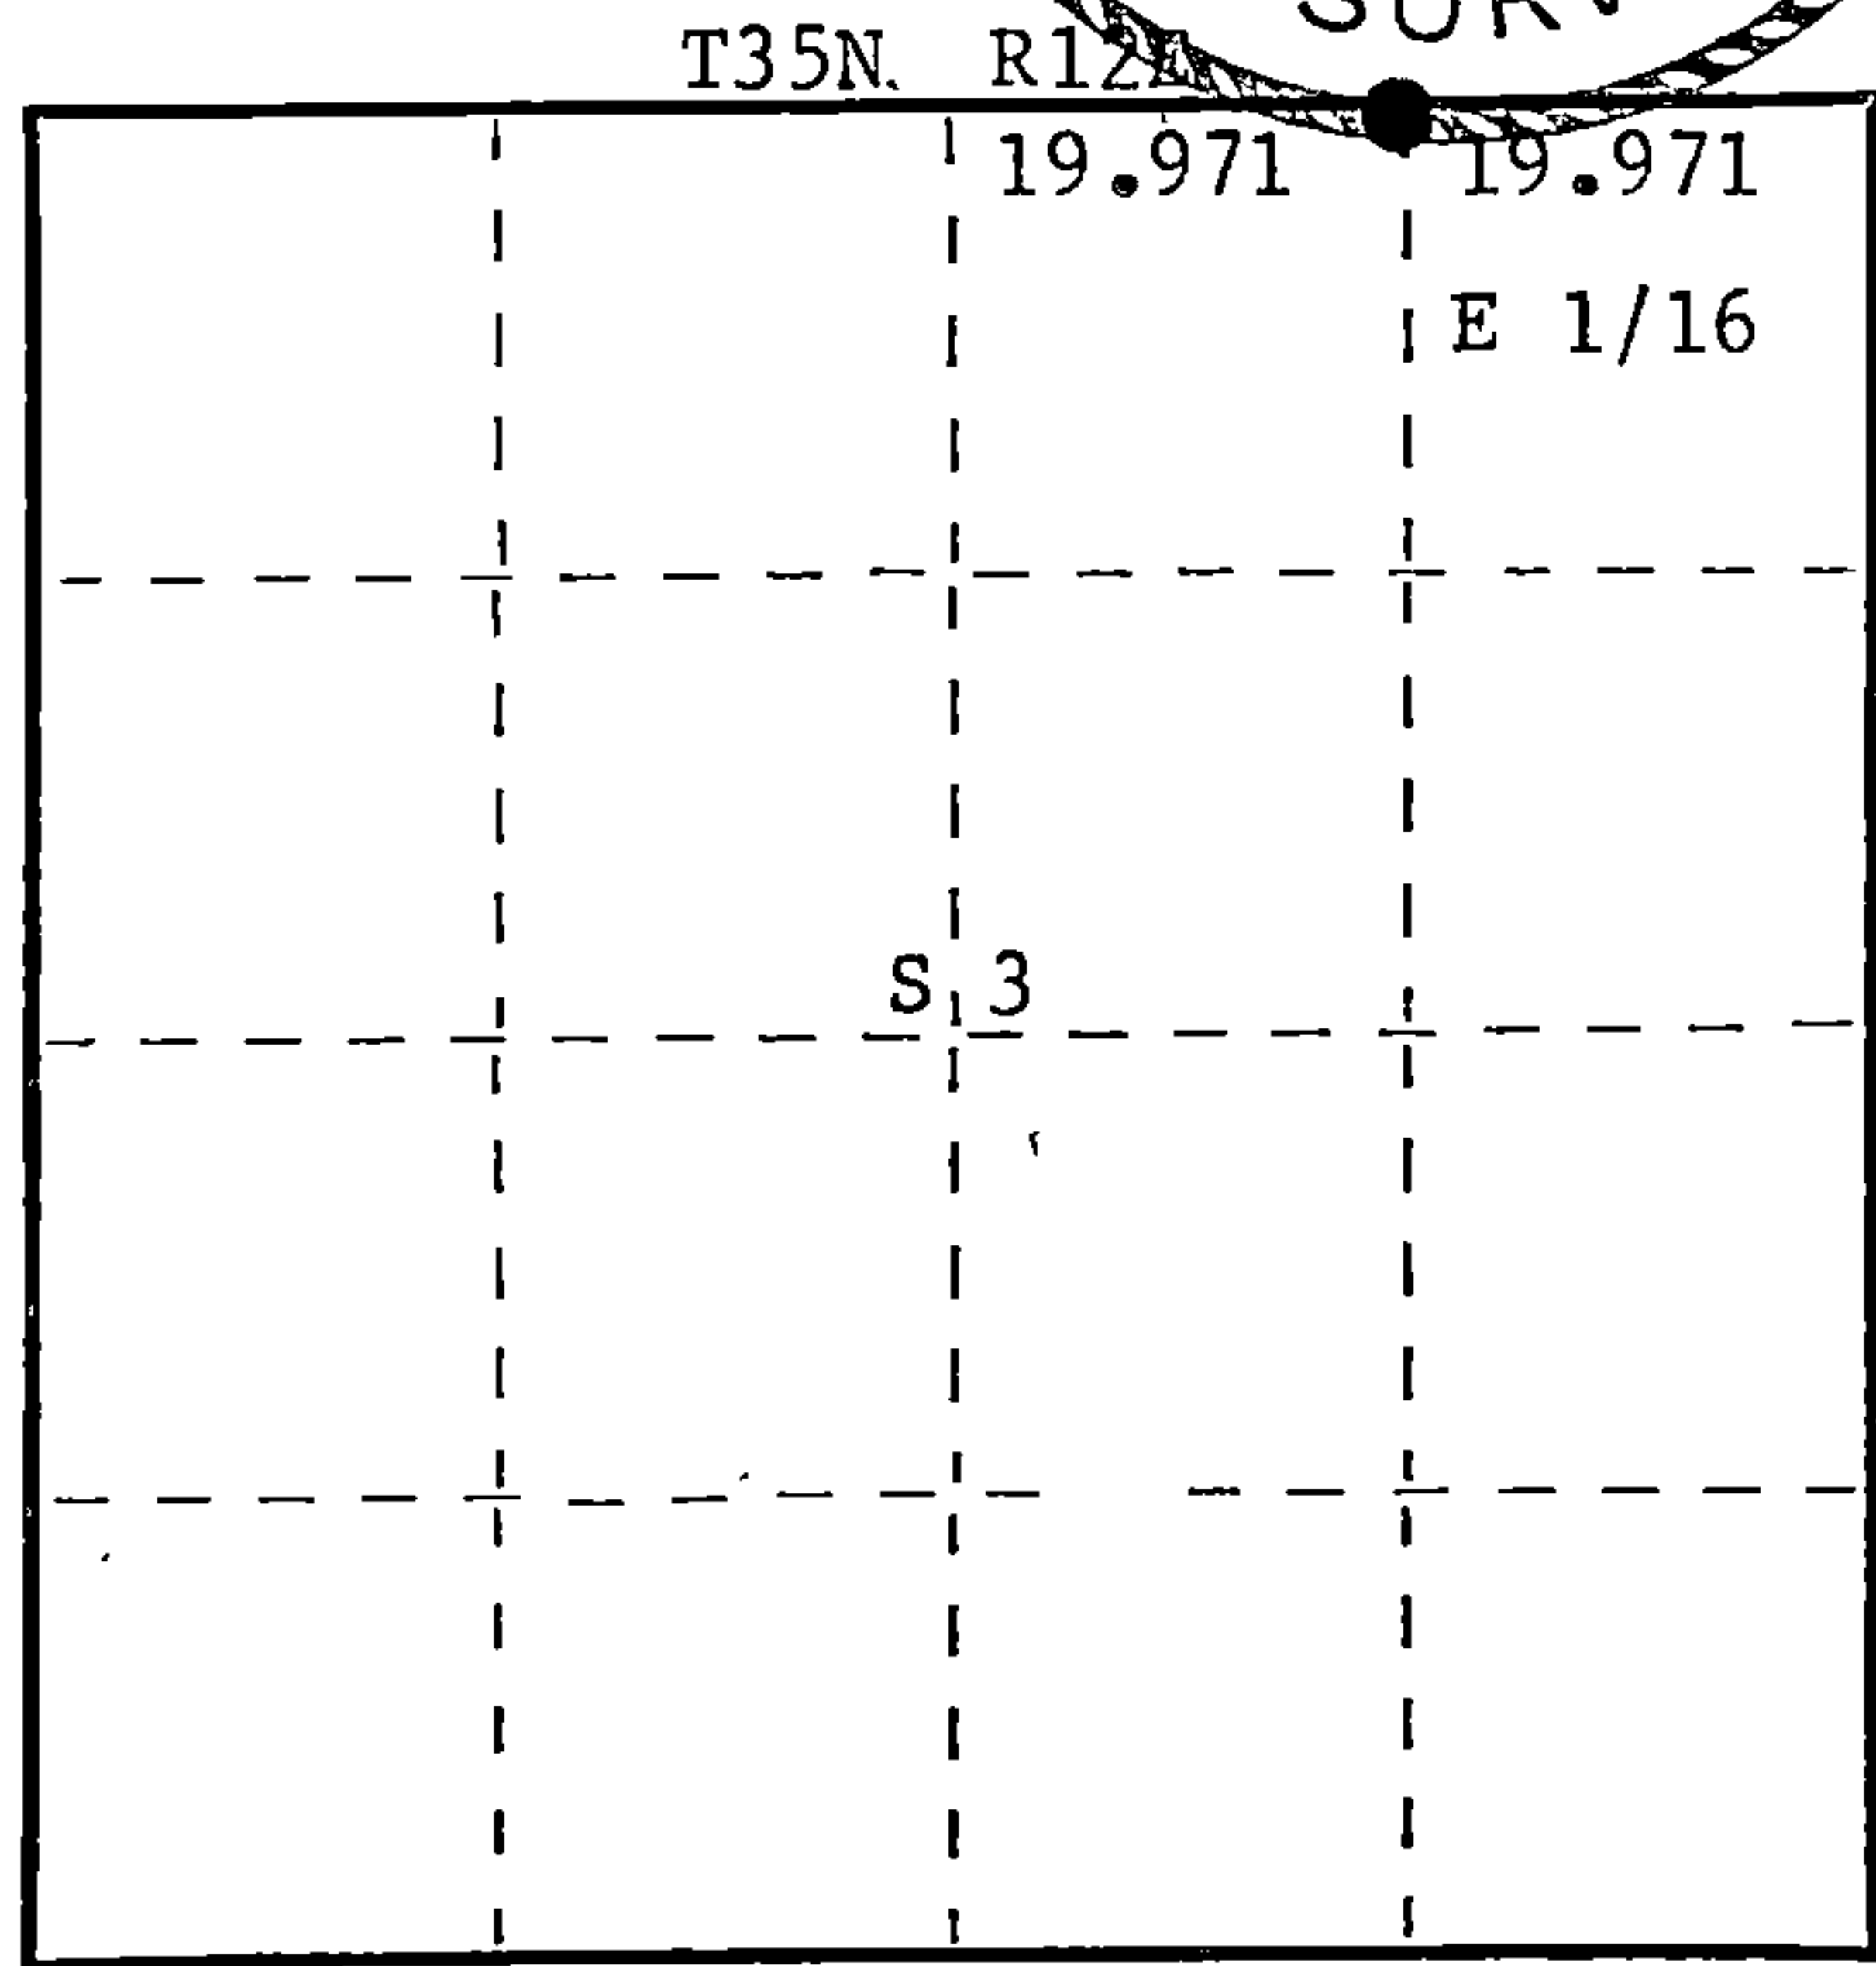

○ = Corner monument restored.

History of original corner establishment:

No records on file of any previous survey.

Description of corner evidence found:

Corner established by traverse and computation from 1/4 corner between Section 33 & 4
and previously established Section Corner 34, 35, 3 and 2. Computed distance 2636.137 ft.
(39.941 chains) at bearing N 88° 59' E.
Set E 1/16 at 1318.068 ft. (19.971 chains) intermediate.

Description of monument and accessories I established to perpetuate the original location of this corner.

Set 1½" x 18" iron pipe in centerline of Sipple road for true corner, 5" below surface.

Set 1½" iron pipe with 2" brass cap, 60 links north for witness corner, stamped:

Monument projects 18" above ground.

Marked NBTs - Sugar 8" S5°W, 36.8 links, scribed 1/16 BT.

Sugar 7" N24°E, 65.2 links, scribed 1/16 BT.

Measurements and bearings taken from true corner.

S498
T36N R12E
S 60 lks
E 1/16 S 34
S 3 W.C.
T35N R12E
CPI-1977

Dated at Rhineland, Wis., this 2nd day of August, 19 77

Signature Philip T. Hansen Title Registered Land Surveyor Registration No. S-498
(County Surveyor, Registered Land Surveyor, or other duly authorized official)

Office of Register of Deeds, County of Forest, I hereby certify that the within
instrument was filed in this office for record on the 22nd day of AUGUST, 19 77
at 3:30 o'clock P. M.

Eugene Stutzman
(Register of Deeds)

By _____ Deputy

DOCUMENT NUMBER **112149**

43612340010