

CERTIFIED LAND CORNER RESTORATION

Index No. X-15

State of Wisconsin }  
County of Forest } ss.


I Philip T. Hansen, do hereby certify that on the 1st day of September, 1977, I ~~found~~ established ~~evidence of~~ the C 1/4 corner of Section 34 Township 36, North, Range 12 East, Fourth Principal Meridian, as described hereon; and that from this evidence I established a new monument and accessories as described hereon to perpetuate the original location of this corner.

Resident witnesses:


Glen Barker

Jim Claflin

Herb Wagoner

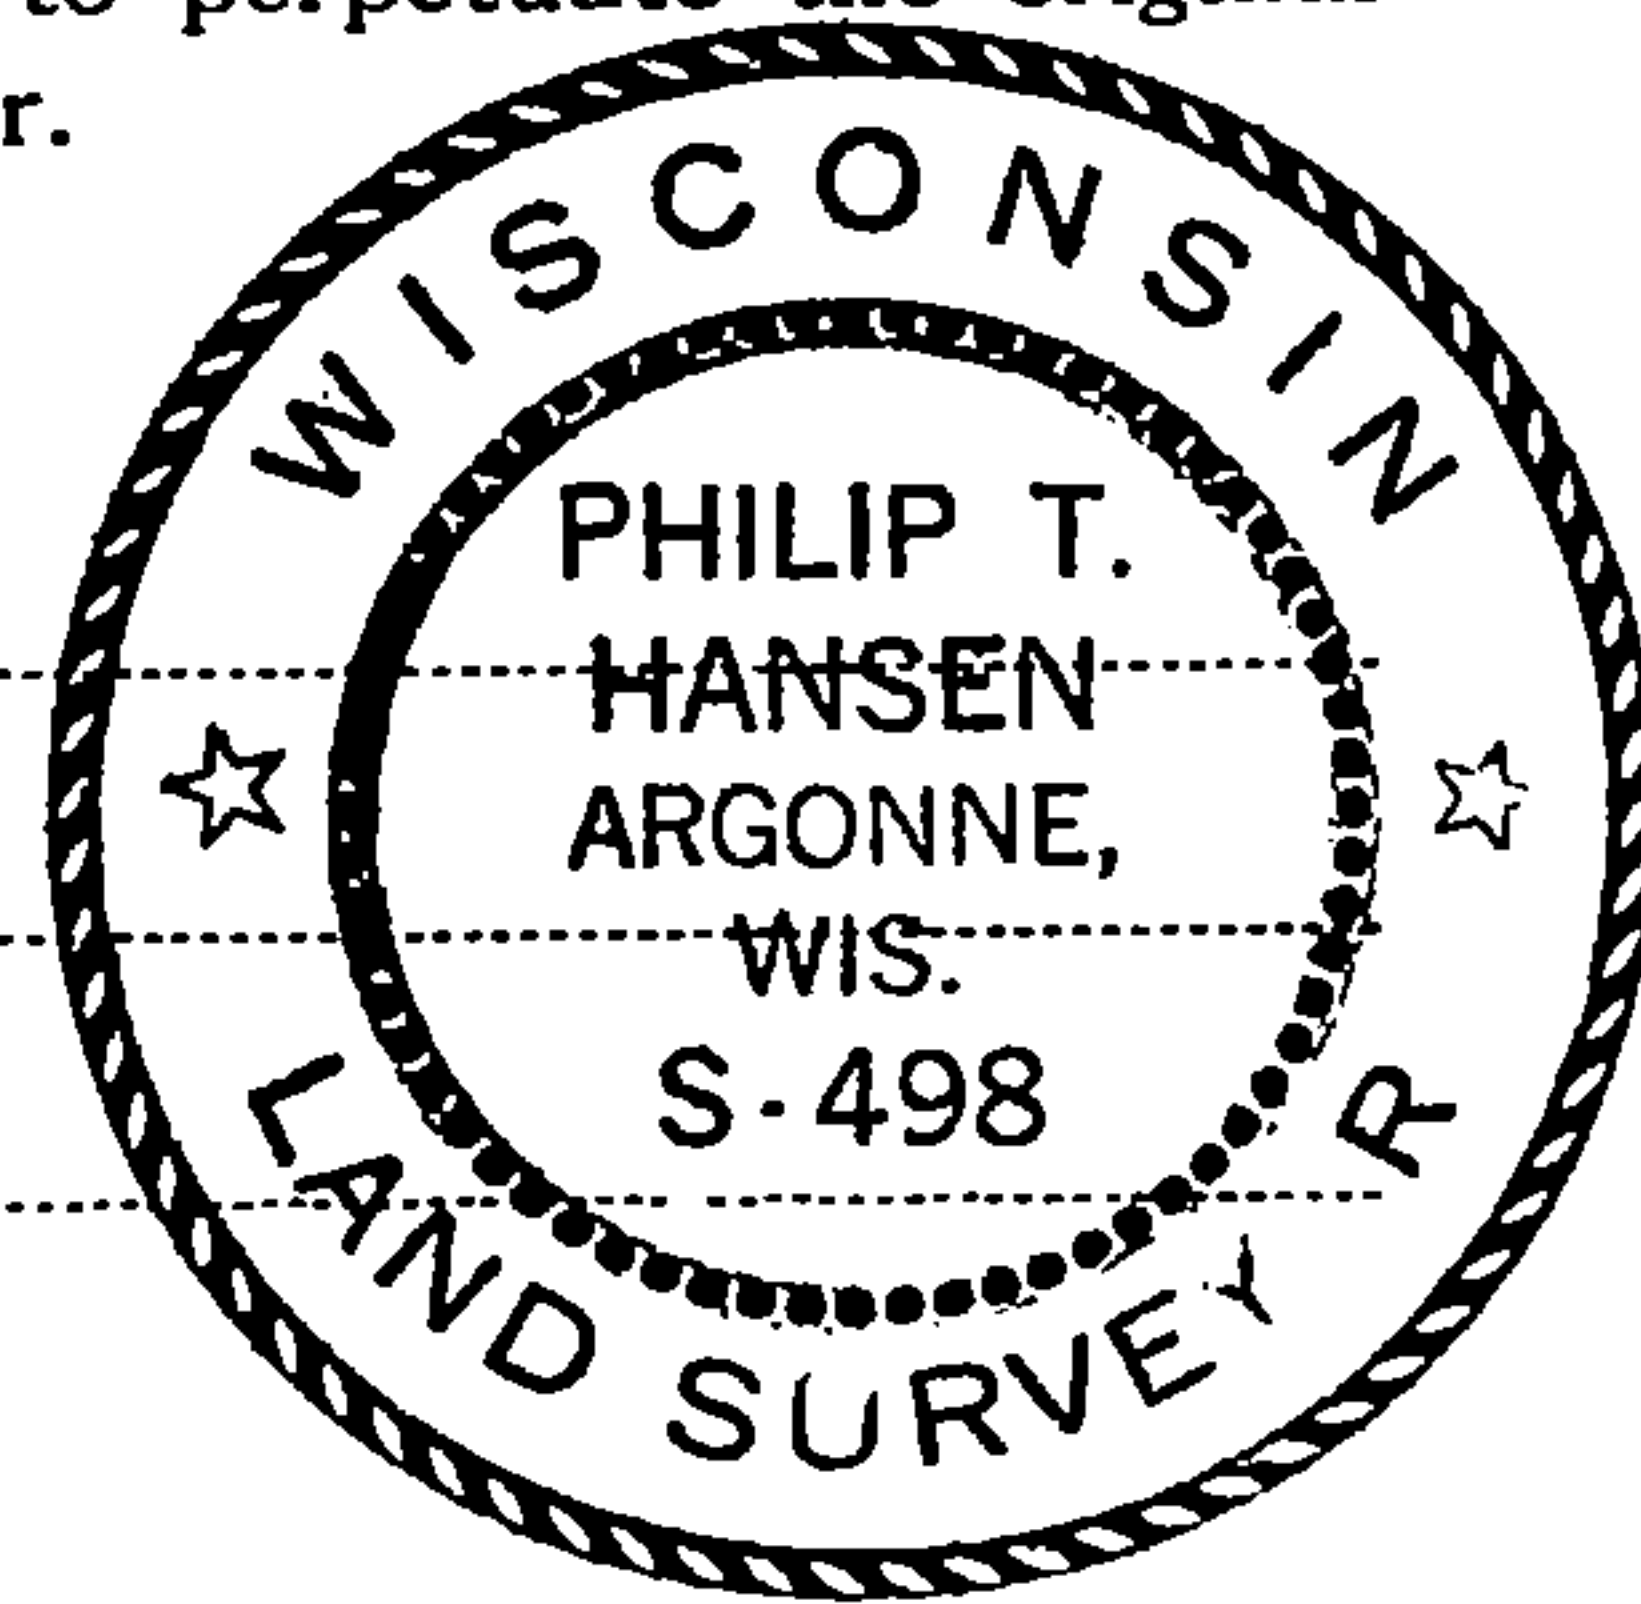

FORM 985 M. C. MILLER CO., MILWAUKEE

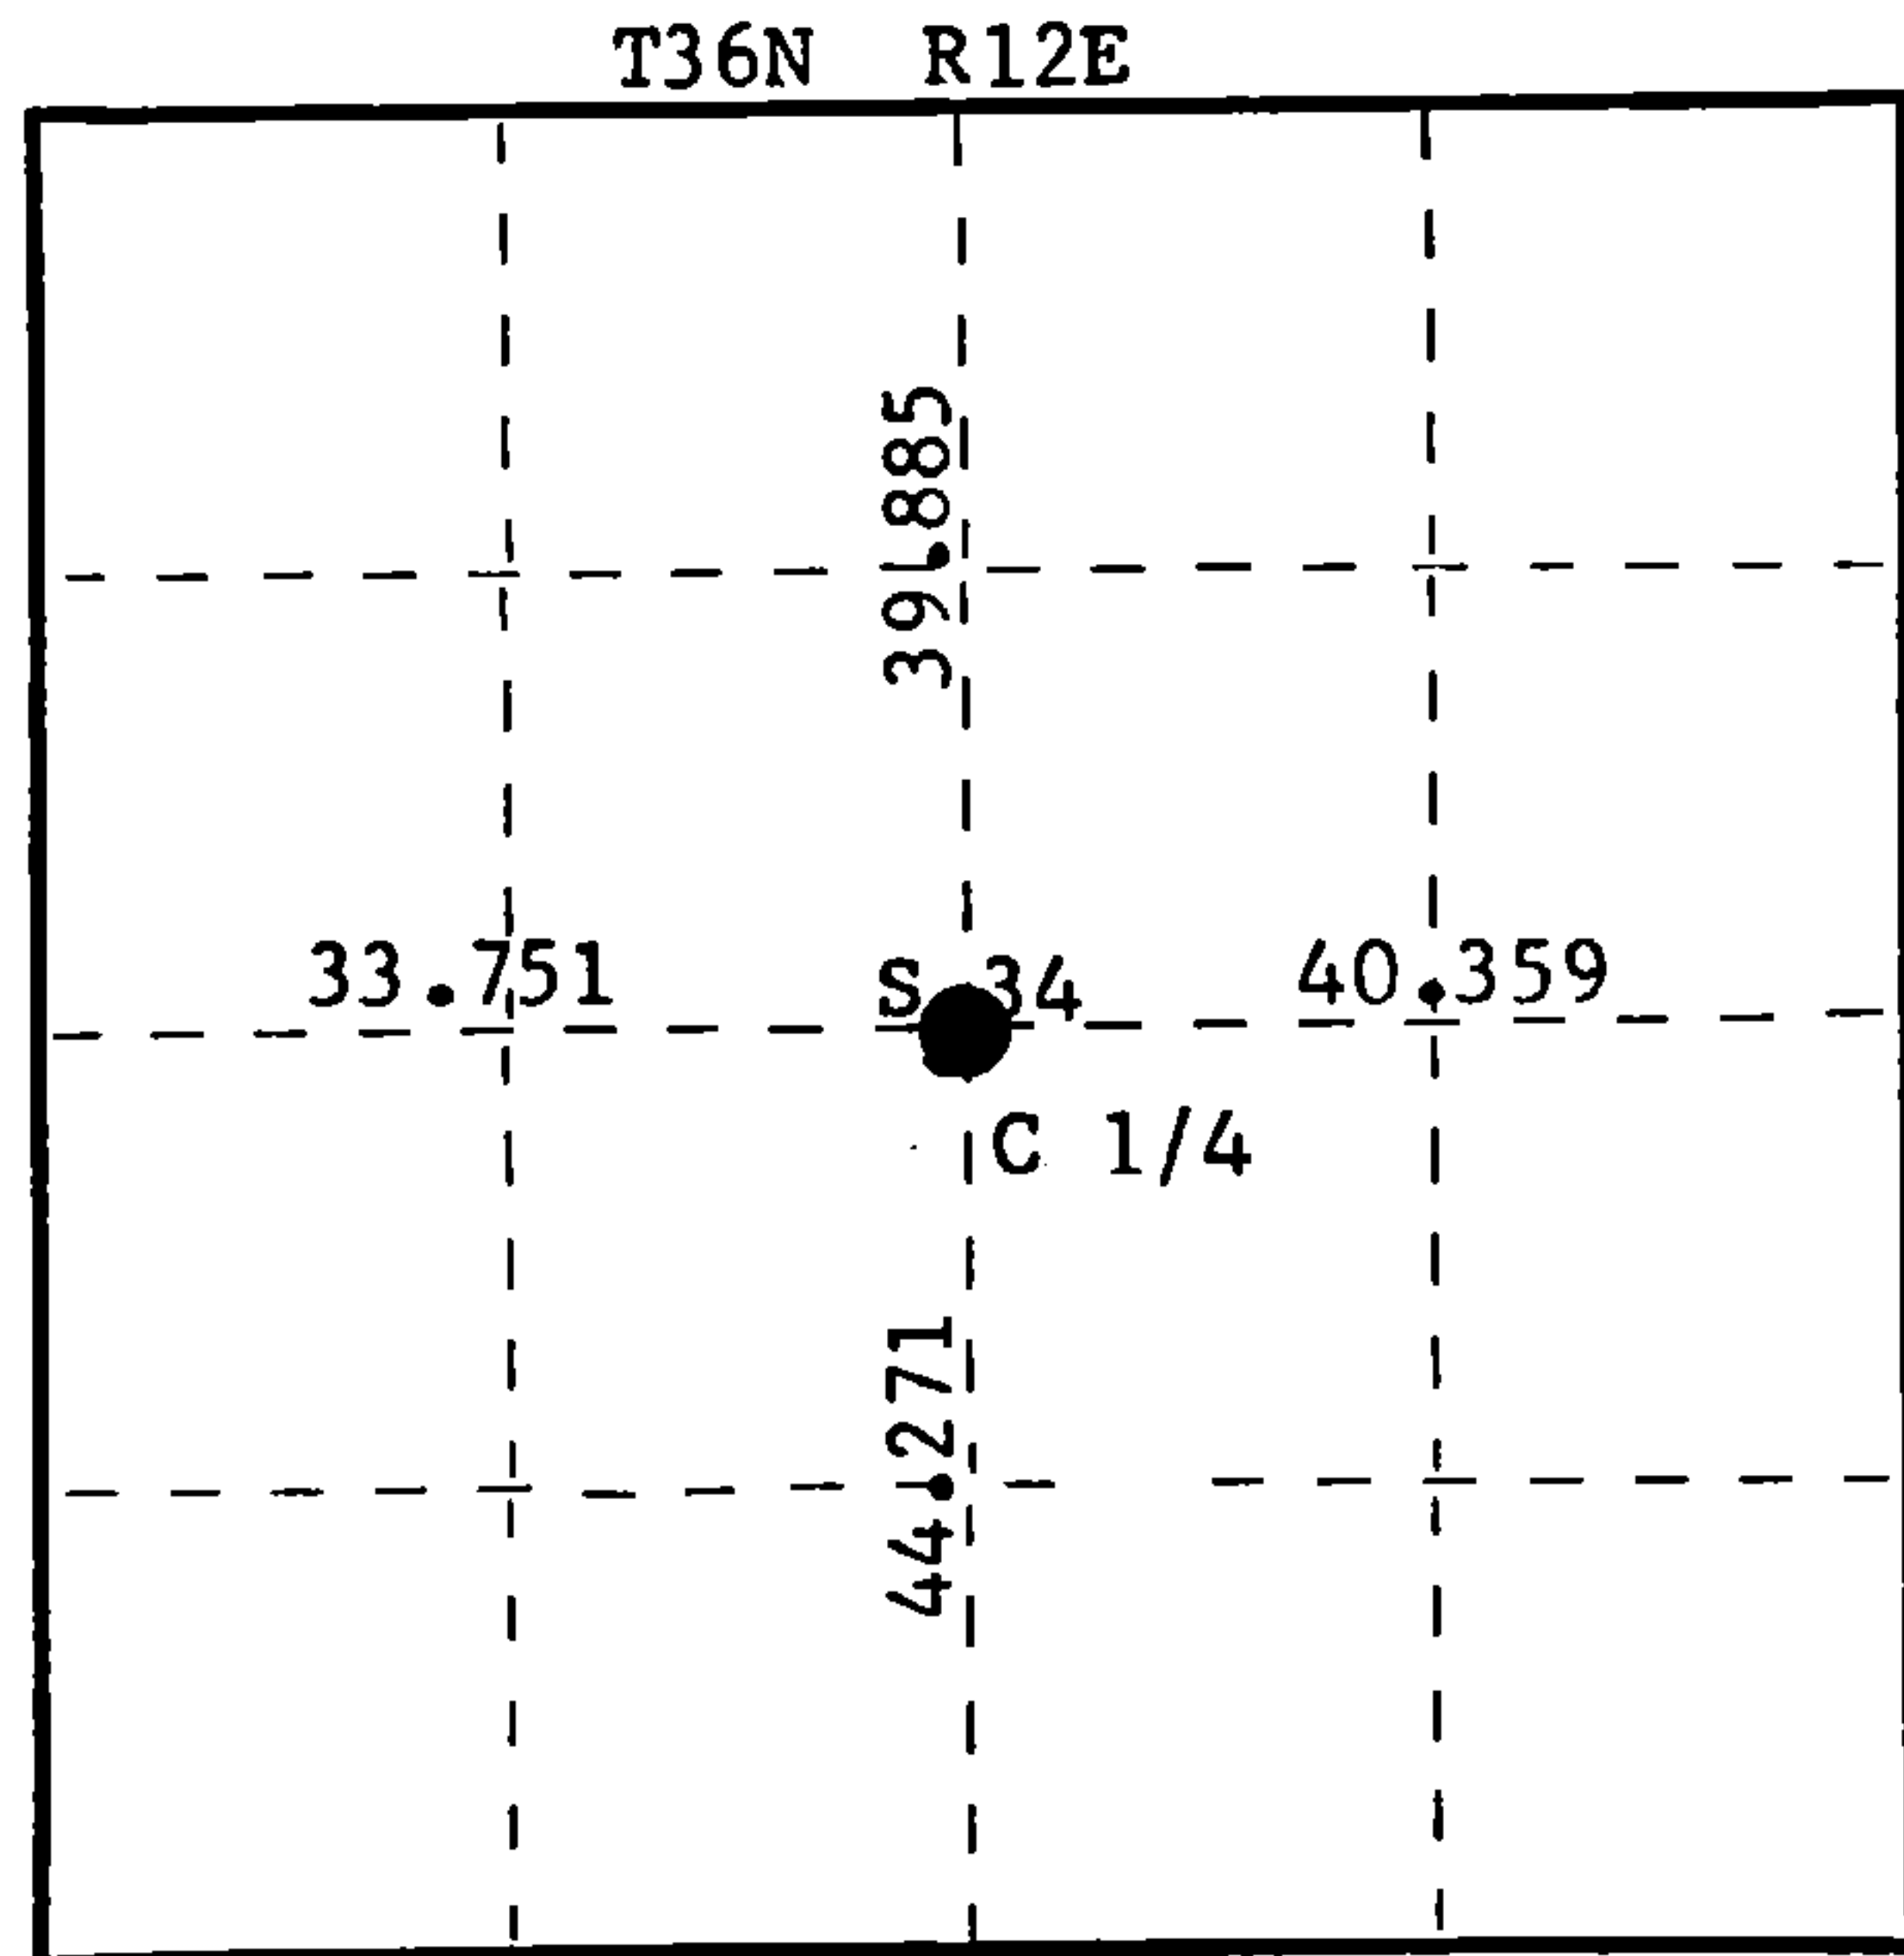

○ = Corner monument restored.

History of original corner establishment:

No records of any previous surveys.

Description of corner evidence found:

No evidence of any corner recovered. Corner established by traverse and computation. Ran traverse from N 1/4 to S 1/4 corner. Ran traverse from E 1/4 to W 1/4 corner to establish C 1/4 corner. Corner sets 2227.586 feet S 87° 43' 16" E of W 1/4 corner and 2632.4391 feet S 2° 02' 38" W of N 1/4 corner.

Description of monument and accessories I established to perpetuate the original location of this corner.

Set 2 1/2" Berntsen A-1 Federal Monument, aluminum with magnet in cap and base, projecting 24" above ground. Cap stamped:  
Marked NBTs - Sugar 8" S22°W, 23.8 links.  
Sugar 10" N71°E, 25.75 links.  
Sugar 7" N73°W, 34.24 links.  
All scribed C 1/4 BT.

T36N R12E  
C 1/4 S 34  
S498 - 1977

Dated at Rhineland, Wis., this 6th day of September, 1977.

Signature Philip T. Hansen Title Registered Land Surveyor Registration No. S-498  
(County Surveyor, Registered Land Surveyor, or other duly authorized official)

Office of Register of Deeds, County of Forest, I hereby certify that the within instrument was filed in this office for record on the 7th day of September, 1977 at 2:30 o'clock P. M.

Eugene Staley  
(Register of Deeds)  
By \_\_\_\_\_ Deputy

DOCUMENT NUMBER ----- **112286**

43612342020