

CERTIFIED LAND CORNER RESTORATION

Index No. W-17

State of Wisconsin }  
County of Forest } ss.


I Philip T. Hansen, do hereby certify that on the 17th day of August, 19 77, I ~~found~~ established ~~the~~ N 1/16 corner of Section 34 & 35 Township 36, North, Range 12 East, Fourth Principal Meridian, as described hereon; and that from this evidence I established a new monument and accessories as described hereon to perpetuate the original location of this corner.

Resident witnesses:


Glen Barker

Jim Claflin

Herb Wagoner

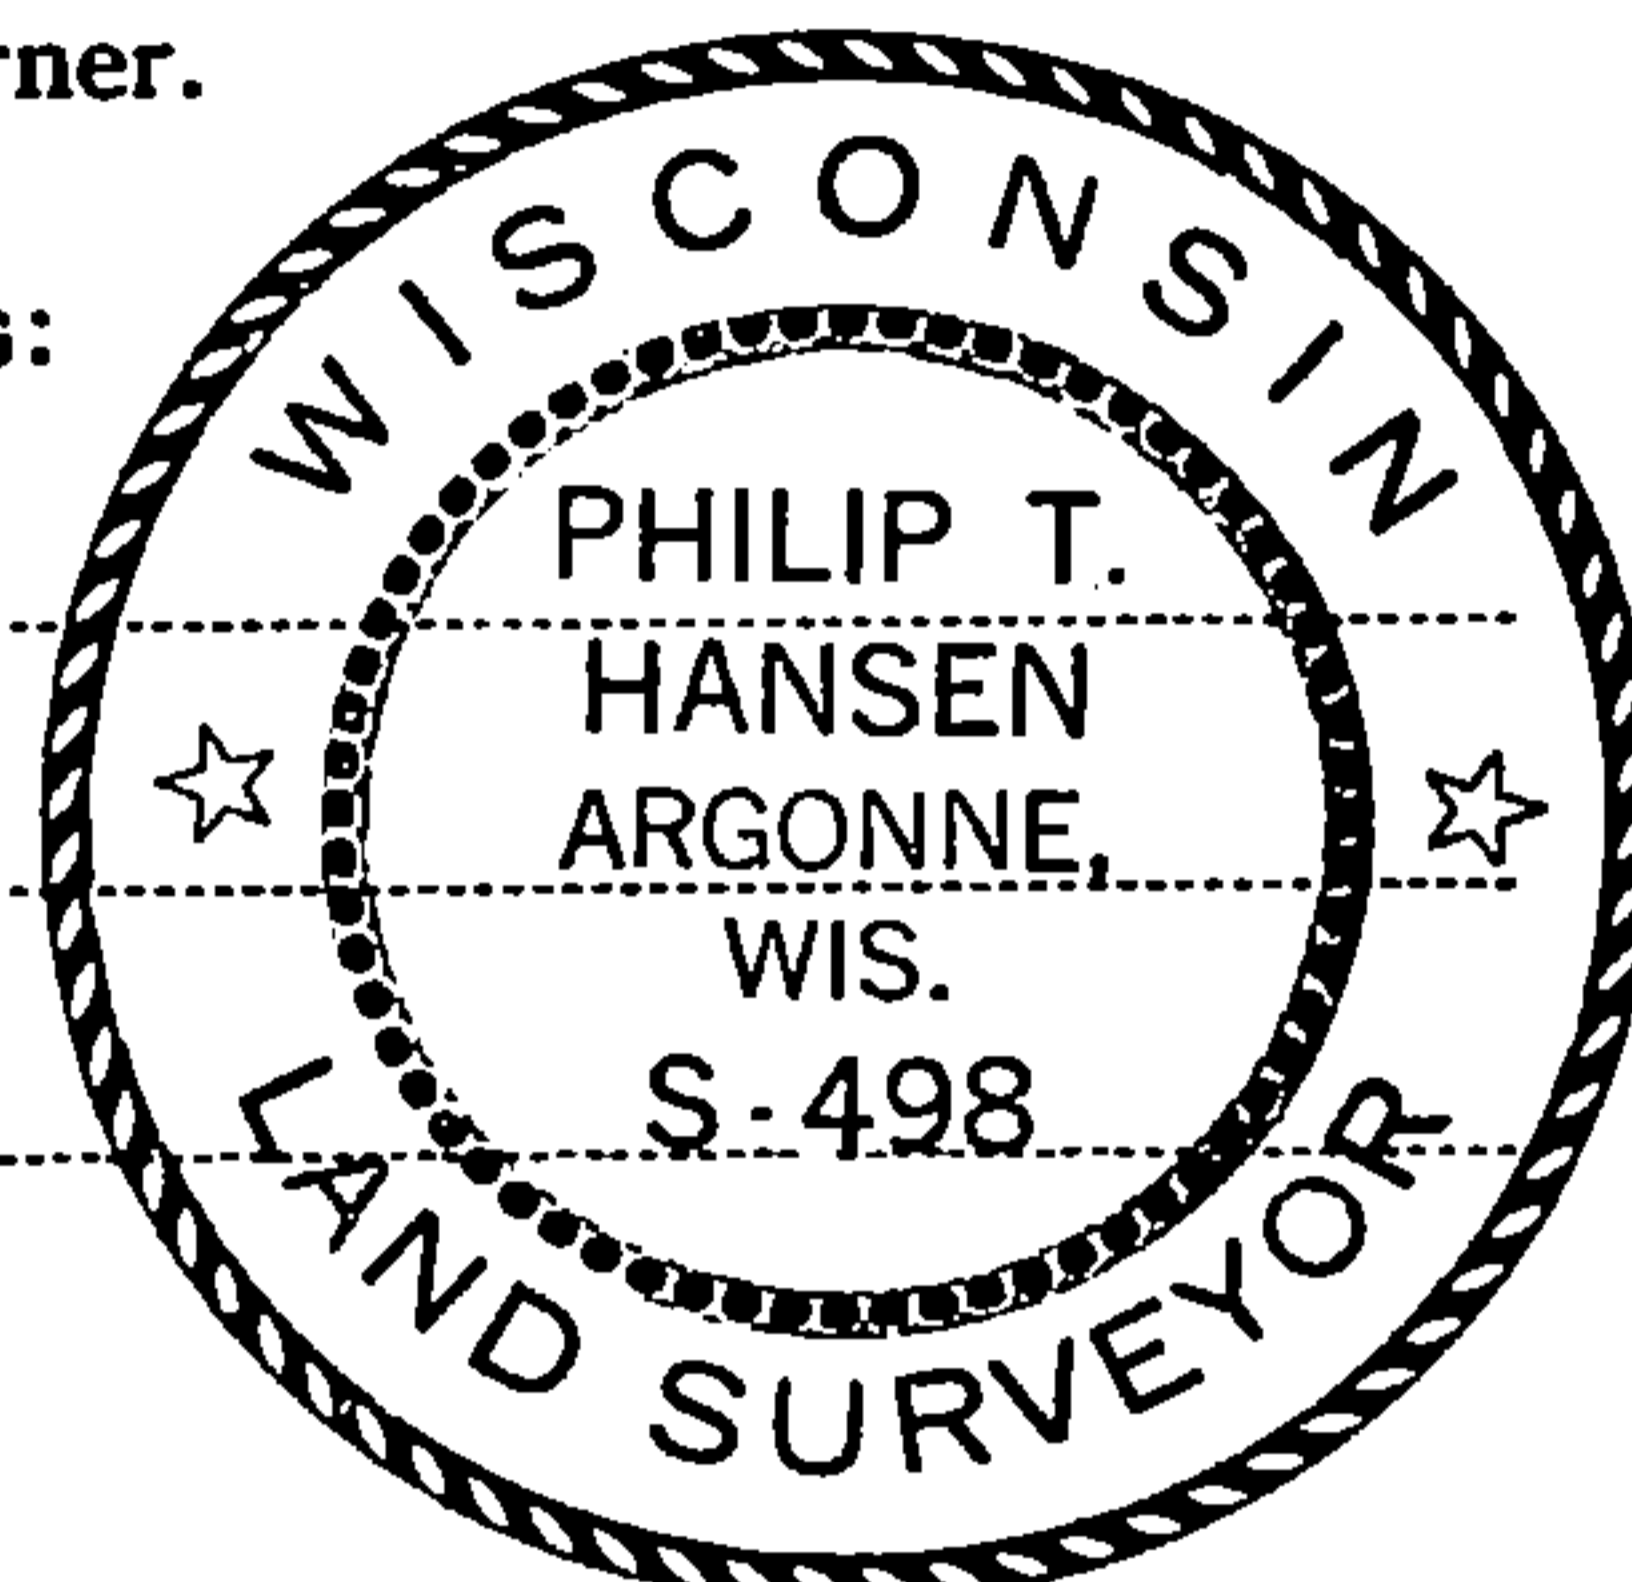

T36N R12E

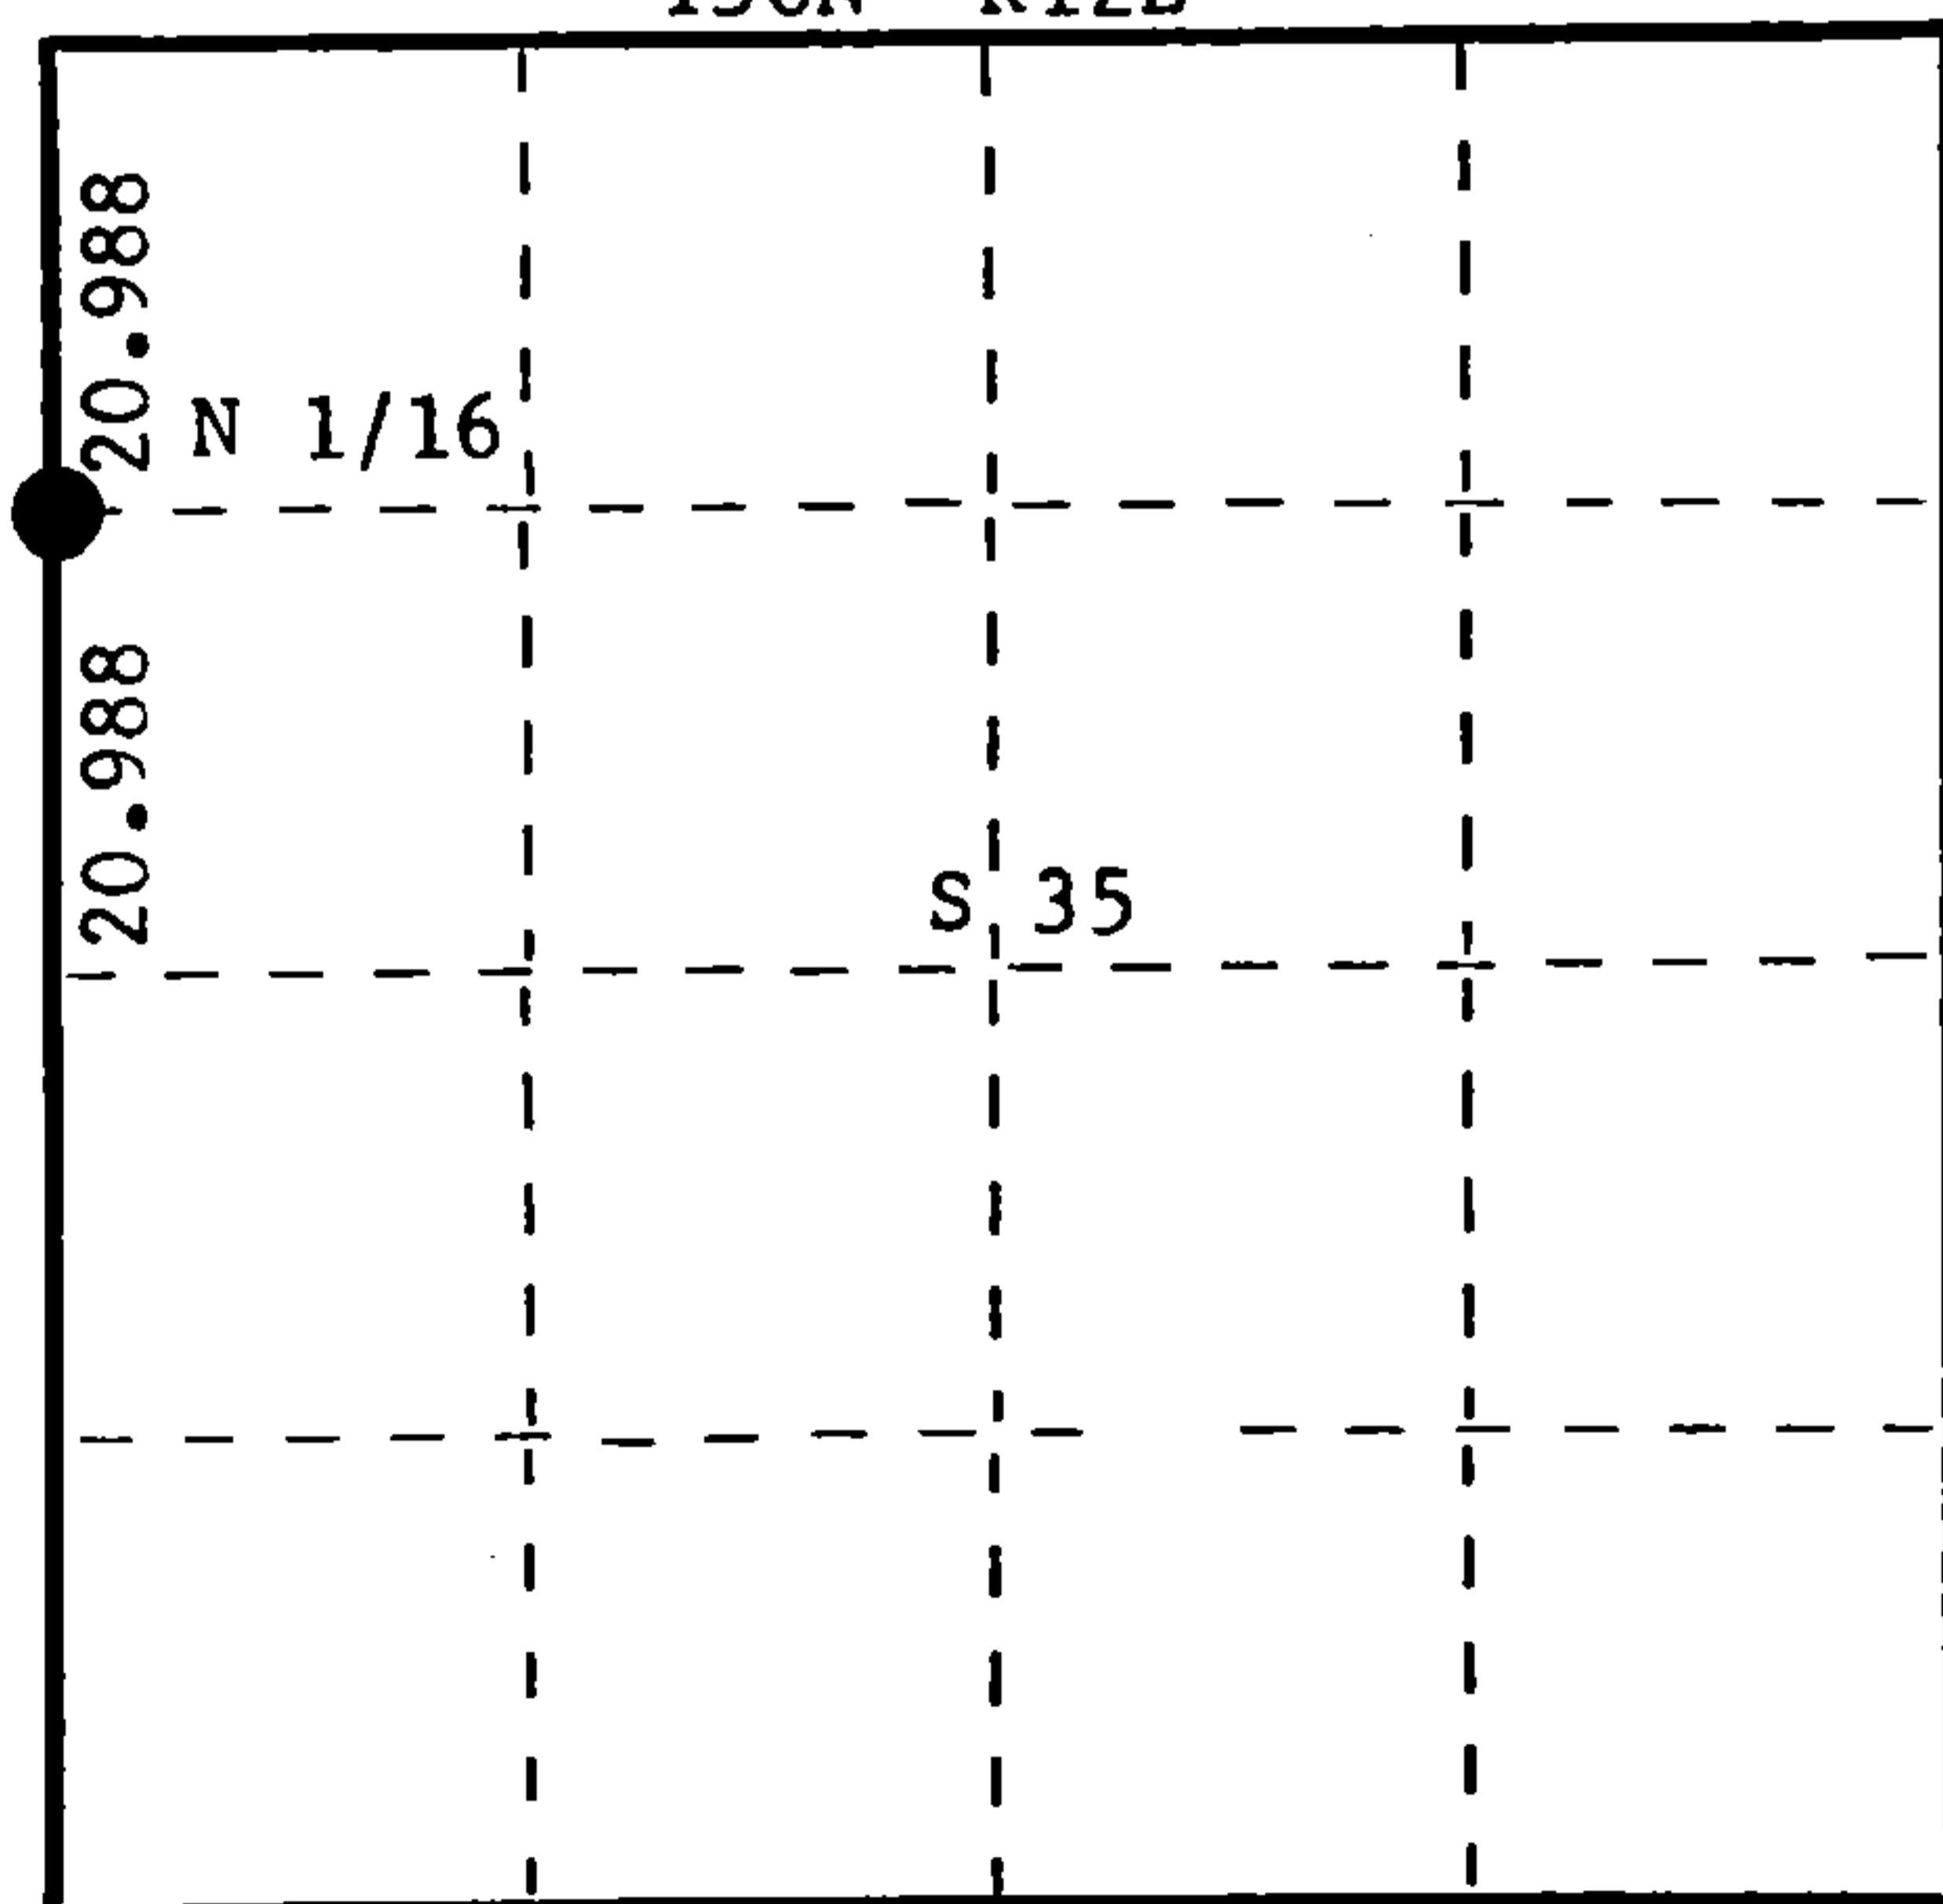

○ = Corner monument restored.

History of original corner establishment:

No record of any previous survey.

Description of corner evidence found:

No evidence of any previous corner recovered.

Corner established by proportion. Ran traverse south from Section Corner 27, 26, 34, 35 to Section Corner 34, 35, 2 & 3. Computed distance 5540.757 feet (83.951 chains) at bearing S 2° 41' 29" W.

Set N 1/16 at 1385.1892 feet (20.9877 chains) intermediate between Section Corner and 1/4 corner.

Description of monument and accessories I established to perpetuate the original location of this corner.

Set 1 1/2" iron pipe with 2" brass cap, projecting 2' above ground. Cap stamped:

Marked NBTs - Sugar 8" S44°E, 18.5 links, scribed 1/16 BT.

Sugar 8" N37°W, 40.7 links, scribed 1/16 BT.

S498

T36N R12E

N 1/16 S34 | S35

CPI-1977

Dated at Rhineland, Wis., this 19th day of August, 19 77.

Signature Philip T. Hansen Title Registered Land Surveyor Registration No. S-498  
(County Surveyor, Registered Land Surveyor, or other duly authorized official)

Office of Register of Deeds, County of Forest, I hereby certify that the within instrument was filed in this office for record on the 22nd day of AUGUST, 19 77 at 3:30 o'clock P. M.

Eugene Staszny  
(Register of Deeds)

DOCUMENT NUMBER

**112163**

By \_\_\_\_\_ Deputy

FORM 985 R. C. MILLER CO., MILWAUKEE

43612343000